
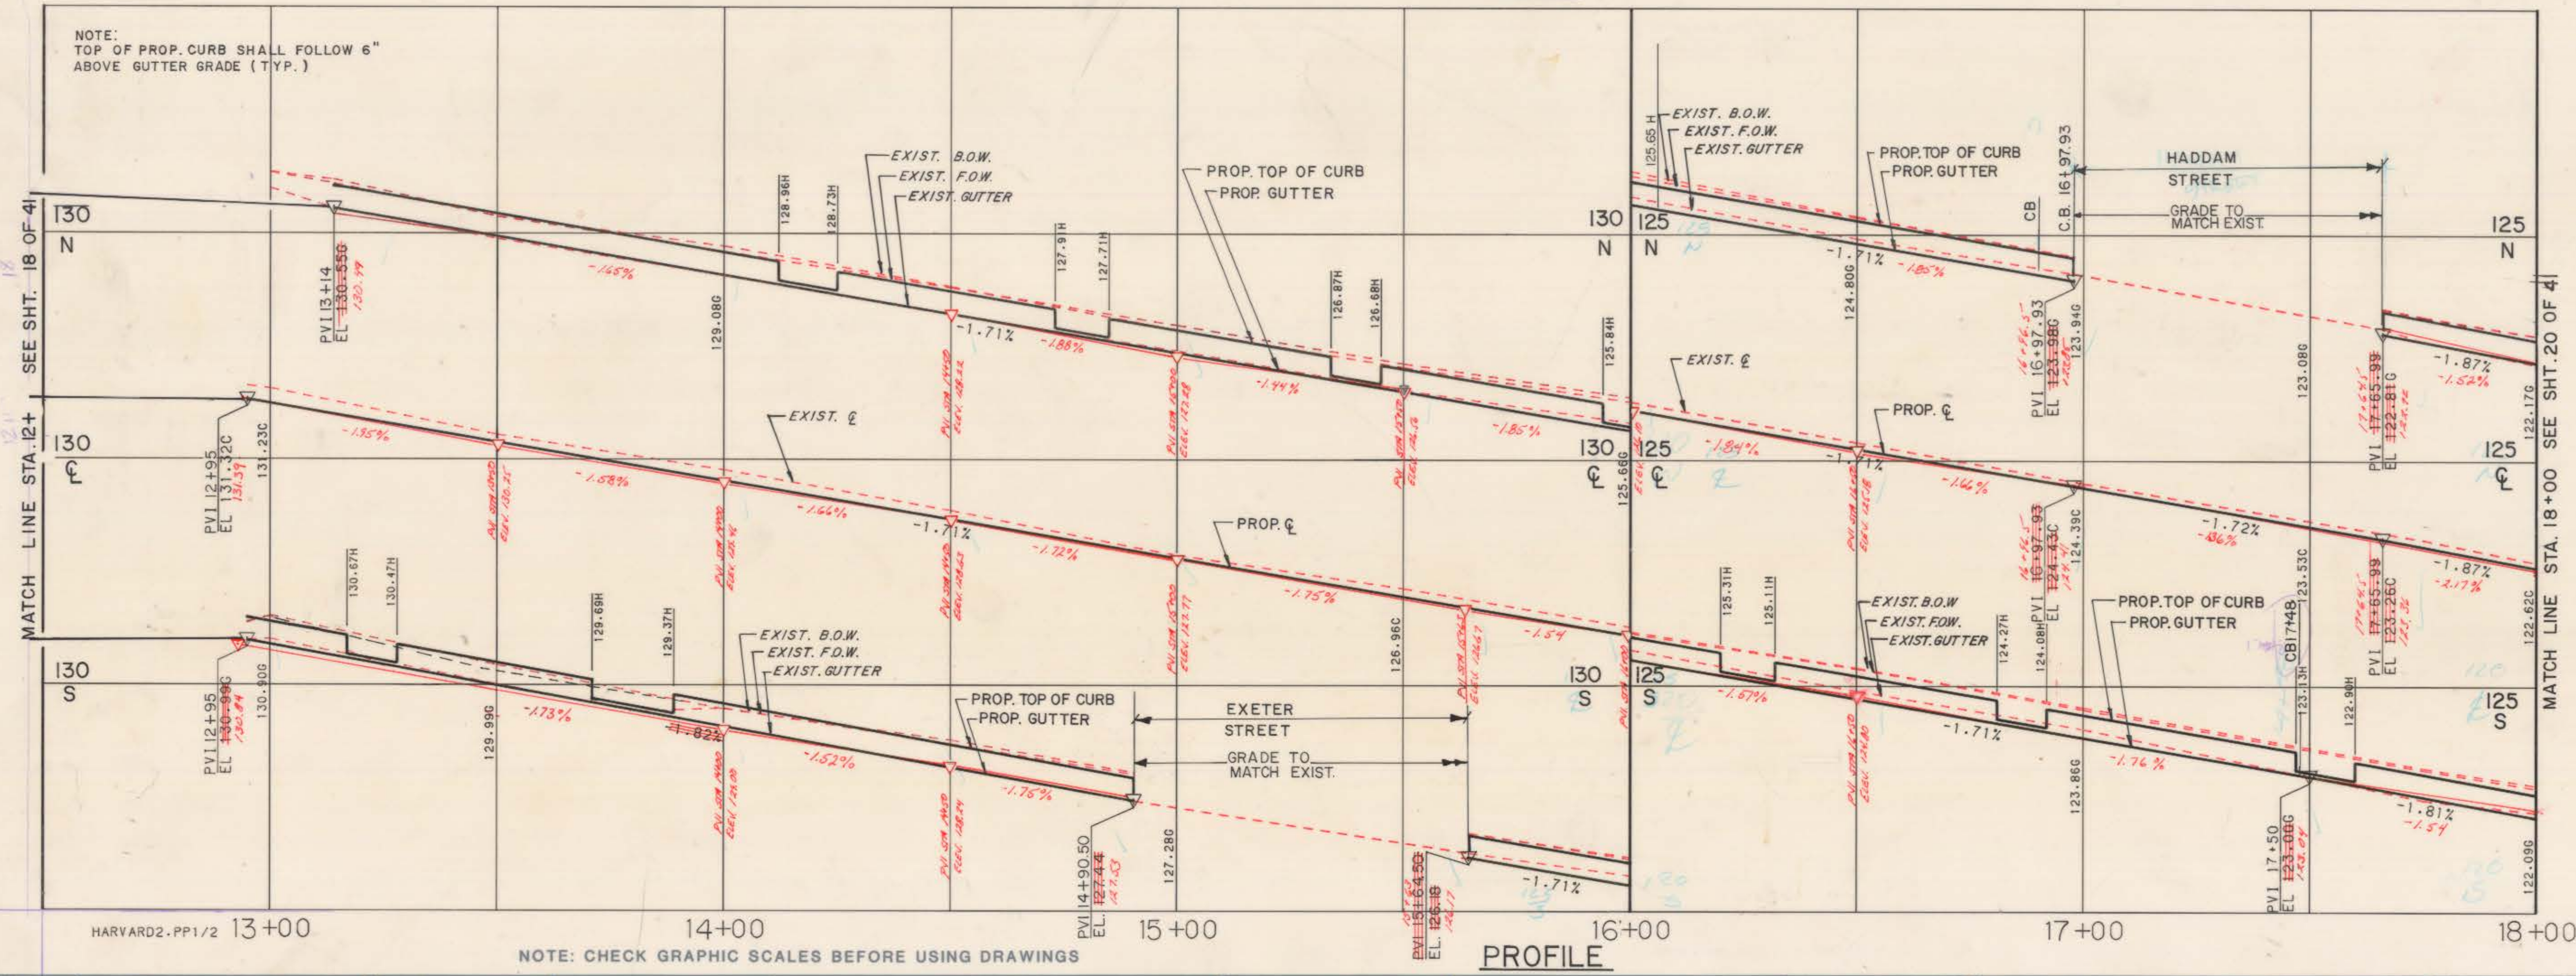


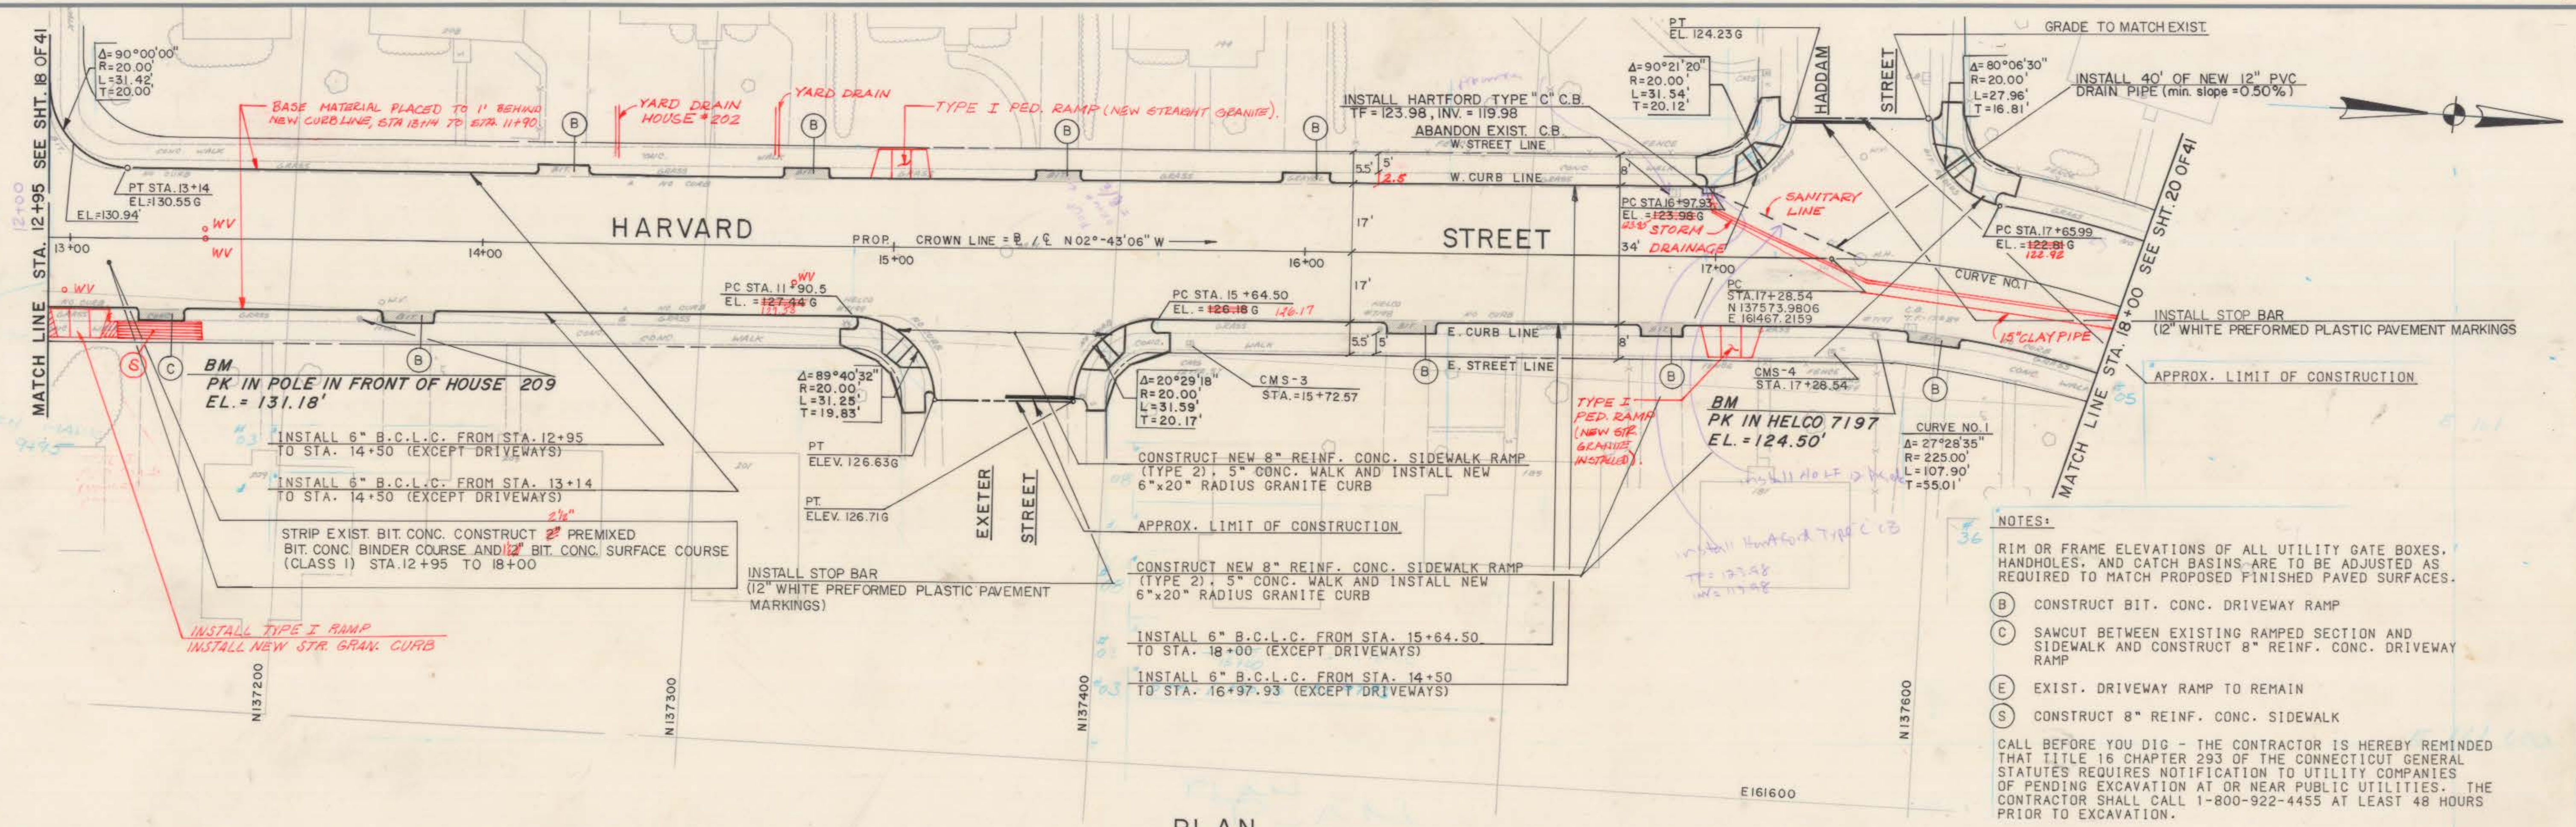

REVISIONS NO. DATE DESCRIPTION 1 11/27/87 Add Plan Note - As Built - Deleted by MDH JAN 87 2 11/27/87 Add Plan Note - As Built - Deleted by MDH JAN 87		SUPV. JAC DESIGN MDH/AEC DRAWN NDF CHECKED AEC DATE 02.18.86	GRAPHIC SCALES HORIZ. 1"=20' VERT. 1"=2' ROADWAY RECONSTRUCTION HARTFORD, CONNECTICUT		Hayden Wegman Consulting Engineers WEST HARTFORD NEW YORK • BOSTON • BUFFALO ATLANTA • MEMPHIS	CITY OF HARTFORD, CONNECTICUT DEPARTMENT OF PUBLIC WORKS BUREAU OF ENGINEERING SERVICES DAYBOOK NO. 011005 DATE	HARVARD STREET 12+95 TO STA. 18+00 PLAN AND PROFILE Contract No. E86-2 Job No. - 852534	SHEET 19 OF 41
--	--	--	---	--	---	---	--	-------------------