
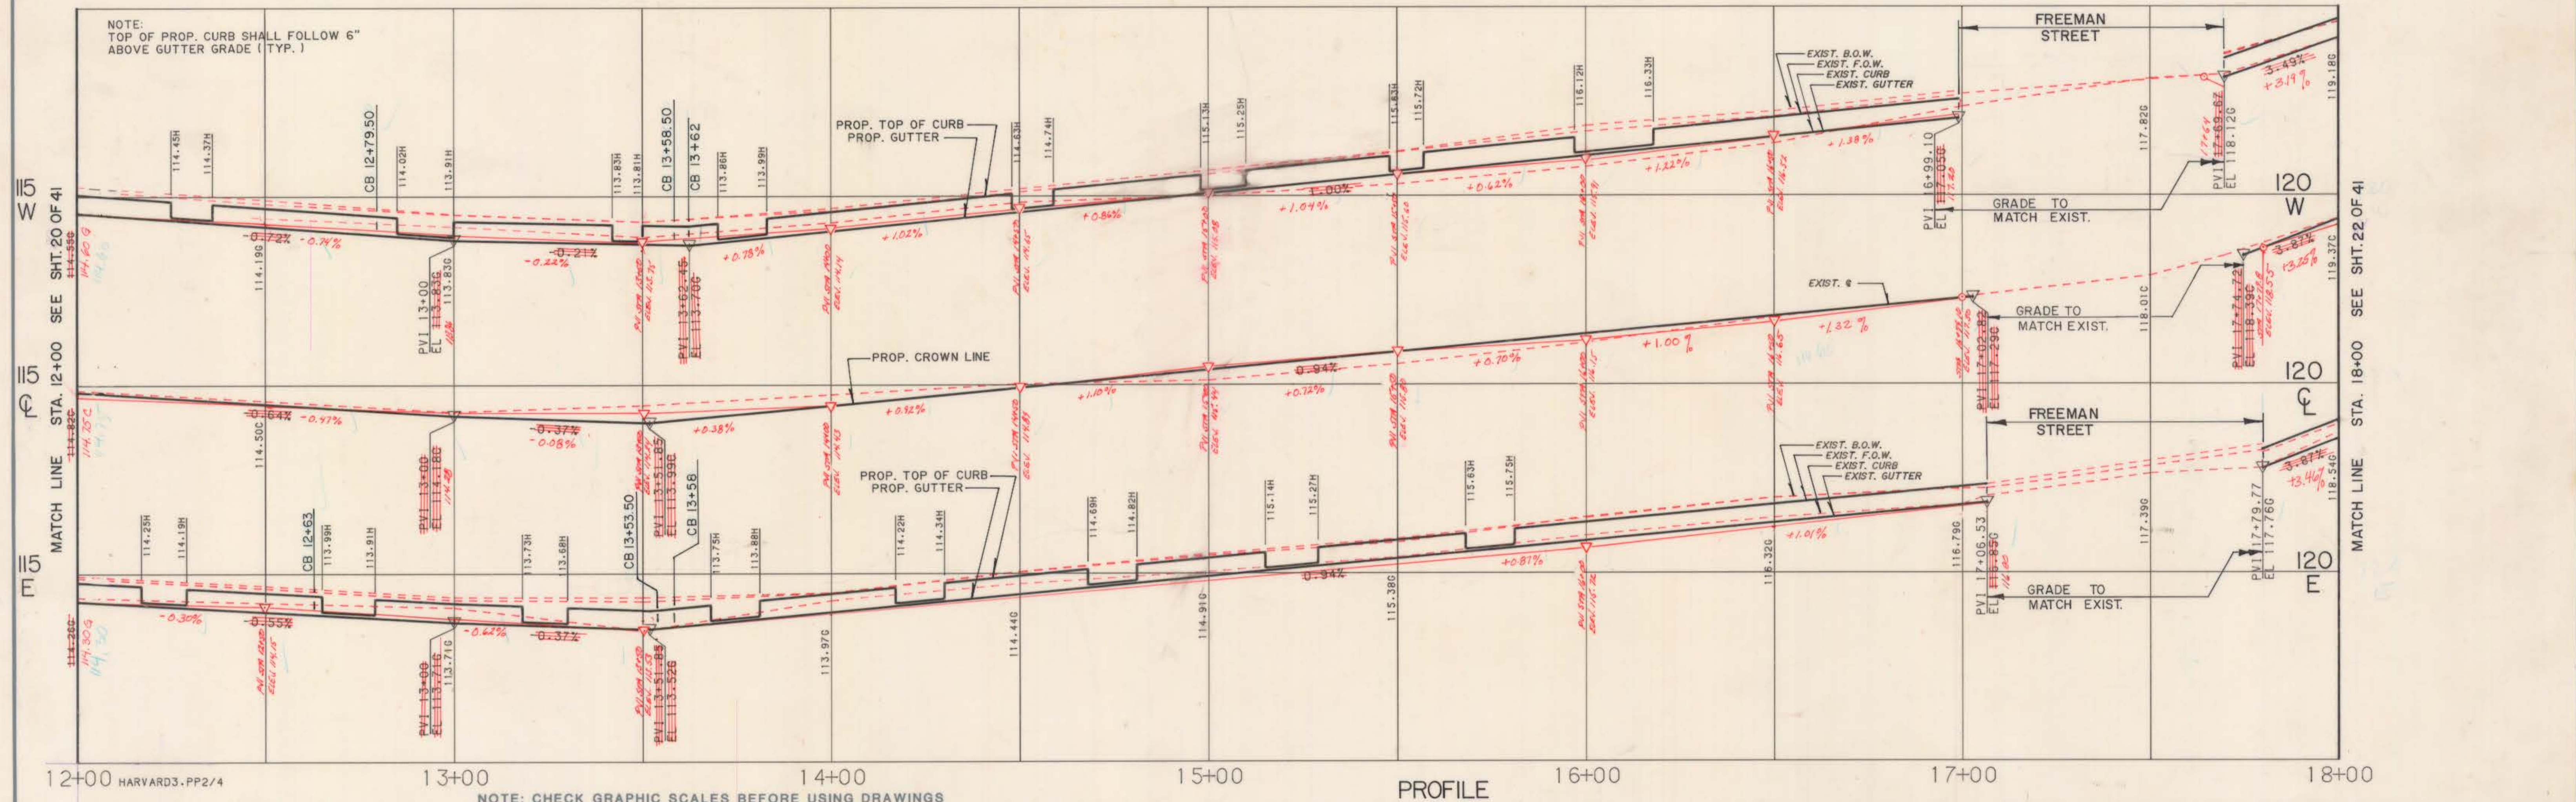


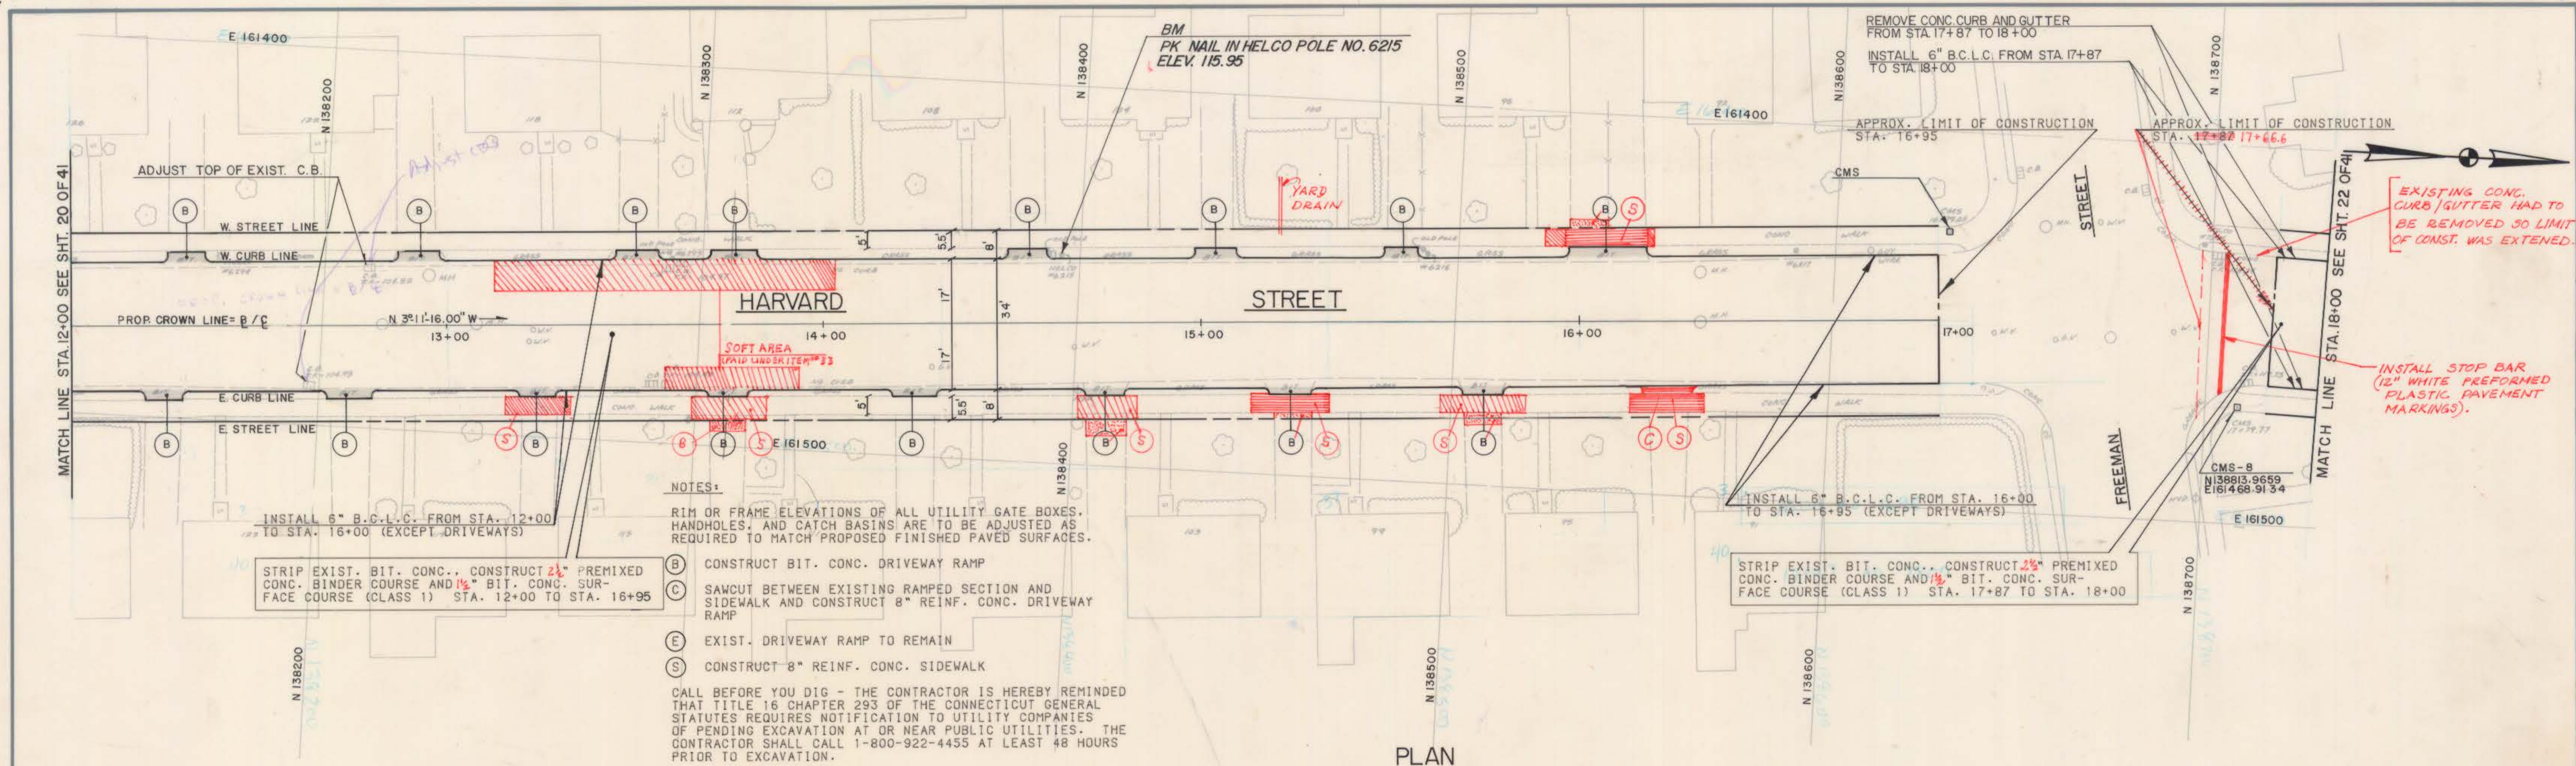

REVISIONS		NO. DATE DESCRIPTION	
1/27/87 Add Plan Notes As Drafted by MTH		JAN 87	
AS BUILT - RED SOLID LINE			
HORIZONTAL AS BUILT BY: MSN			
VERTICAL AS BUILT BY: RJF			
CHECKED BY: MDH			
DATE 02-18-86		DESCRIPTION	
DESIGN MDH/AEC		REVISIONS	
DRAWN N.D. FORNIN			
CHECKED AEC			
DATE 02-18-86			

GRAPHIC SCALES		ROADWAY RECONSTRUCTION	
HORIZ. 1" = 20'		HARTFORD, CONNECTICUT	
VERT. 1" = 2'			

Hayden Wegman		CITY OF HARTFORD, CONNECTICUT	
Consulting Engineers		DEPARTMENT OF PUBLIC WORKS	
WEST HARTFORD		BUREAU OF ENGINEERING SERVICES	
NEW YORK • BOSTON • BUFFALO			
ATLANTA • MEMPHIS			
DAYBOOK NO. 011005		DATE	

HARVARD STREET		PLAN AND PROFILE	
STA. 12+00 TO STA. 18+00		SHEET 21	
Contract No. E-86-3		Job No. - 852534	
		OF 41	