
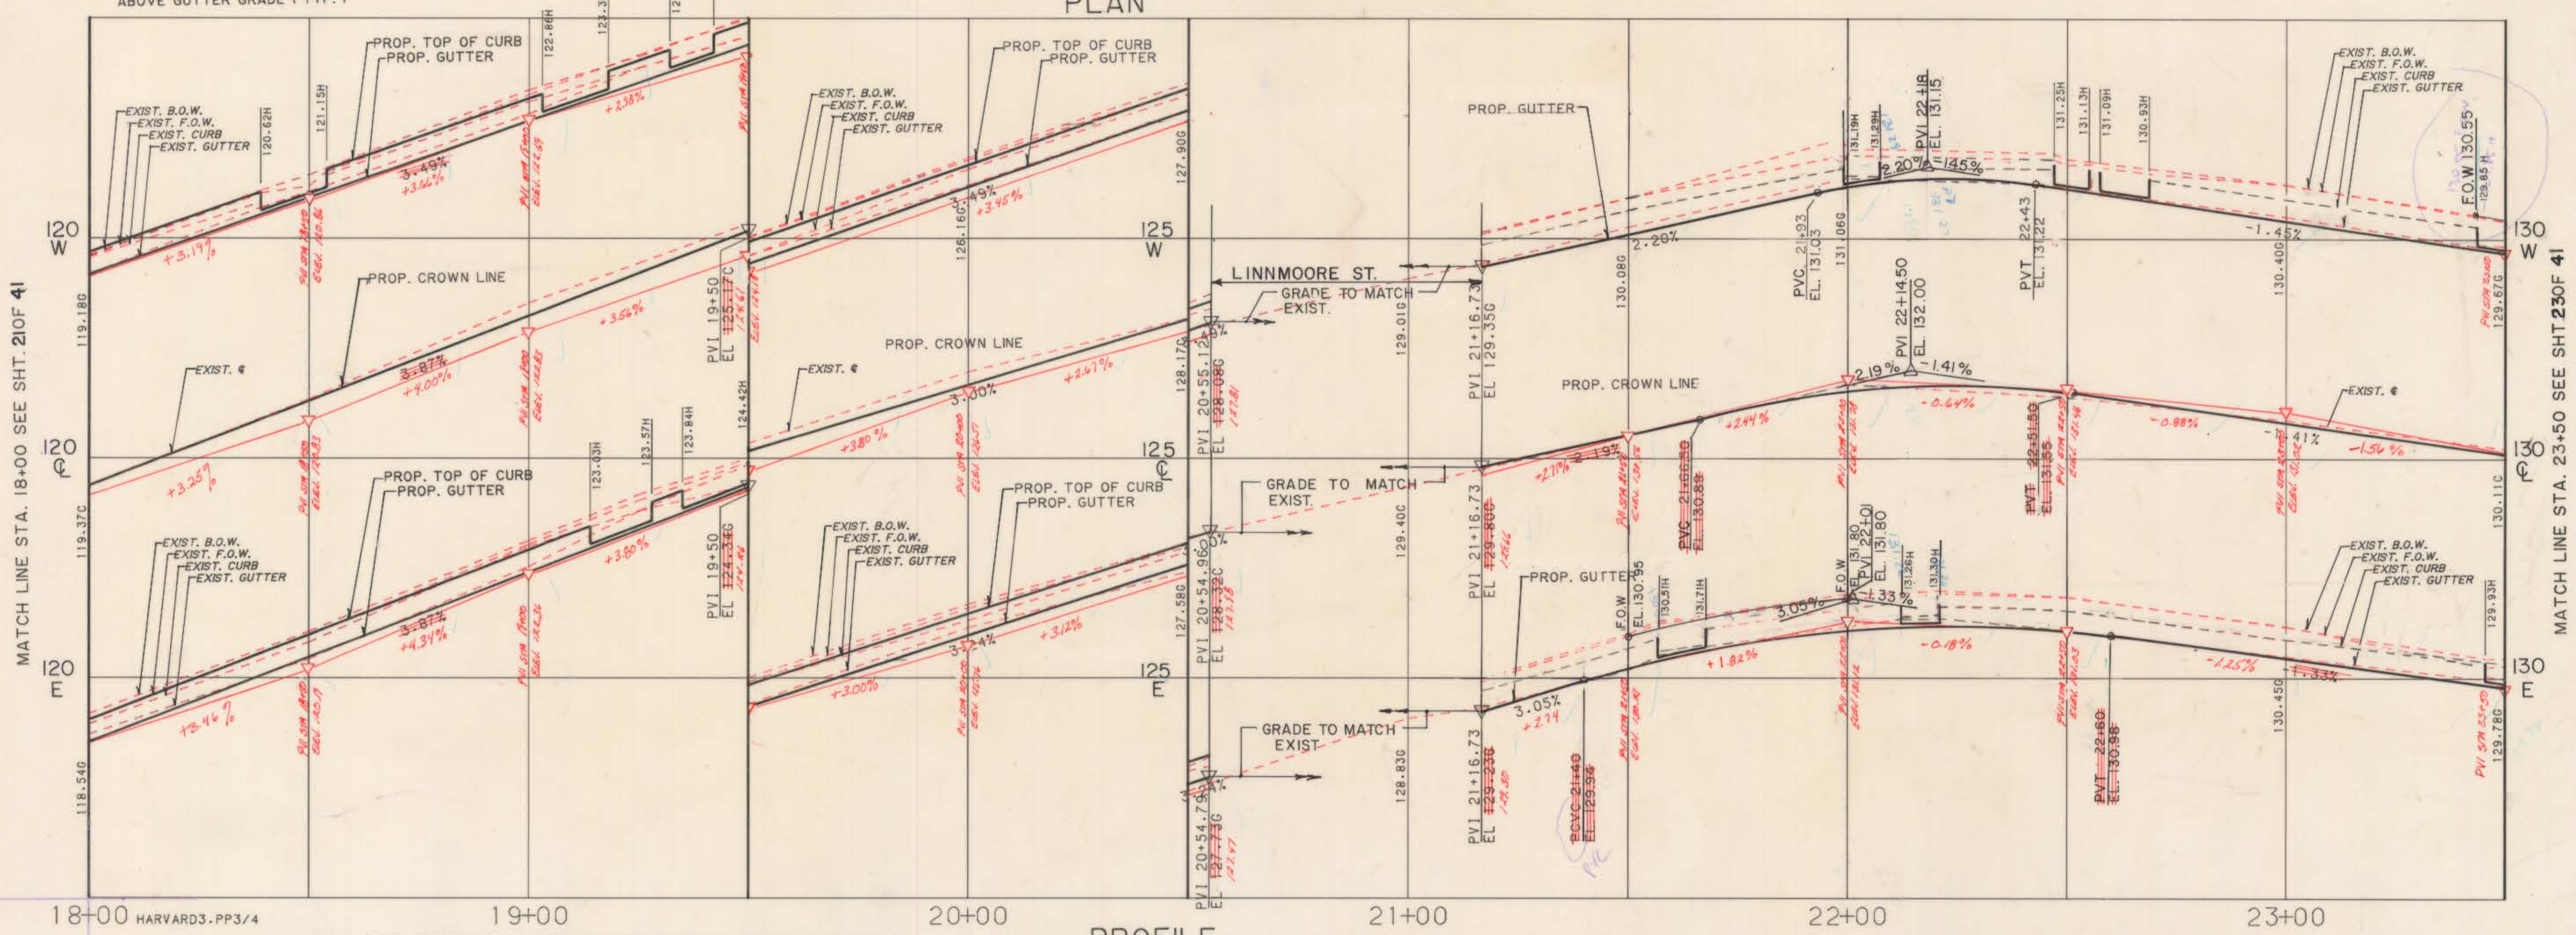


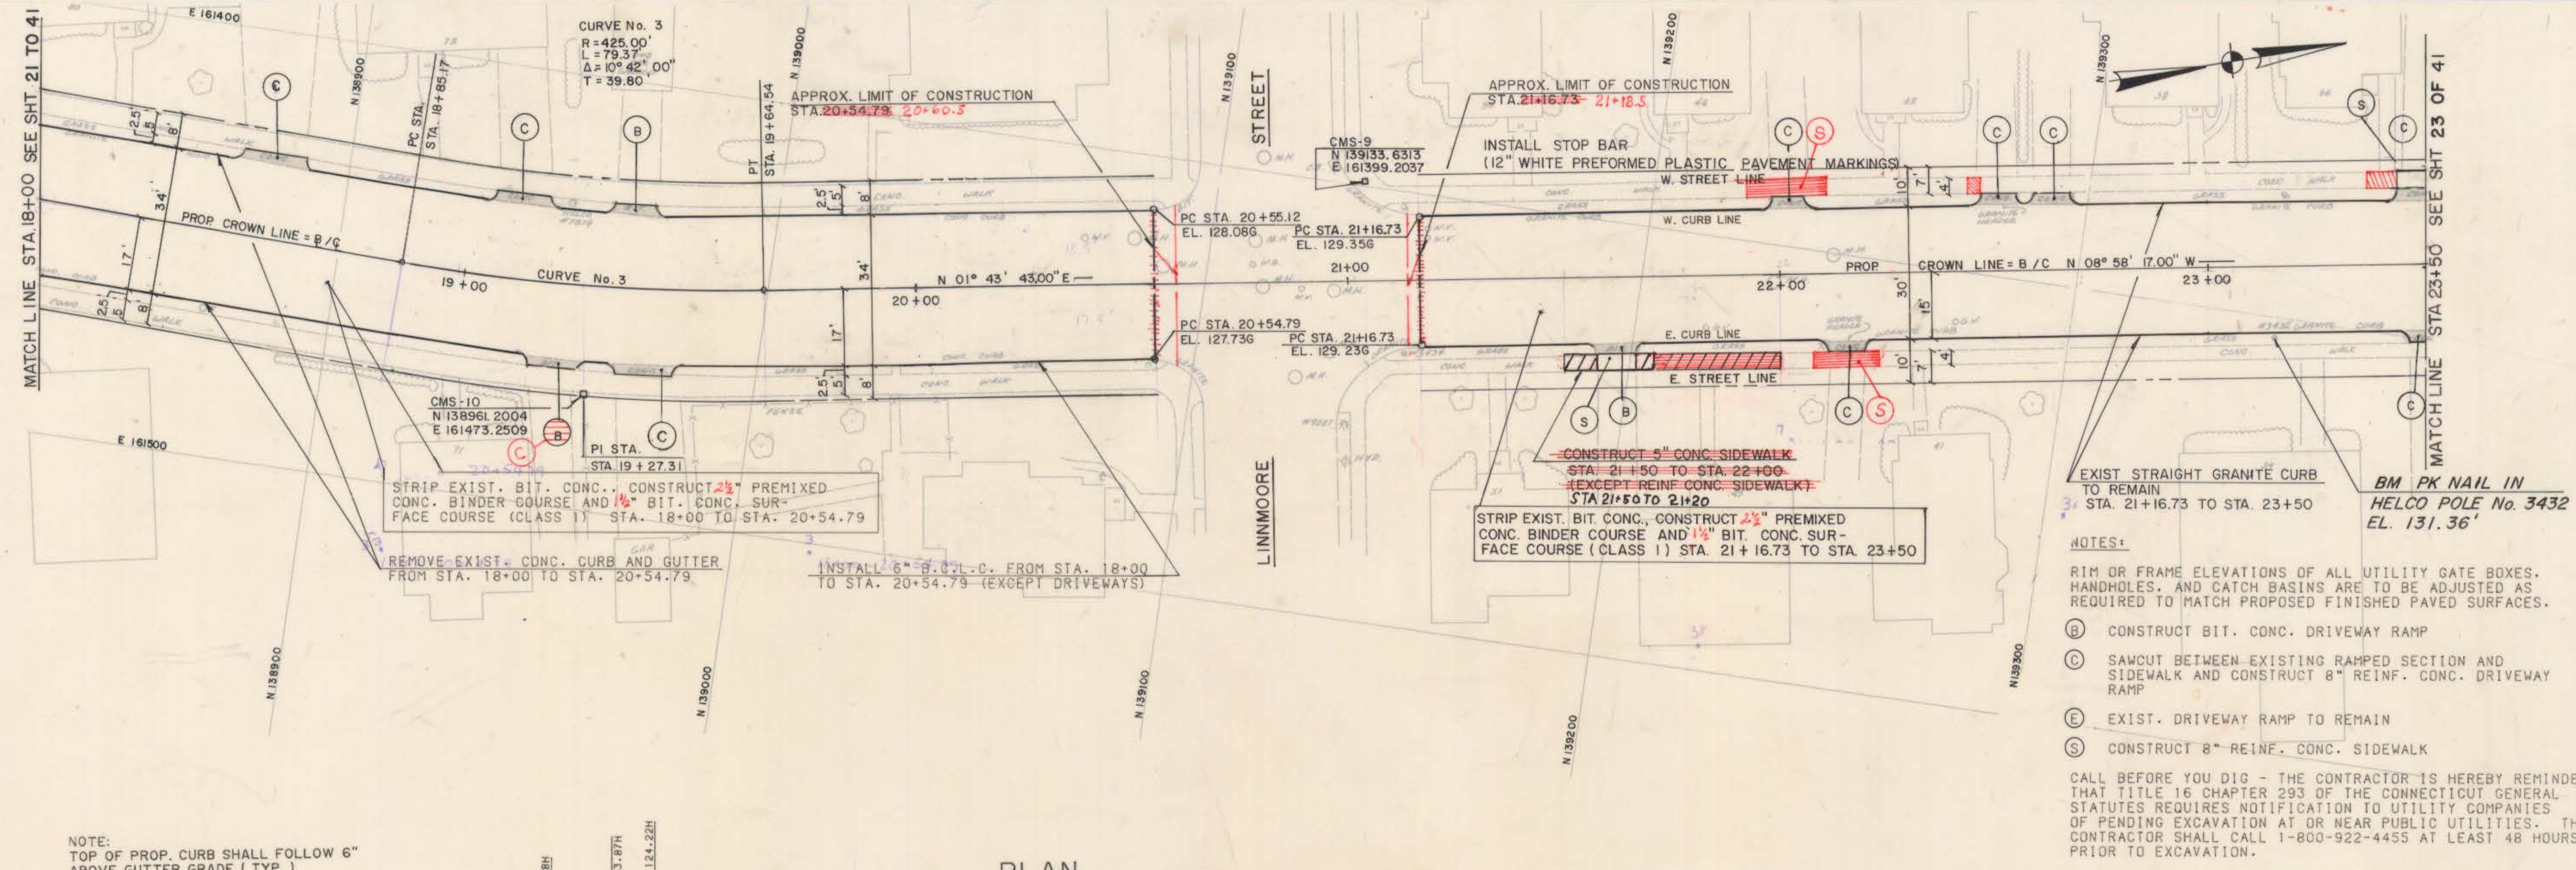

REVISIONS NO. DATE DESCRIPTION 1 1/21/17 VERIFIED AS BUILT DRAWING BY SFP 2 1/21/17 ADD LINE ON PLAN AS BUILT DRAWING BY SFP 3 2/1/17 CHECKED BY MDH		SUPV. JAC DESIGN MDH/AEC DRAWN JRM CHECKED AEC DATE	GRAPHIC SCALES HORIZ. 1" = 20' VERT. 1" = 2'	ROADWAY RECONSTRUCTION HARTFORD, CONNECTICUT		Hayden Wegman Consulting Engineers WEST HARTFORD NEW YORK • BOSTON • BUFFALO ATLANTA • MEMPHIS	CITY OF HARTFORD, CONNECTICUT DEPARTMENT OF PUBLIC WORKS BUREAU OF ENGINEERING SERVICES DAYBOOK NO. 011005 DATE	HARVARD STREET STA. 18+00 TO STA. 23+50 PLAN AND PROFILE CONTRACT NO. E86-3 Job No. 852534	SHEET 22 OF 41
---	--	---	--	---	--	---	---	--	-------------------