



NOTES:

RIM OR FRAME ELEVATIONS OF ALL UTILITY GATE BOXES, HANDHOLES, AND CATCH BASINS ARE TO BE ADJUSTED AS REQUIRED TO MATCH PROPOSED FINISHED PAVED SURFACES.



(B) CONSTRUCT BIT. CONC. DRIVEWAY RAMP

(C) SAWCUT BETWEEN EXISTING RAMPED SECTION AND SIDEWALK AND CONSTRUCT 8" REINF. CONC. DRIVEWAY RAMP

(E) EXIST. DRIVEWAY RAMP TO REMAIN

(S) CONSTRUCT 8" REINF. CONC. SIDEWALK

CALL BEFORE YOU DIG - THE CONTRACTOR IS HEREBY REMINDED THAT TITLE 16 CHAPTER 293 OF THE CONNECTICUT GENERAL STATUTES REQUIRES NOTIFICATION TO UTILITY COMPANIES OF PENDING EXCAVATION AT OR NEAR PUBLIC UTILITIES. THE CONTRACTOR SHALL CALL 1-800-922-4455 AT LEAST 48 HOURS PRIOR TO EXCAVATION.

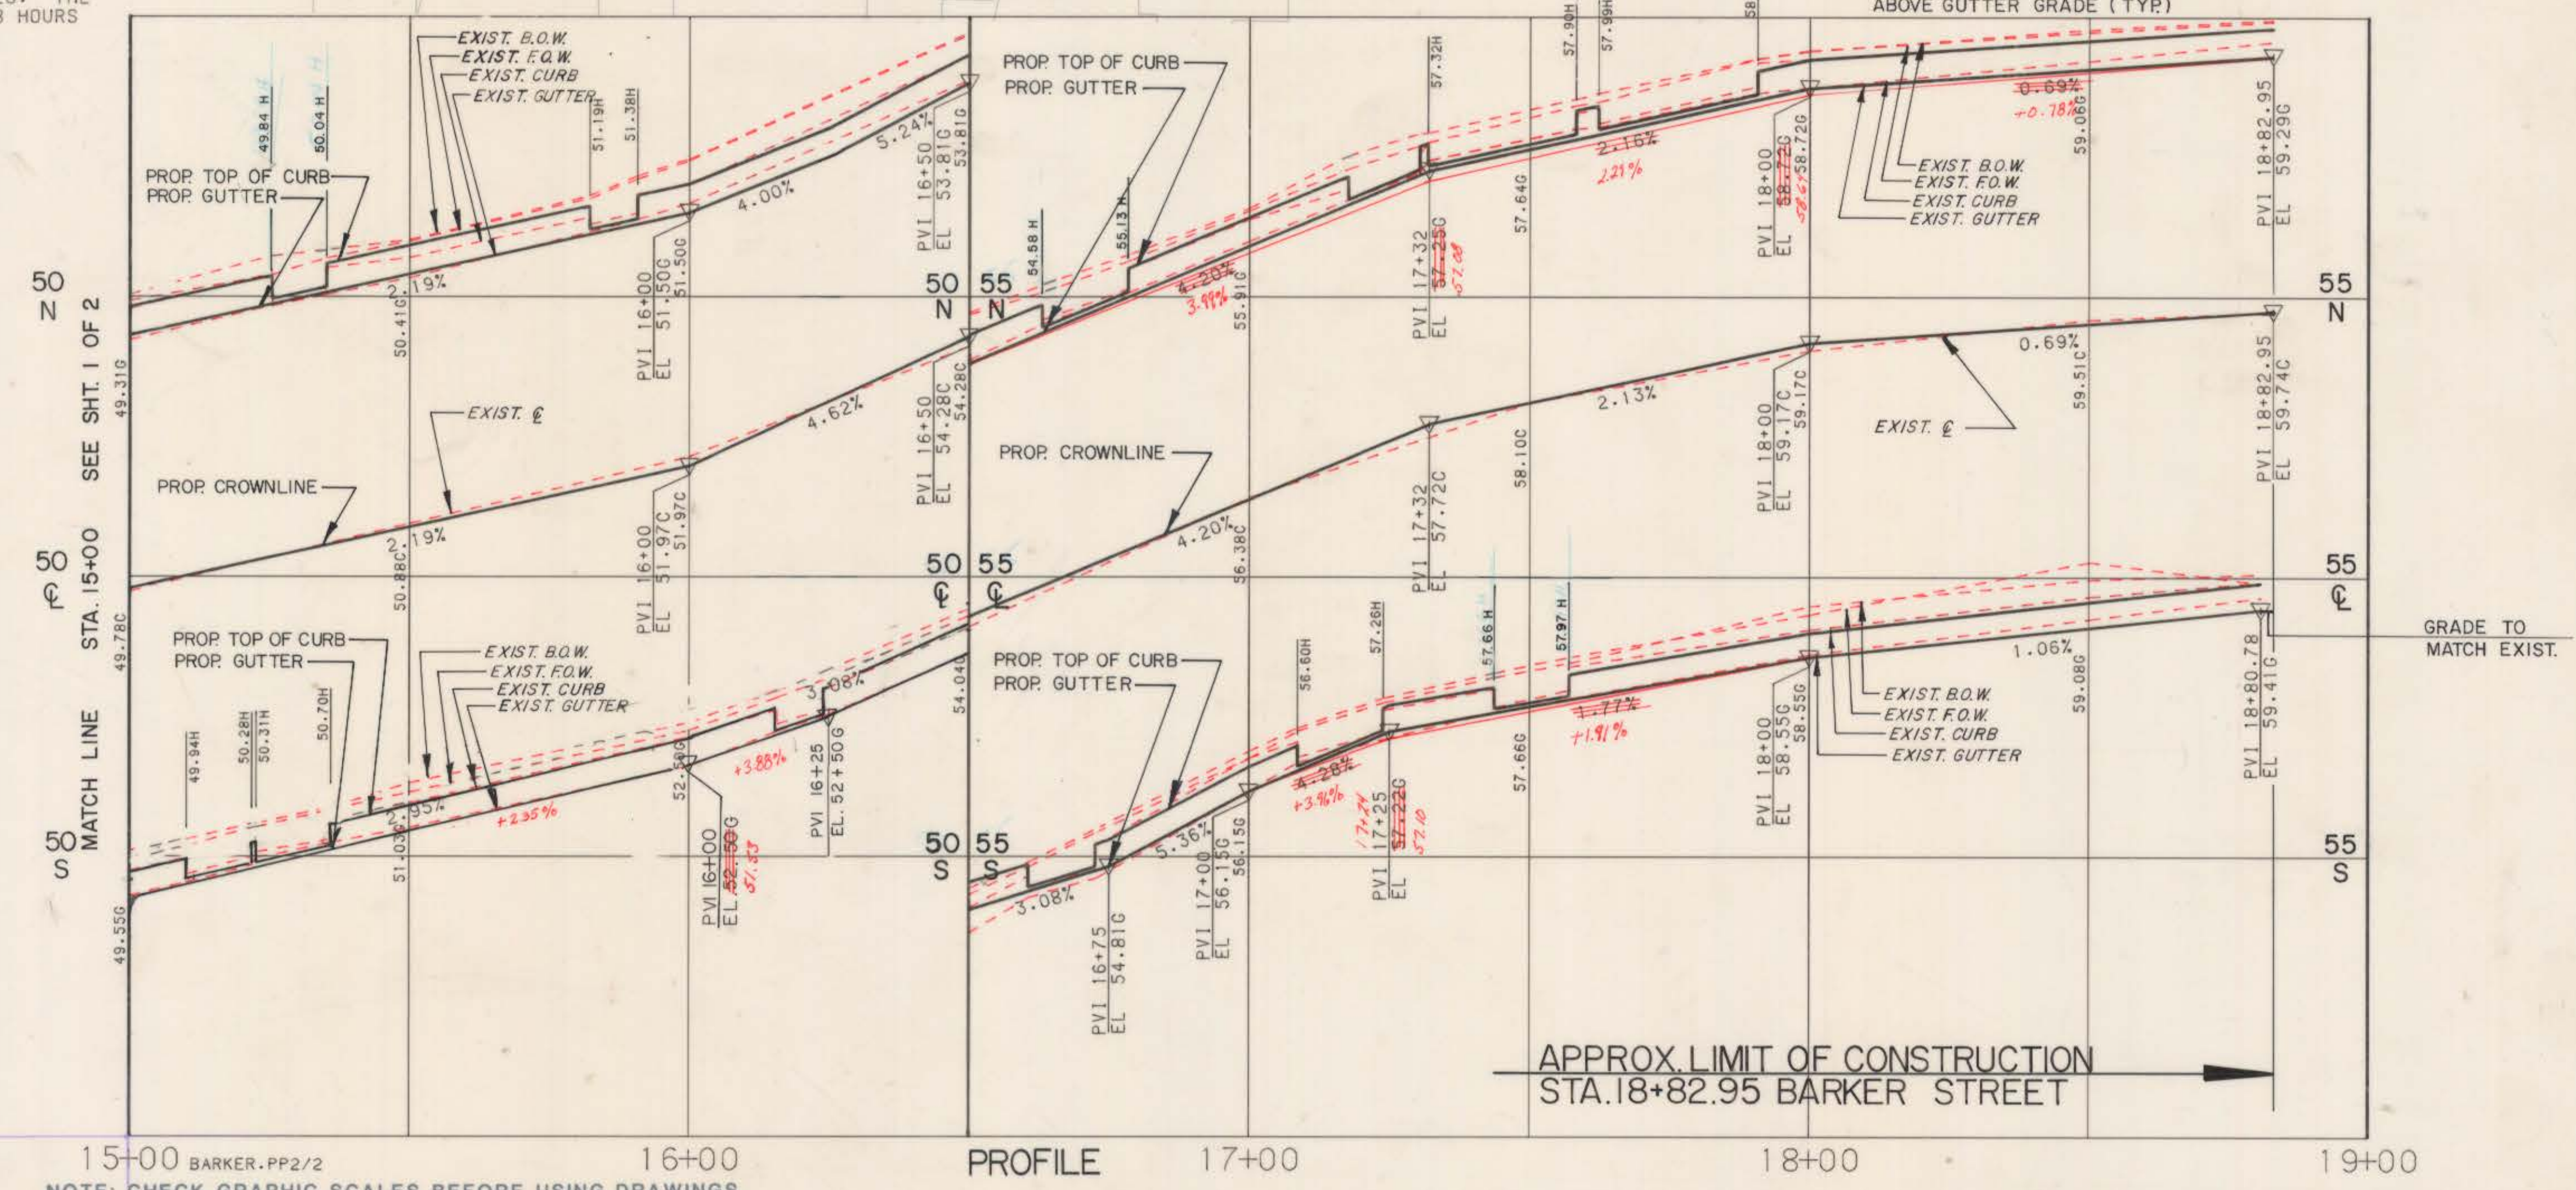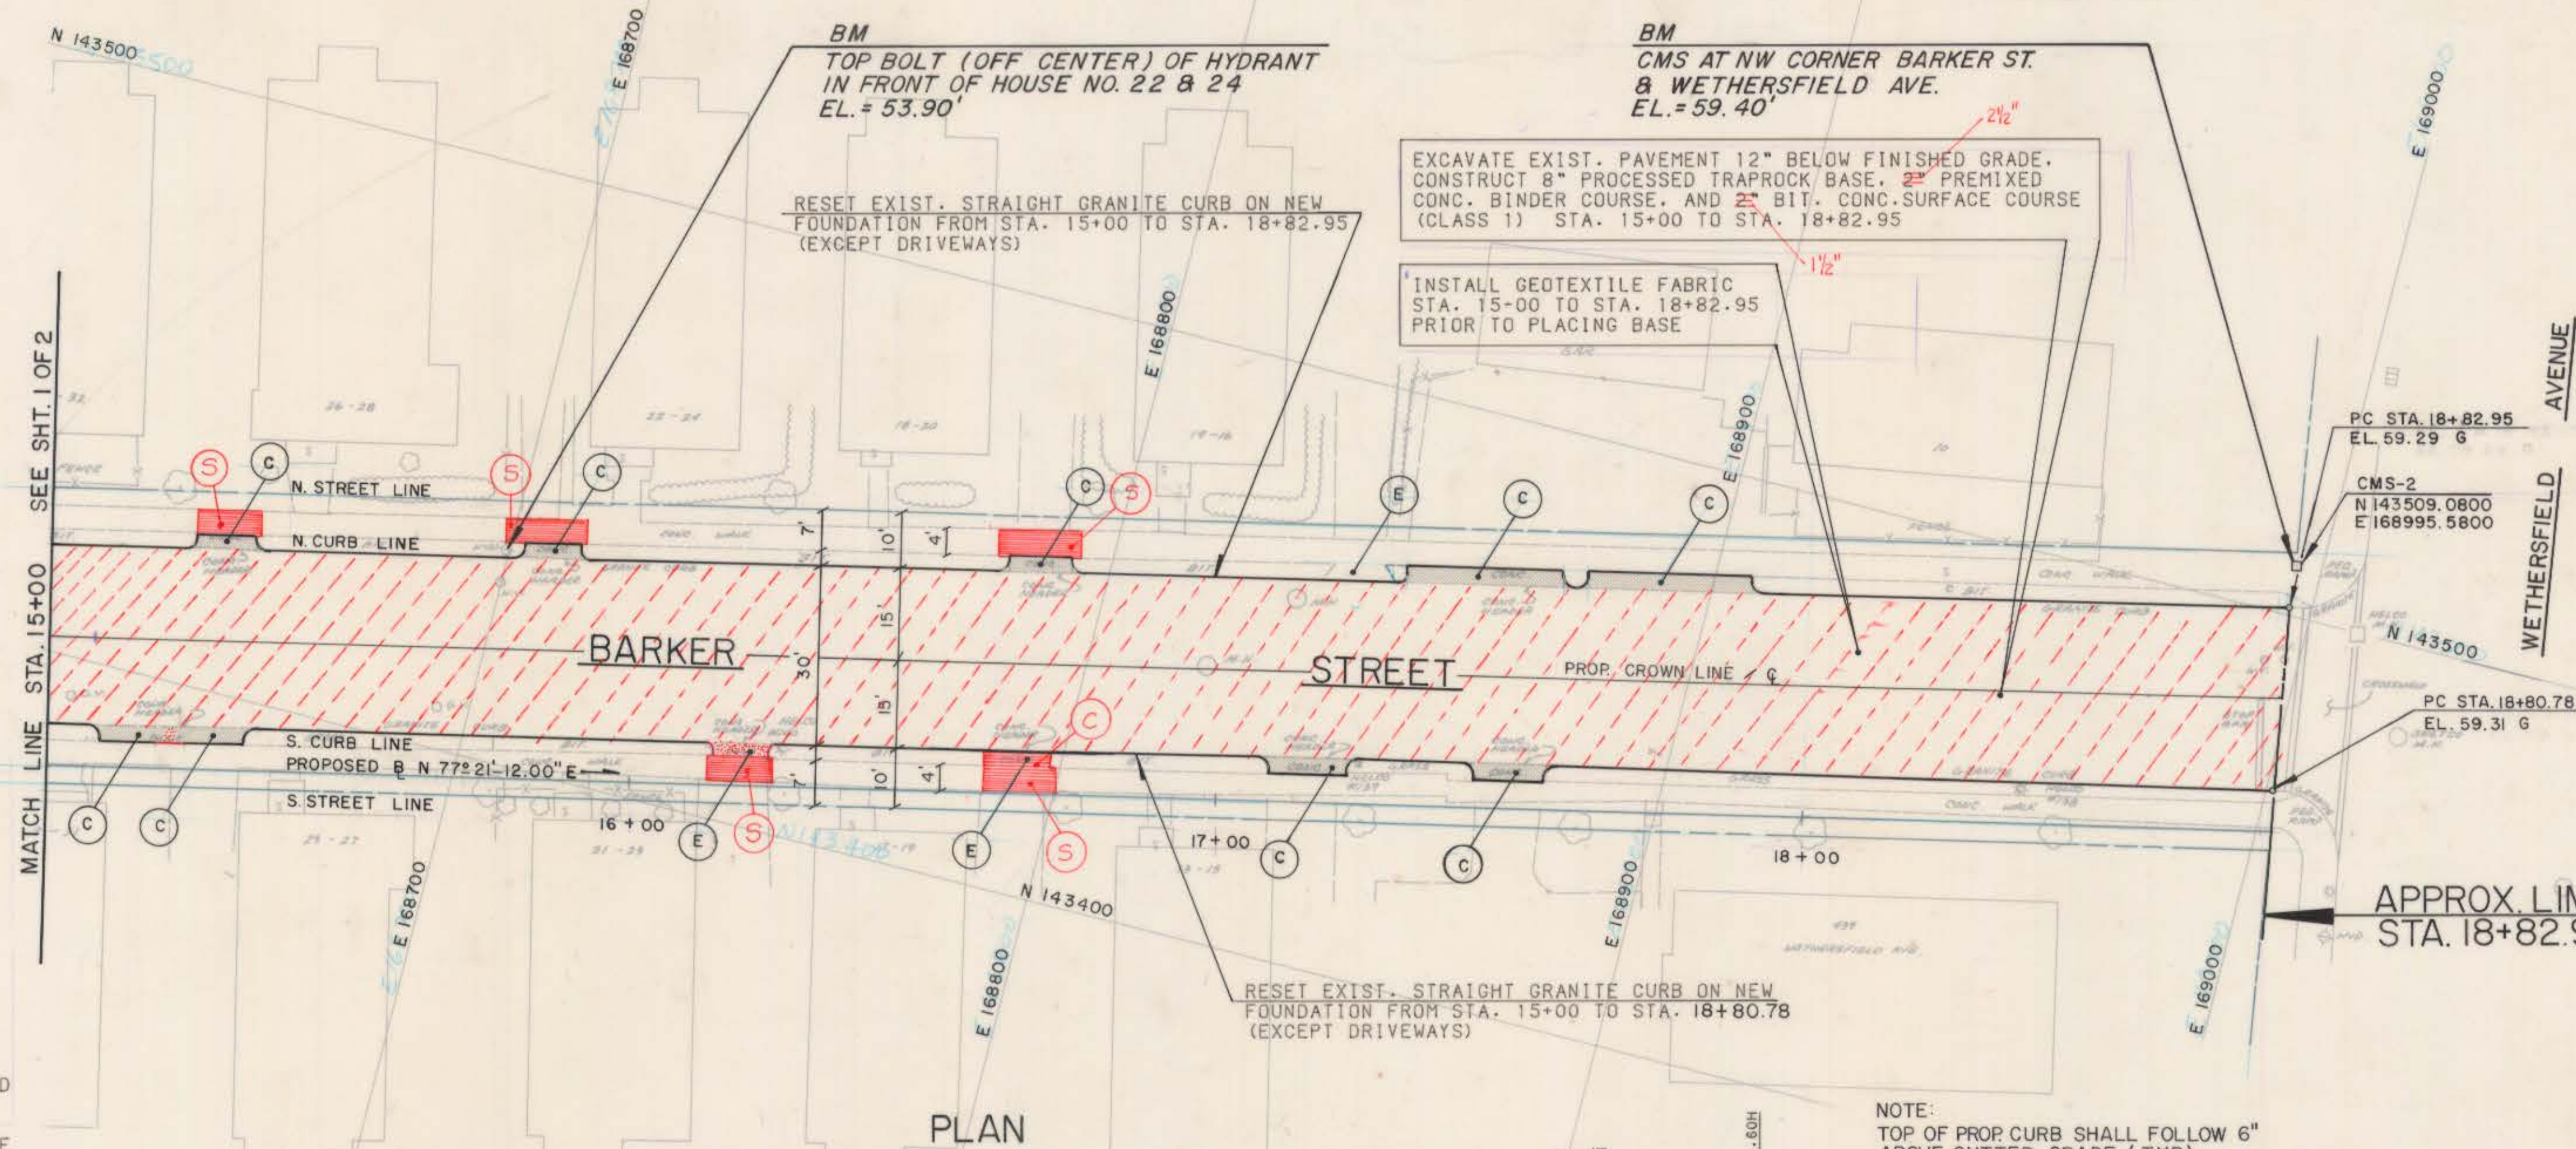

NO.	DATE	DESCRIPTION
1	1/21/87	ADD (OFF-EX) AS BUILT - DRAWN BY MTR
2	1/21/87	AS BUILT BY RJP
3	1/21/87	CHECKED BY MCL

SUPV.	JAC
DESIGN	MDH/AEC
DRAWN	ND.FORIN
CHECKED	AEC
DATE	02-12-86

GRAPHIC SCALES
HORIZ. 1" = 20'
VERT. 1" = 2'

ROADWAY RECONSTRUCTION
HARTFORD, CONNECTICUT

Hayden | Wegman
Consulting Engineers
WEST HARTFORD
NEW YORK • BOSTON • BUFFALO
ATLANTA • MEMPHIS

CITY OF HARTFORD, CONNECTICUT
DEPARTMENT OF PUBLIC WORKS
BUREAU OF ENGINEERING SERVICES
DAYBOOK NO. 011005
DATE

BARKER STREET
STA. 15+00 TO STA. 18+82.95
PLAN AND PROFILE
Contract No. E86 Job No. - 852534
SHEET 2 OF 41