
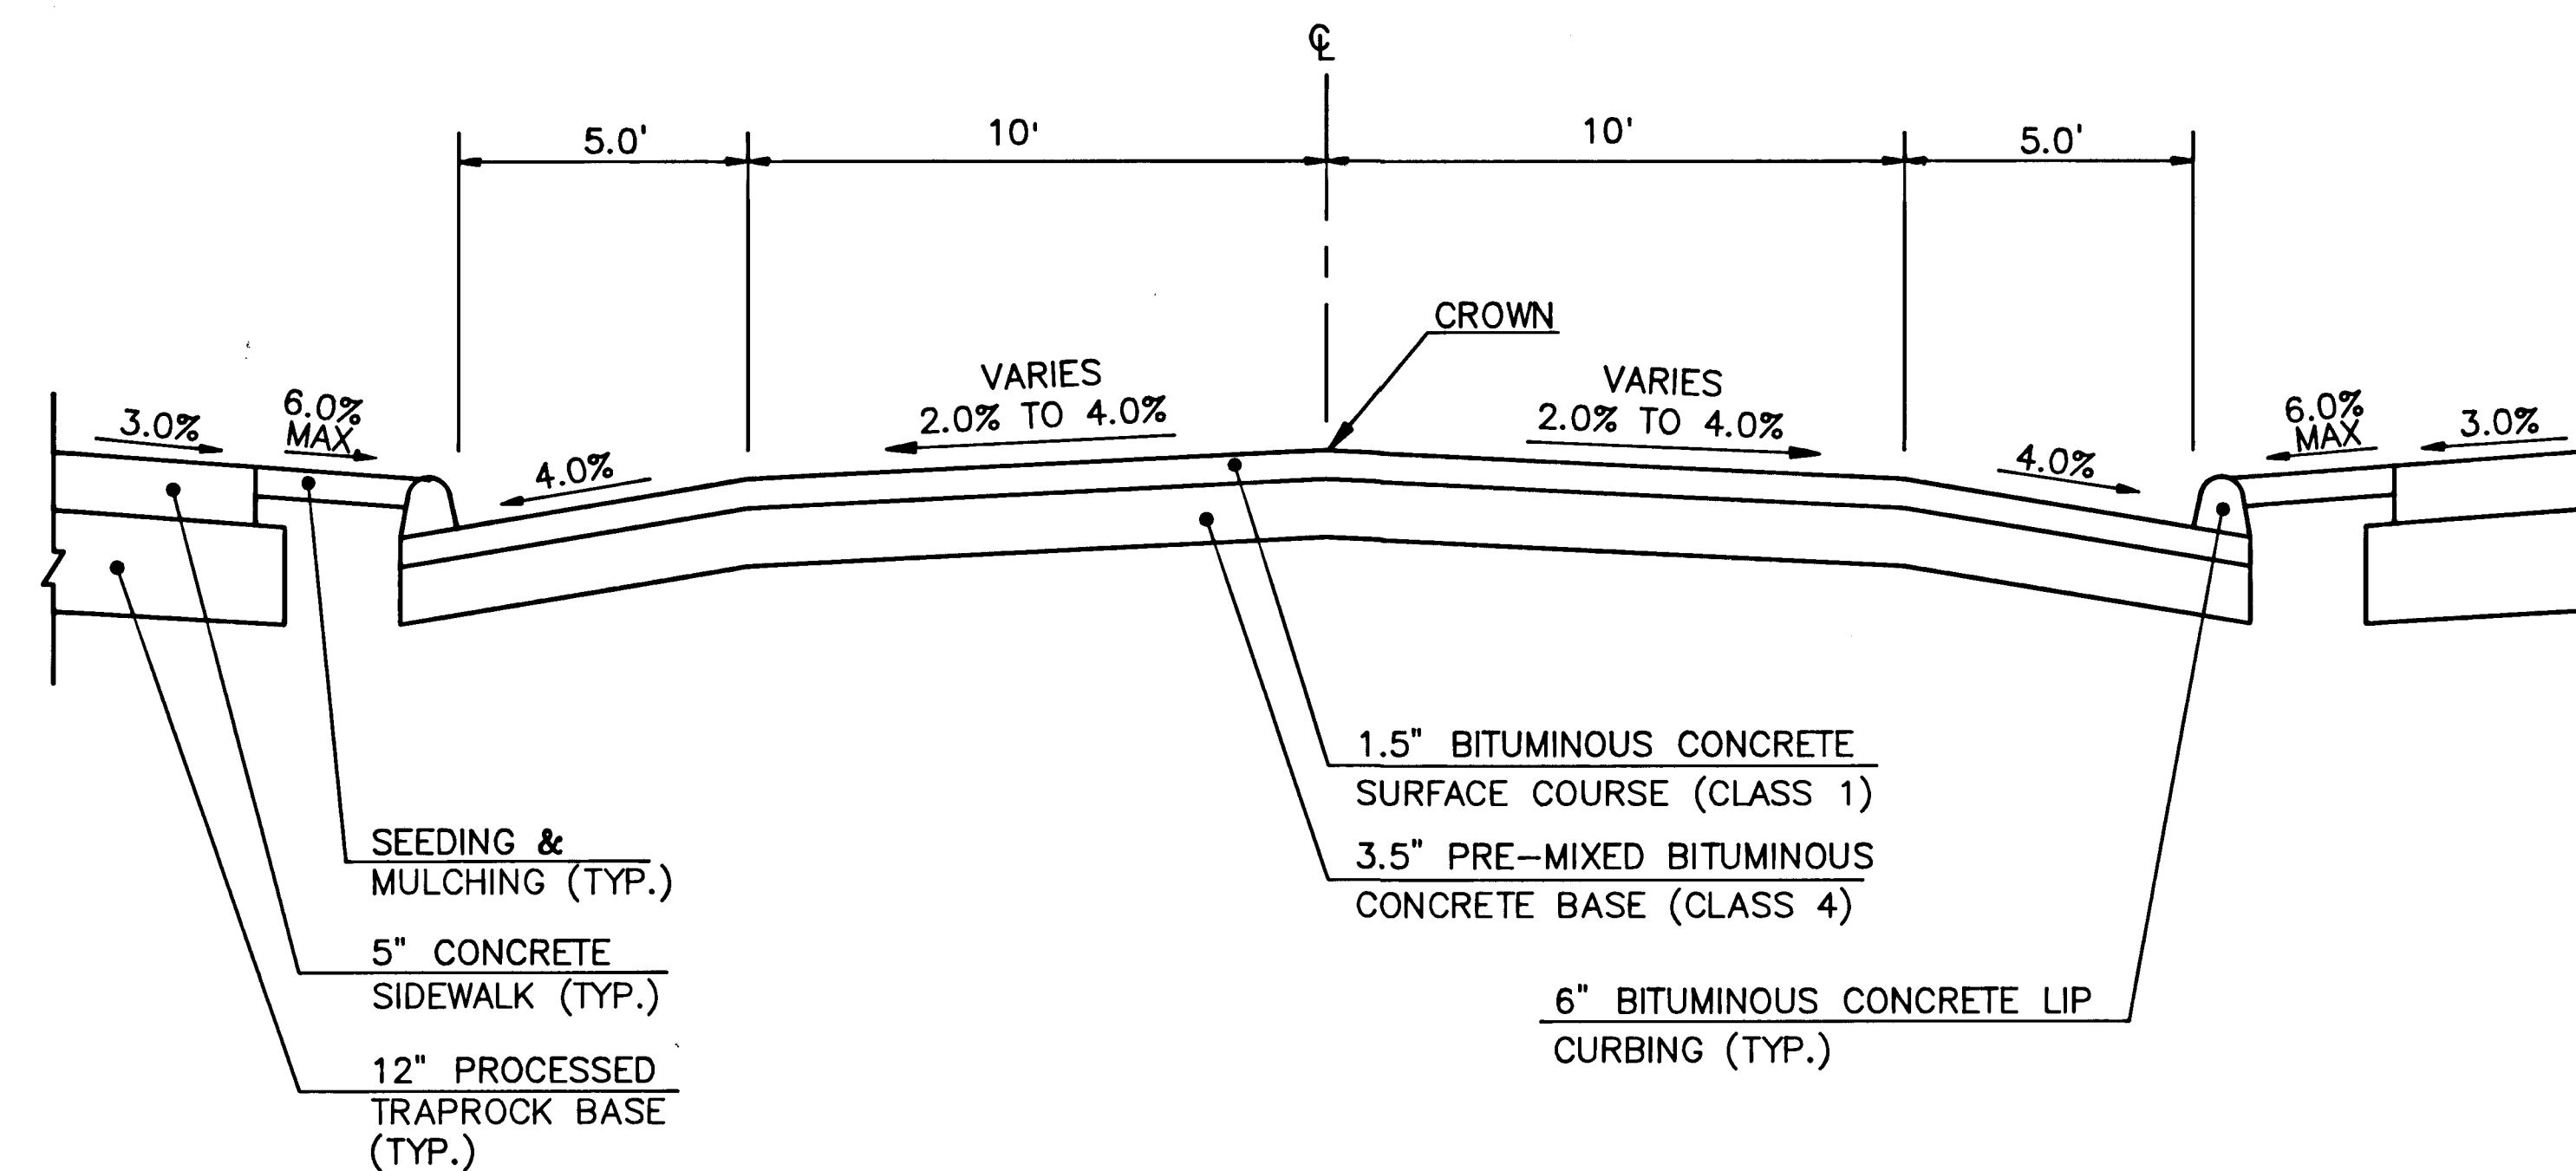
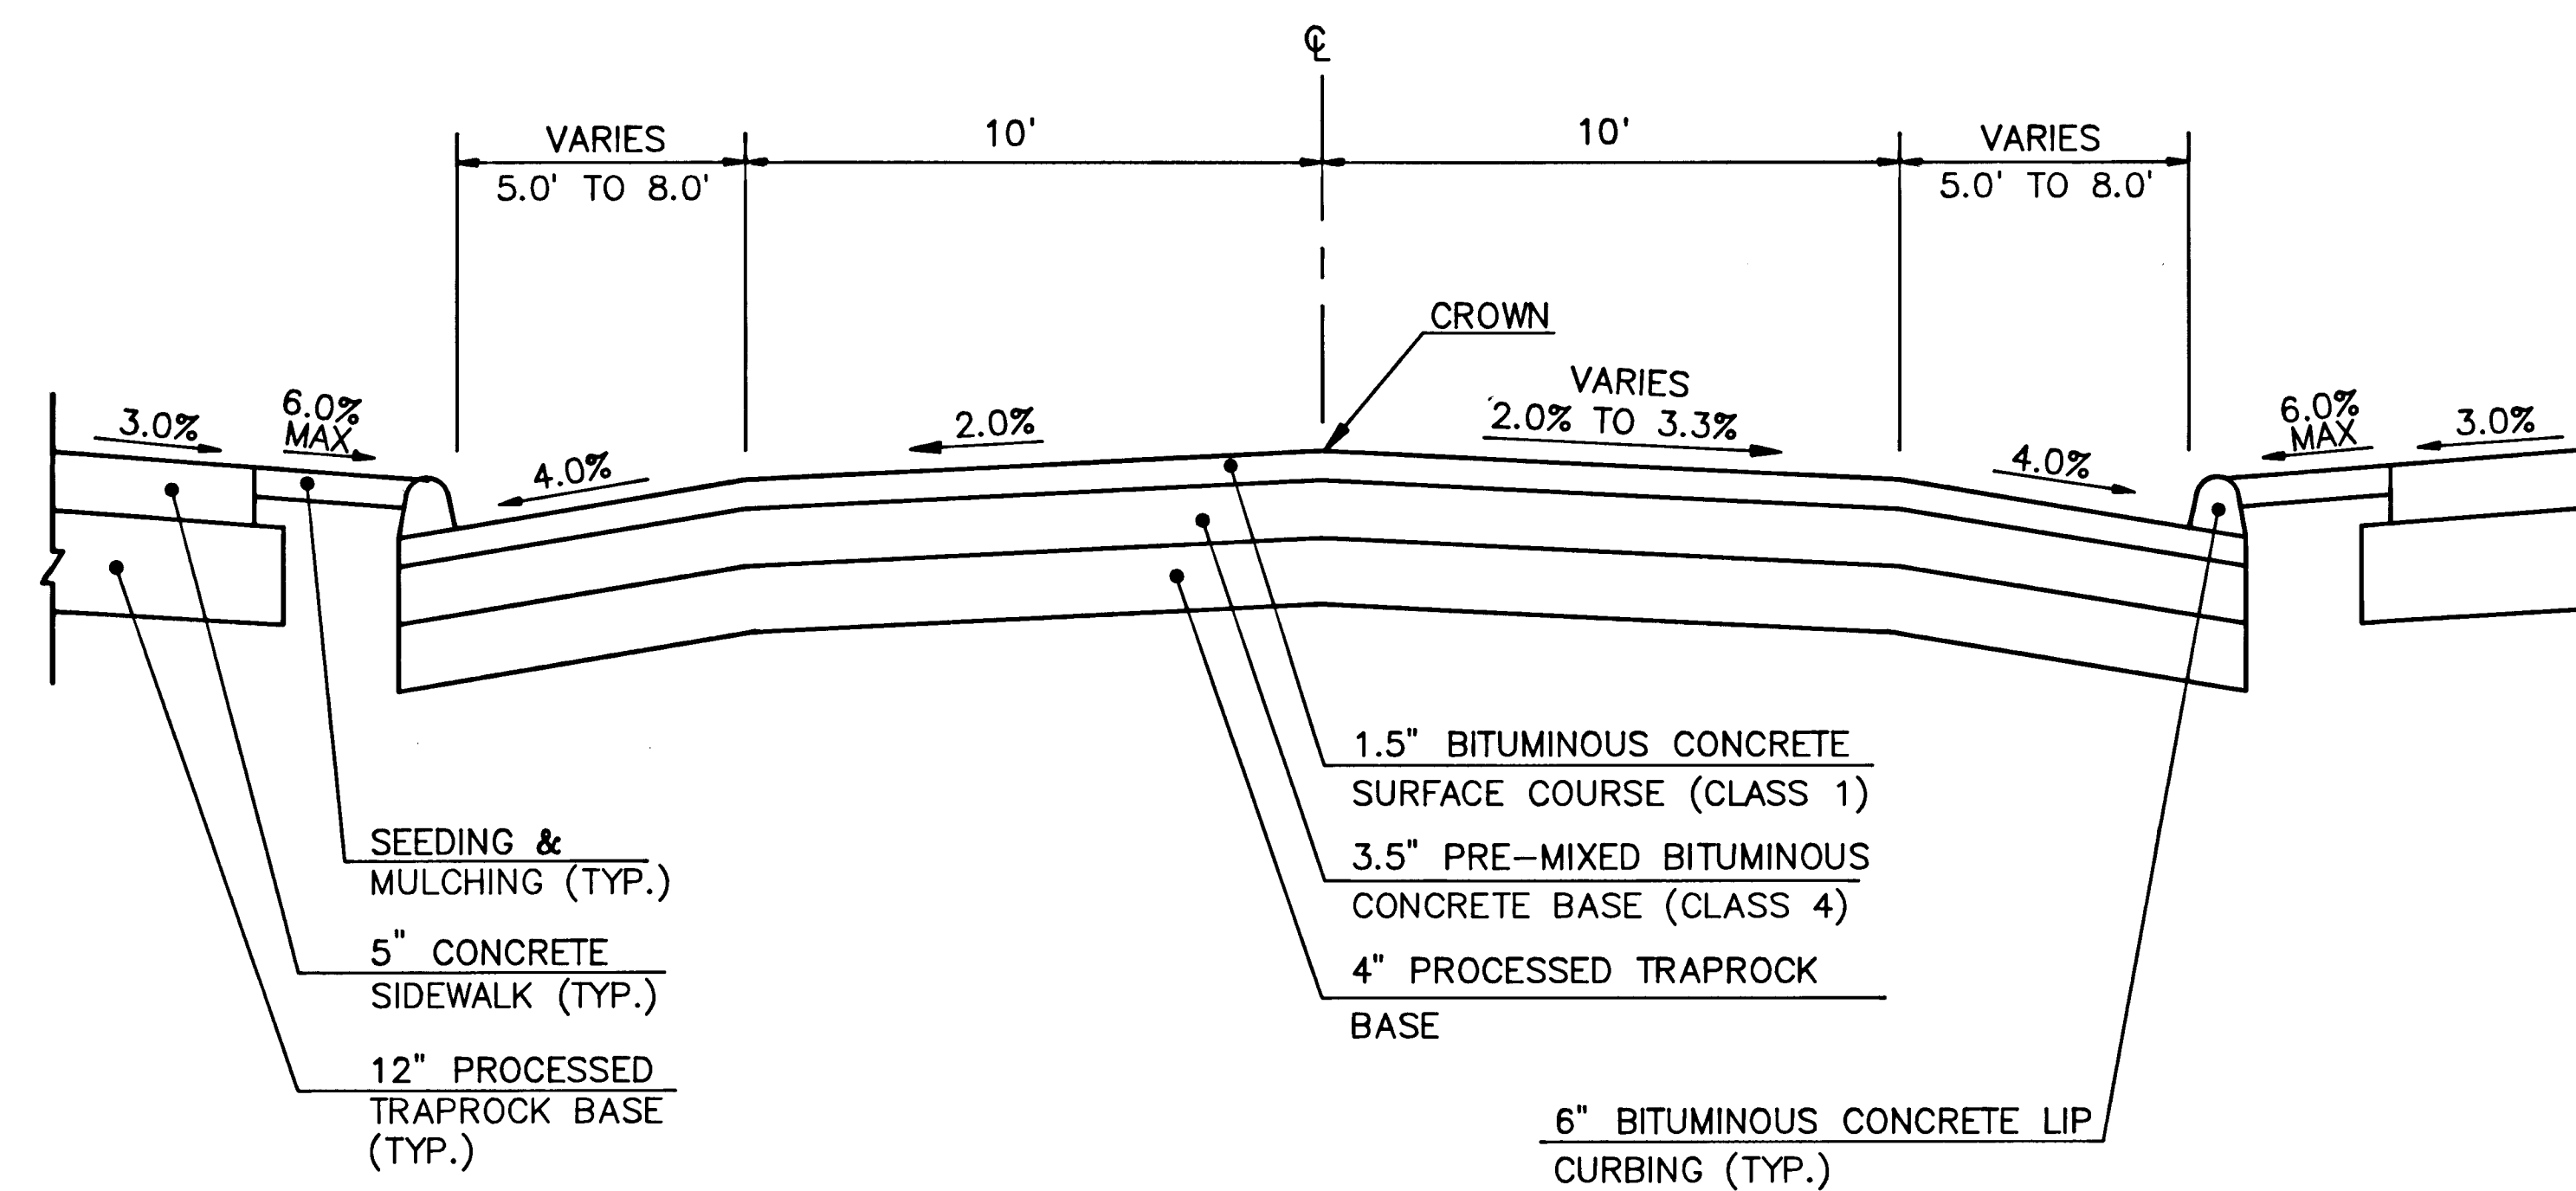


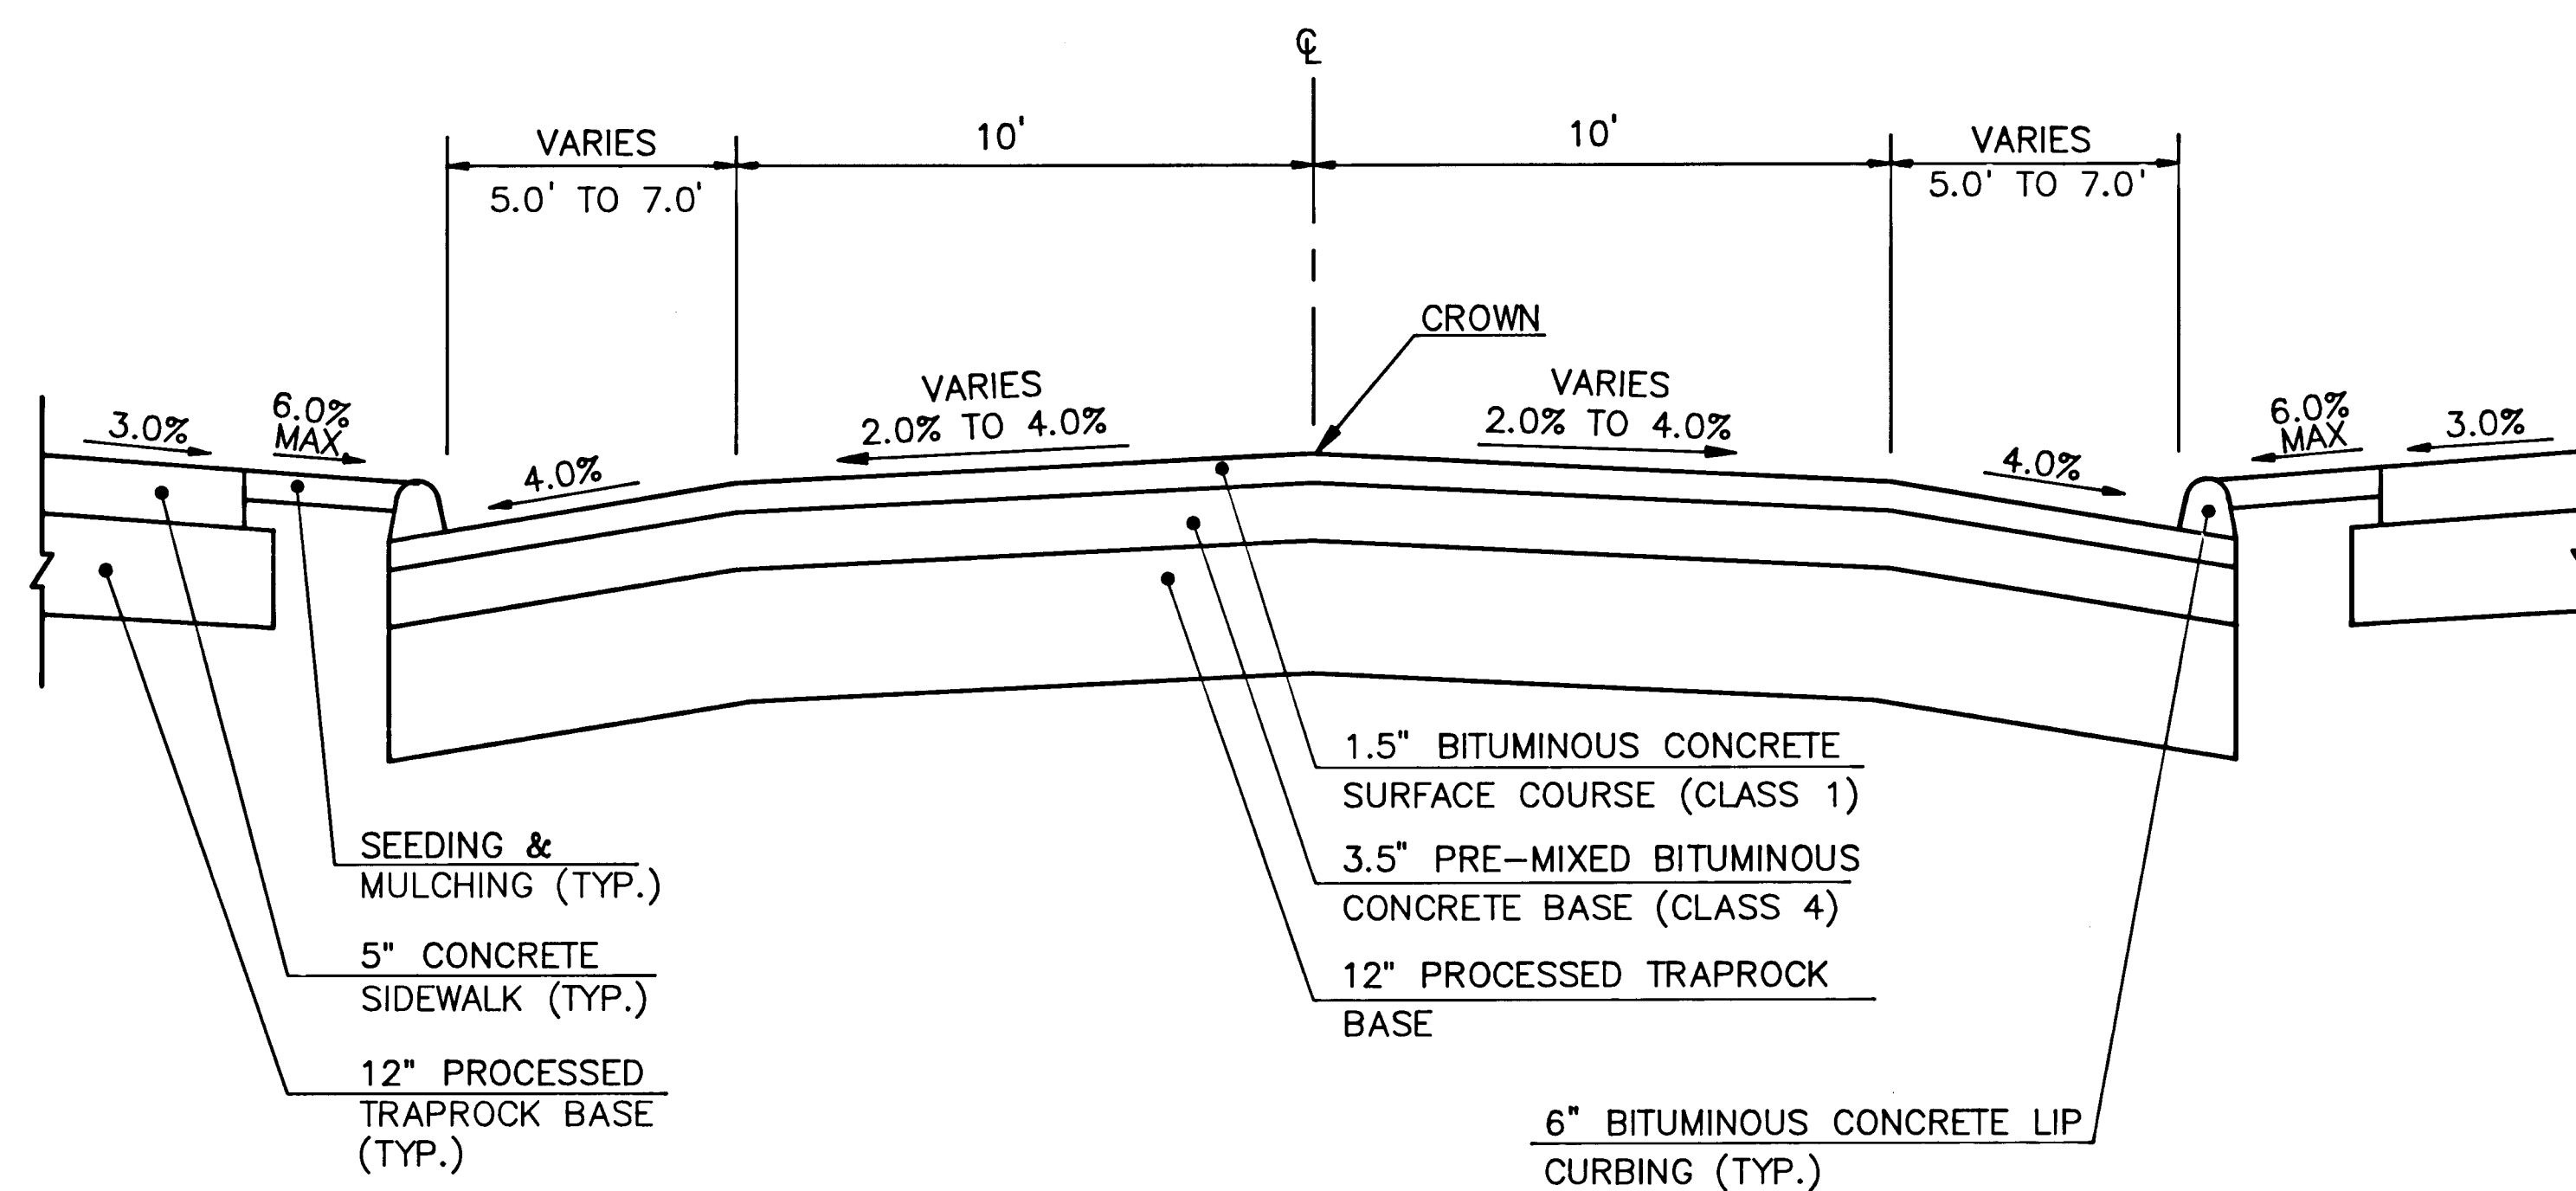

	JUN 90	AS BUILT	
NO.	DATE	REVISION	
DESIGNED: P.L.	DATE <u>MARCH 23, 1980</u>		
DRAWN: T.N.S.			
CHECKED: A.M.			
APPROVED: R.C.G.			
		SCALE <u>N.T.S.</u>	

CONTRACT NO. E88-07 AREA II

TYPICAL CROSS SECTIONS

THE CITY OF
HARTFORD, CONNECTICUT



PURCELL
ASSOCIATES

	SHEET NO.
	3 OF 48
	DAYBOOK N
	01113