



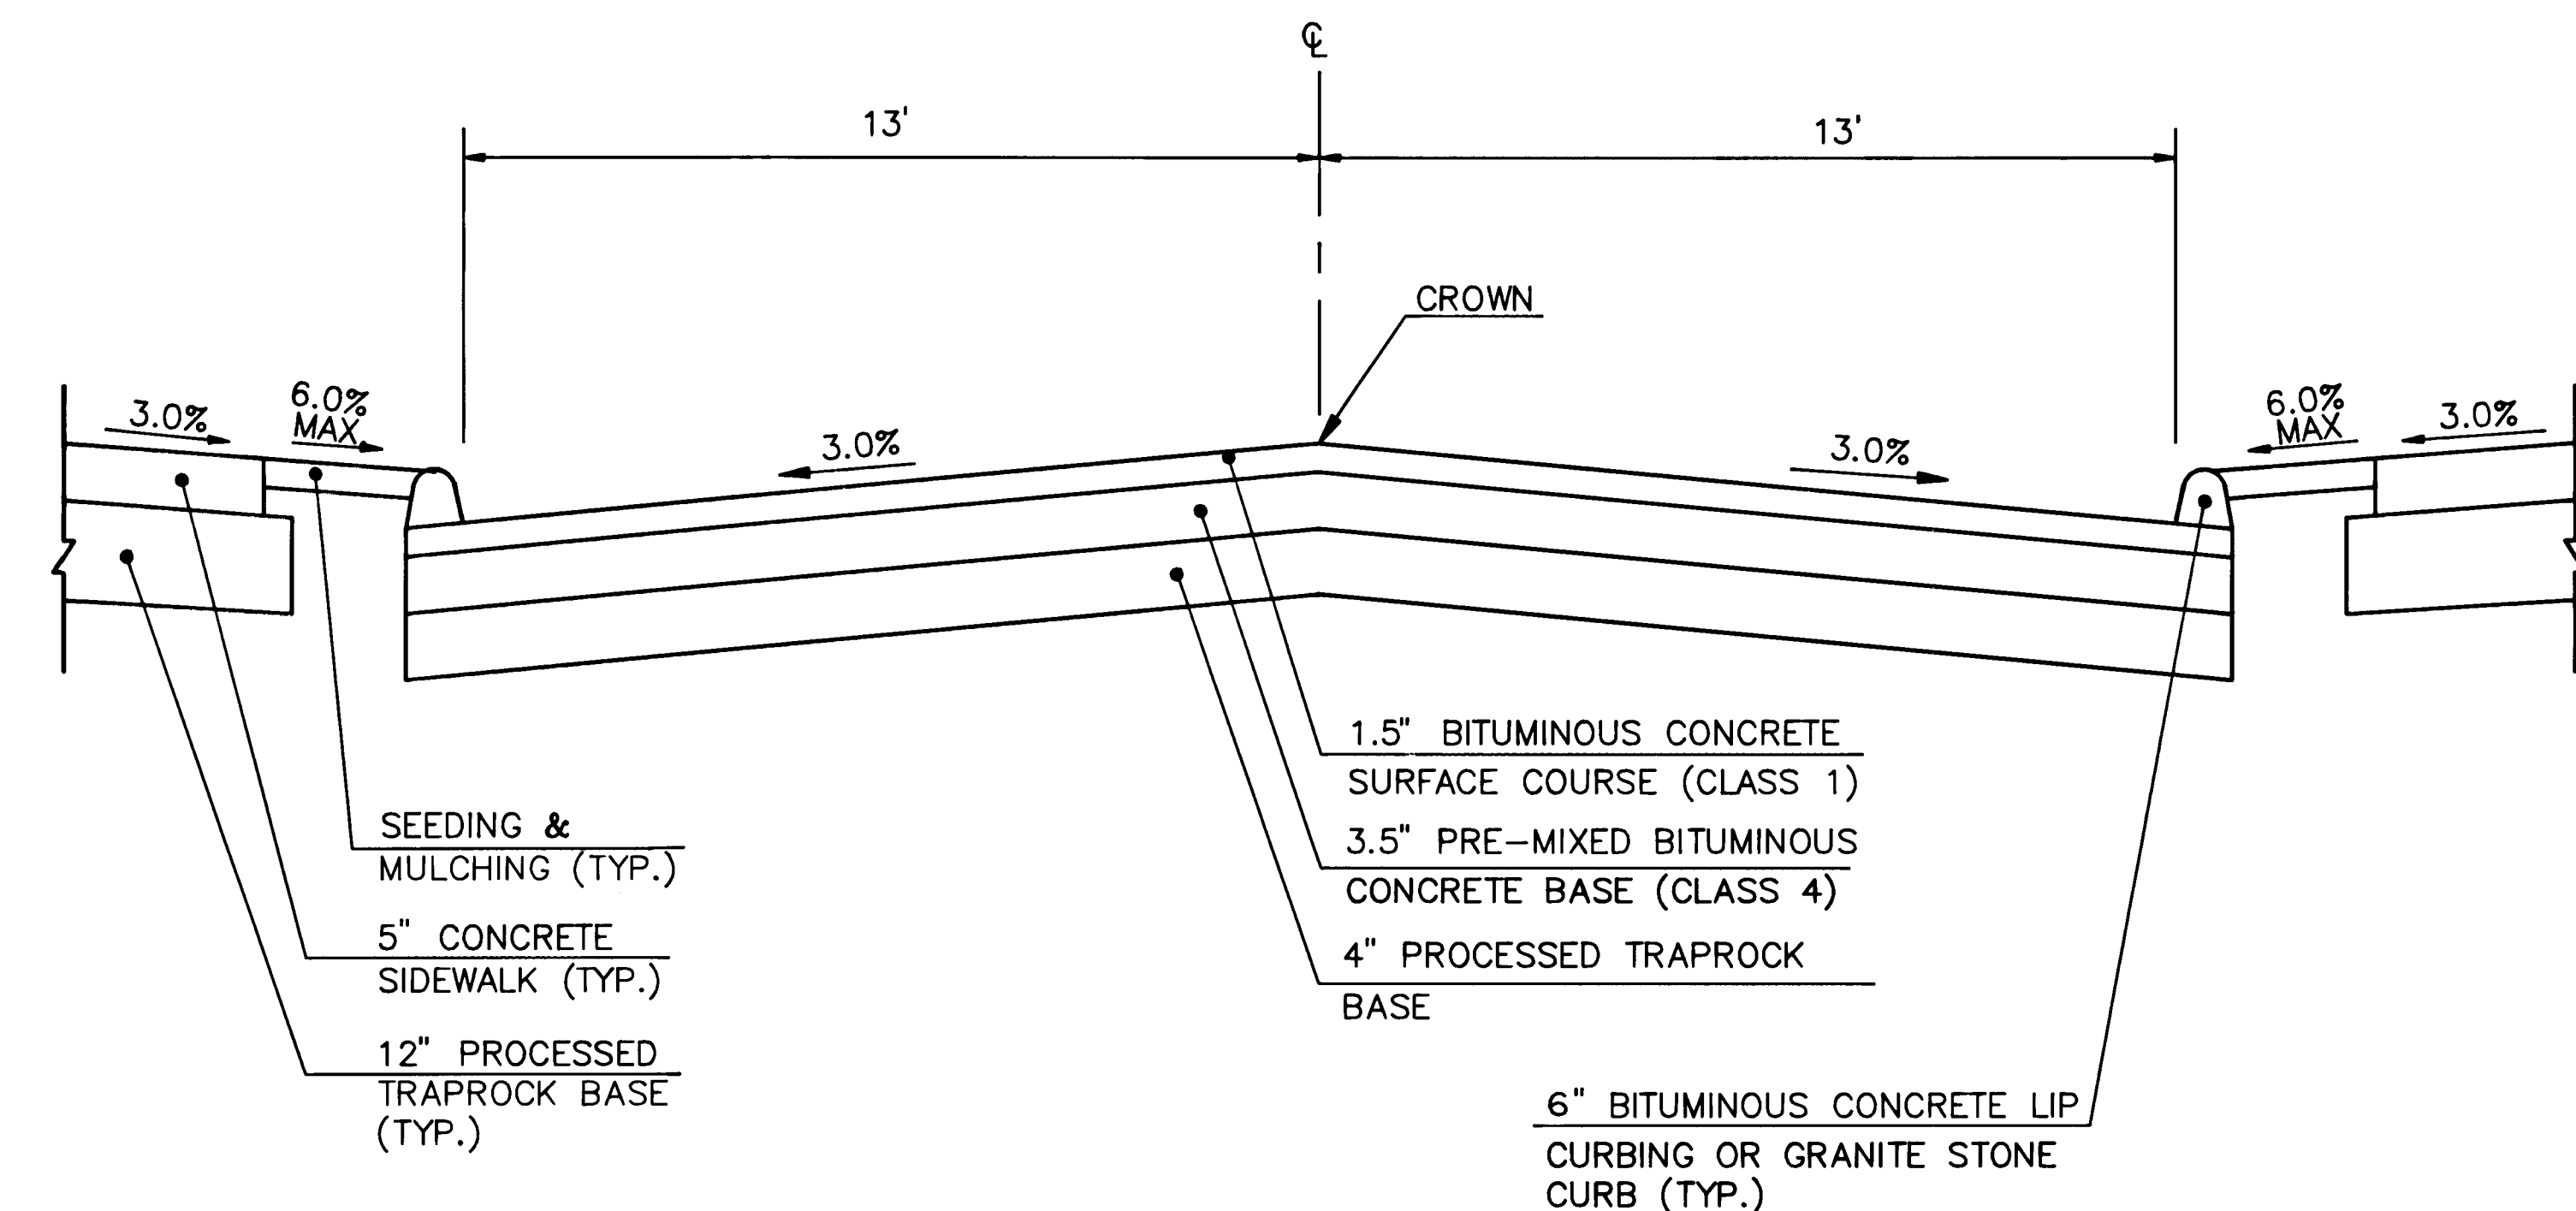

TYPICAL CROSS SECTION
(TYPE 5)

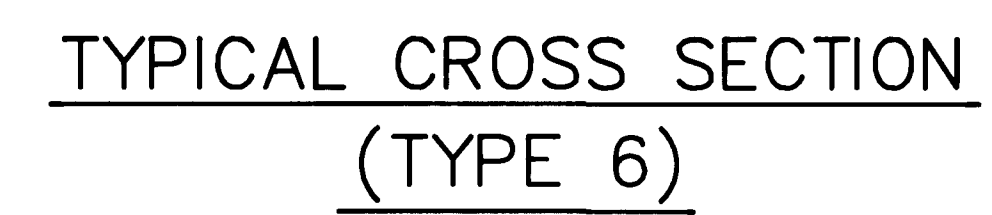

			CONTRACT NO. E88-07 AREA II	
			TYPICAL CROSS SECTIONS	
	JUN 90	AS BUILT	THE CITY OF	
NO.	DATE	REVISION	HARTFORD, CONNECTICUT	
DESIGNED: PL.		DATE <u>MARCH 23, 1988</u>		
DRAWN: T.N.S.				
CHECKED: A.M.				
APPROVED: R.C.G.				
		SCALE <u>N.T.S.</u>	SHEET NO. 4 OF 48	
			DAYBOOK NO. 011113	