



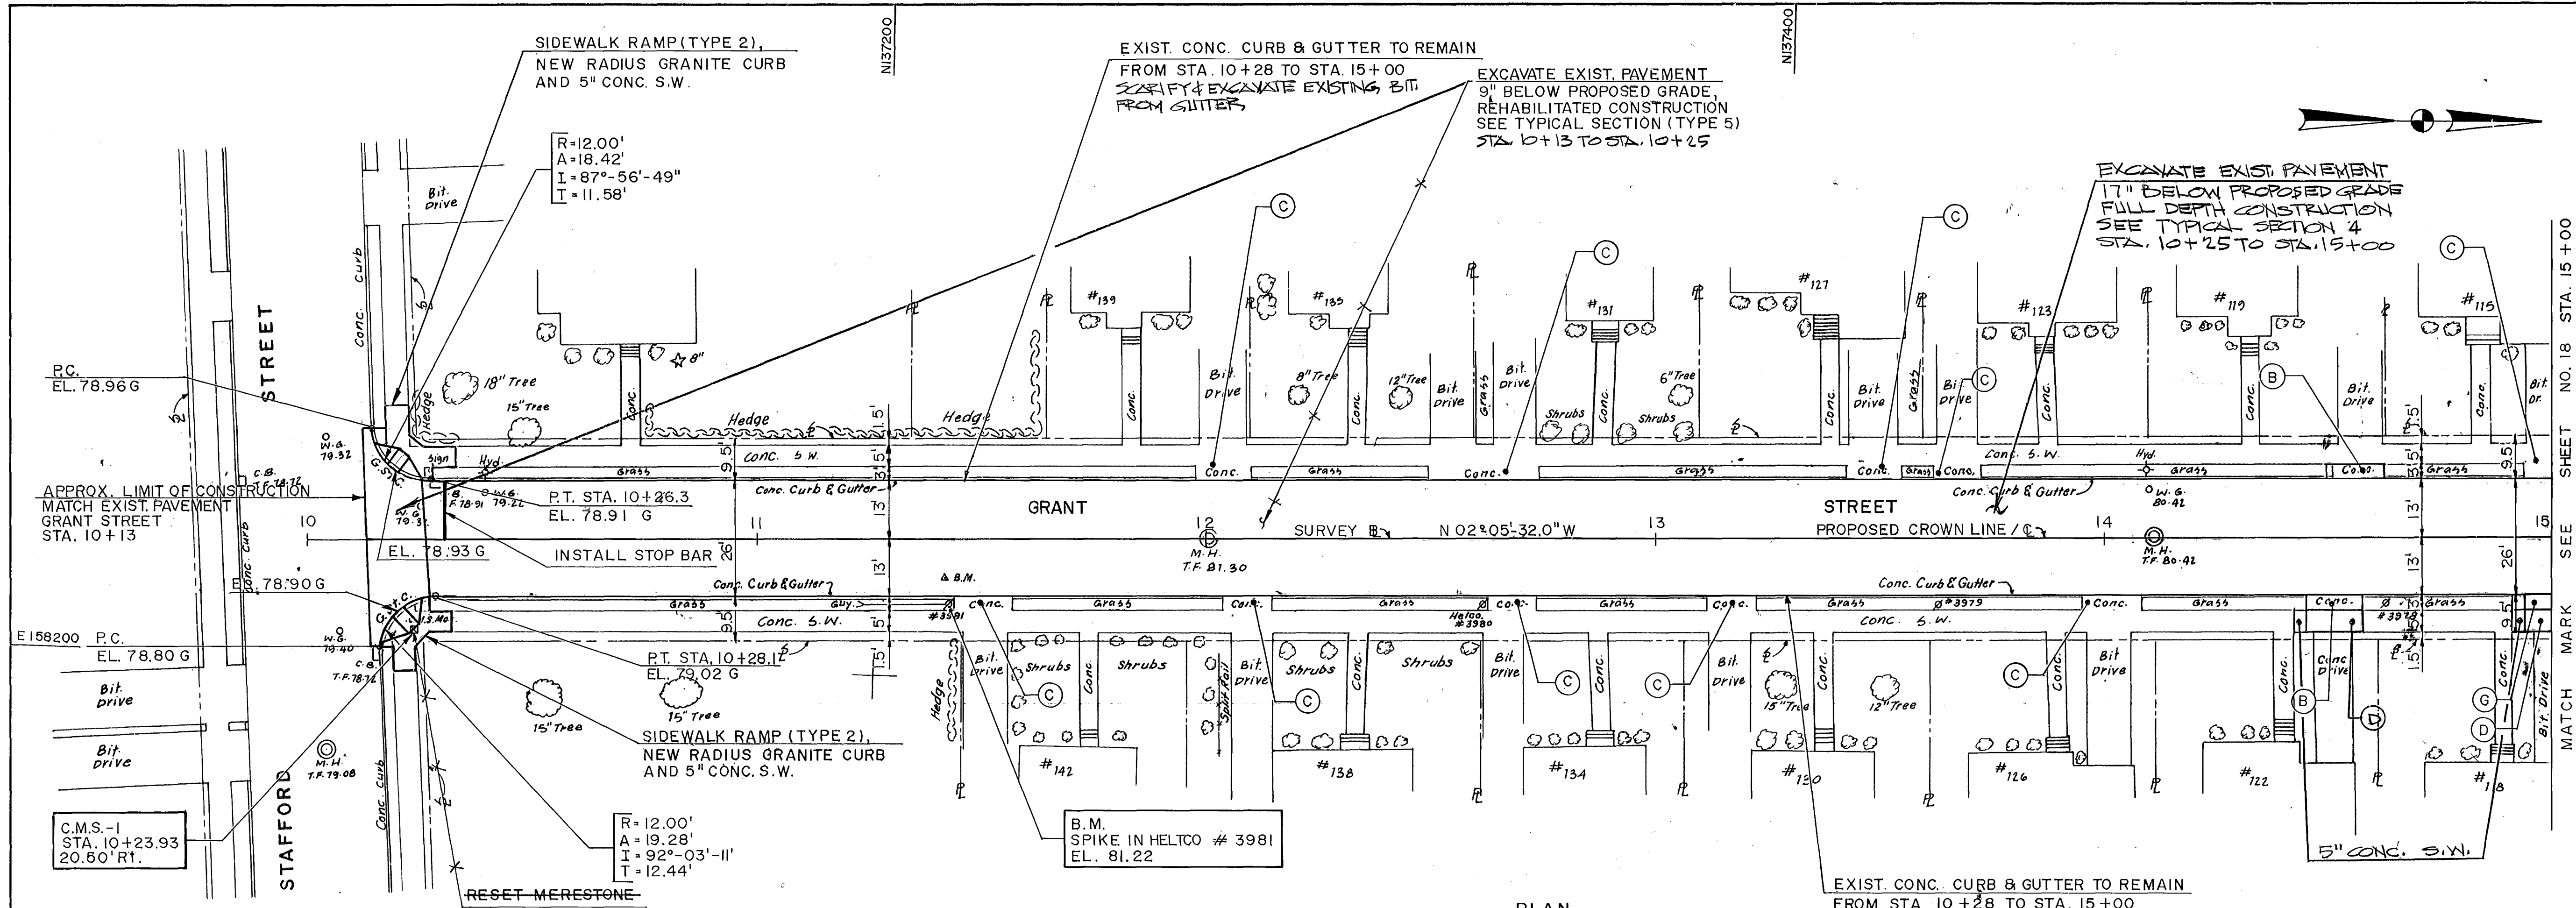

PLAN
SCALE: 1" = 20'

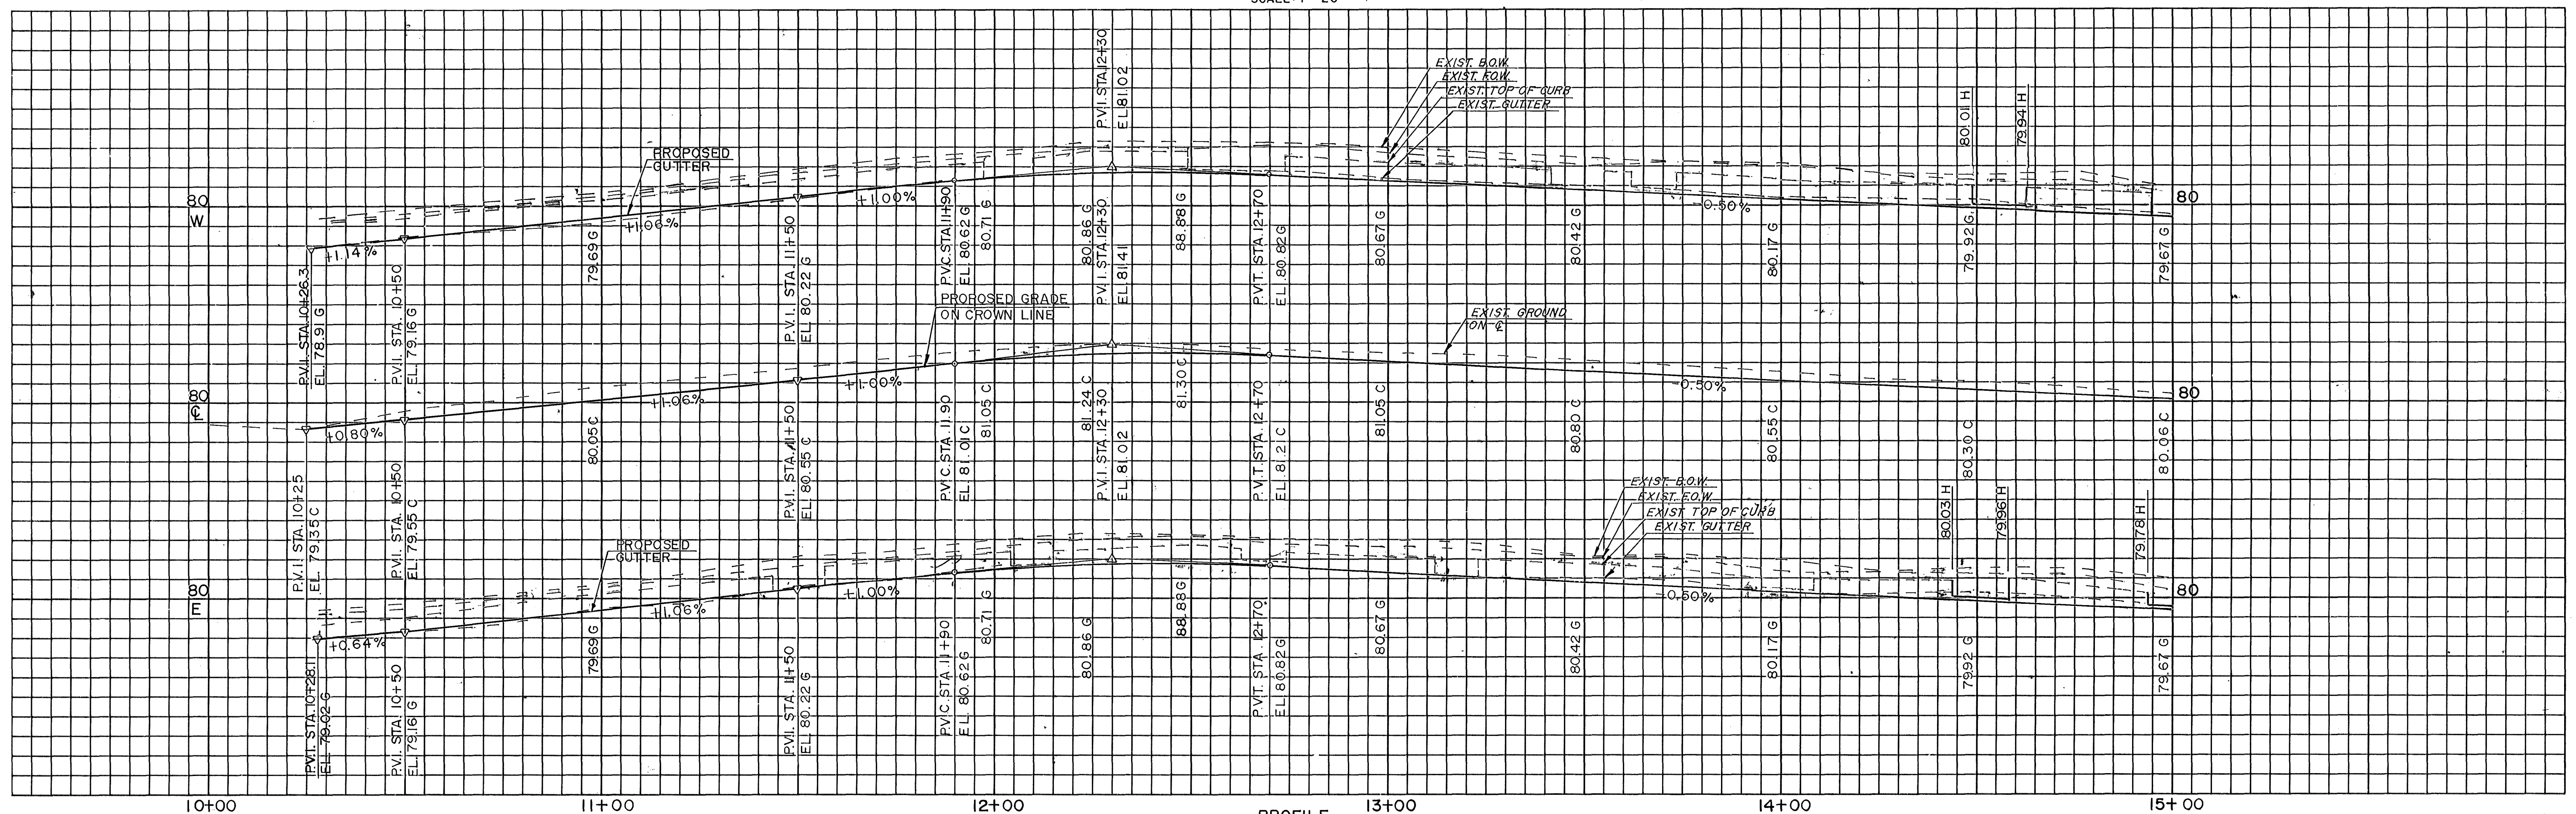

PROFILE
SCALE:
VERT. 1" = 2'
HORIZ. 1" = 20'

NOTES

- (B) SAWCUT BETWEEN EXISTING RAMPED SECTION AND SIDEWALK, AND CONSTRUCT 8" REINFORCED CONC. DRIVEWAY RAMP.

(C) EXISTING DRIVEWAY RAMP TO REMAIN.

(D) CONSTRUCT 8" REINFORCED CONC. SIDEWALK.

(G) CONSTRUCT 8" REINFORCED CONC. DRIVEWAY RAMP.
- FOR GENERAL NOTES AND LIST OF ABBREVIATIONS SEE SHEET NO.2
- FOR CONSTRUCTION NOTES SEE SHEET NO.8
- SURVEY BASELINE IS LOCATED 20.50 FT. WEST OF C.M.S.-1

GRANT STREET PLAN AND PROFILE

THE CITY OF
HARTFORD, CONNECTICUT

NO.	DATE	REVISION
1	JAN 90	AS BUILT
2	MARCH 23, 1988	DATE
3	SCALE	AS NOTED

PURCELL
ASSOCIATES

SHEET NO.
17 OF 48
DAYBOOK NO.
011113B