



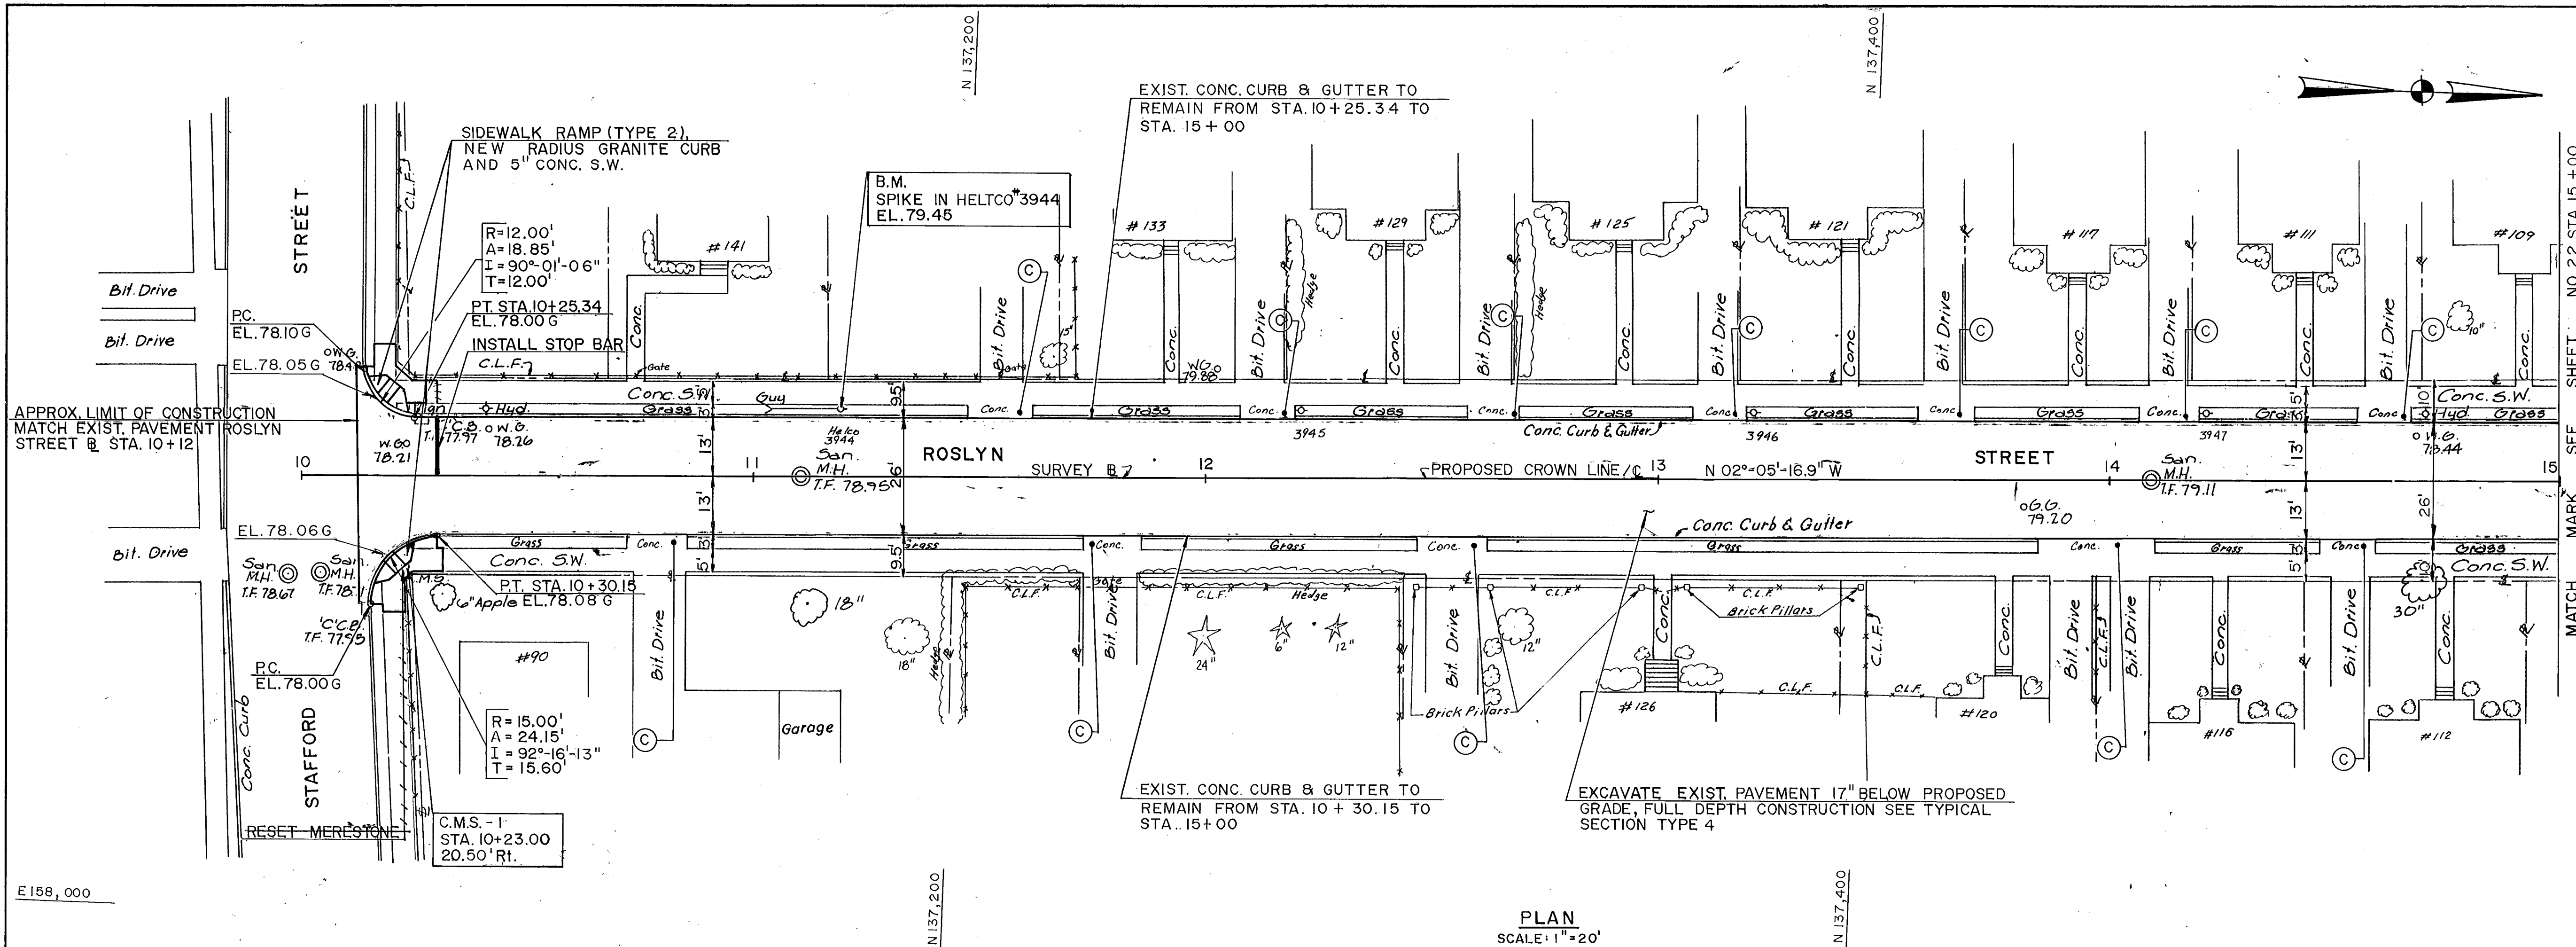

NOTES

1. (C) EXISTING DRIVEWAY RAMP TO REMAIN
2. FOR GENERAL NOTES AND LIST OF ABBREVIATIONS SEE SHEET NO. 2
3. FOR CONSTRUCTION NOTES SEE SHEET NO. 8
4. SURVEY BASELINE IS LOCATED 20.50 FT. WEST OF C.M.S. - 1.

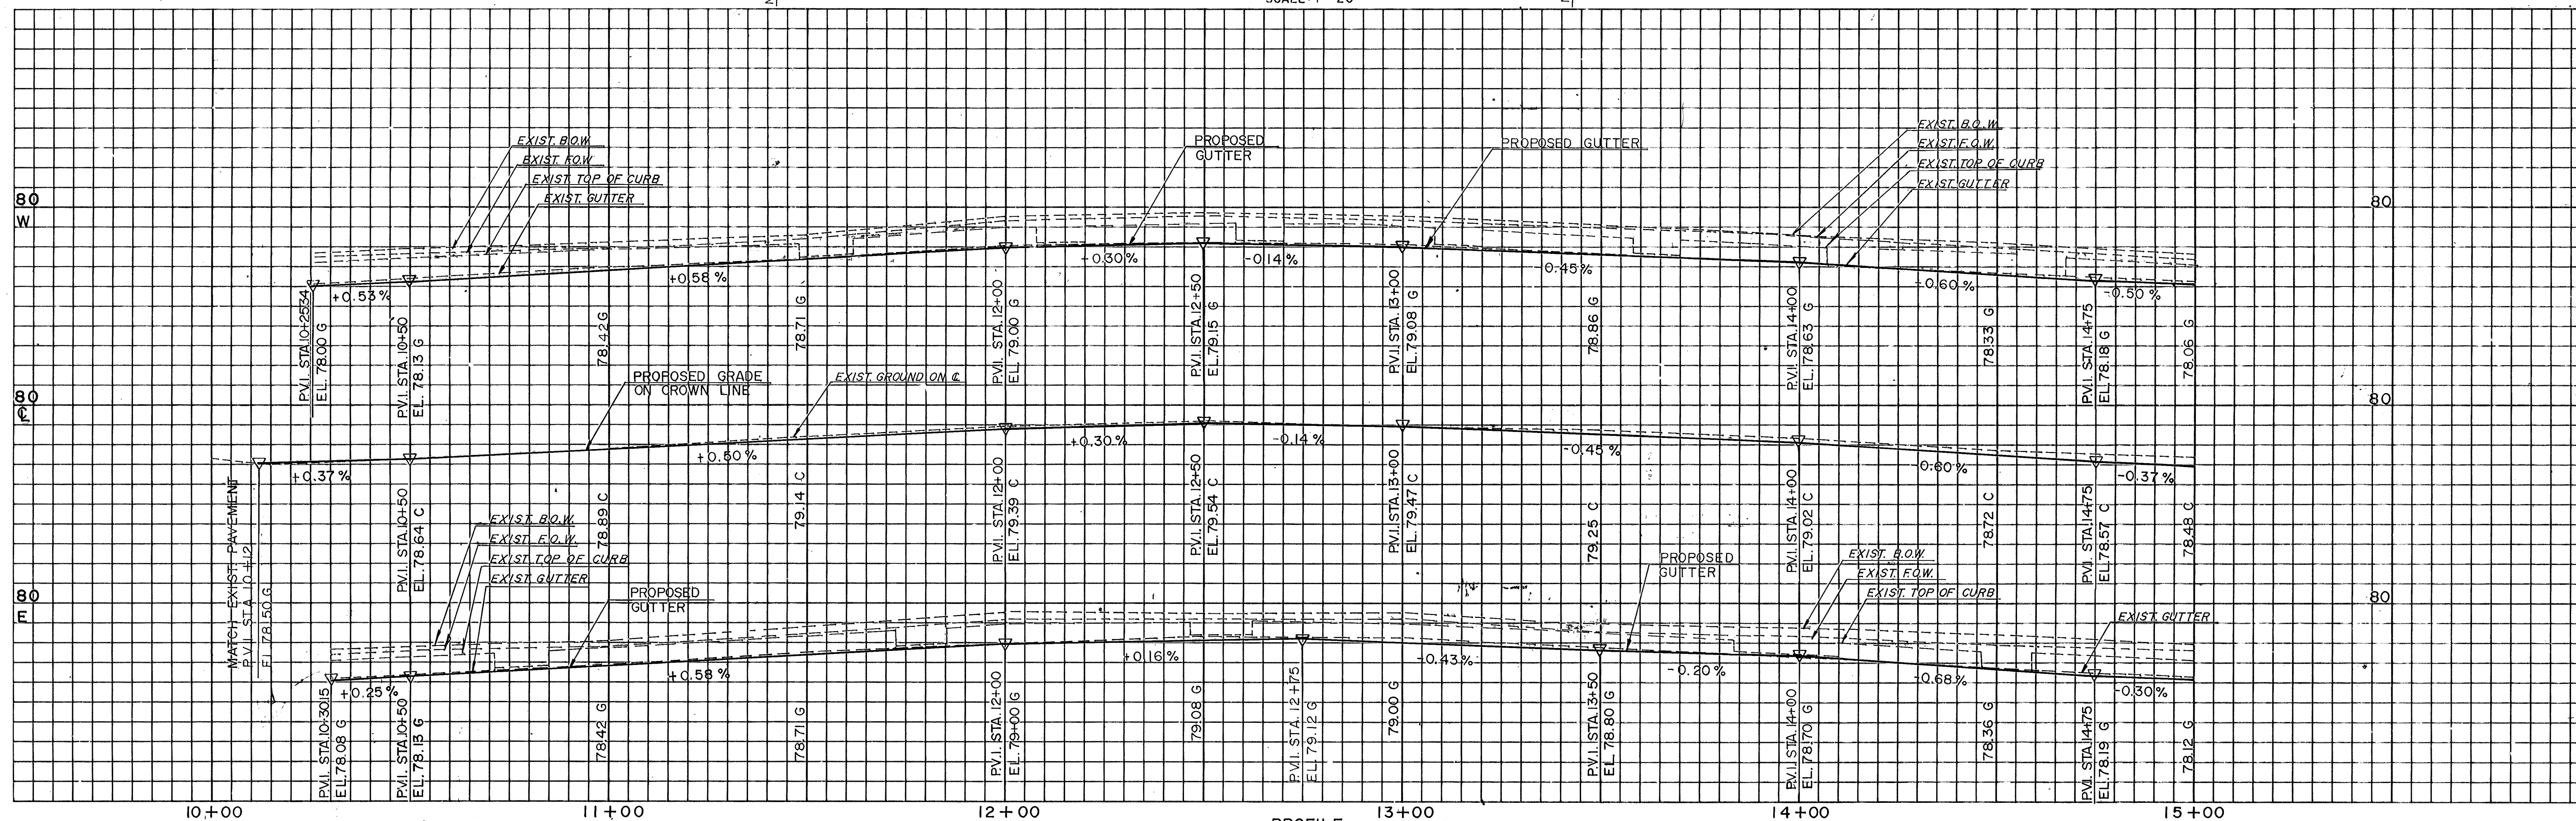

ROSLYN STREET PLAN AND PROFILE

THE CITY OF
HARTFORD, CONNECTICUT

PURCELL
ASSOCIATES

SHEET NO.
21 OF 48
DAYBROOK NO.
01113 C

NO.	DATE	REVISION
JAN 90	AS BUILT	
DESIGNED: PL	DATE: MARCH 23, 1988	
DRAWN: M.J.F.	SCALE: AS NOTED	
CHECKED: A.M.		
APPROVED: R.G.G.		