



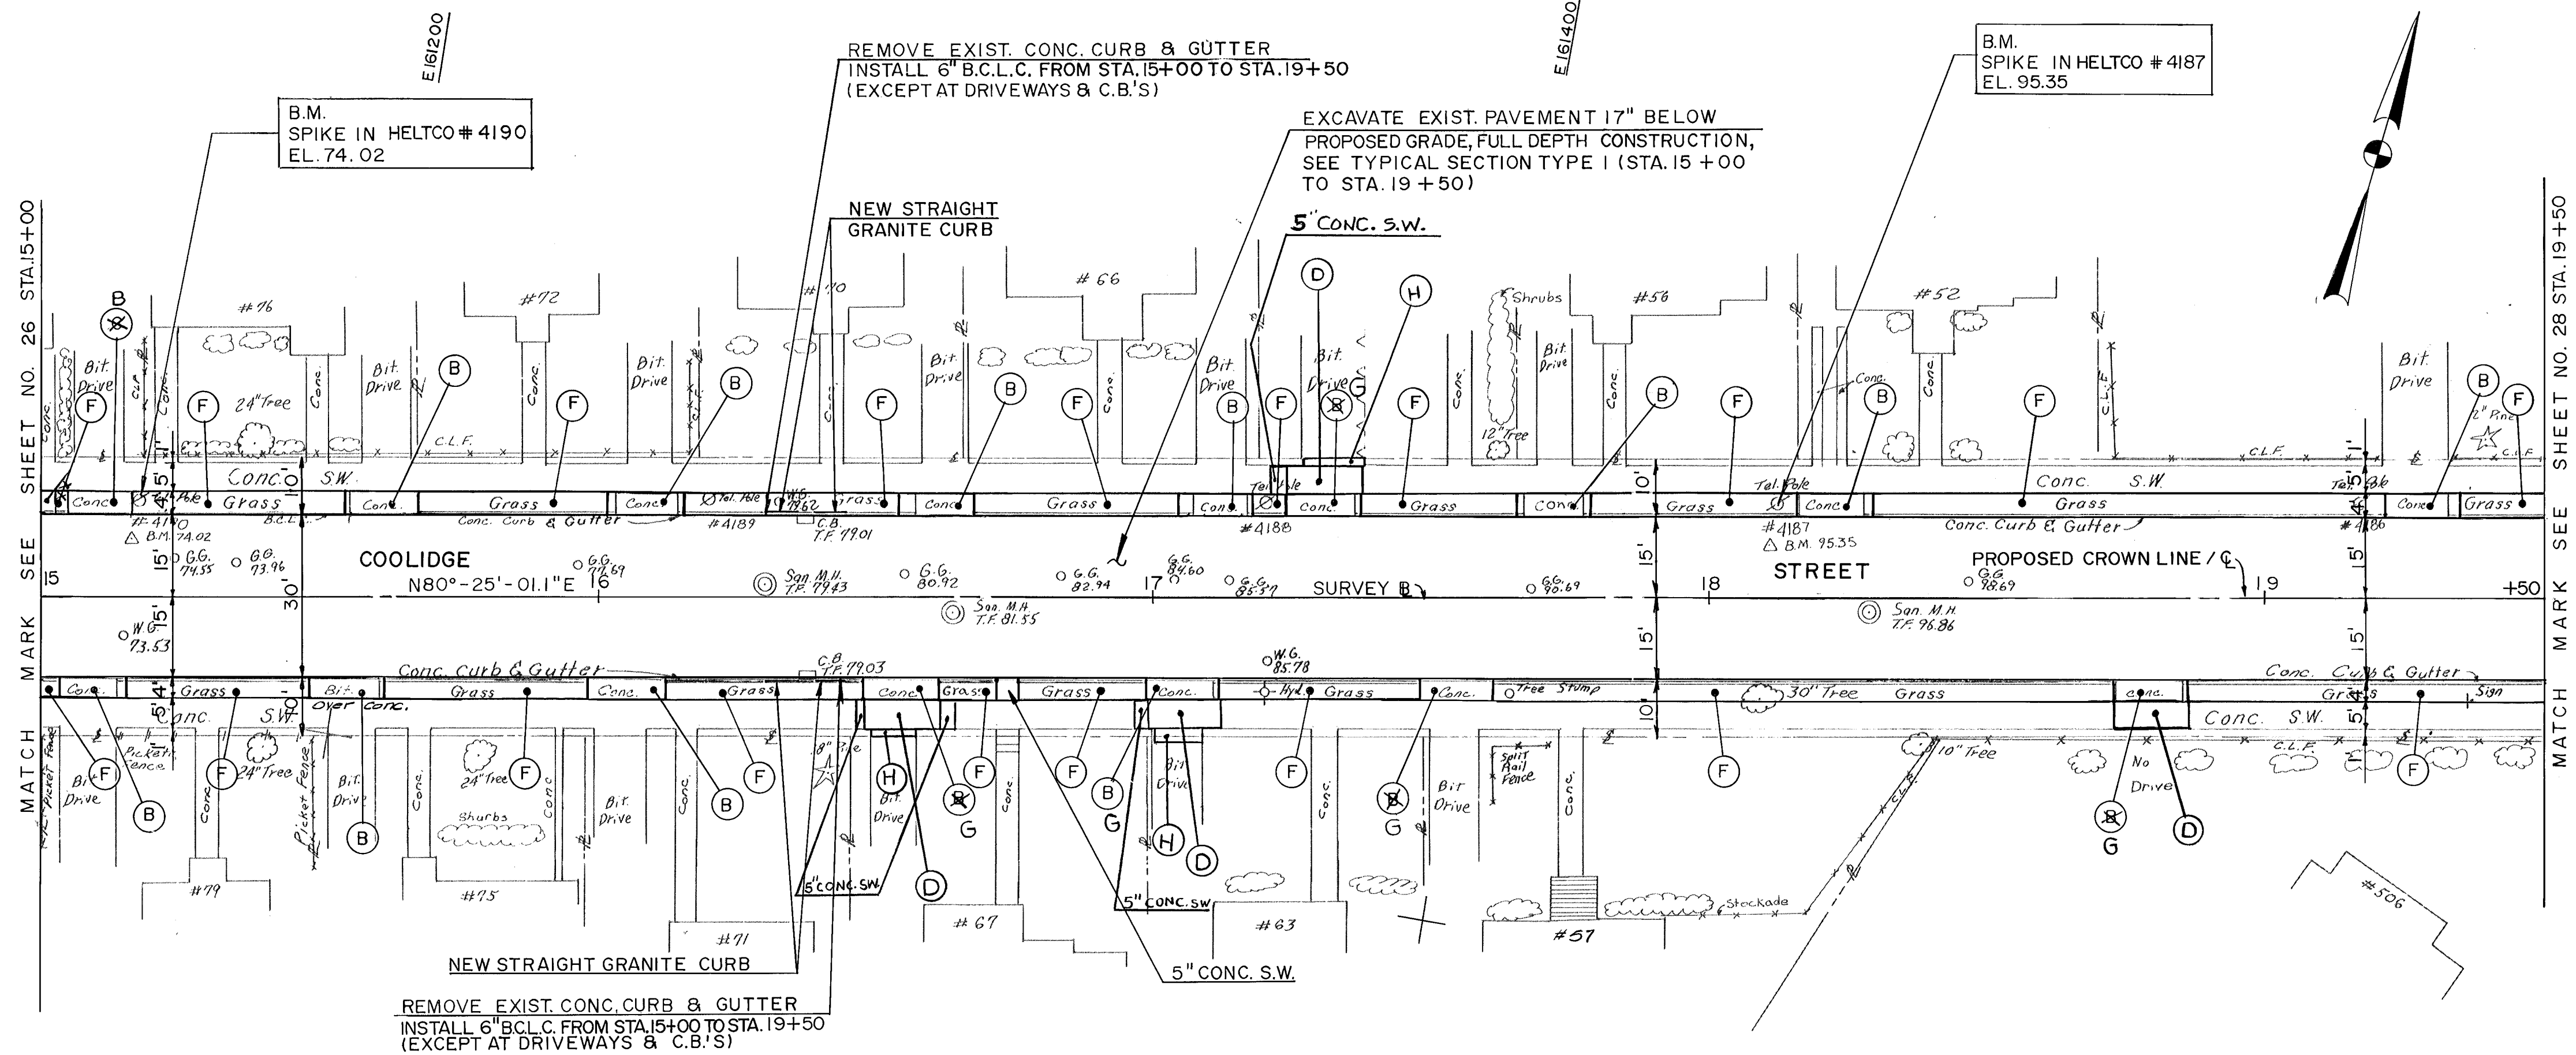

NOTES

- (B) SAWCUT BETWEEN EXISTING RAMPED SECTION AND SIDEWALK, AND CONSTRUCT 8\"/>
- (C) EXISTING DRIVEWAY RAMP TO REMAIN.
- (F) SEEDING & MULCHING.
- FOR GENERAL NOTES AND LIST OF ABBREVIATIONS SEE SHEET NO. 2.
- FOR CONSTRUCTION NOTES SEE SHEET NO. 8.
- SURVEY BASELINE IS LOCATED 15.00 FT. NORTH FROM FACE OF SOUTH CURB.
- (D) CONSTRUCT 8\"/>
- (G) CONSTRUCT 8\"/>

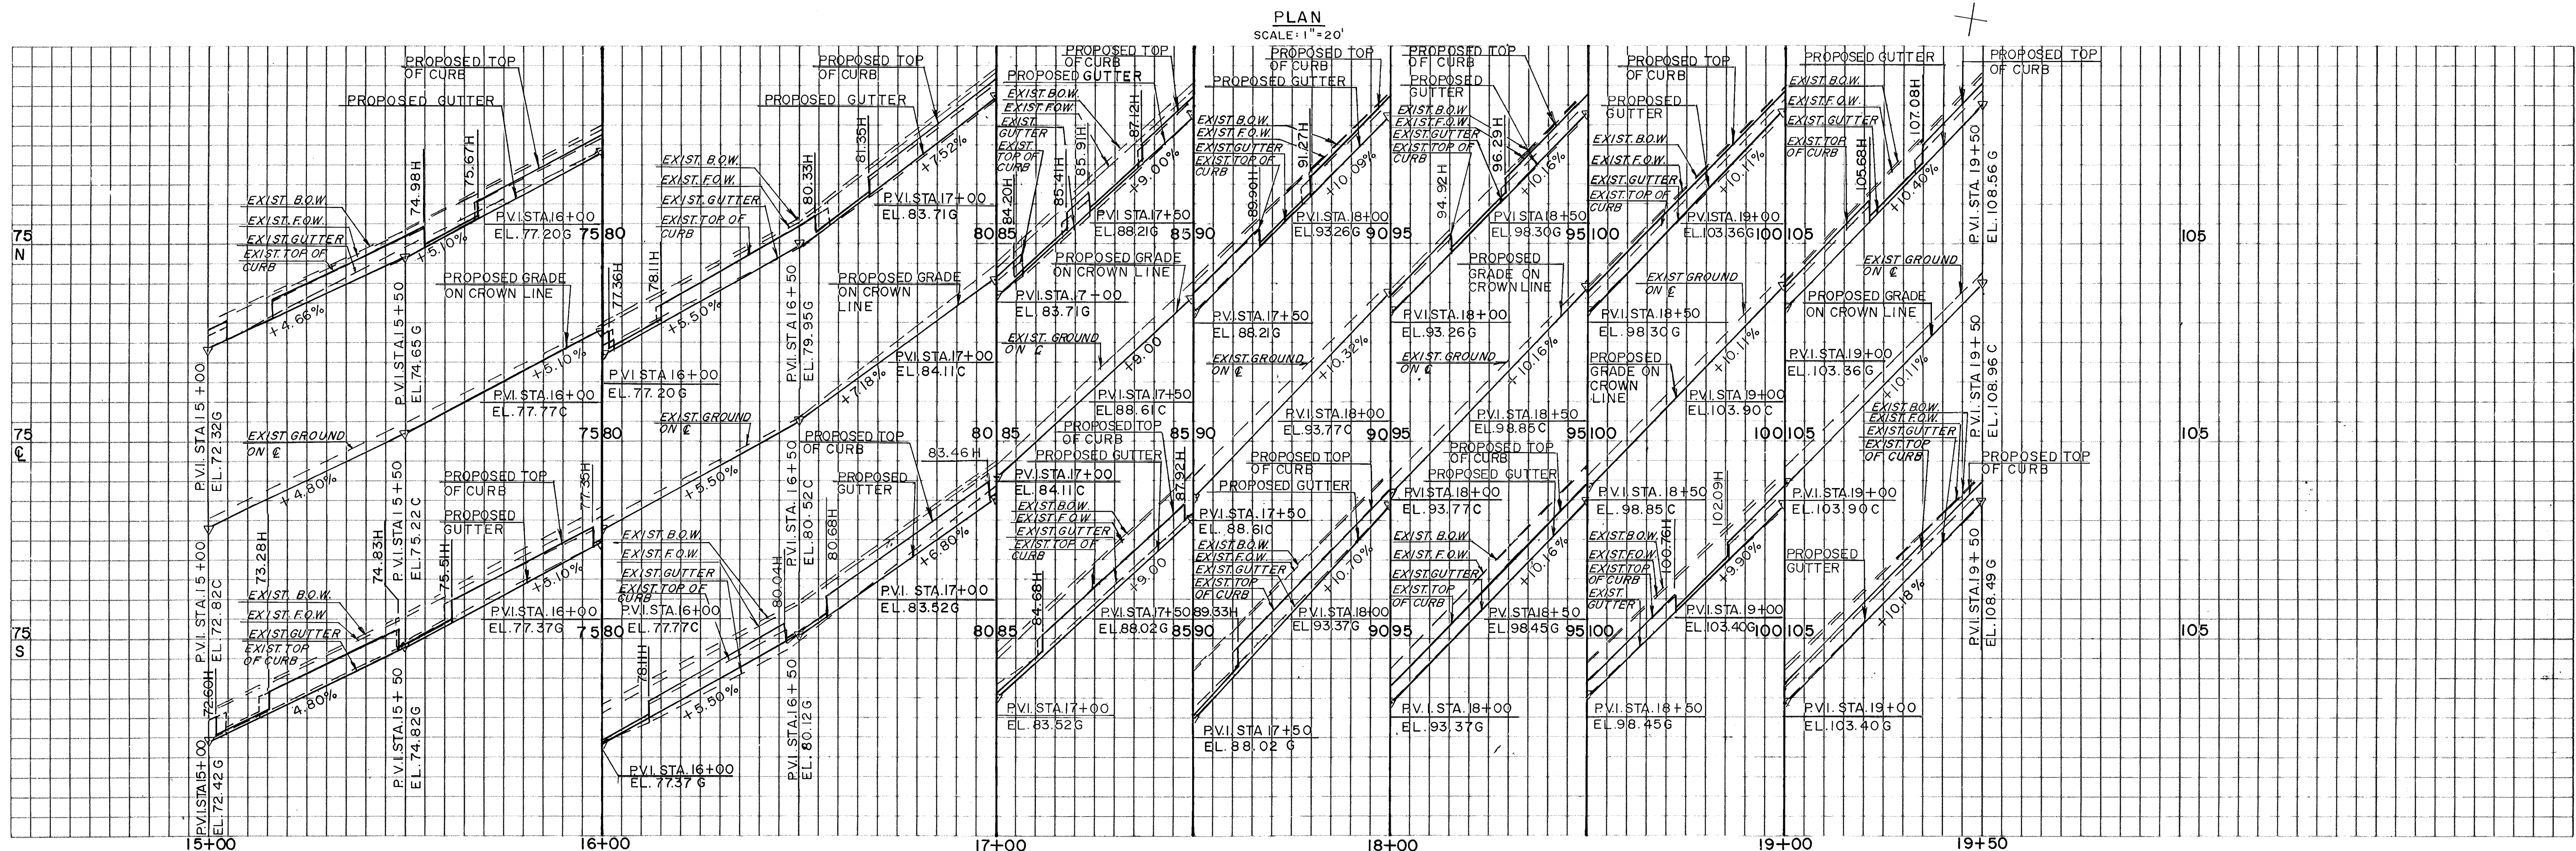

PROFILE
SCALE: VERT. 1" = 2'
HORIZ. 1" = 20'

COOLIDGE STREET			
PLAN AND PROFILE			
THE CITY OF HARTFORD, CONNECTICUT			
DESIGNED: D.M.	DATE: JAN 90	AS BUILT	
DRAWN: C.L.P.	DATE: MARCH 23, 1988.		
CHECKED: A.M.	SCALE: AS NOTED		
APPROVED: R.C.G.			
SHEET NO. 27 OF 48			
DAYBOOK NO. 01113 E			

PURCELL
ASSOCIATES