


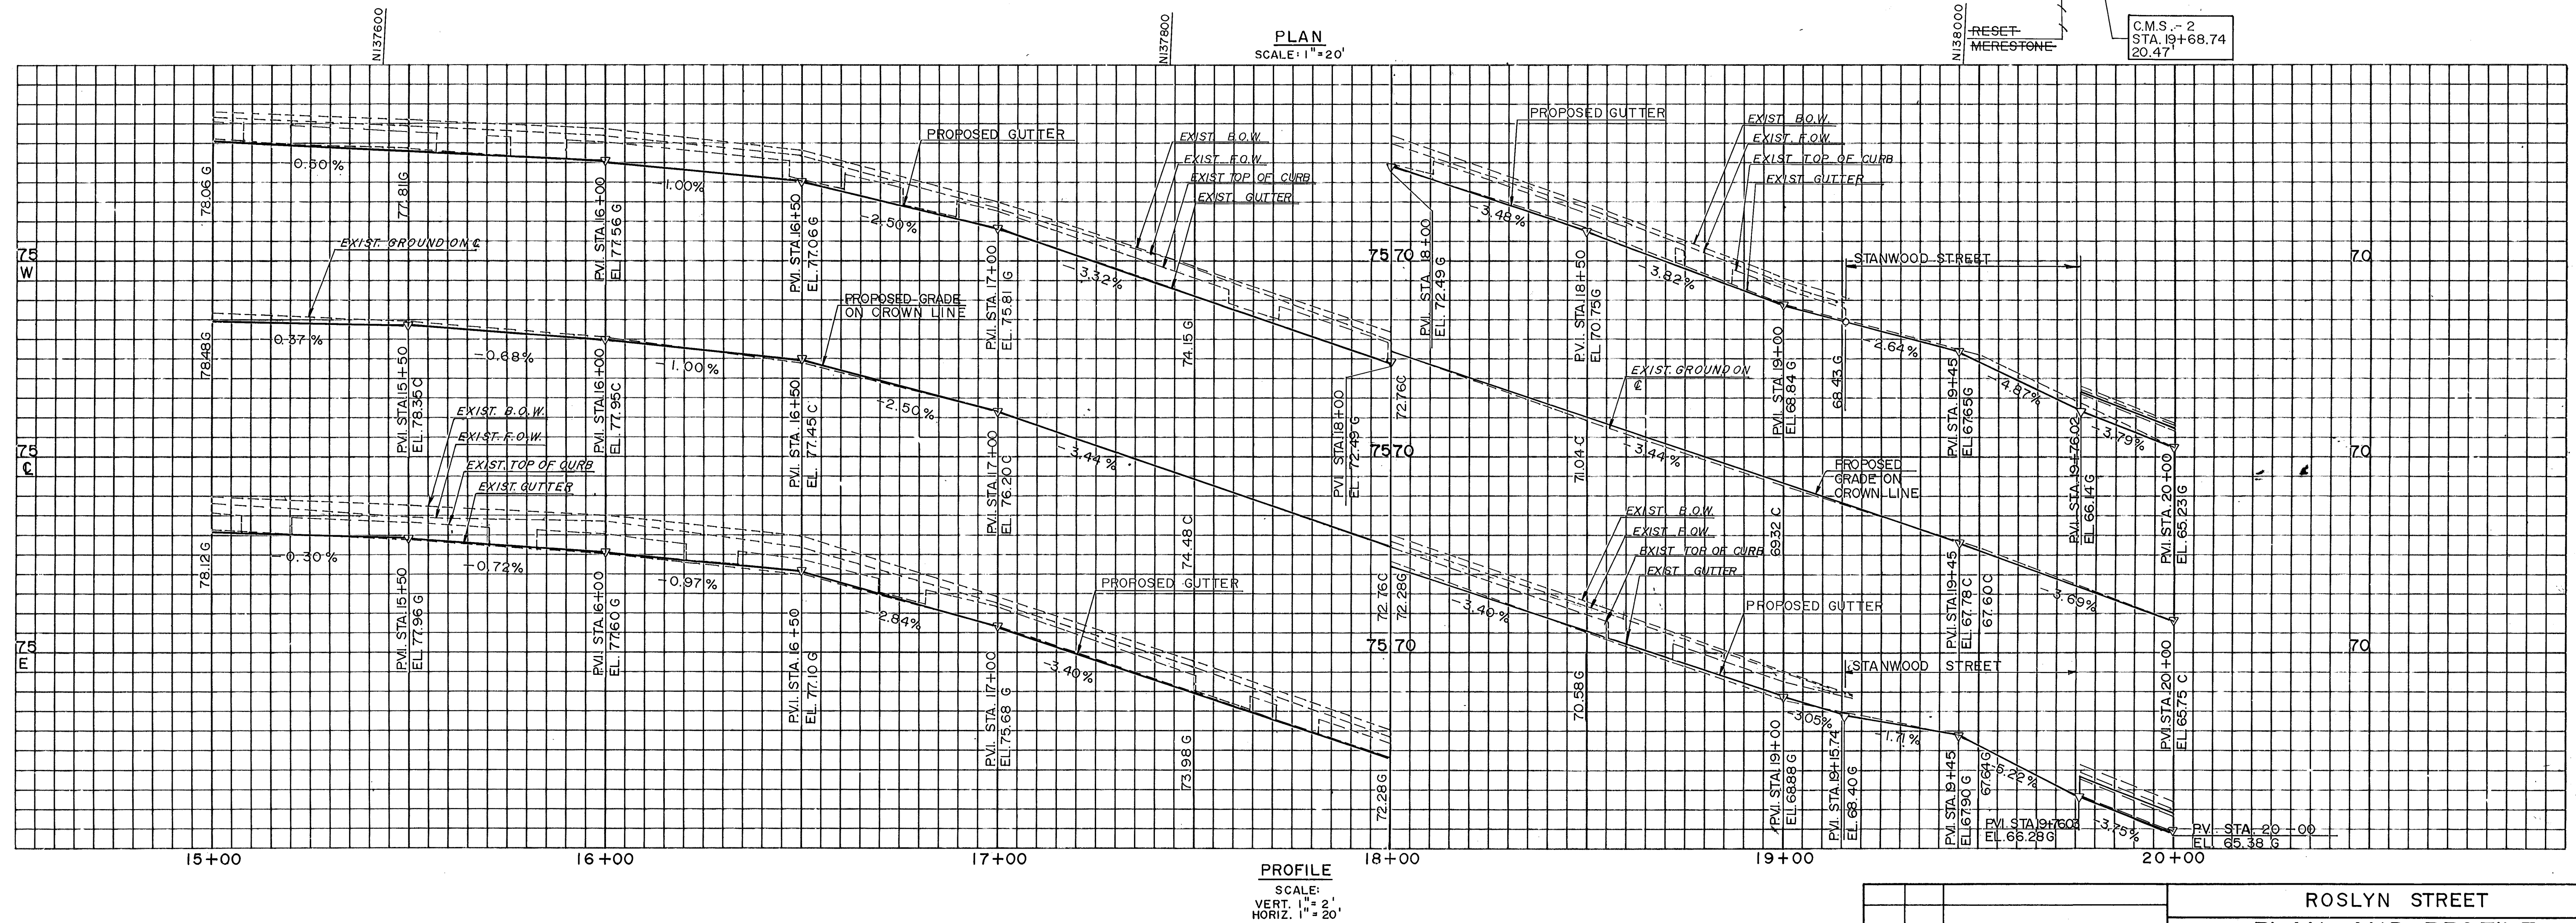

			ROSLYN STREET	
			PLAN AND PROFILE	
	JAN 90	AS BUILT	THE CITY OF	
NO.	DATE	REVISION	HARTFORD, CONNECTICUT	
DESIGNED: P.L.		DATE MARCH 23, 1988		SHEET NO.
DRAWN: C.P.				22 OF 48
CHECKED: A.M.				DAY BOOK NO.
APPROVED: R.C.G.				
SCALE AS NOTED				