



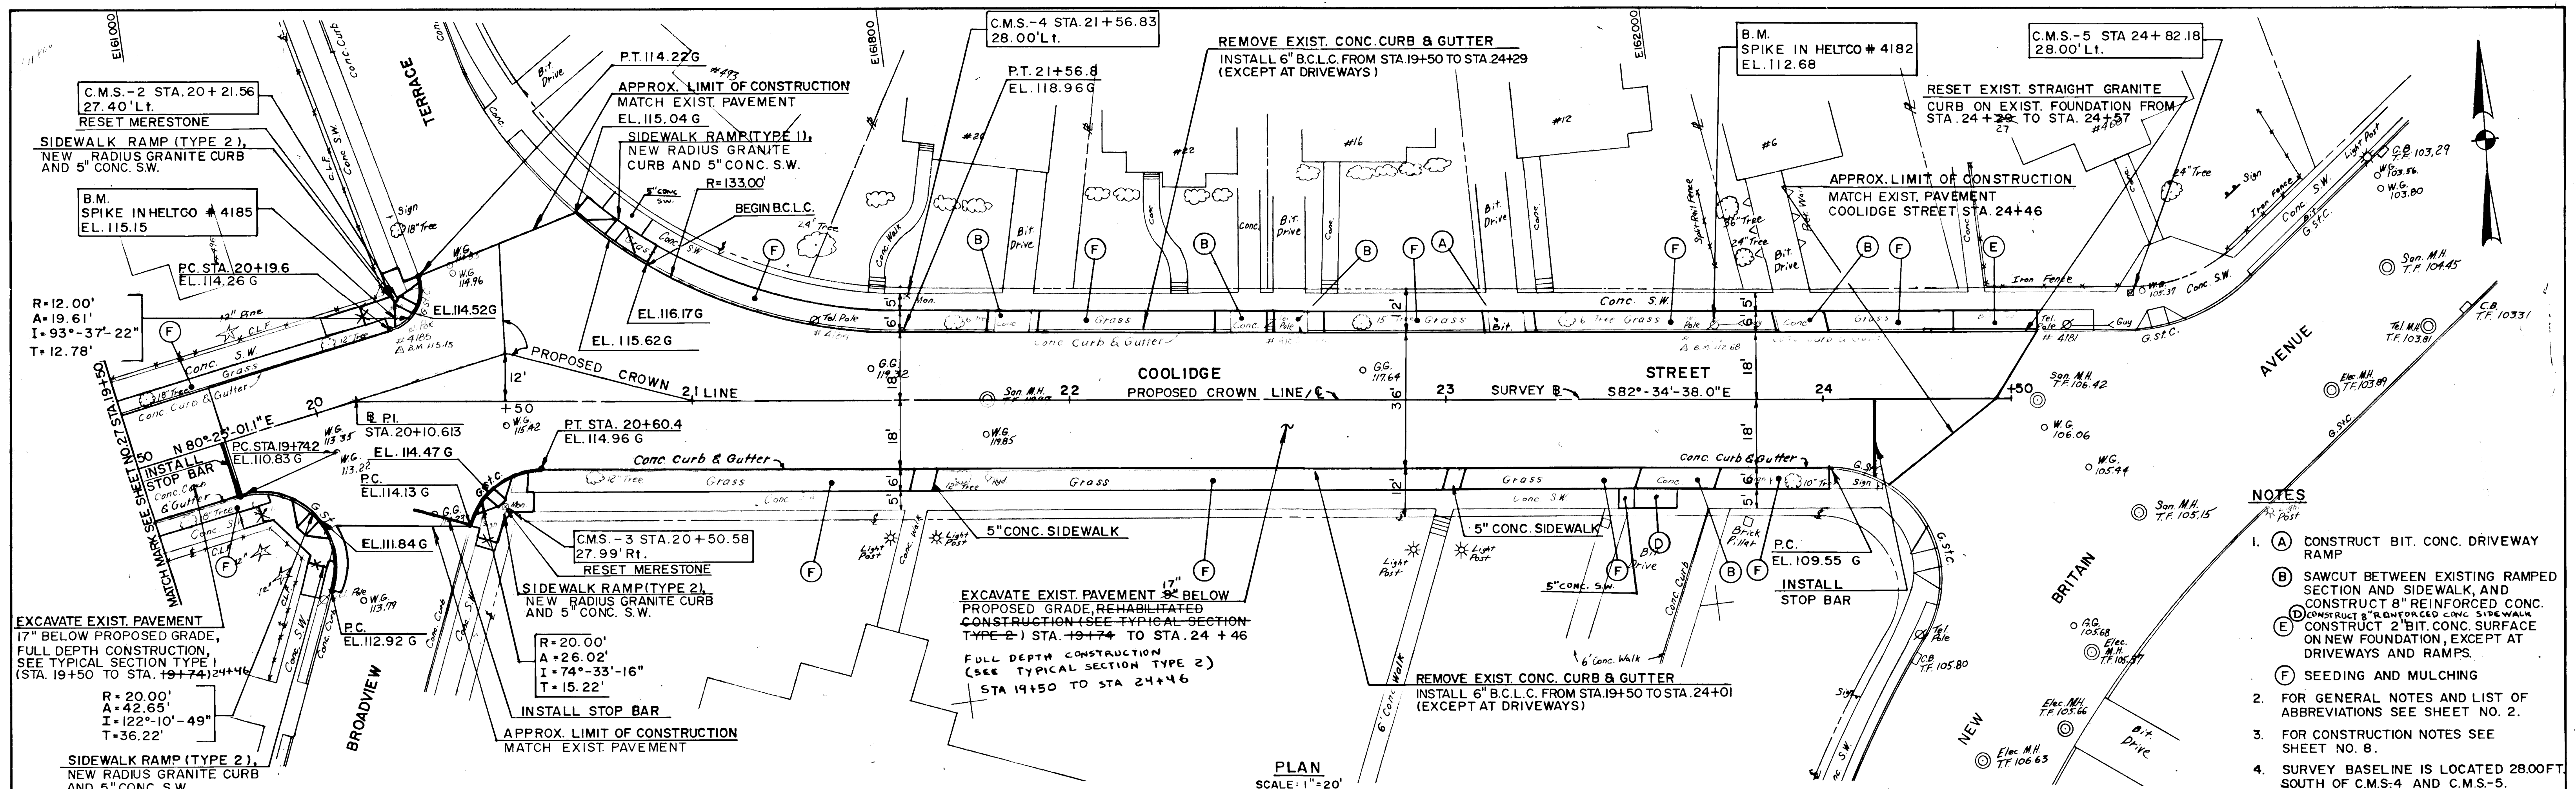

- NOTES**
- (A) CONSTRUCT BIT. CONC. DRIVEWAY RAMP
 - (B) SAWCUT BETWEEN EXISTING RAMPED SECTION AND SIDEWALK, AND CONSTRUCT 8" REINFORCED CONC.
 - (C) CONSTRUCT 8" REINFORCED CONC. SIDEWALK ON NEW FOUNDATION, EXCEPT AT DRIVEWAYS AND RAMPS.
 - (F) SEEDING AND MULCHING
- FOR GENERAL NOTES AND LIST OF ABBREVIATIONS SEE SHEET NO. 2.
 - FOR CONSTRUCTION NOTES SEE SHEET NO. 8.
 - SURVEY BASELINE IS LOCATED 28.00 FT. SOUTH OF C.M.S.-4 AND C.M.S.-5.

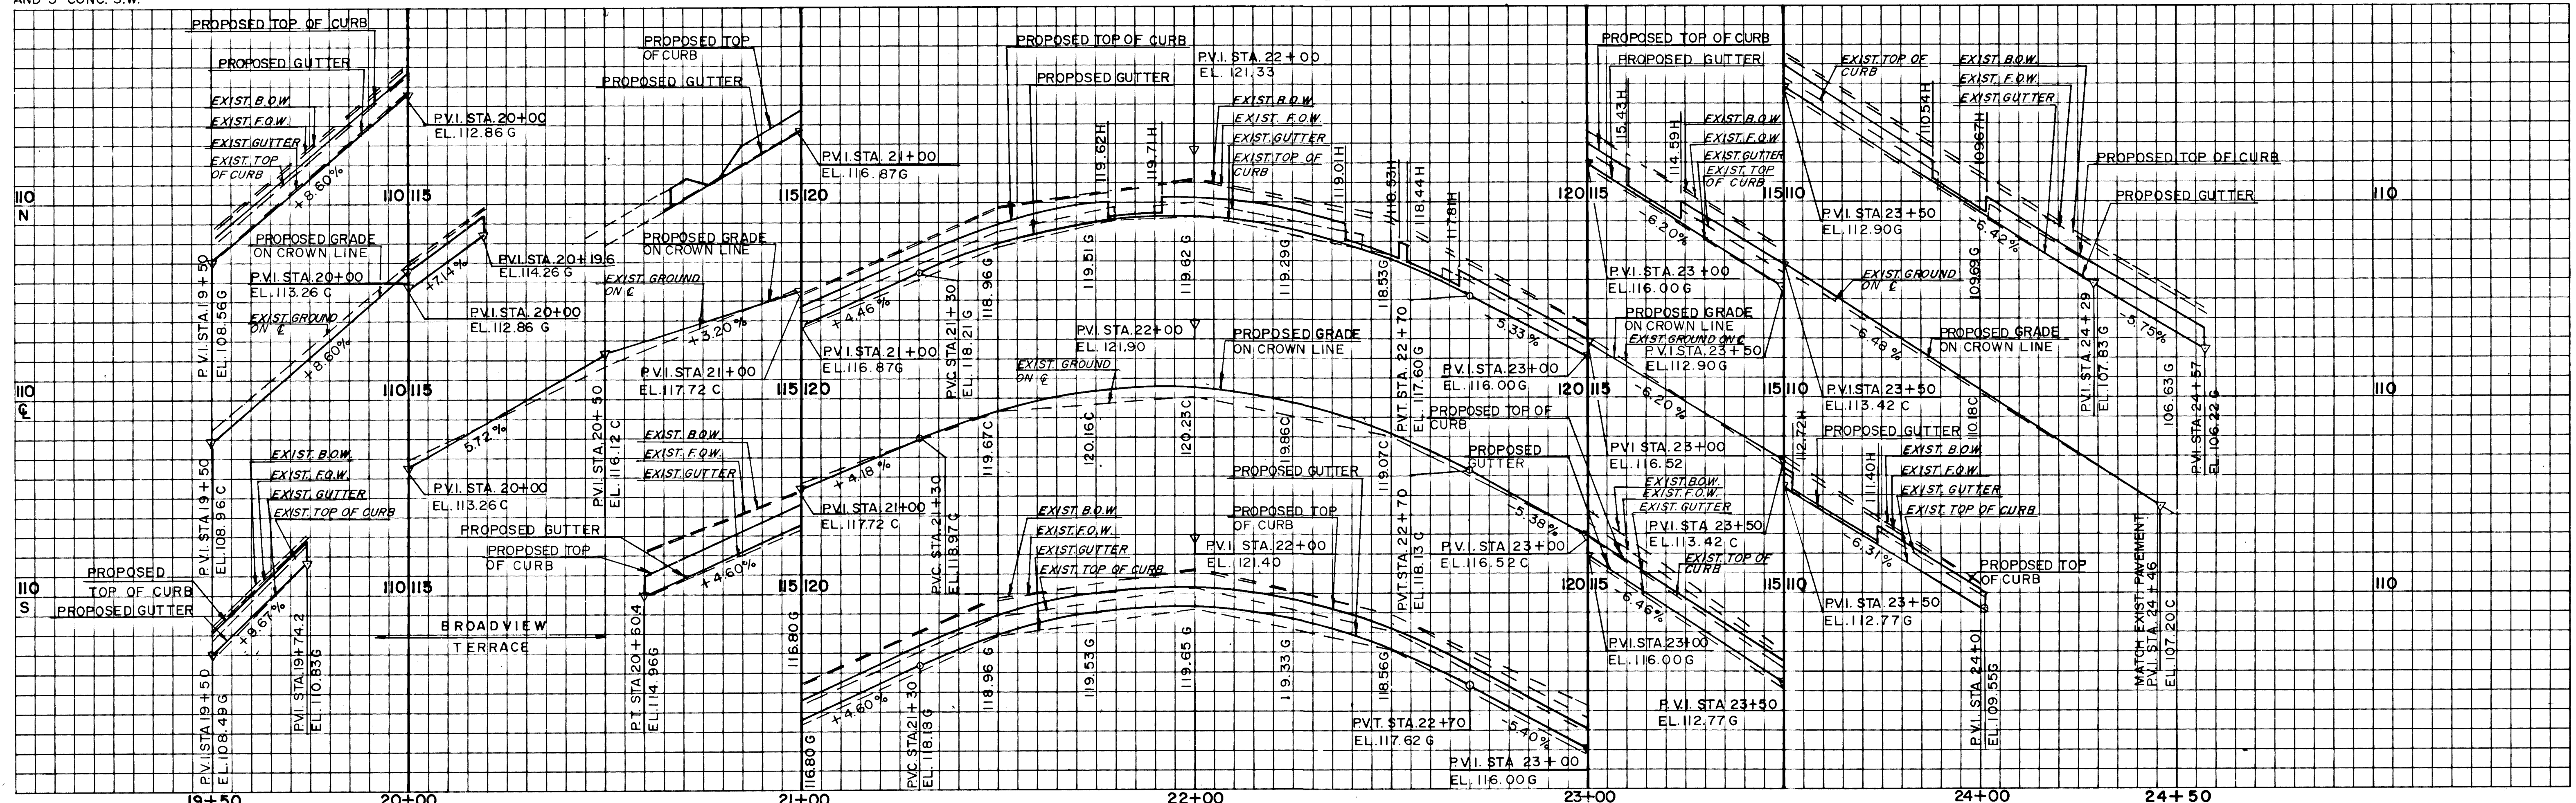

PROFILE
SCALE: 1"=20'

COOLIDGE STREET			
PLAN AND PROFILE			
THE CITY OF HARTFORD, CONNECTICUT			
DESIGNED: D.M.		DATE: MARCH 23, 1988	
DRAWN: C.L.P.		SCALE: AS NOTED	
CHECKED: A.M.		APPROVED: R.C.G.	
NO. DATE		REVISION	
JAN 90 AS BUILT			

PURCELL
ASSOCIATES

SHEET NO.
28 OF 48
DAY BOOK NO.
01113 E