
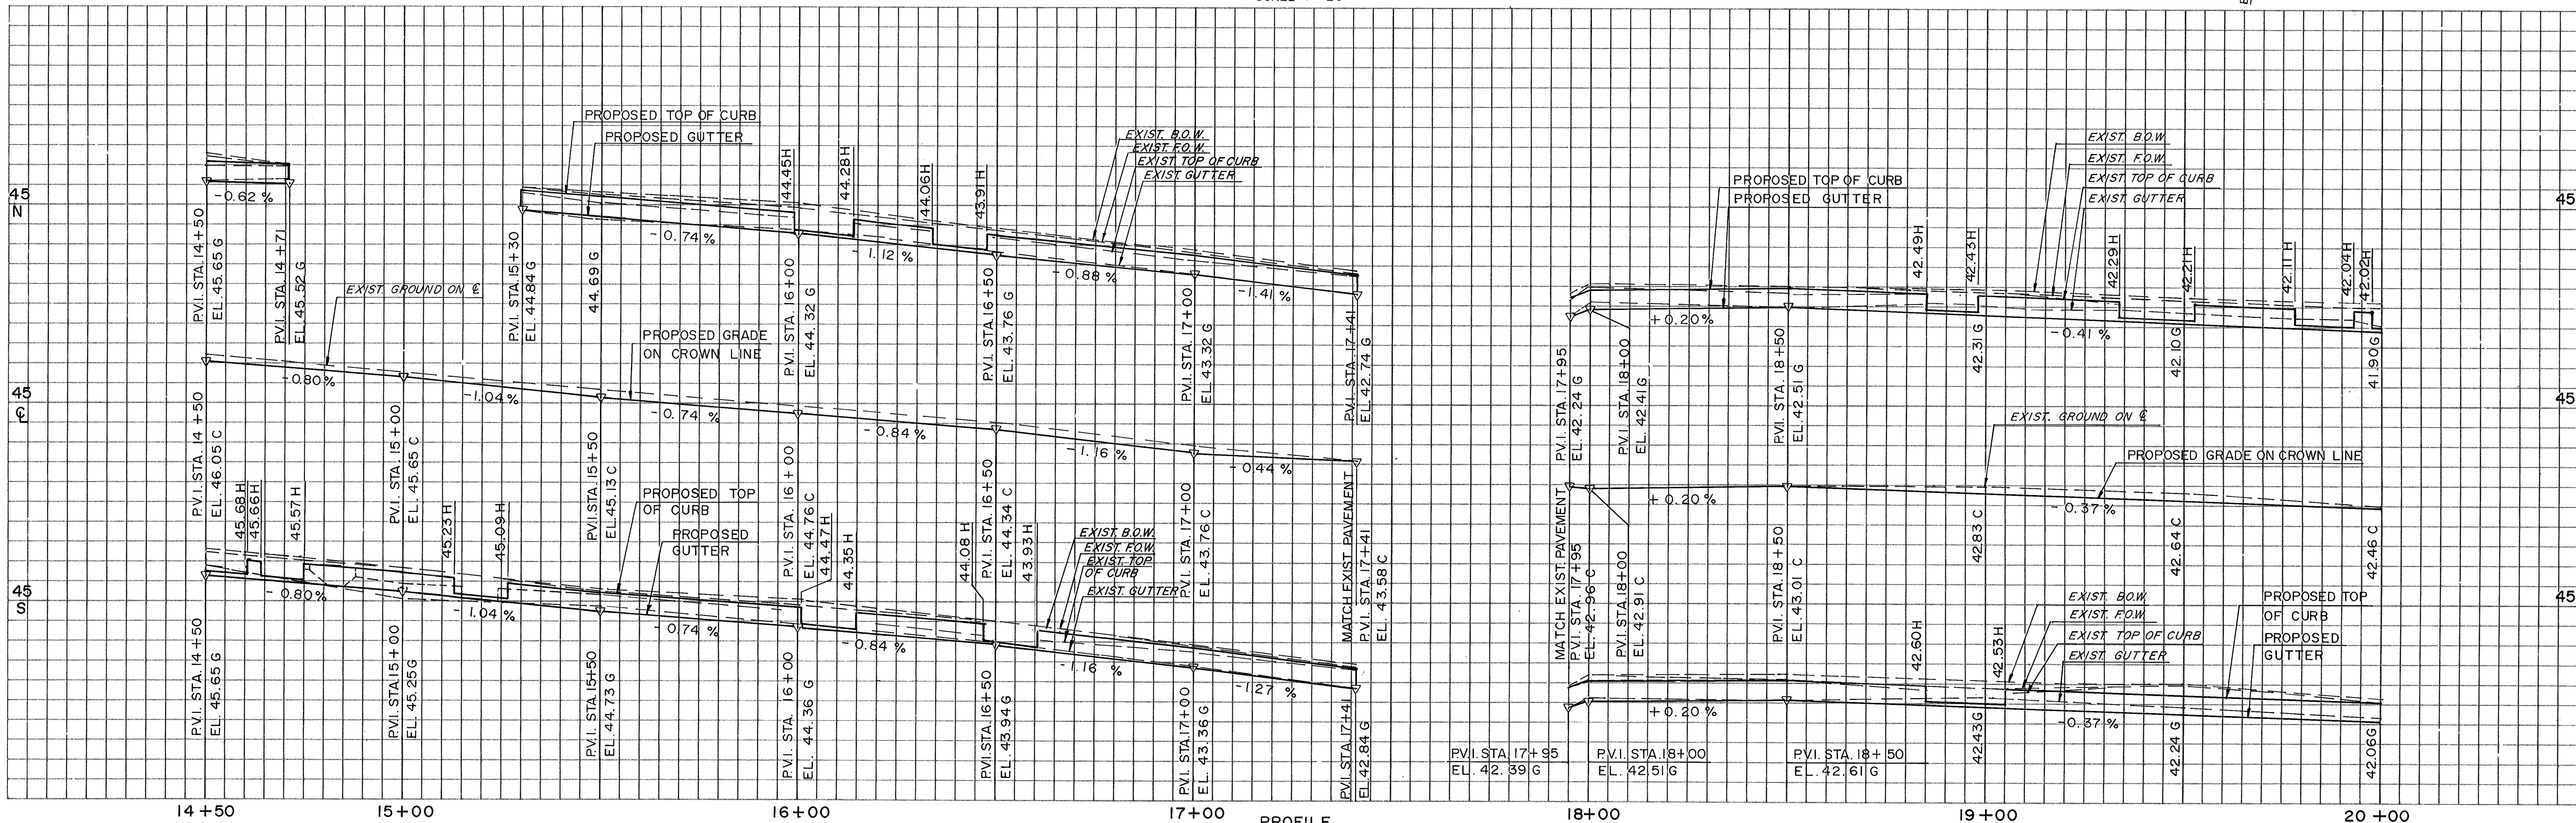


NOTES

1. (B) SAWCUT BETWEEN EXIST. RAMPED SECTION AND SIDEWALK, AND CONSTRUCT 8" REINFORCED CONC. DRIVEWAY RAMP
- (D) CONSTRUCT 8" REINFORCED CONC. SIDEWALK
- (E) CONSTRUCT 2" BIT. CONC. SURFACE ON NEW FOUNDATION, EXCEPT AT DRIVEWAYS AND RAMPS.
- (F) SEEDING AND MULCHING
- (G) CONSTRUCT 8" REINFORCED CONC. DRIVEWAY RAMP
2. FOR GENERAL NOTES AND LIST OF ABBREVIATIONS SEE SHEET NO. 2.
3. FOR CONSTRUCTION NOTES SEE SHEET NO. 8.
4. SURVEY BASELINE IS LOCATED 23.00 FT. SOUTH OF C.M.S. - 2.
- (H) CONSTRUCT BIT. CONC. DRIVEWAY.

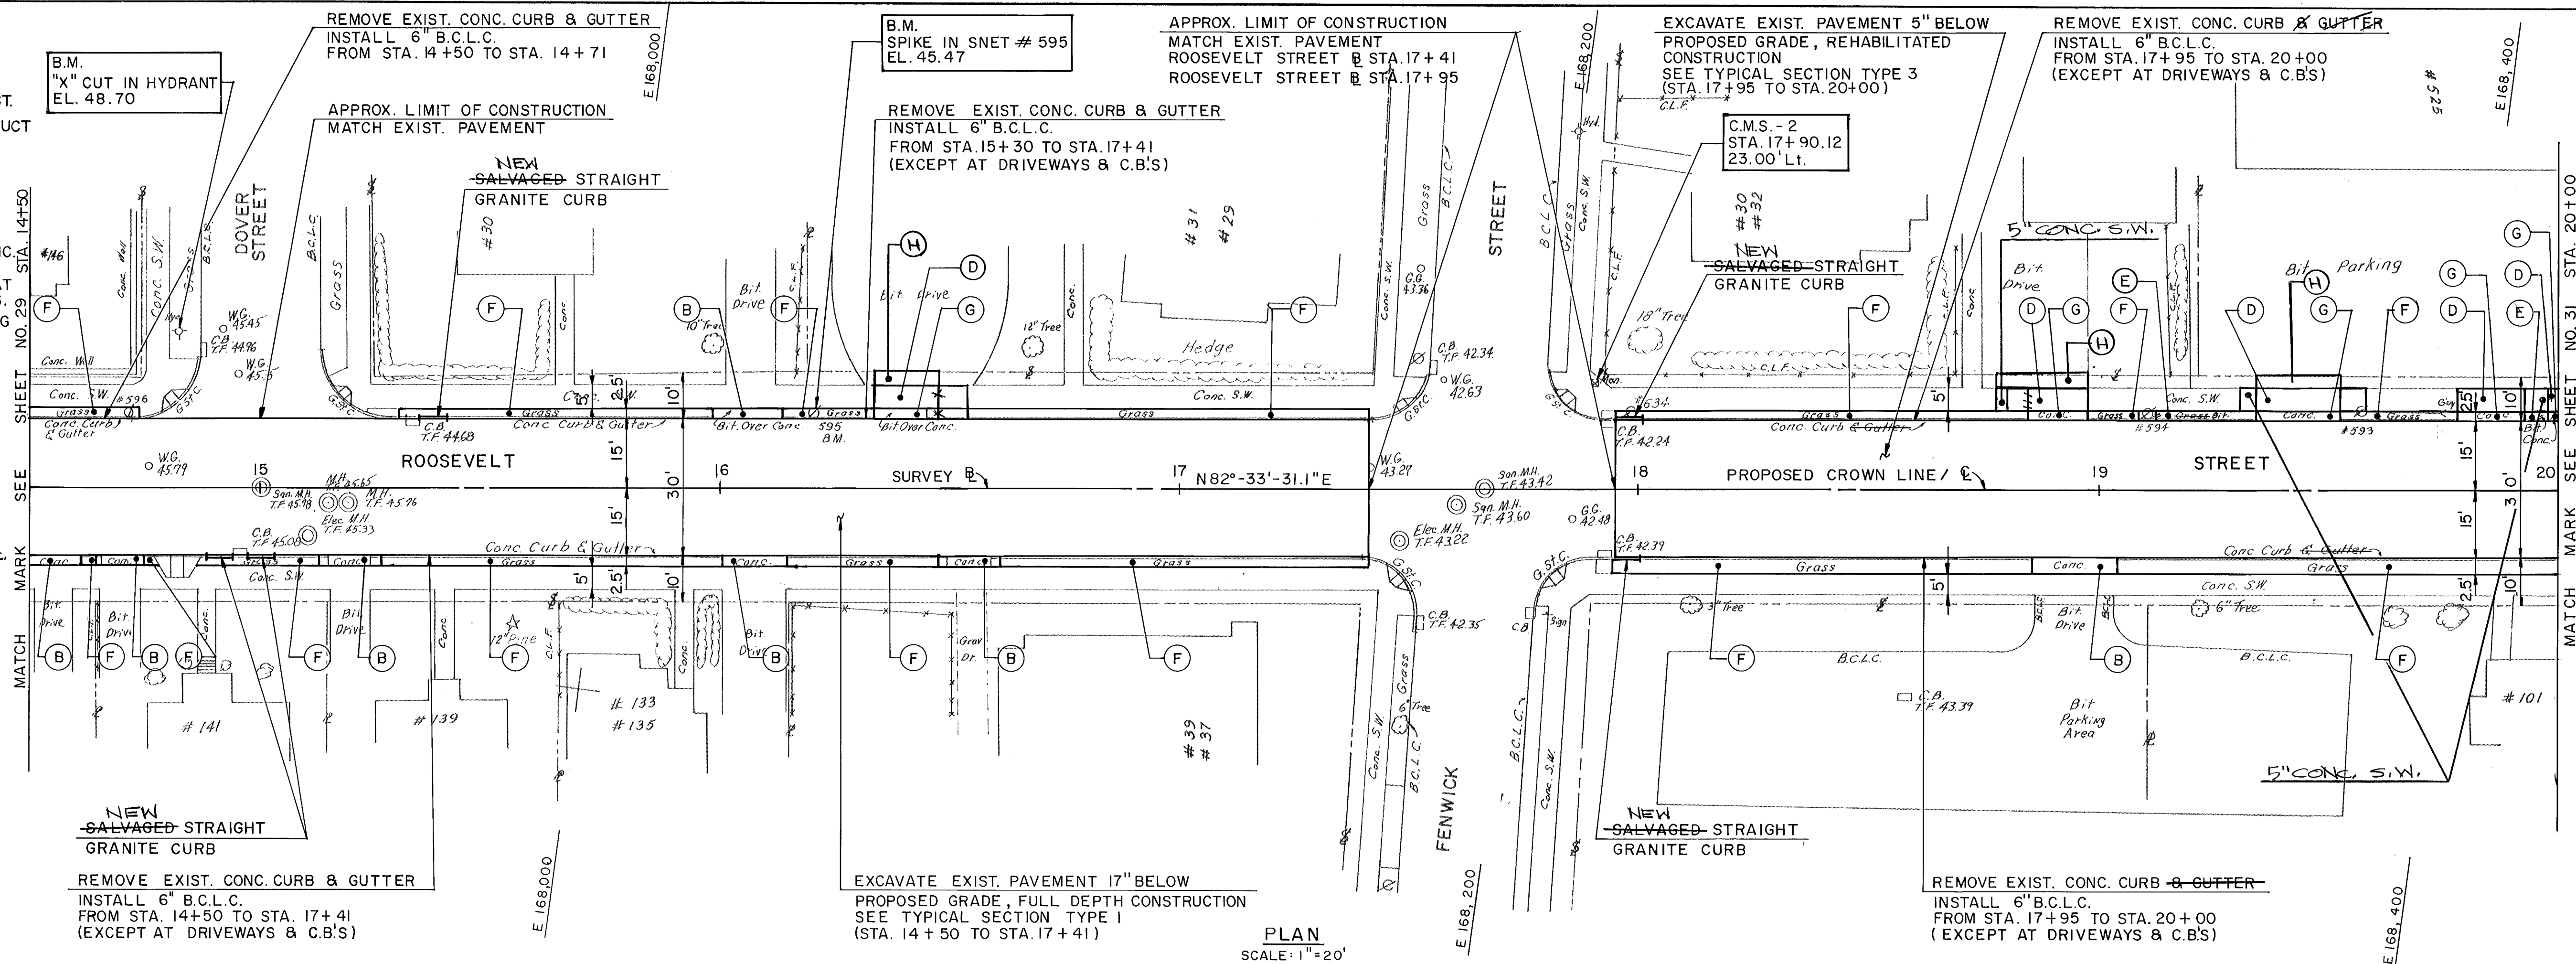

ROOSEVELT STREET			
PLAN AND PROFILE			
THE CITY OF HARTFORD, CONNECTICUT			
DESIGNED: I.R.	DATE: MARCH 23, 1988		
DRAWN: C.B.	SCALE: AS NOTED		
CHECKED: A.M.			
APPROVED: R.C.G.			
JUN 90 AS BUILT		SHEET NO. 30 OF 48	
		DAYBOOK NO. 011113 F	