



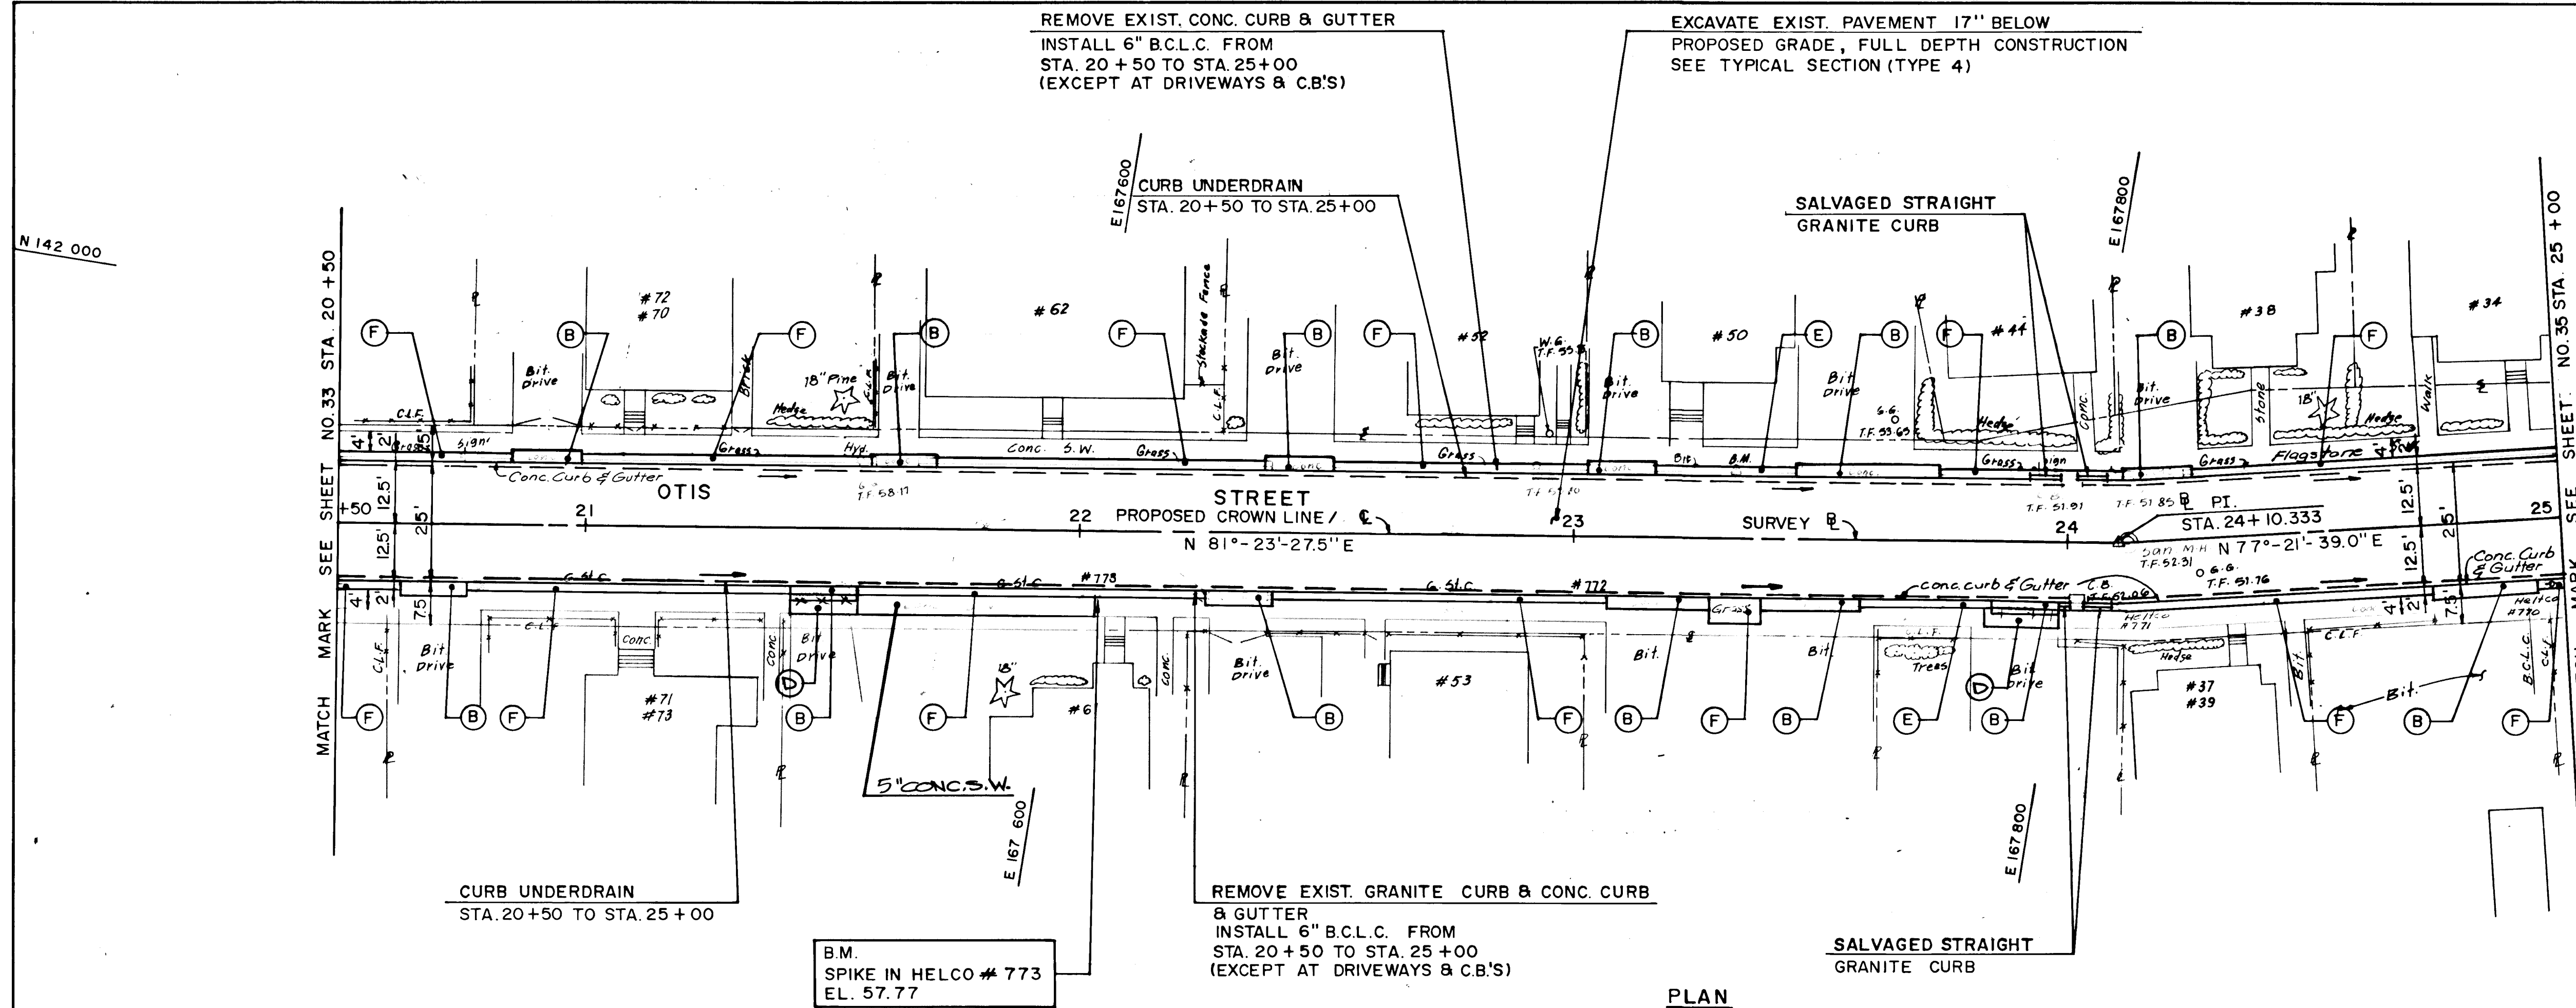

PLAN
SCALE: 1" = 20'

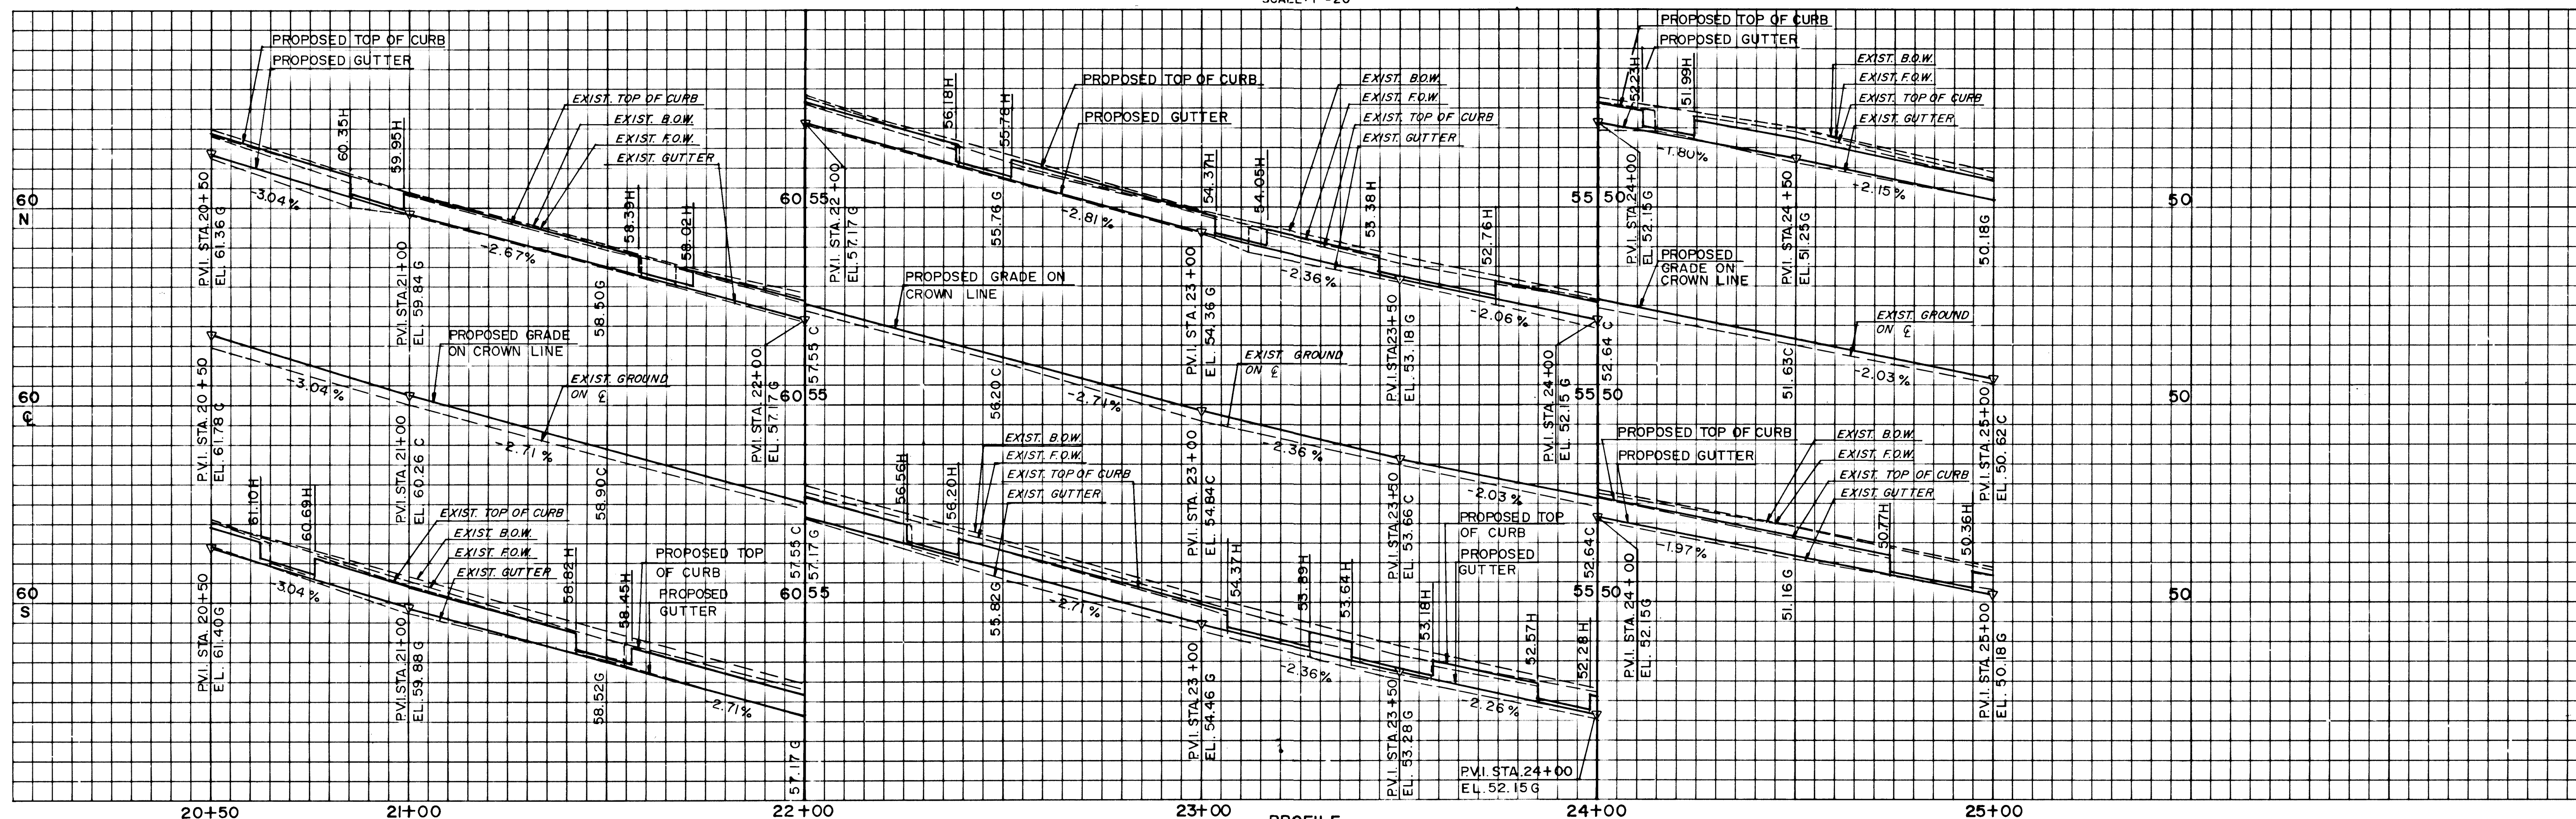

PROFILE
SCALE:
VERT. 1" = 20'
HORIZ. 1" = 20'

NOTES

- (B) SAWCUT BETWEEN EXISTING RAMPED SECTION AND SIDEWALK, AND CONSTRUCT 8" REINFORCED CONC. DRIVEWAY RAMP.
- (C) EXISTING DRIVEWAY RAMP TO REMAIN.
- (E) CONSTRUCT 2" BIT. CONC. SURFACE ON NEW FOUNDATION, EXCEPT AT DRIVEWAYS AND RAMPS.
- (F) SEEDING AND MULCHING.
- (D) CONSTRUCT 8" REINFORCED CONC. SIDEWALK.
- (H) CONSTRUCT BIT. CONC. DRIVEWAY.
- FOR GENERAL NOTES AND LIST OF ABBREVIATIONS SEE SHEET NO. 2.
- FOR CONSTRUCTION NOTES SEE SHEET NO. 8.
- SURVEY BASELINE IS LOCATED 12.50 FT. SOUTH FROM FACE OF NORTH CURB.

OTIS STREET			
PLAN AND PROFILE			
THE CITY OF HARTFORD, CONNECTICUT			
DESIGNED: D.M.		DATE: MARCH 23, 1988.	
DRAWN: C.B.		SCALE: AS NOTED	
CHECKED: A.M.		APPROVED: R.C.G.	
NO. DATE		REVISION	
JAN 90		AS BUILT	
SHEET NO. 34 OF 48		DAYBOOK NO. 011113 G	

PURCELL
ASSOCIATES