



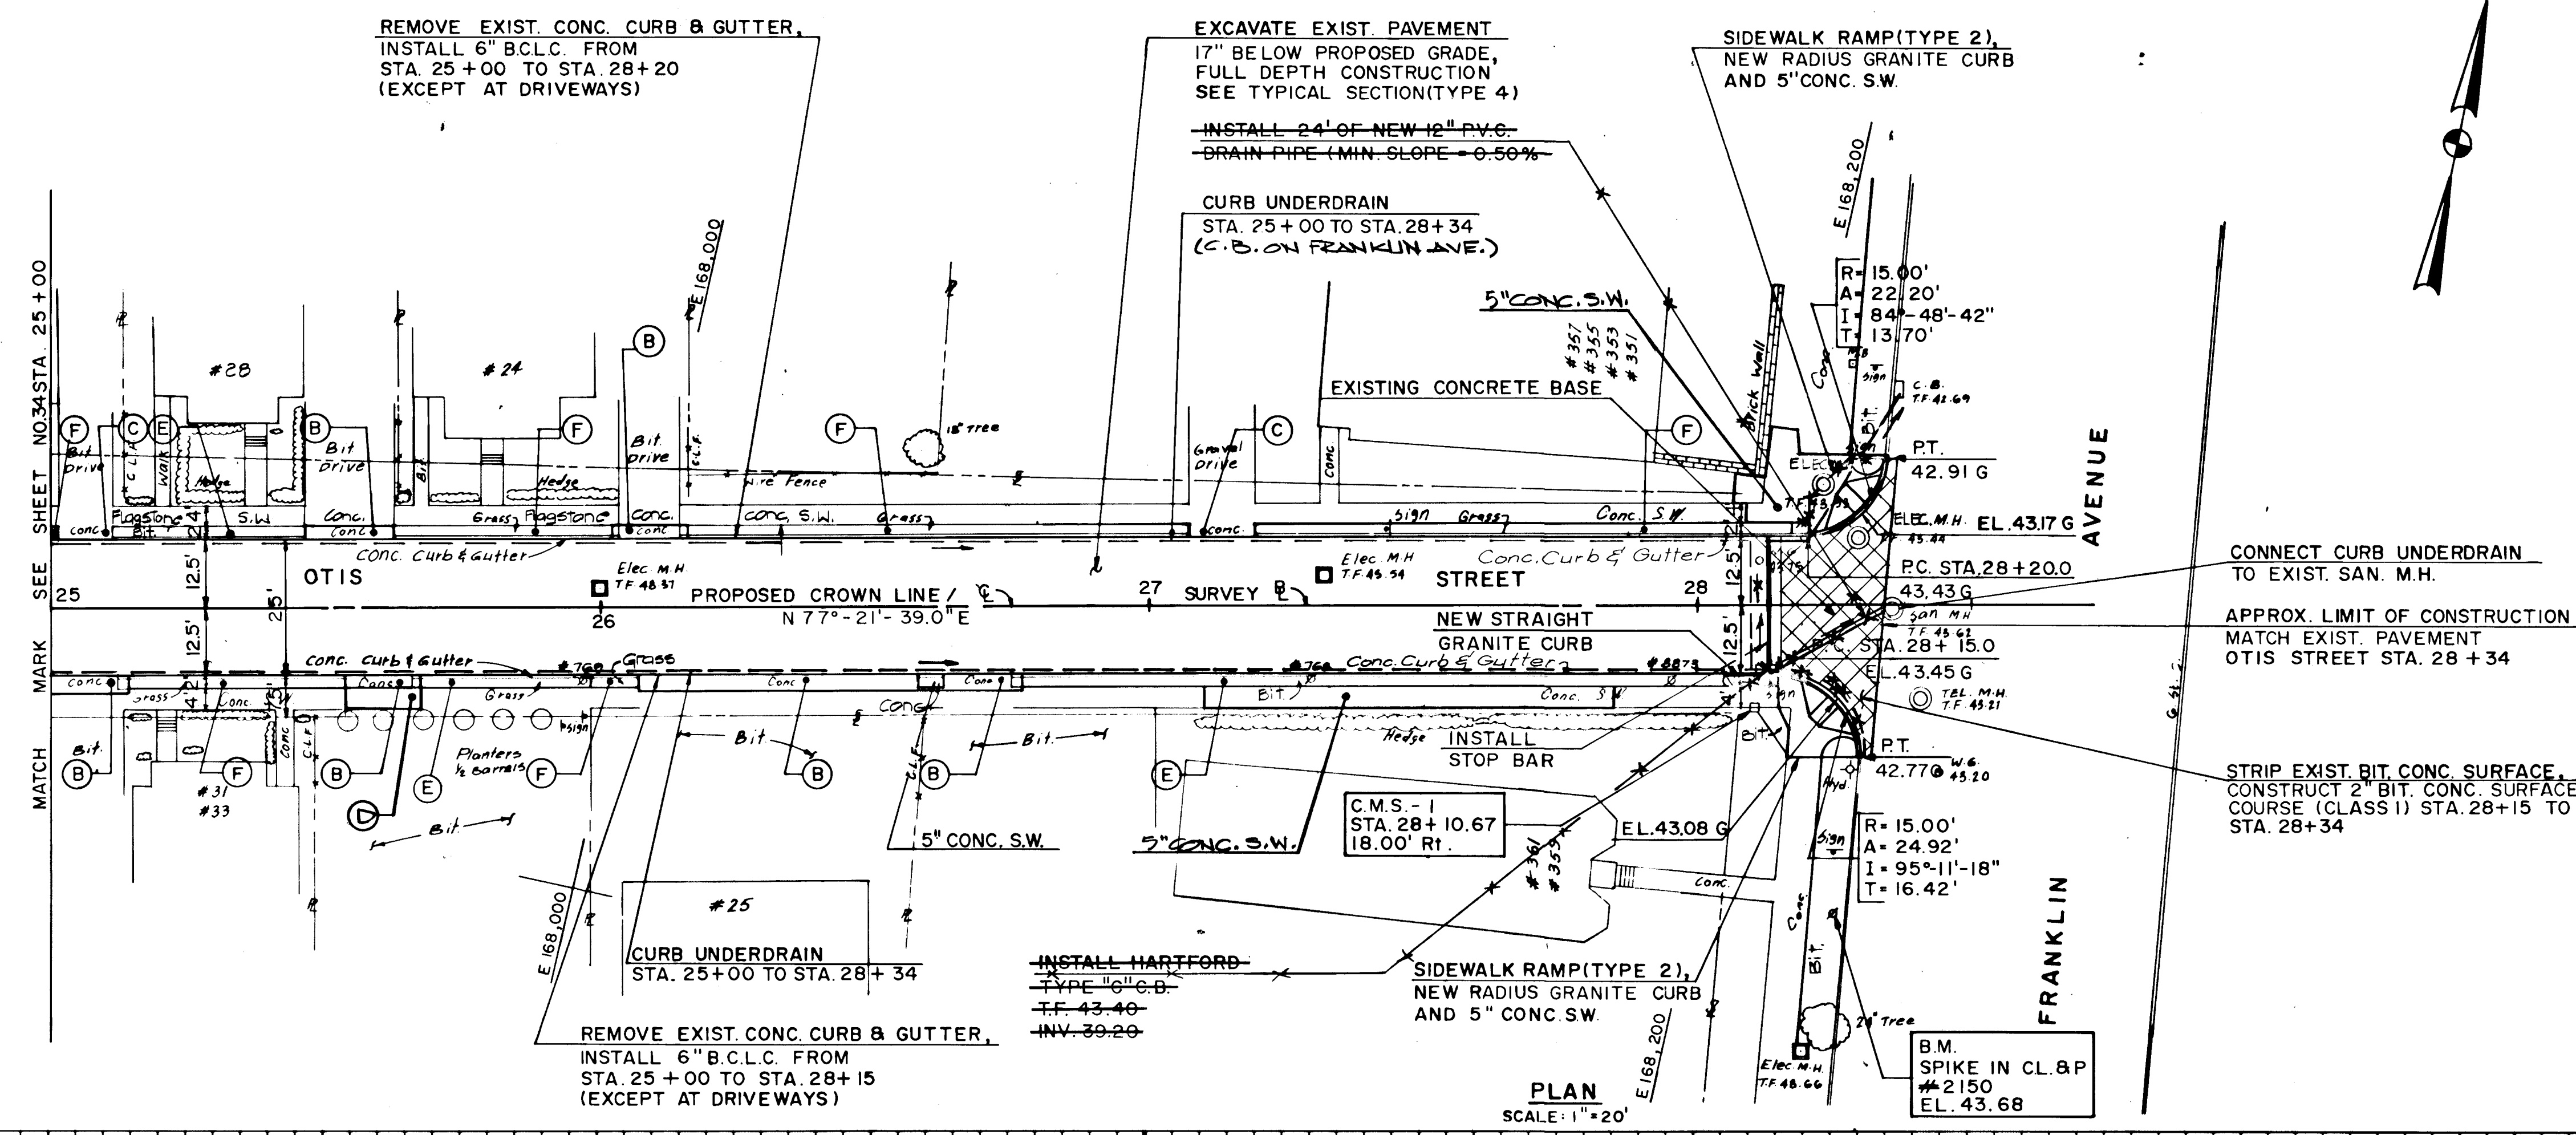

- NOTES**
- (B) SAWCUT BETWEEN EXISTING RAMPED SECTION AND SIDEWALK, AND CONSTRUCT 8" REINFORCED CONC. DRIVEWAY RAMP.
 - (C) EXISTING DRIVEWAY RAMP TO REMAIN.
 - (D) CONSTRUCT 8" REINFORCED CONC. SIDEWALK.
 - (E) CONSTRUCT 2" BIT. CONC. SURFACE ON NEW FOUNDATION, EXCEPT AT DRIVEWAYS AND RAMPS.
 - (F) SEEDING AND MULCHING
 - (G) CONSTRUCT 8" REINFORCED CONC. DRIVEWAY RAMP.
 - (H) CONSTRUCT BIT. CONC. DRIVEWAY.
- FOR GENERAL NOTES AND LIST OF ABBREVIATIONS SEE SHEET NO. 2
 - FOR CONSTRUCTION NOTES SEE SHEET NO. 8
 - SURVEY BASELINE IS LOCATED 18.00 FT. NORTH OF C.M.S.-I

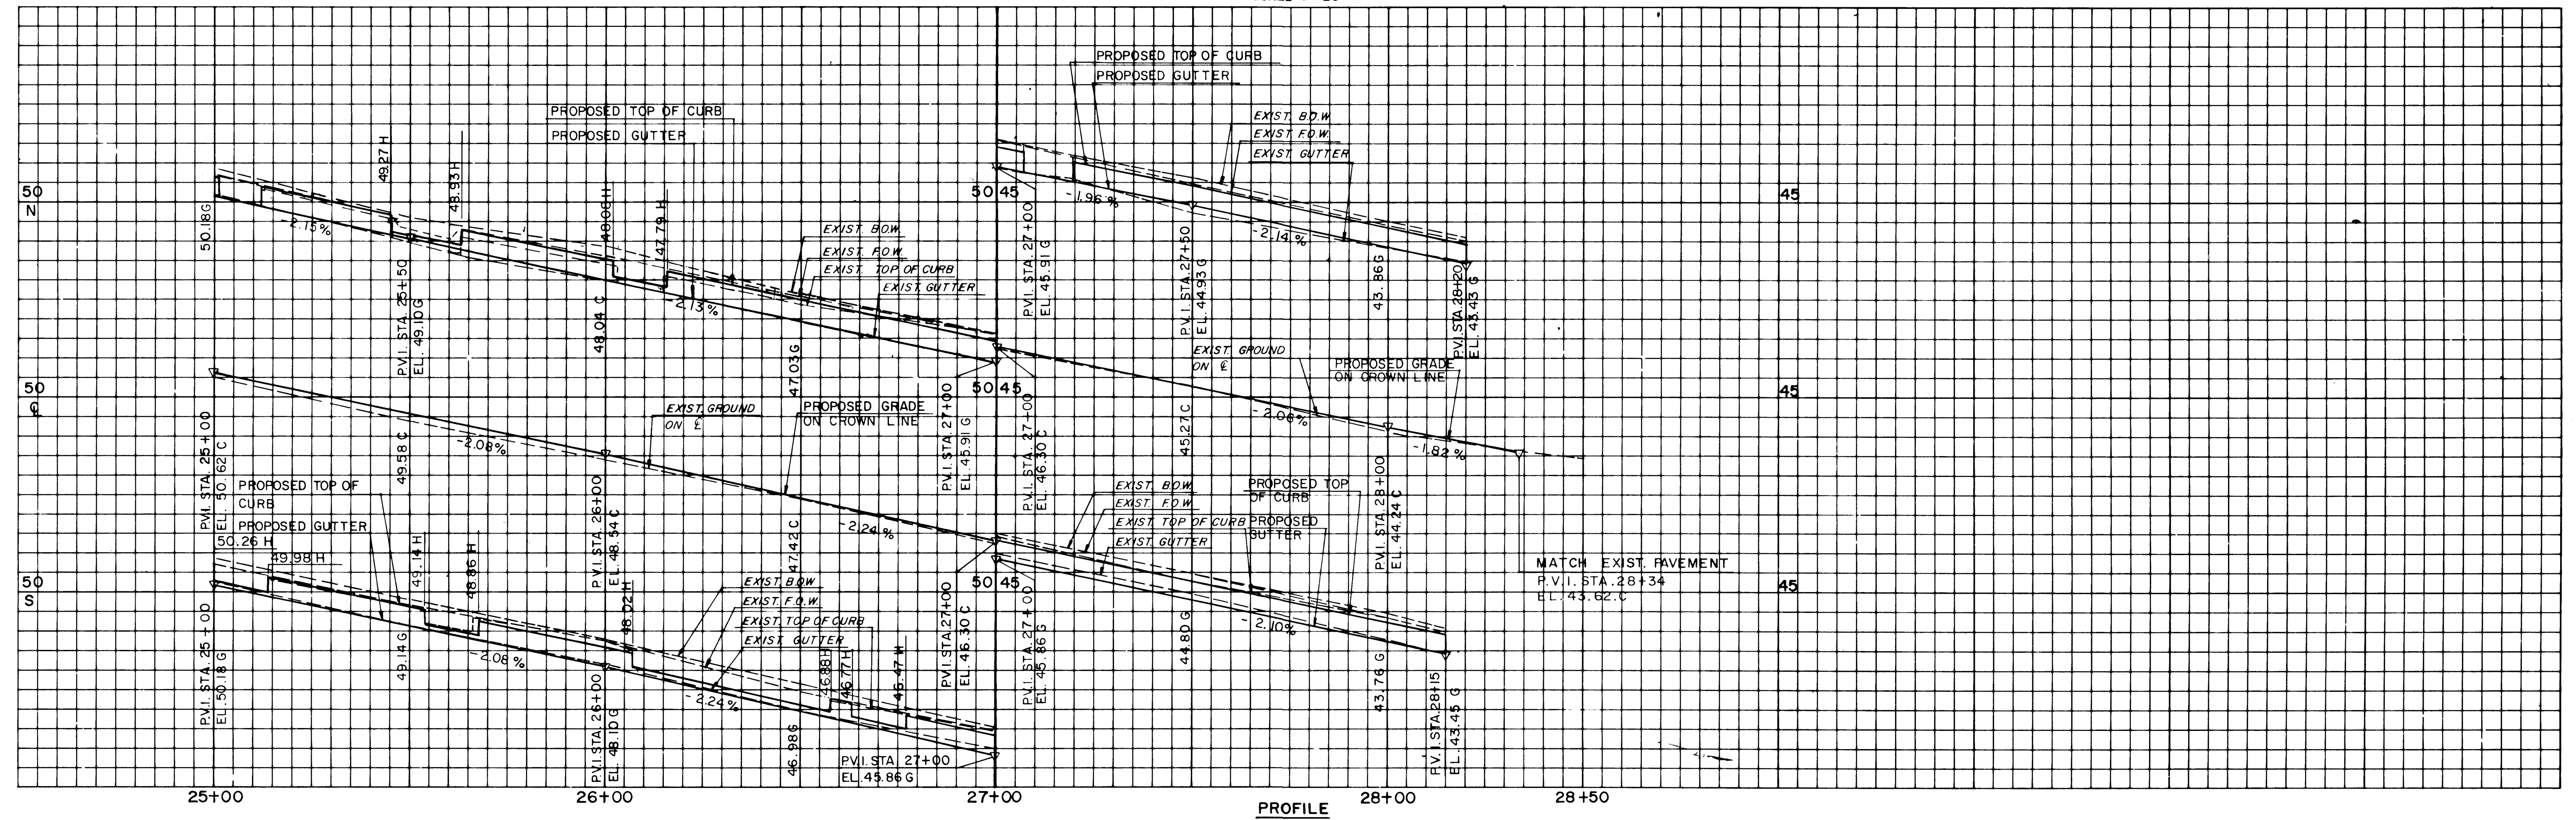

OTIS STREET			
PLAN AND PROFILE			
THE CITY OF HARTFORD, CONNECTICUT			
DESIGNED: D.M.	DATE: MARCH 23, 1988		
DRAWN: C.B.			
CHECKED: A.M.			
APPROVED: R.C.G.			
NO. DATE	REVISION	SCALE: AS NOTED	
1 7/20/88	DRAINAGE	SHEET NO. 35 OF 48	
JUN 98 AS BUILT		DAYBOOK NO. 011136	