



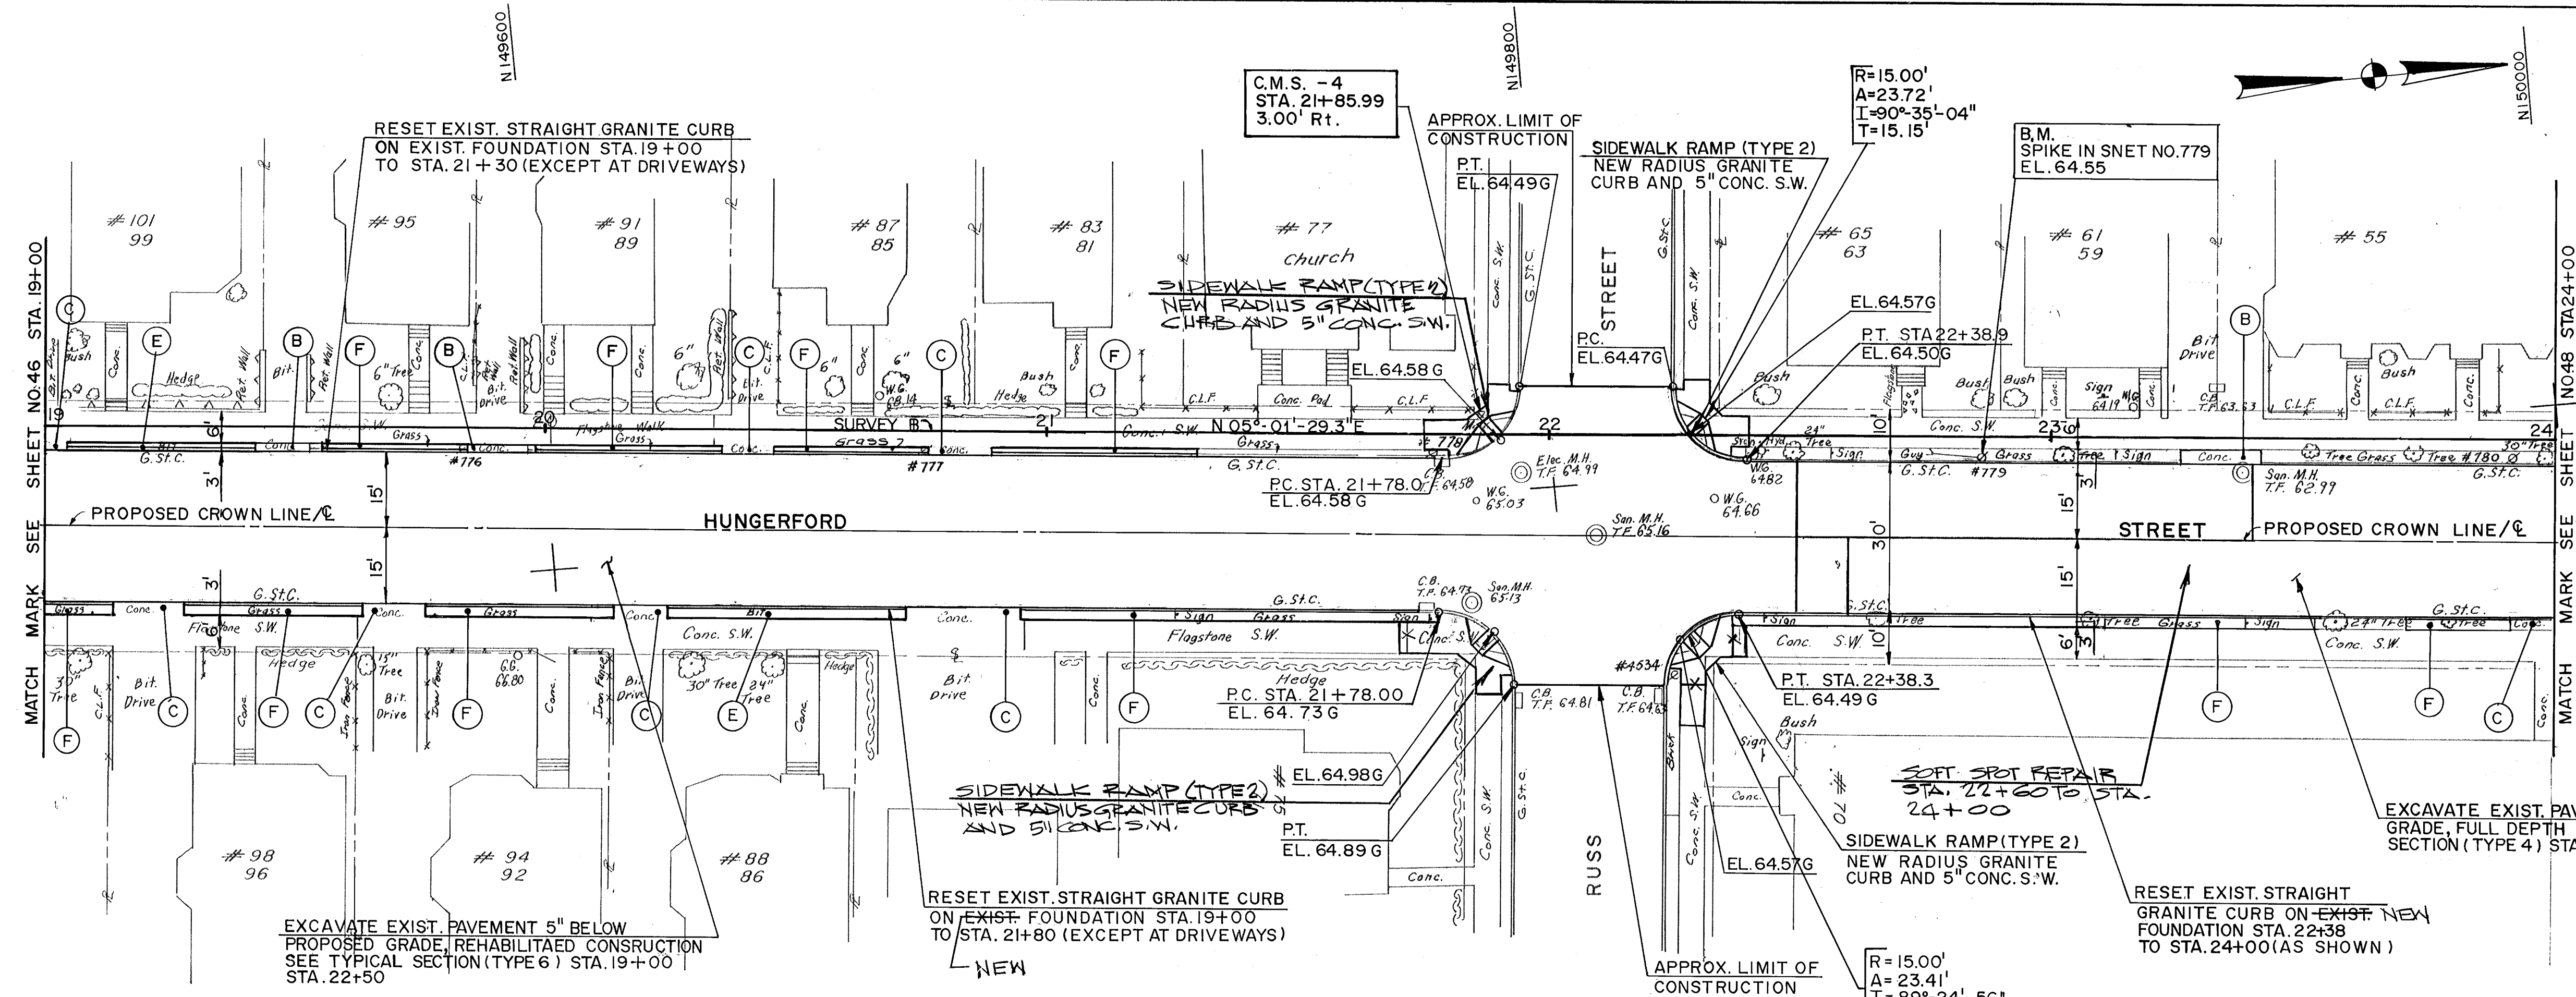

PLAN
SCALE: 1"=20'

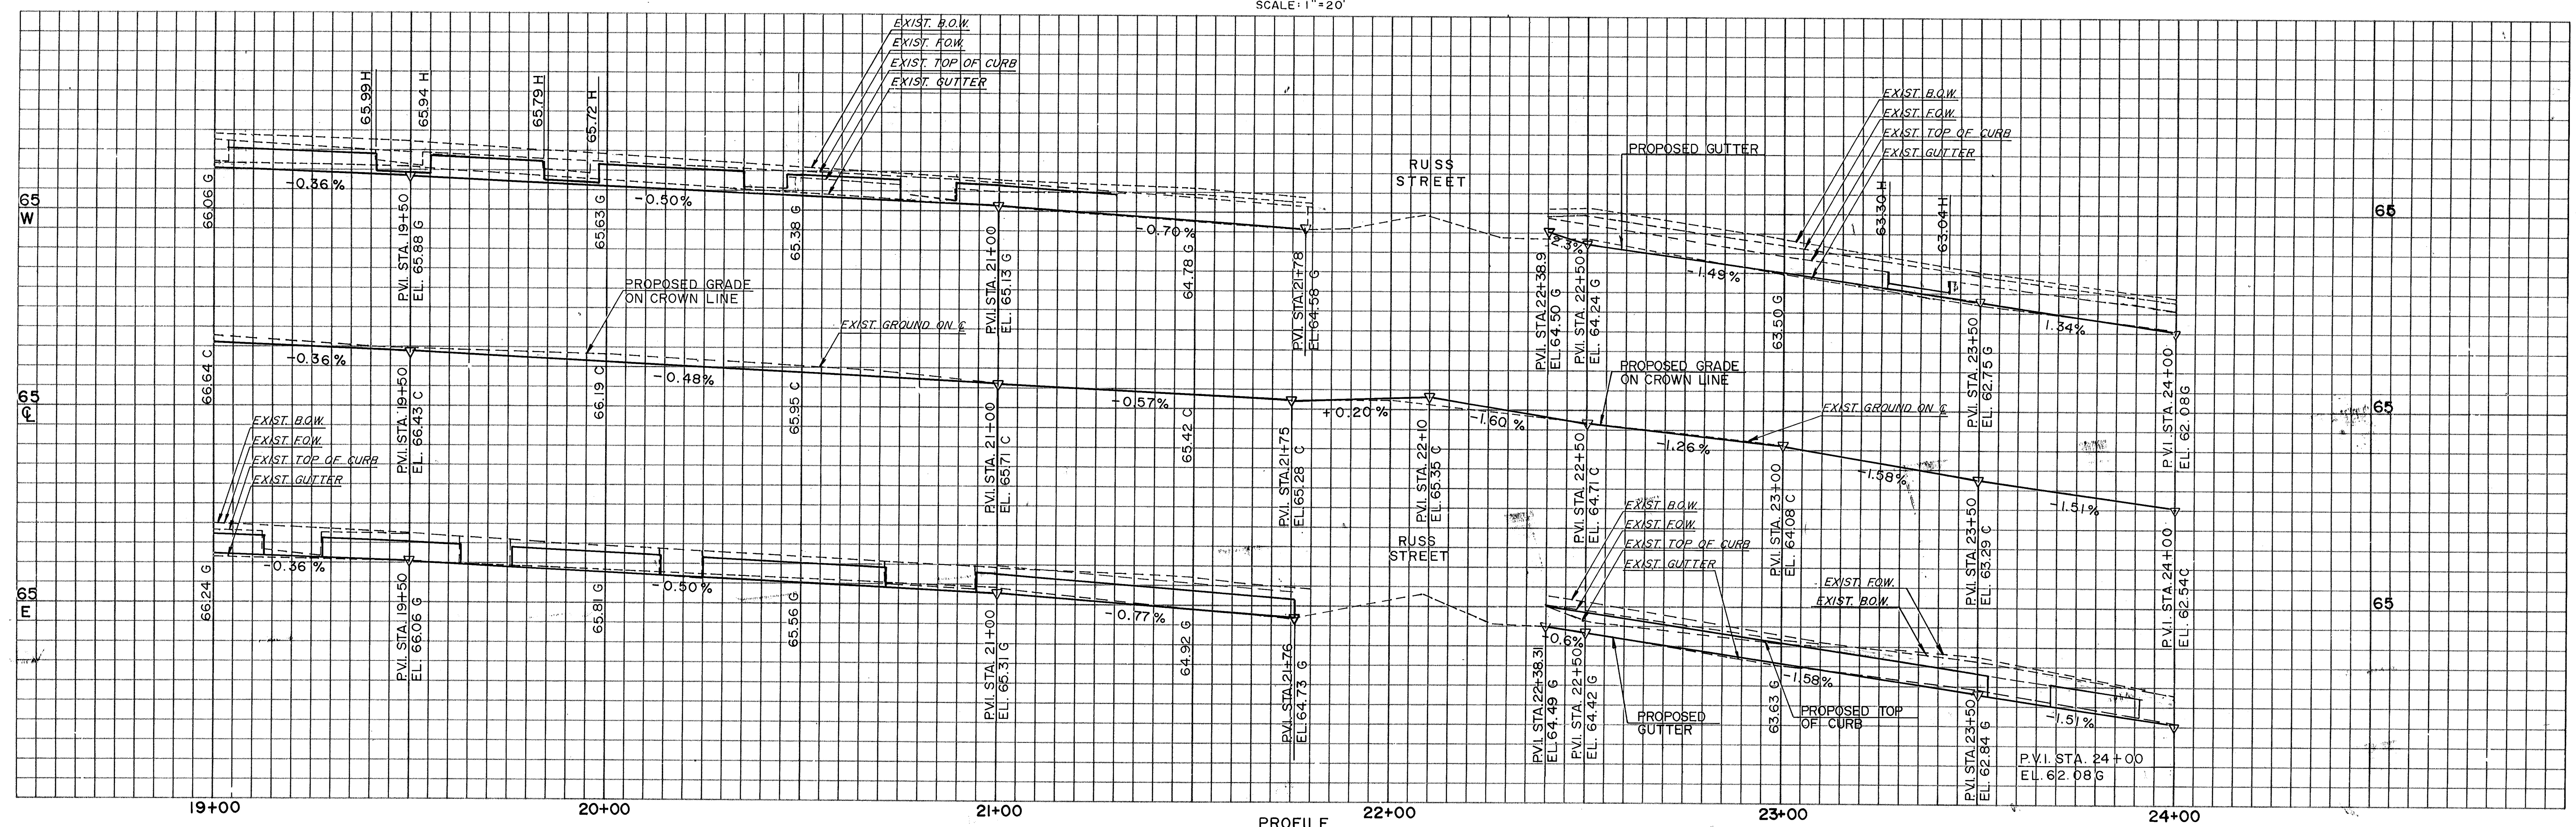

PROFILE
SCALE:
VERT. 1"=2'
HORIZ. 1"=20'

NOTES

- (B) SAWCUT BETWEEN EXISTING RAMPED SECTION AND SIDEWALK, AND CONSTRUCT 8" REINFORCED CONC. DRIVEWAY PAMP.
- (C) EXISTING DRIVEWAY RAMP TO REMAIN.
- (E) CONSTRUCT 2" BIT. CONC. SURFACE ON NEW FOUNDATION, EXCEPT AT DRIVEWAYS AND RAMPS.
- (F) SEEDING AND MULCHING.
- FOR GENERAL NOTES AND LIST OF ABBREVIATIONS SEE SHEET NO. 2
- FOR CONSTRUCTION NOTES SEE SHEET NO. 8
- SURVEY BASELINE IS LOCATED 3.00 FT. EAST OF C.M.S. - 4.

NO.	DATE	REVISION
1	JAN 90	AS-BUILT
2		
3		
HUNGERFORD STREET
PLAN AND PROFILE

THE CITY OF
HARTFORD, CONNECTICUT

DESIGNED: D.M.
DRAWN: M.J.F.
CHECKED: P.L.
APPROVED: R.C.G.

DATE MARCH 23, 1988.

SCALE AS NOTED

SHEET NO.
47 OF 48
DAYBOOK NO.
01113 L

PURCELL
ASSOCIATES