
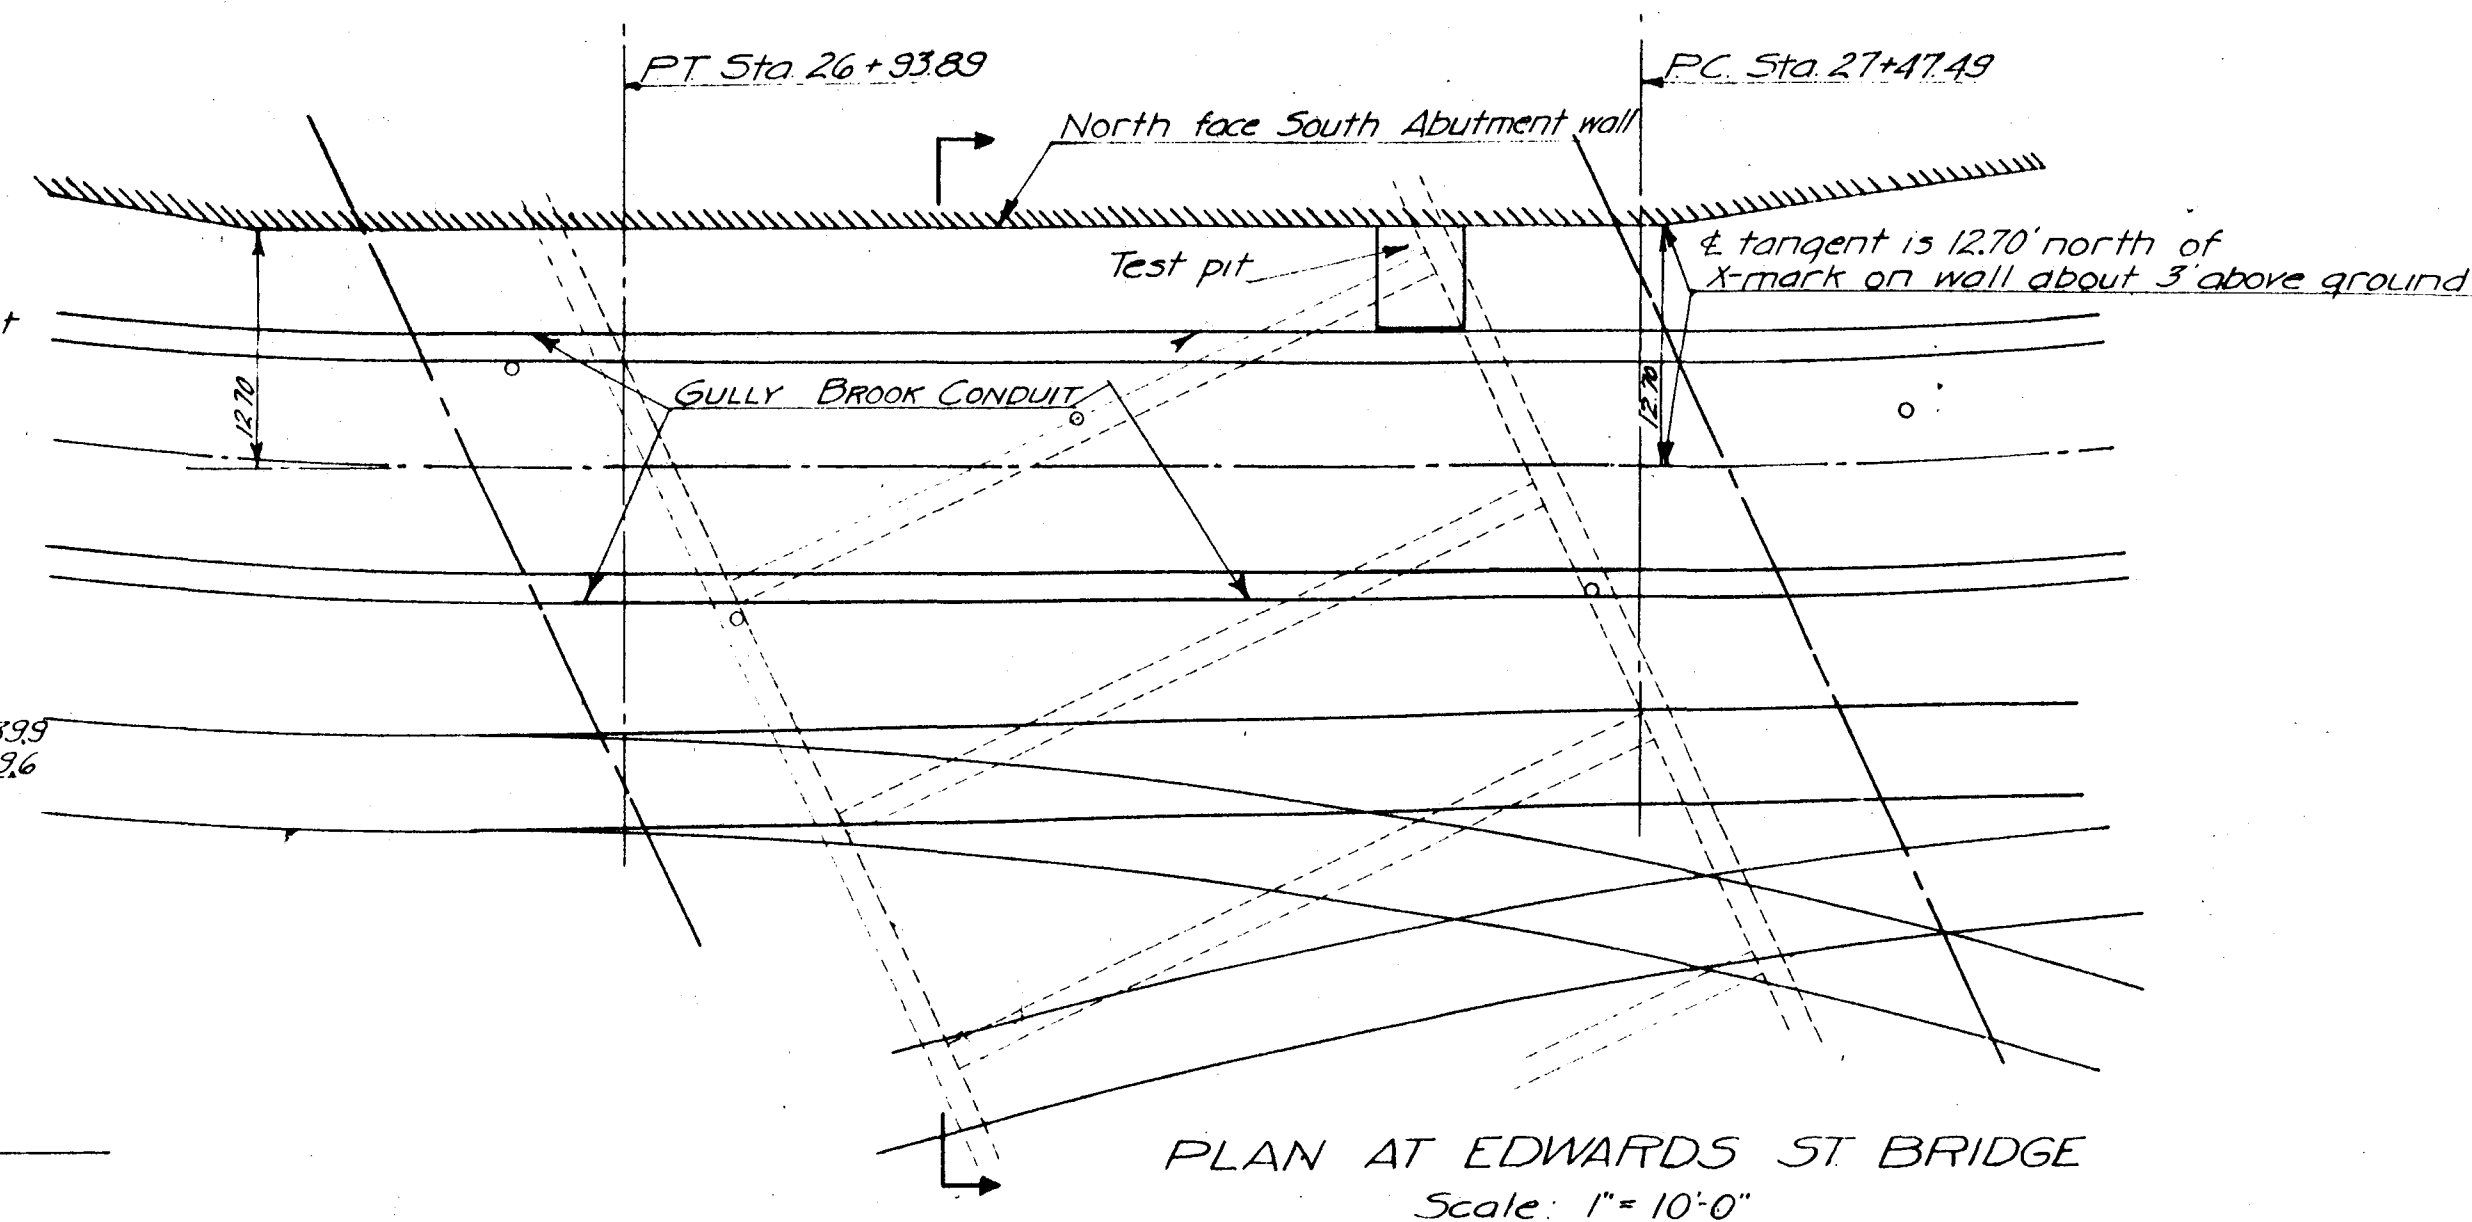
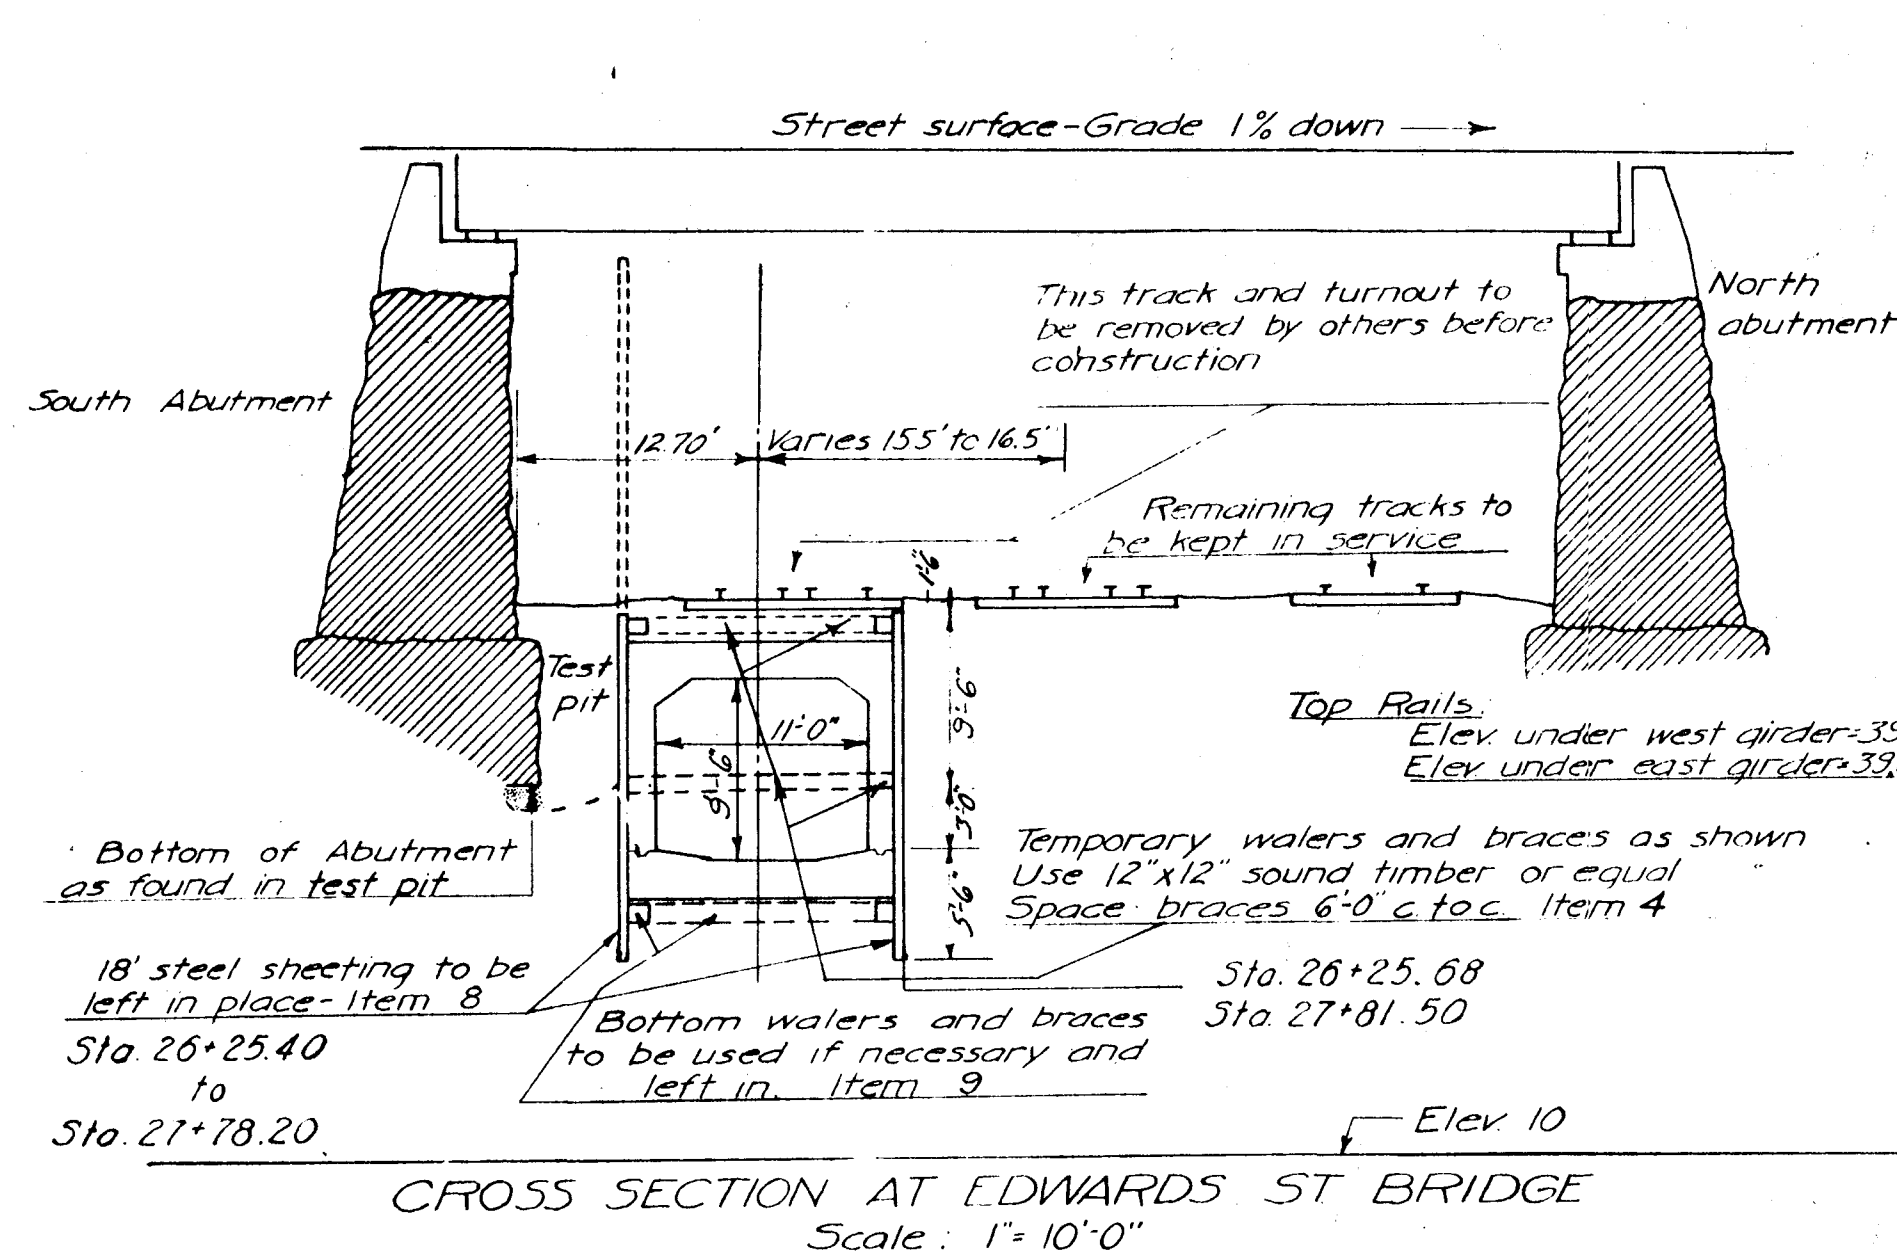


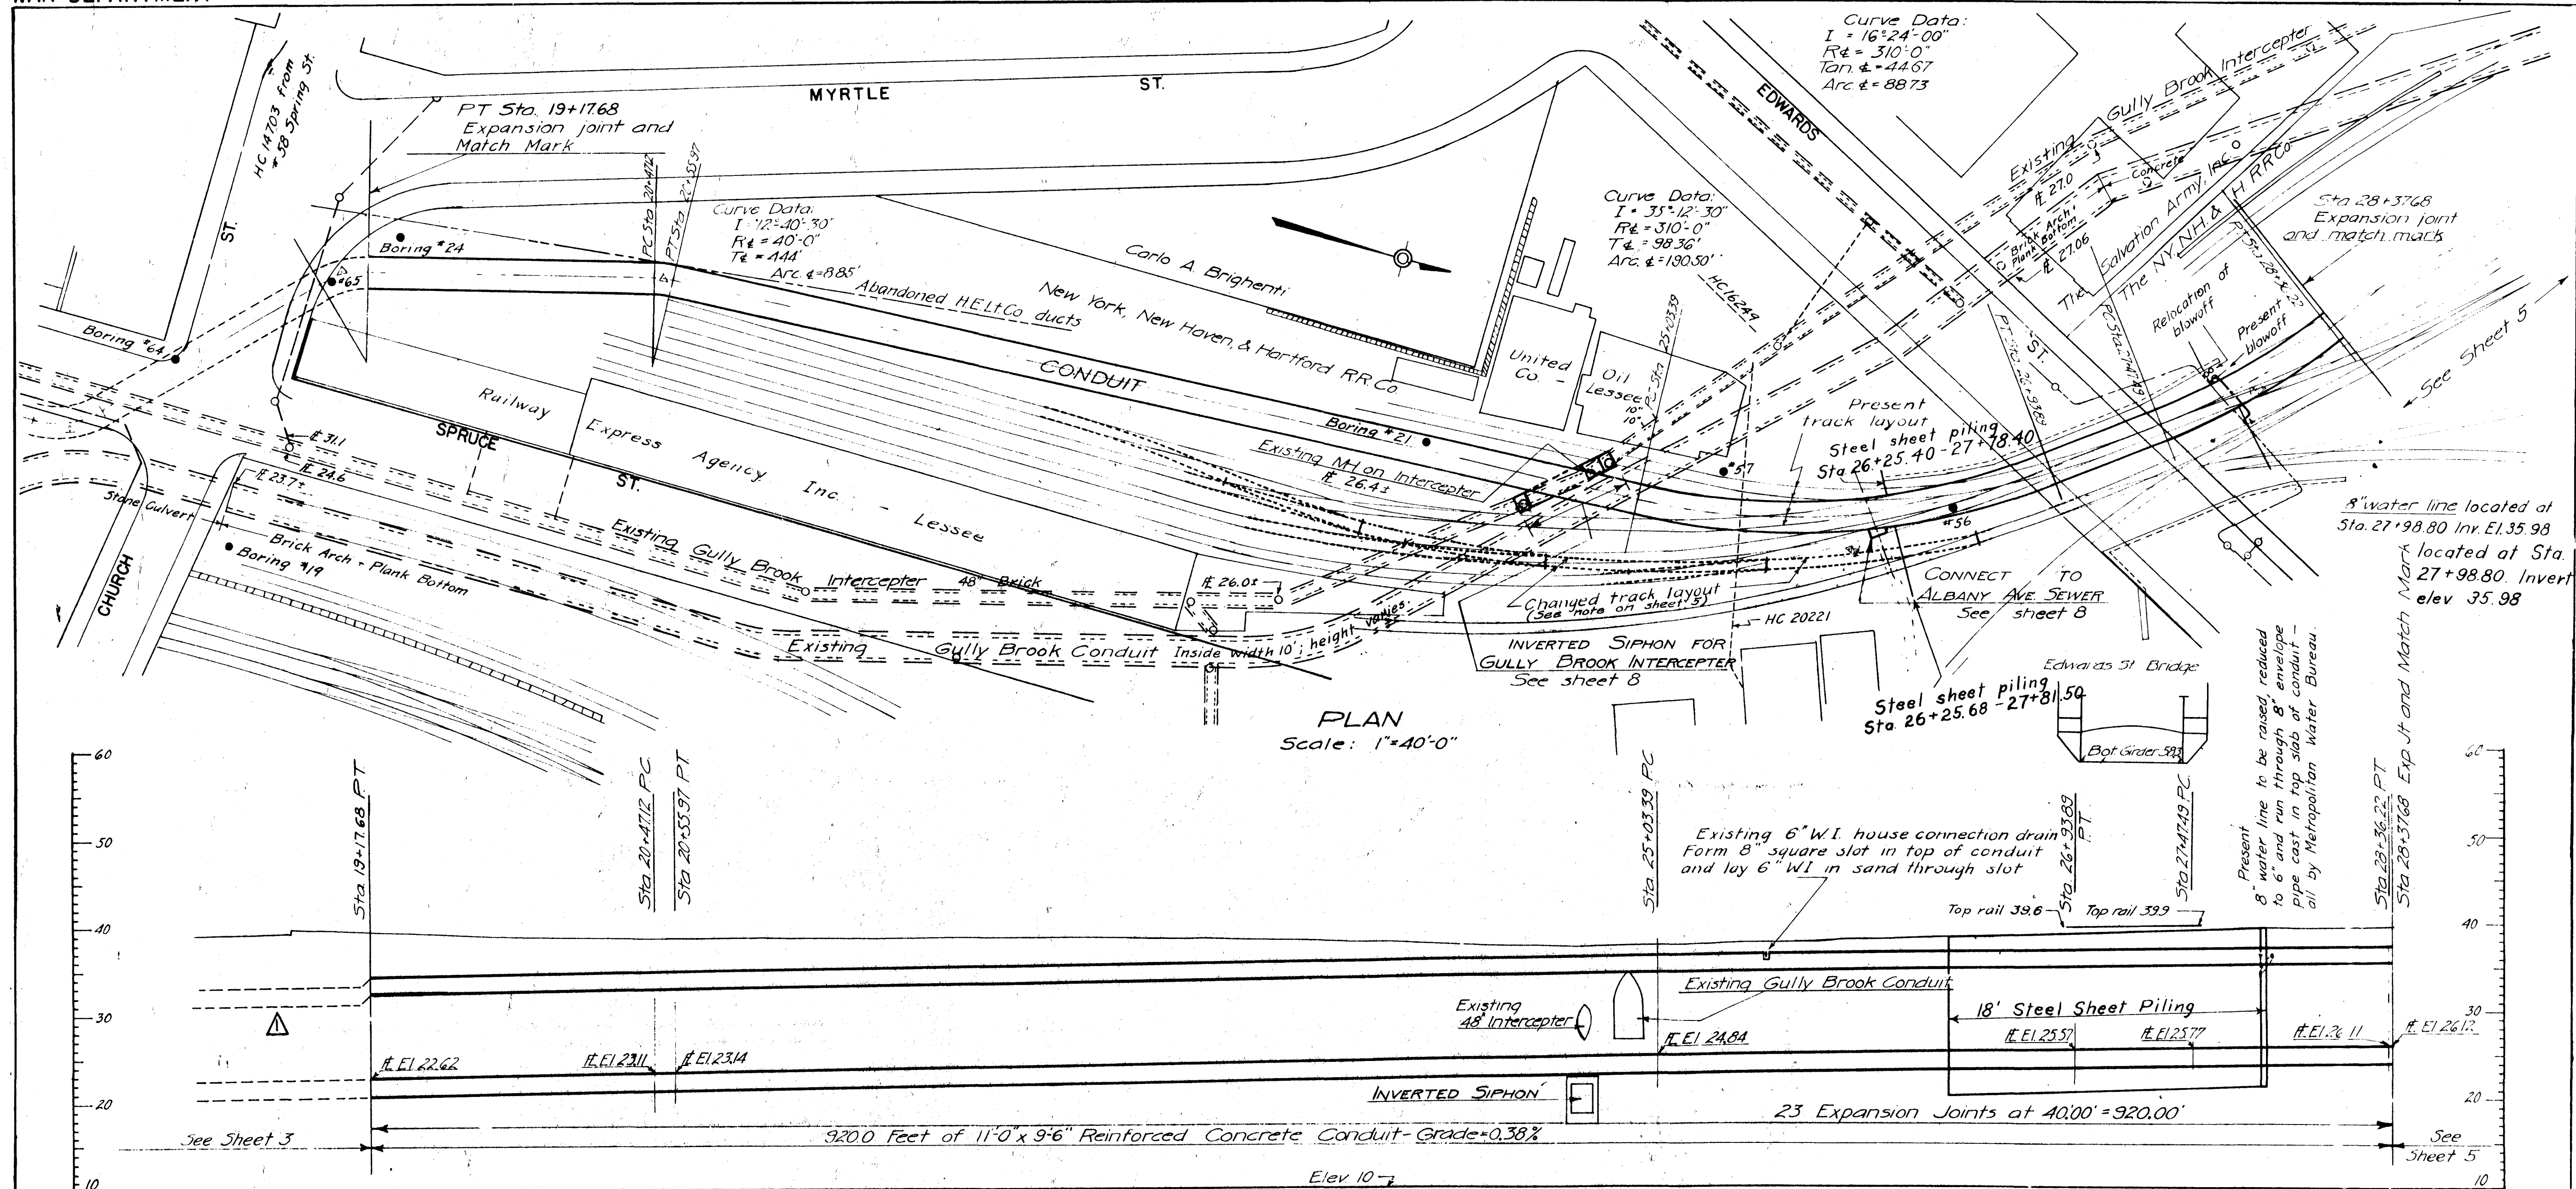

	12-31-45	As built revisions			
⚠	9-4-43	Conduit Roof lowered 1 ft.	Aug	Comp	288
KEY	DATE	REVISION (Indicated by Δ)	REV BY	CHK BY	AP BY
CONNECTICUT RIVER FLOOD CONTROL					
GULLY BROOK CONDUIT					
HARTFORD CONN.					
PLAN AND PROFILE					
FROM CHURCH STREET TO EDWARDS STREET					
STA. 19 + 17.68 TO STA. 28 + 37.68					
PARK RIVER			CONNECTICUT		
IN 9 SHEETS			SCALE		SHEET NO 4
			AS SHOWN		
U. S. ENGINEER OFFICE, PROVIDENCE, R. I., JULY, 1943					
REVIEWED:	APPROVAL RECOMMENDED:		APPROVED:		
<i>E. M. Lane</i>	<i>J. M. Burns</i>		<i>J. M. Burns</i>		
ENGINEER	PRINCIPAL ENGINEER		LT. COL. CORPS OF ENGINEERS		
	CHIEF, F. C. PLANNING DIV		DISTRICT ENGINEER		
BASIC DESIGN		DRAWN: W. G. D.			
BY		TRACED: W. G. D.			
THE CITY OF HARTFORD		CHECKED: A. W. S.			
		FILE NO. CT-4-3152			