
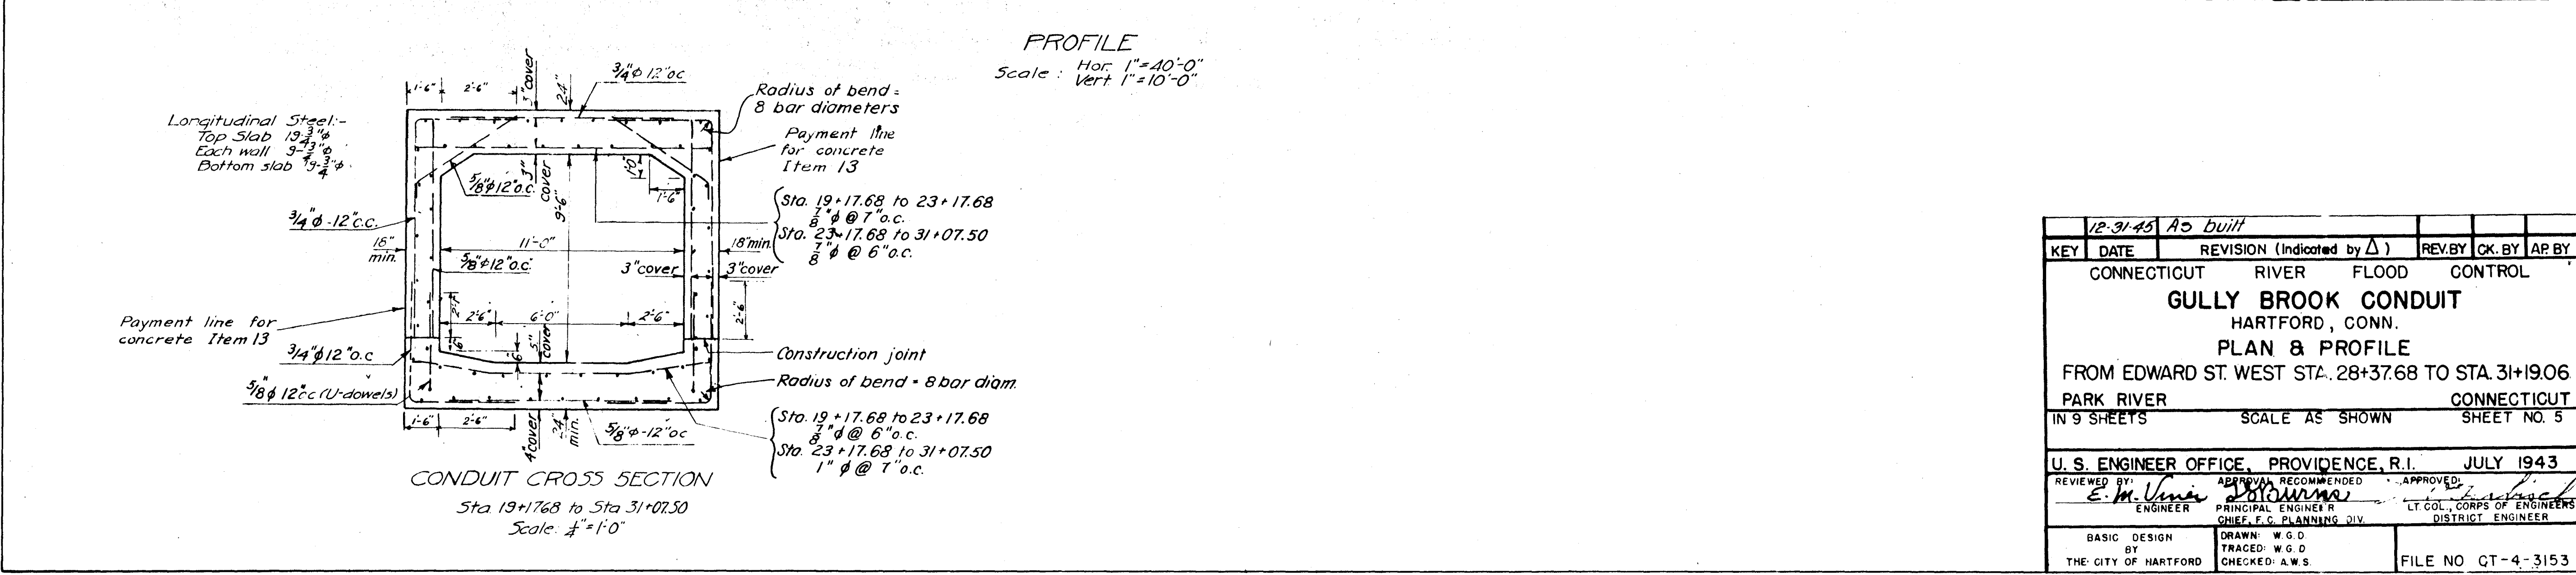
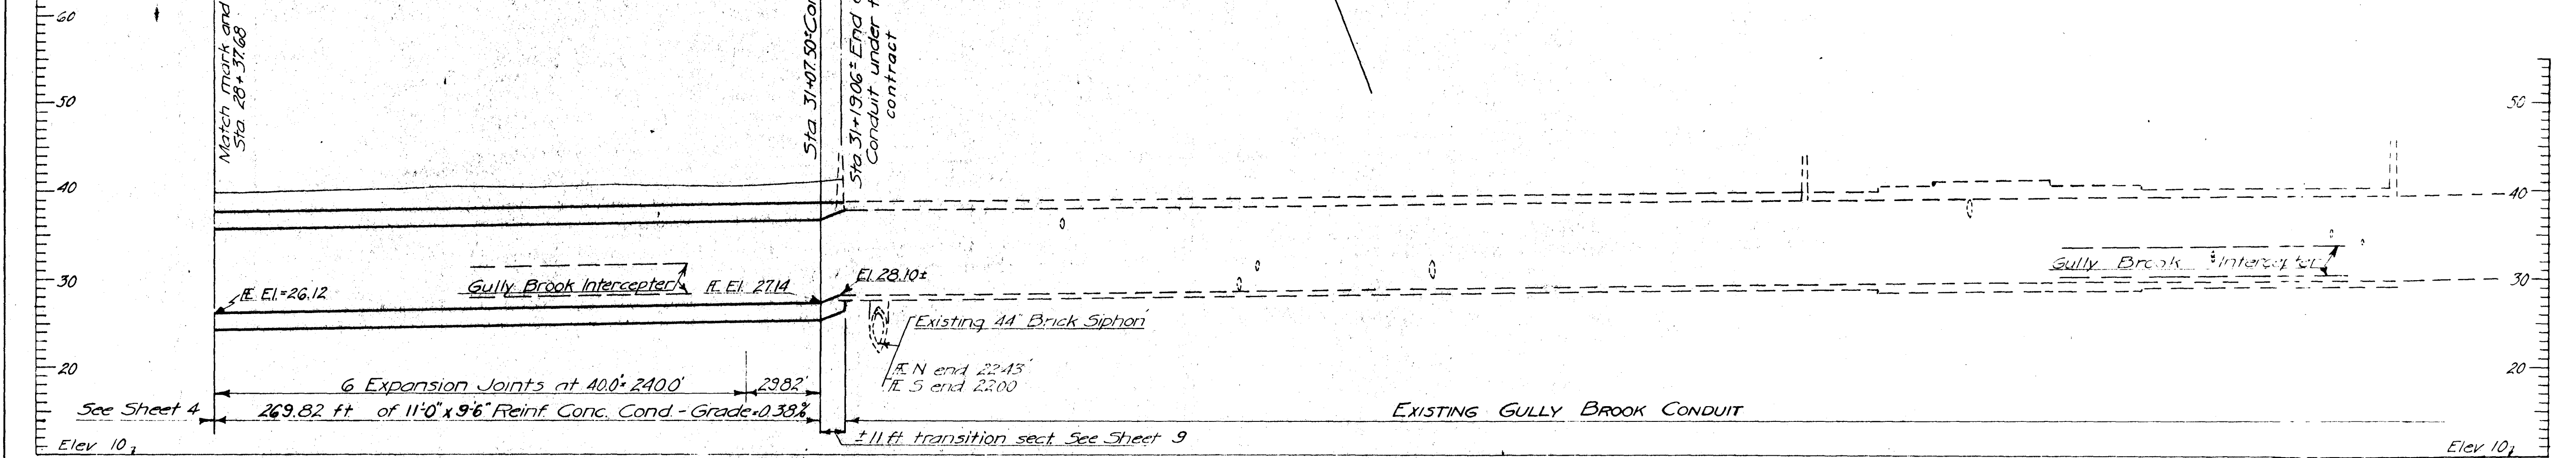


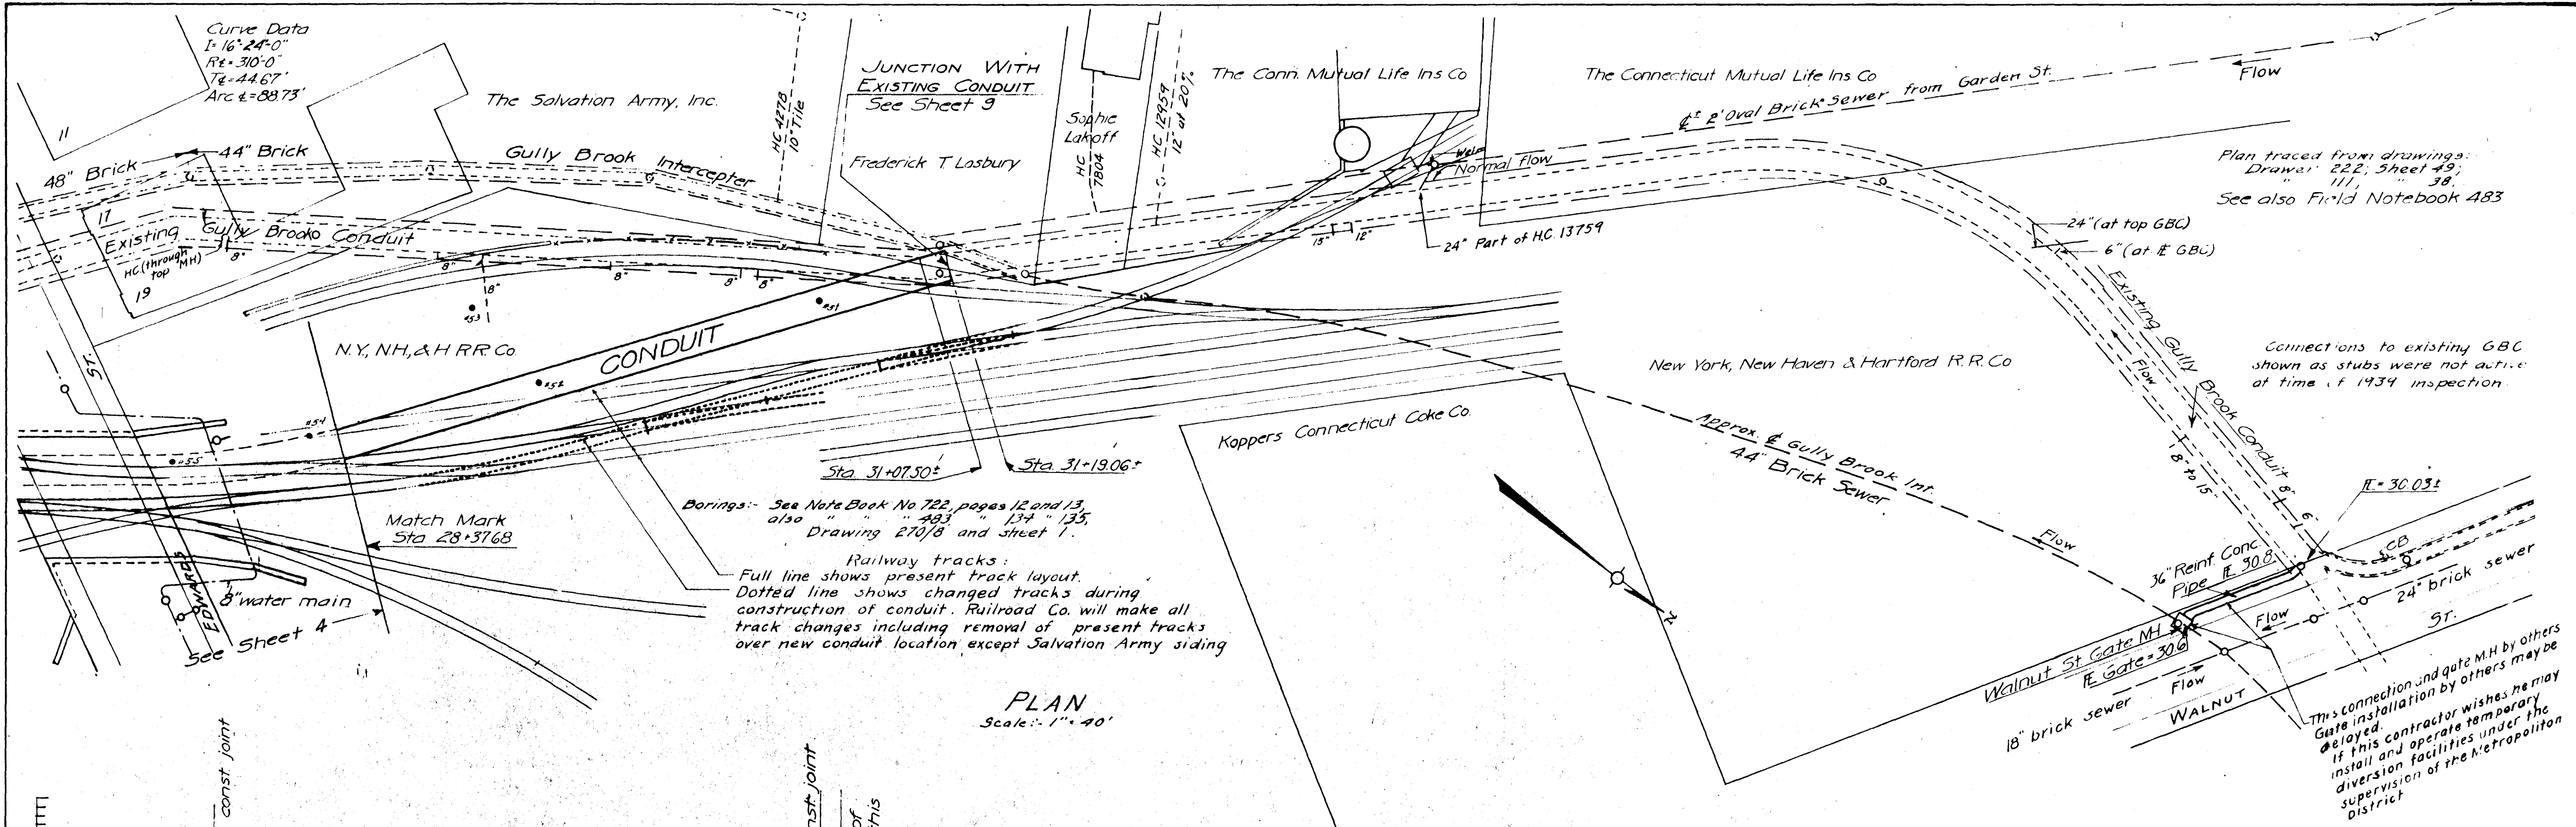

KEY	DATE	REVISION (Indicated by Δ)	REV. BY	CHK. BY	AP. BY
	12-31-45	As built			
CONNECTICUT RIVER FLOOD CONTROL					
GULLY BROOK CONDUIT					
HARTFORD, CONN.					
PLAN & PROFILE					
FROM EDWARD ST. WEST STA. 28+37.68 TO STA. 31+19.06					
PARK RIVER CONNECTICUT					
IN 9 SHEETS SCALE AS SHOWN SHEET NO. 5					
U. S. ENGINEER OFFICE, PROVIDENCE, R.I. JULY 1943					
REVIEWED BY: E. M. Viner ENGINEER					
APPROVED: J. M. Viner PRINCIPAL ENGINEER					
CHIEF, F.C. PLANNING DIV.					
APPROVED: J. M. Viner LT. COL., CORPS OF ENGINEERS					
DISTRICT ENGINEER					
BASIC DESIGN BY THE CITY OF HARTFORD					
DRAWN: W. G. D. TRACED: W. G. D. CHECKED: A. W. S.					
FILE NO. QT-4-3153					