
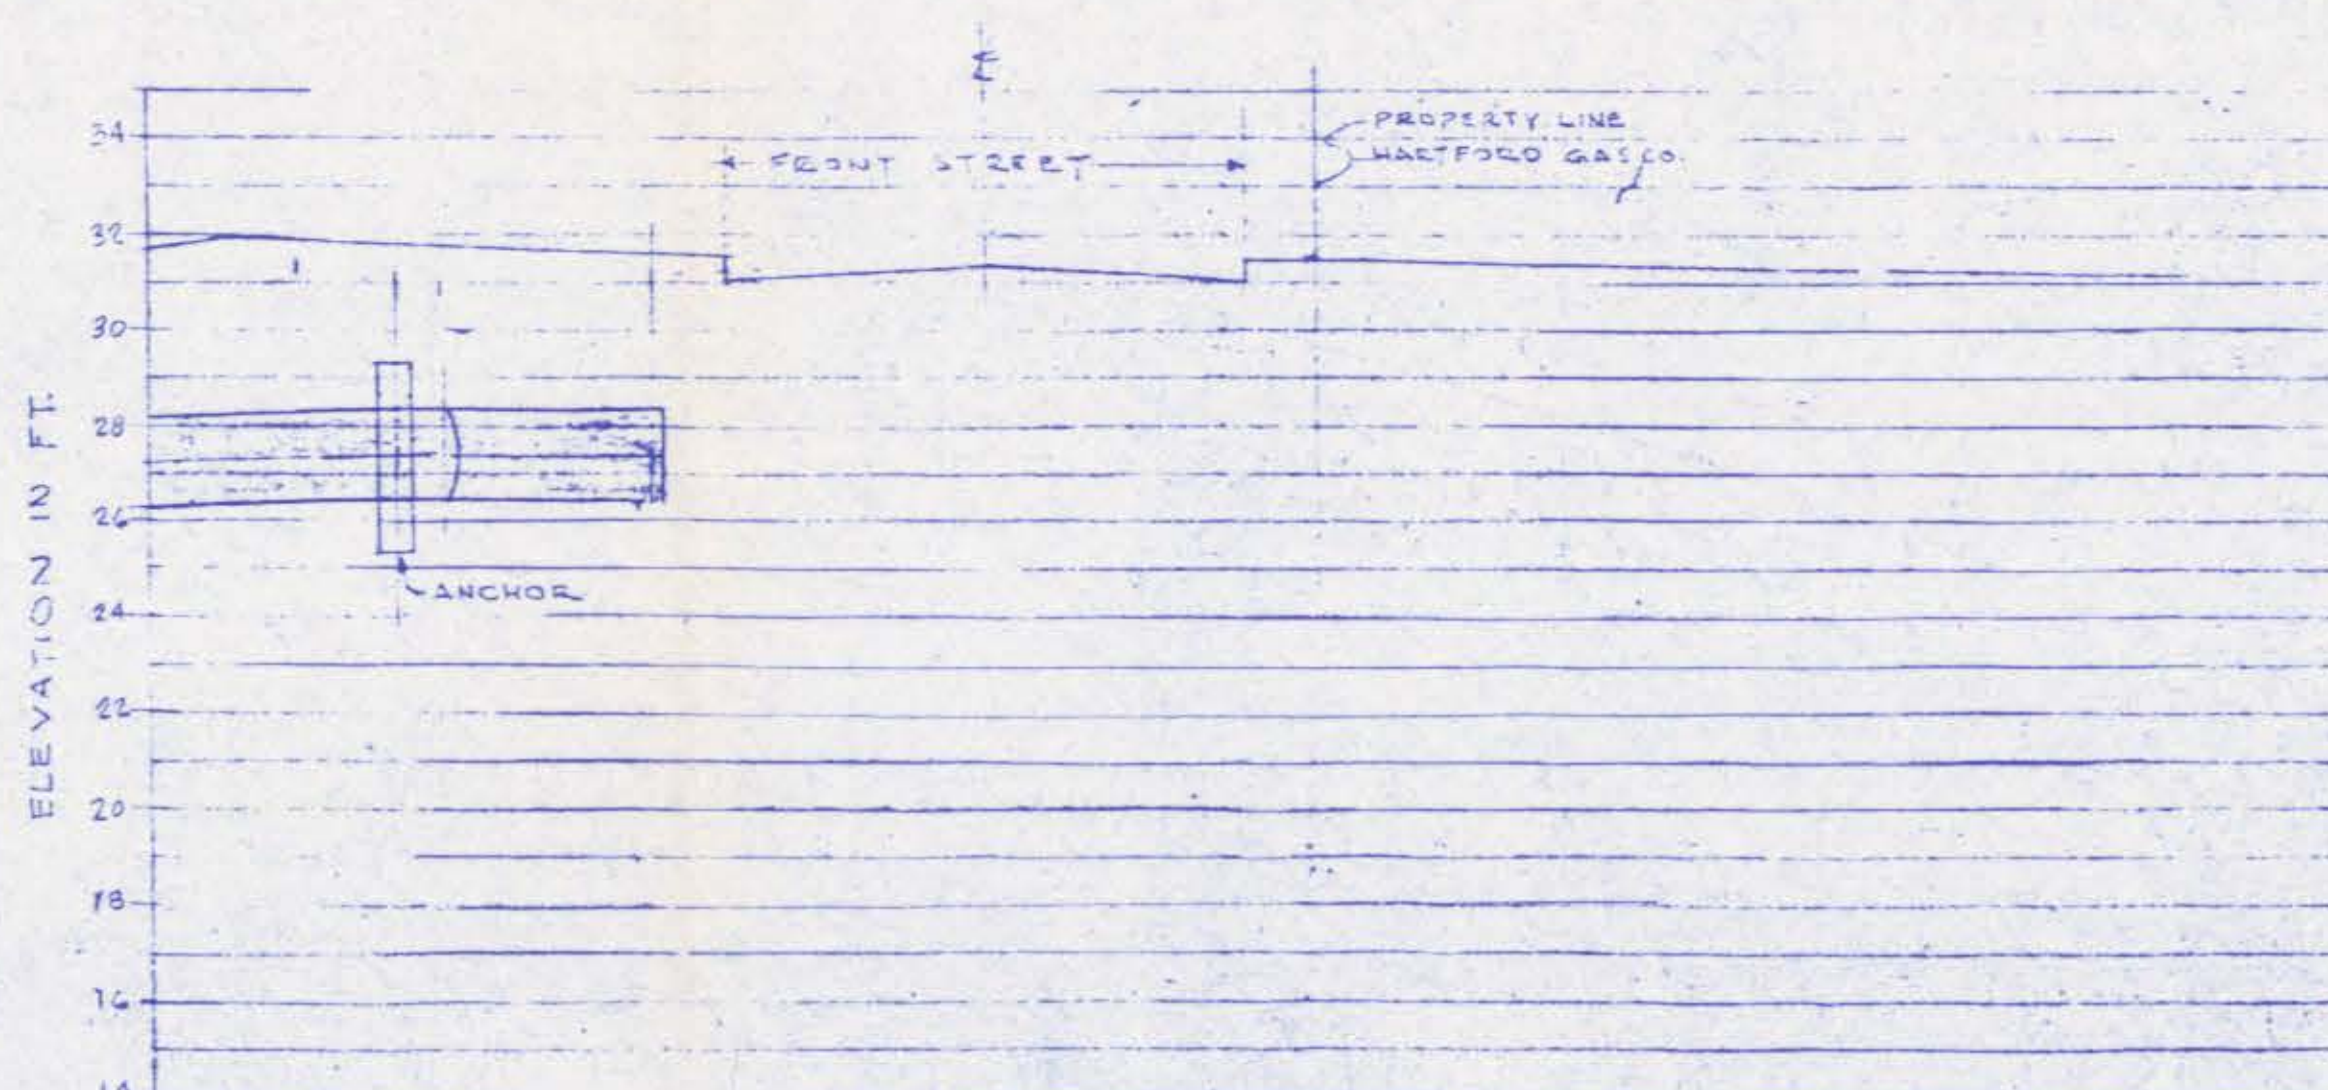


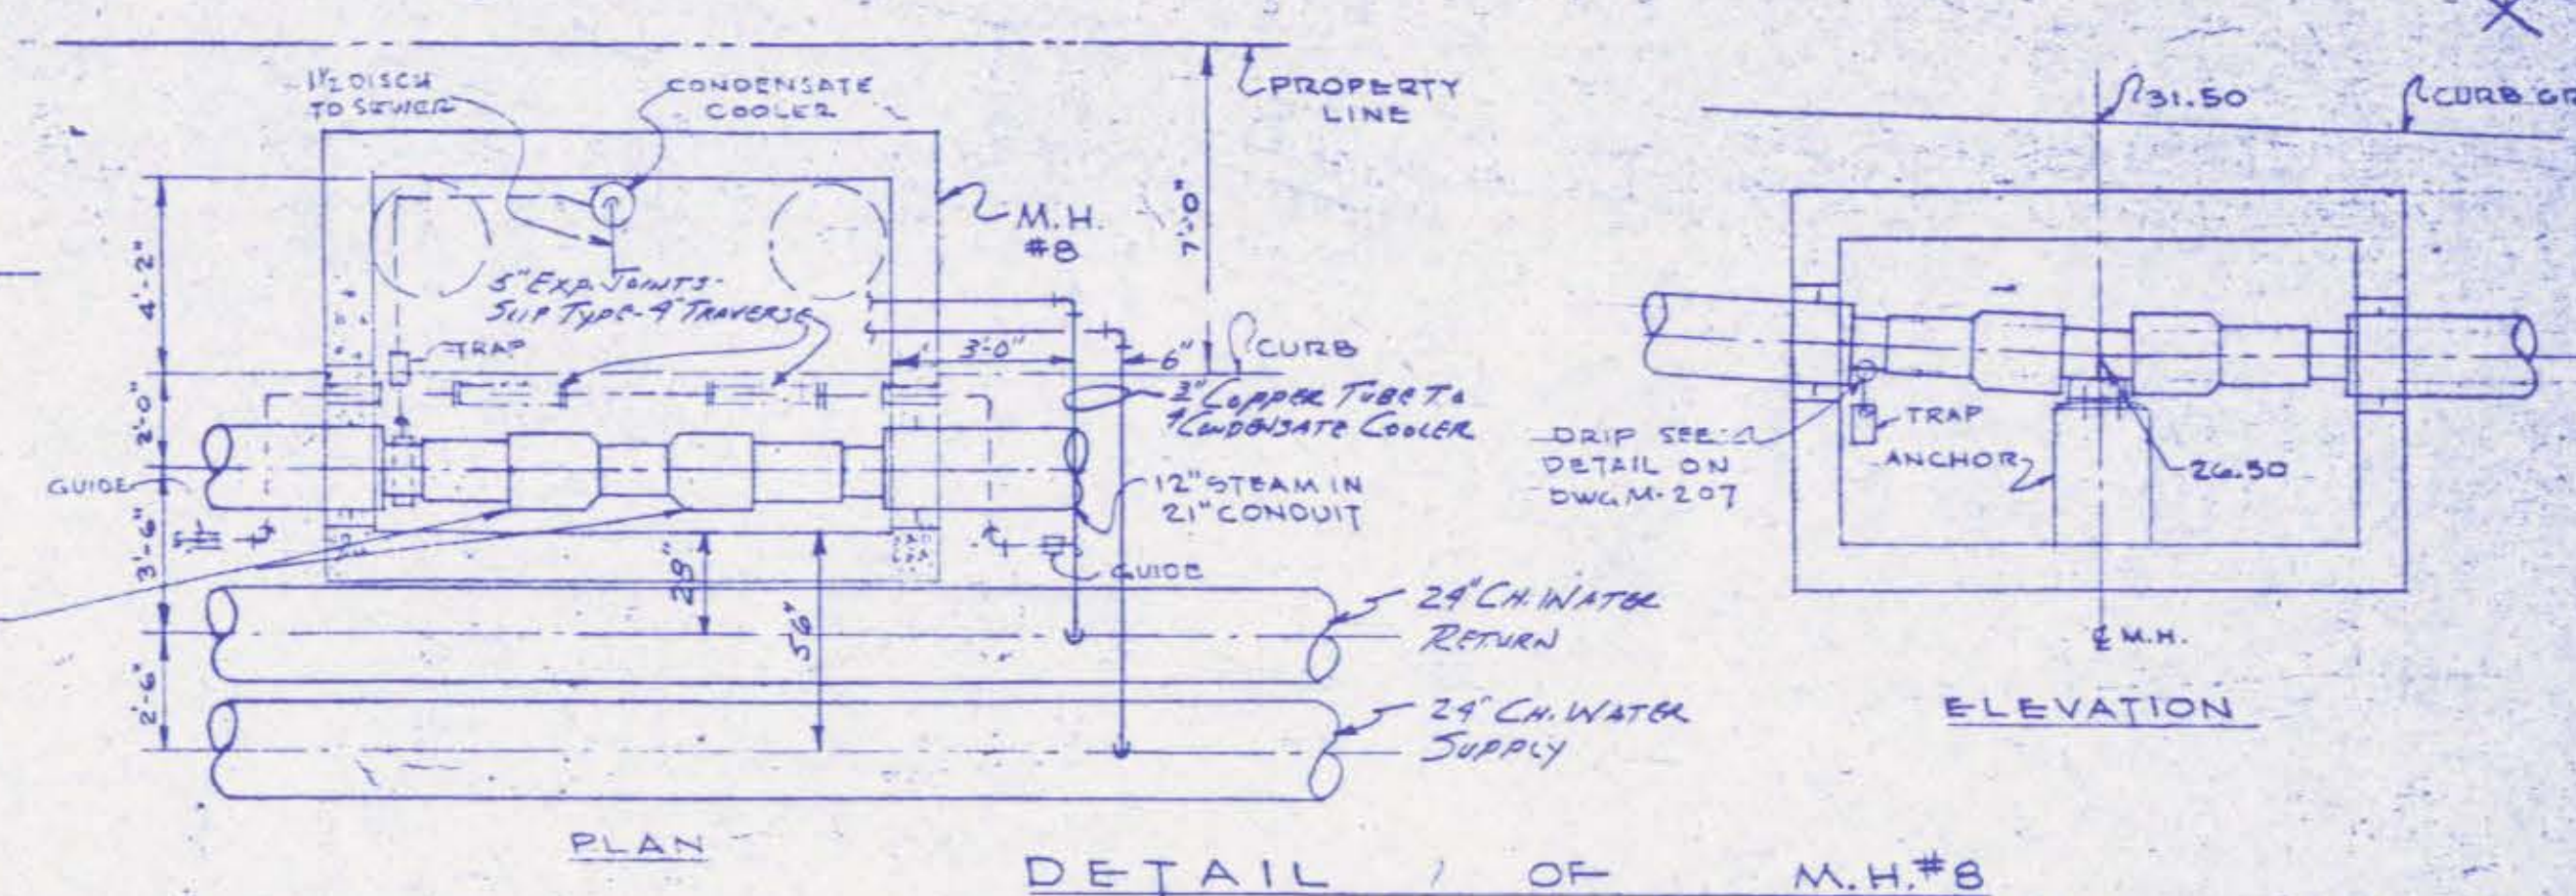

<u>MATERIAL</u>	<u>QUANTITY</u>
1) SCH 40 4" STEEL	<u>60'</u>
2) STEEL COUPLER	<u>2</u>
3) 4" to 5" TRANSITION	<u>2</u>

3-5-62		AS BUILT DIMS & DETAILS ADDED	
DATE	REVISIONS		APP'D
THE HARTFORD GAS COMPANY 233 PEARL STREET, HARTFORD 4, CONNECTICUT			
KELLY STEVENSON VALVE & KNECHT CONSULTING ENGINEERS 101 PARK AVENUE, NEW YORK 17, N.Y.		DRAWN BY TUL CHECKED BY APPROVED BY APPROVED BY	
CHARLES DUBOSE & I.A. ARCHITECTS 88 HARTFORD, CT		CENTRAL HEATING AND REFRIGERATION PLANT UNDERGROUND PIPING SHEET THREE SCALE NOTED DATE 1-24-61 DWG NO. M-503	