
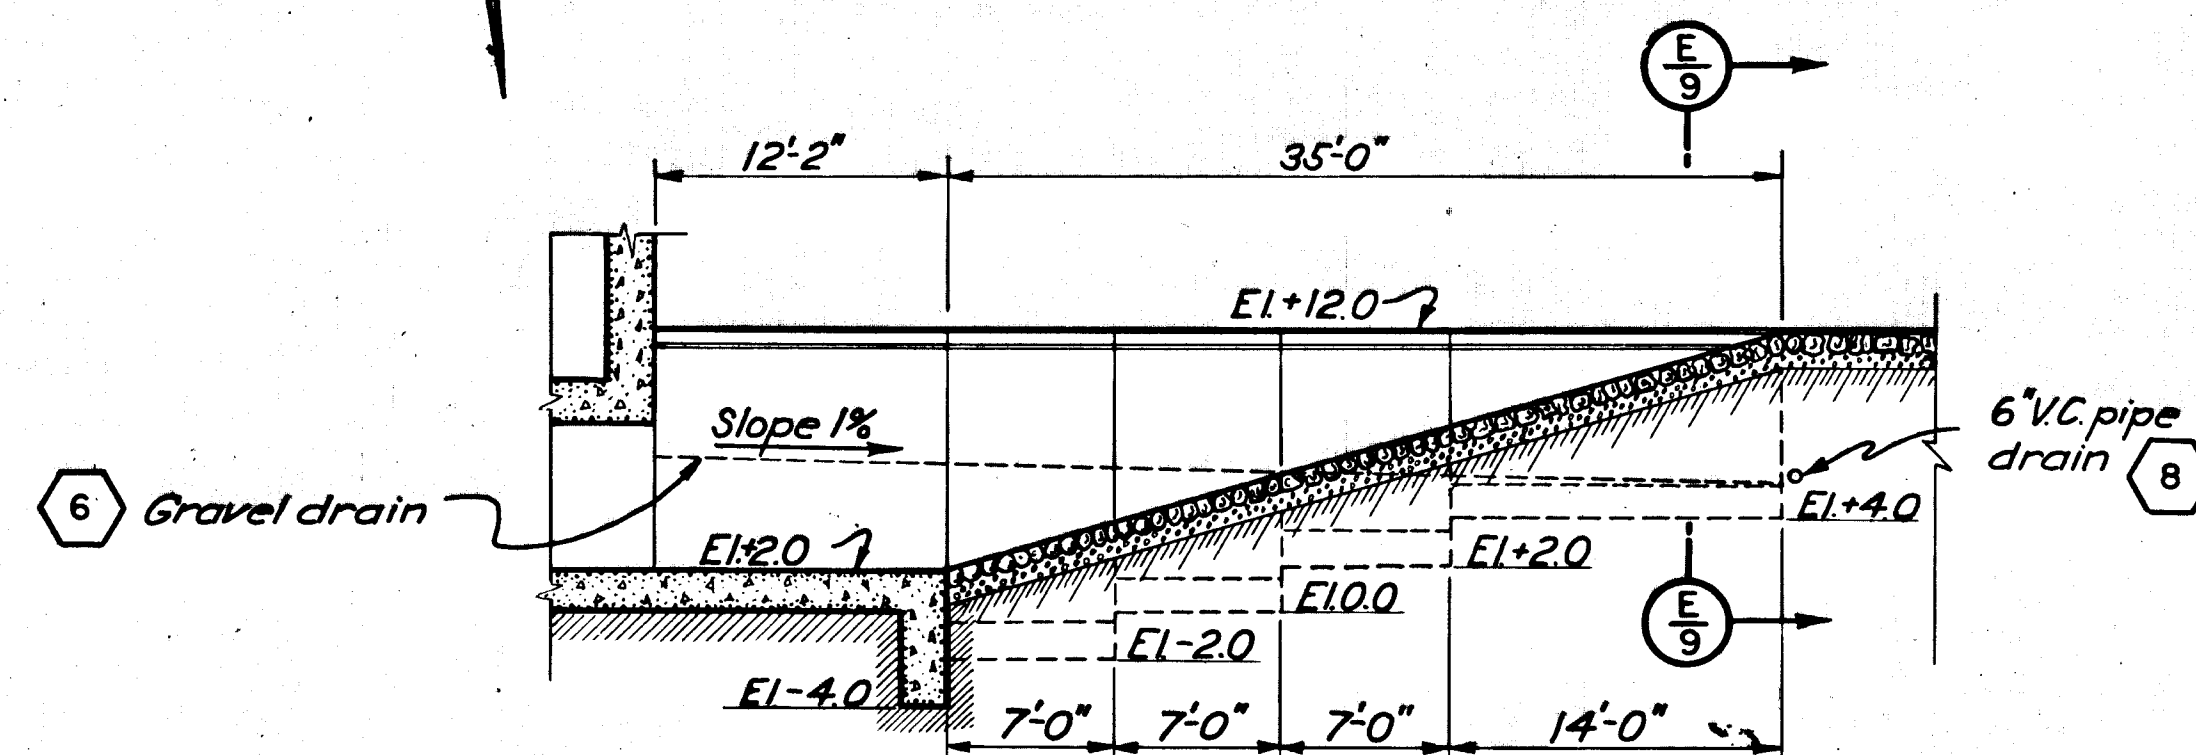



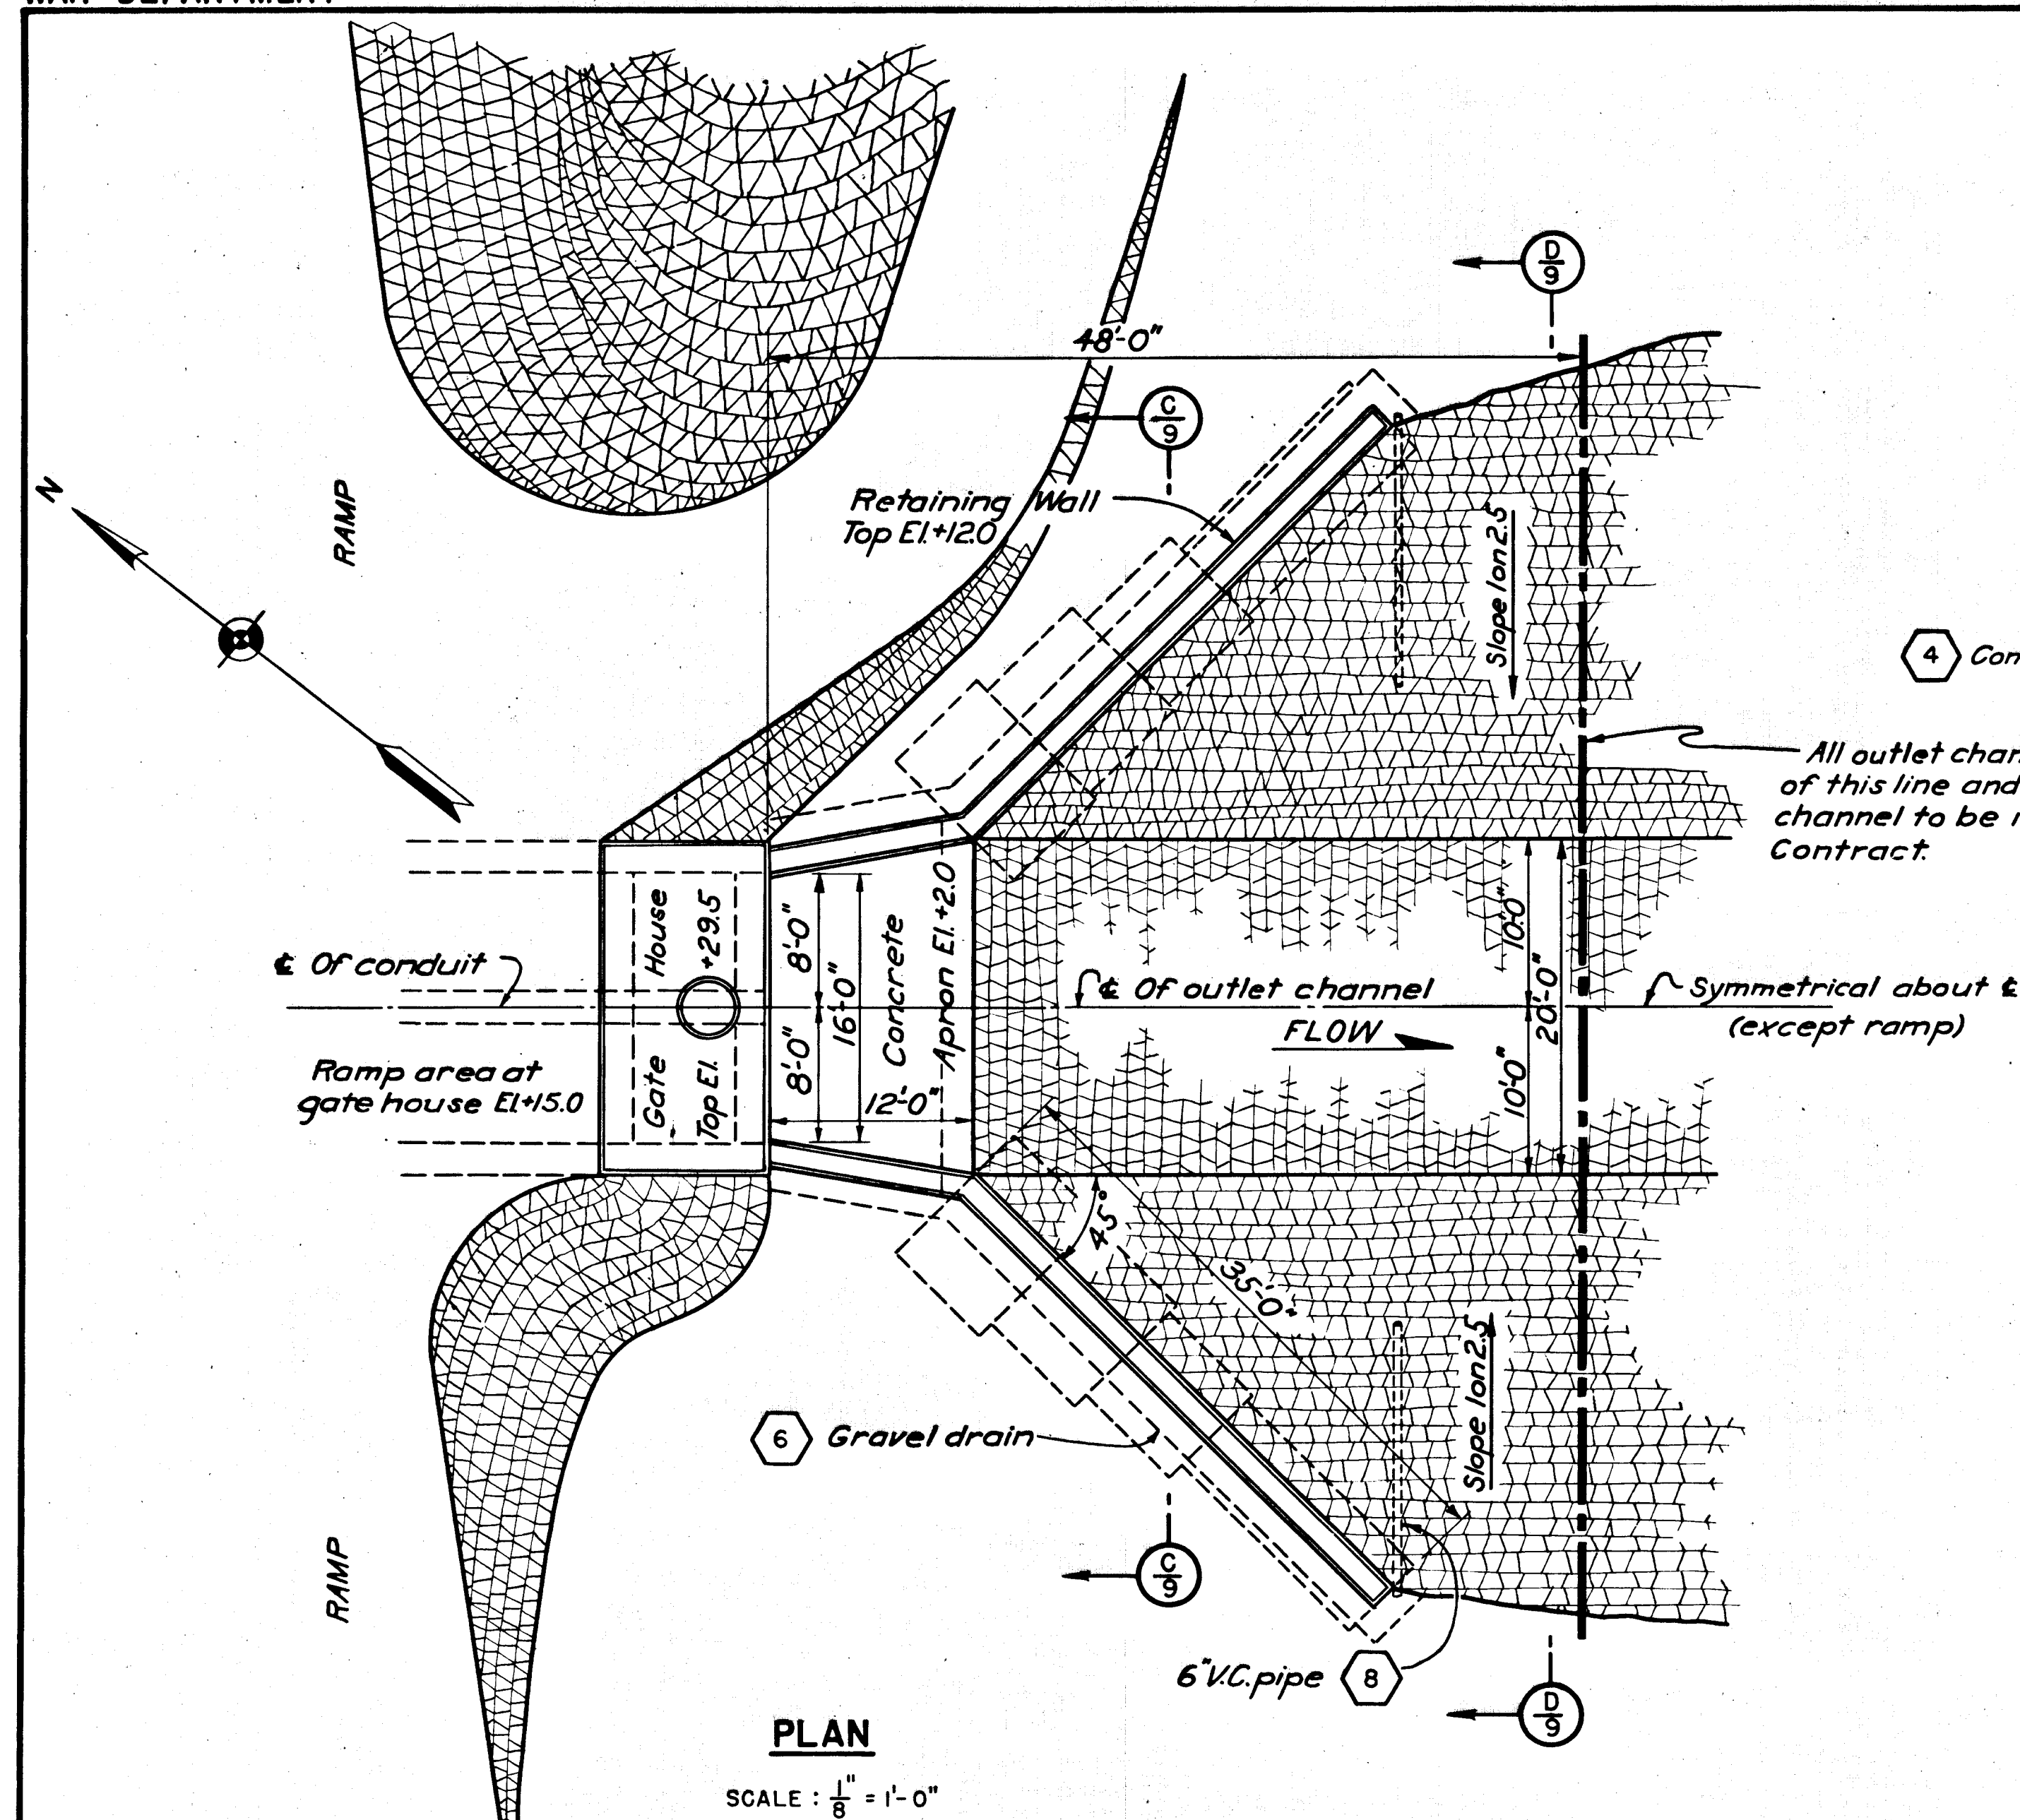


All outlet channel work south of this line and riprap for entire channel to be included in Dike Contract.

4 Compacted random backfill

1'-0" Hand placed riprap to be placed by Dike Contractor.

SECTION C
SCALE: $\frac{1}{8}'' = 1'-0''$

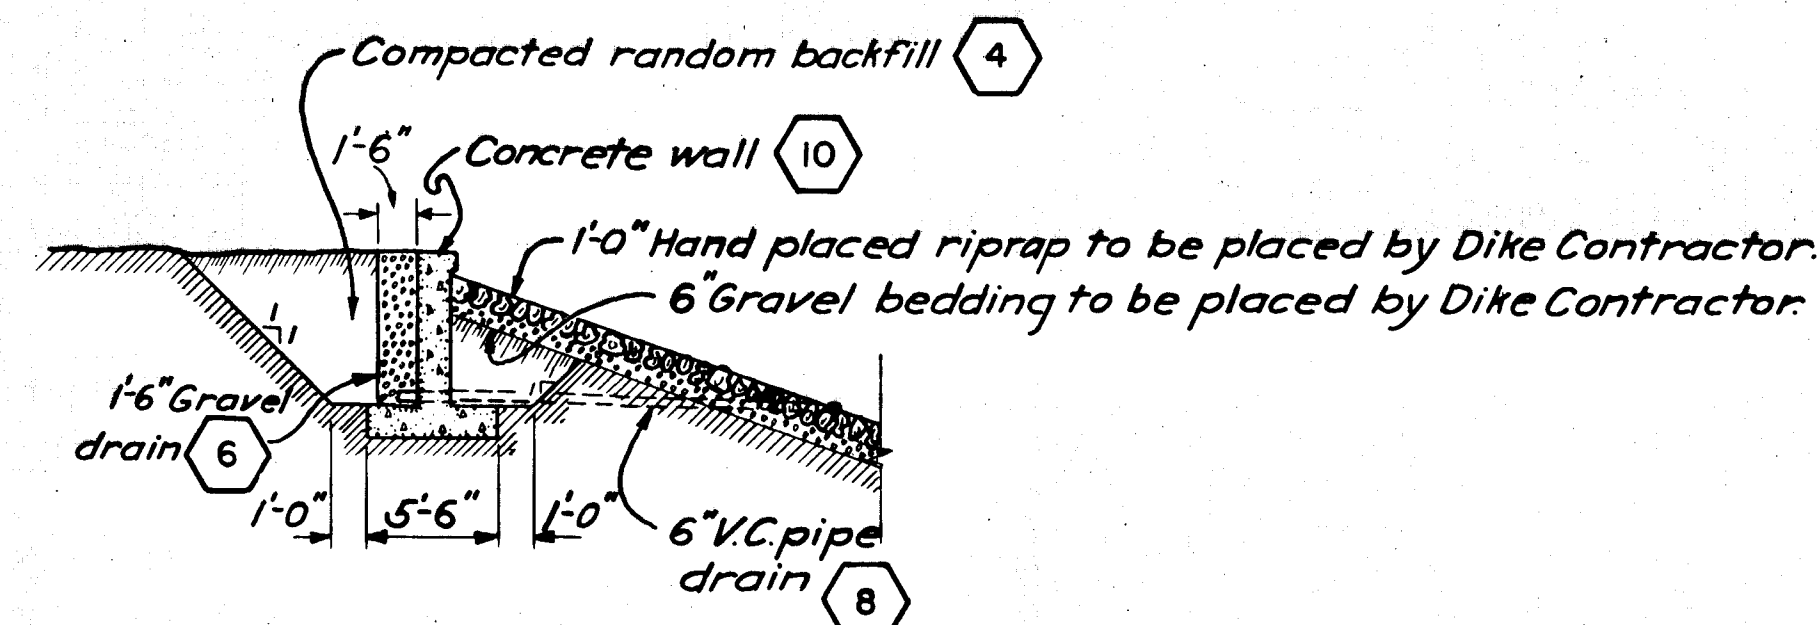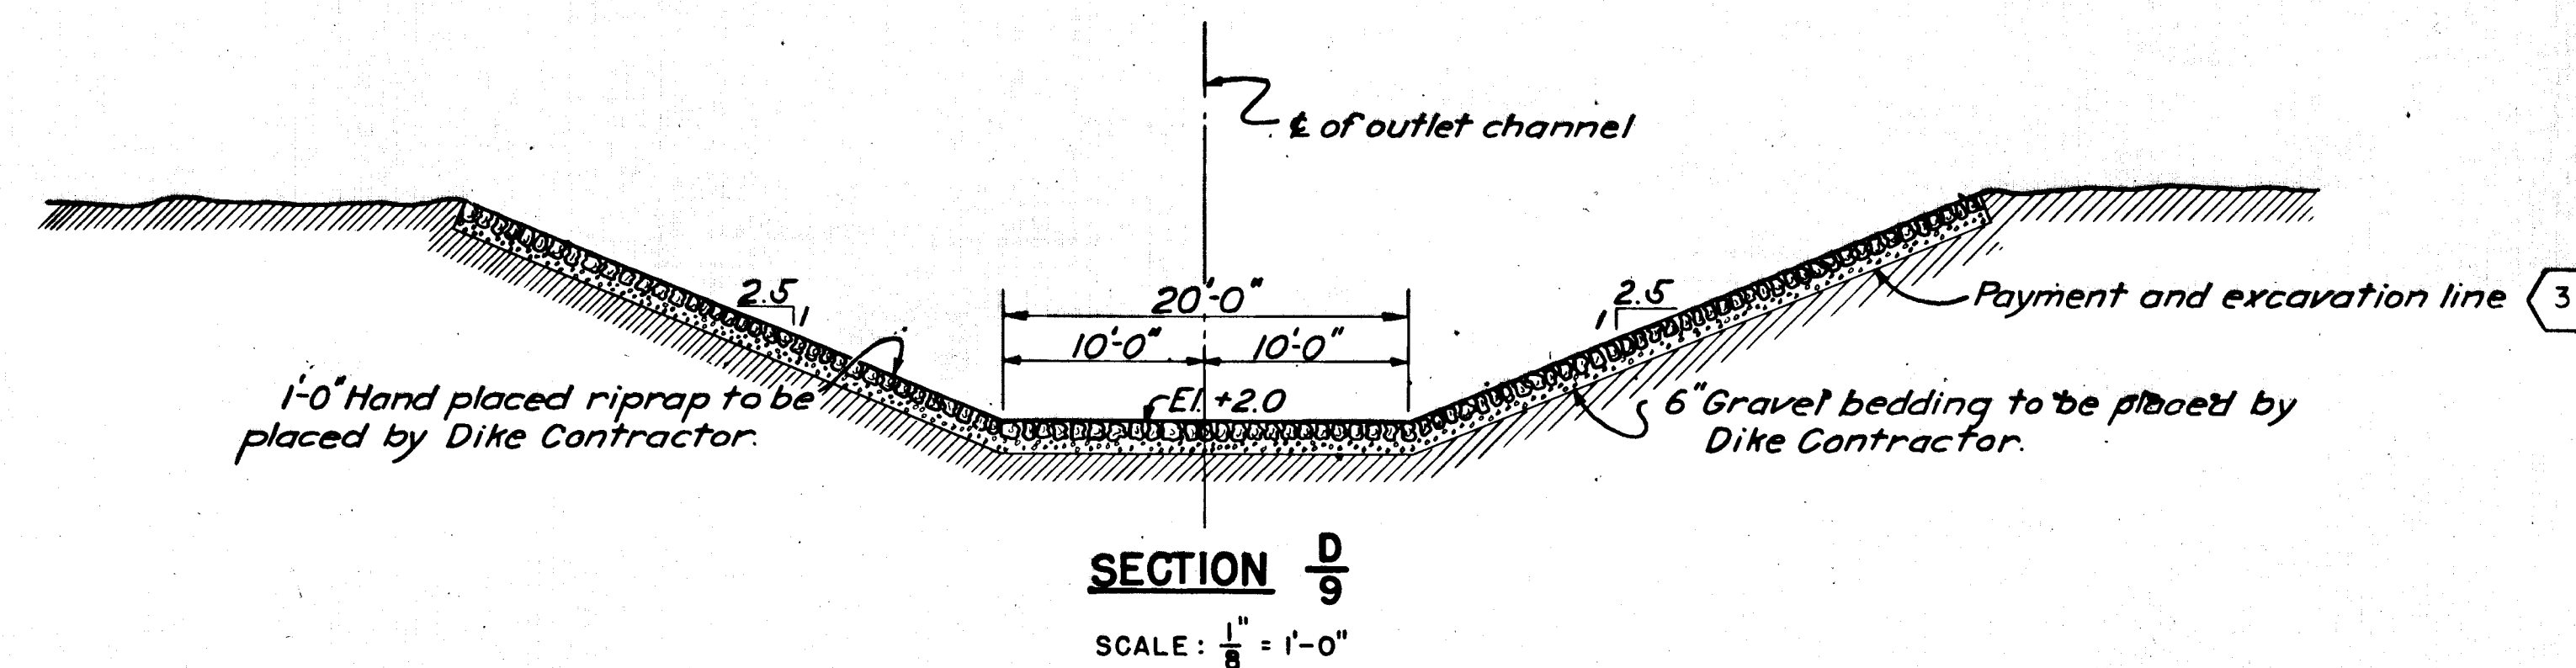

CONNECTICUT RIVER FLOOD CONTROL			
NORTH MEADOWS PUMPING STATION			
FISCAL YEAR 1939 SECTION			
OUTLET STRUCTURE EXCAVATION			
HARTFORD, CONN.			
CONNECTICUT RIVER		CONNECTICUT	
IN 62 SHEETS		SHEET NO. 9	
SCALE 1/8"=1'-0"		SCALE 1/8"=1'-0"	
U. S. ENGINEER OFFICE, PROVIDENCE, R.I., FEB. 1939			
DESIGNED BY: <i>W. A. H. H.</i>		APPROVED BY: <i>W. A. H. H.</i>	
HEAD, DESIGN SECTION		PRINCIPAL ENGINEER	
CHIEF, E.C. ENGINEERING DIV.		DISTRICT ENGINEER	
DRAWN BY: MB.M.C.		CHECKED BY: W.A.H.	
FILE NO. CT-4-1257			

12-31-45	As built				
DATE	REVISION	REV	BY	CK	AP BY