


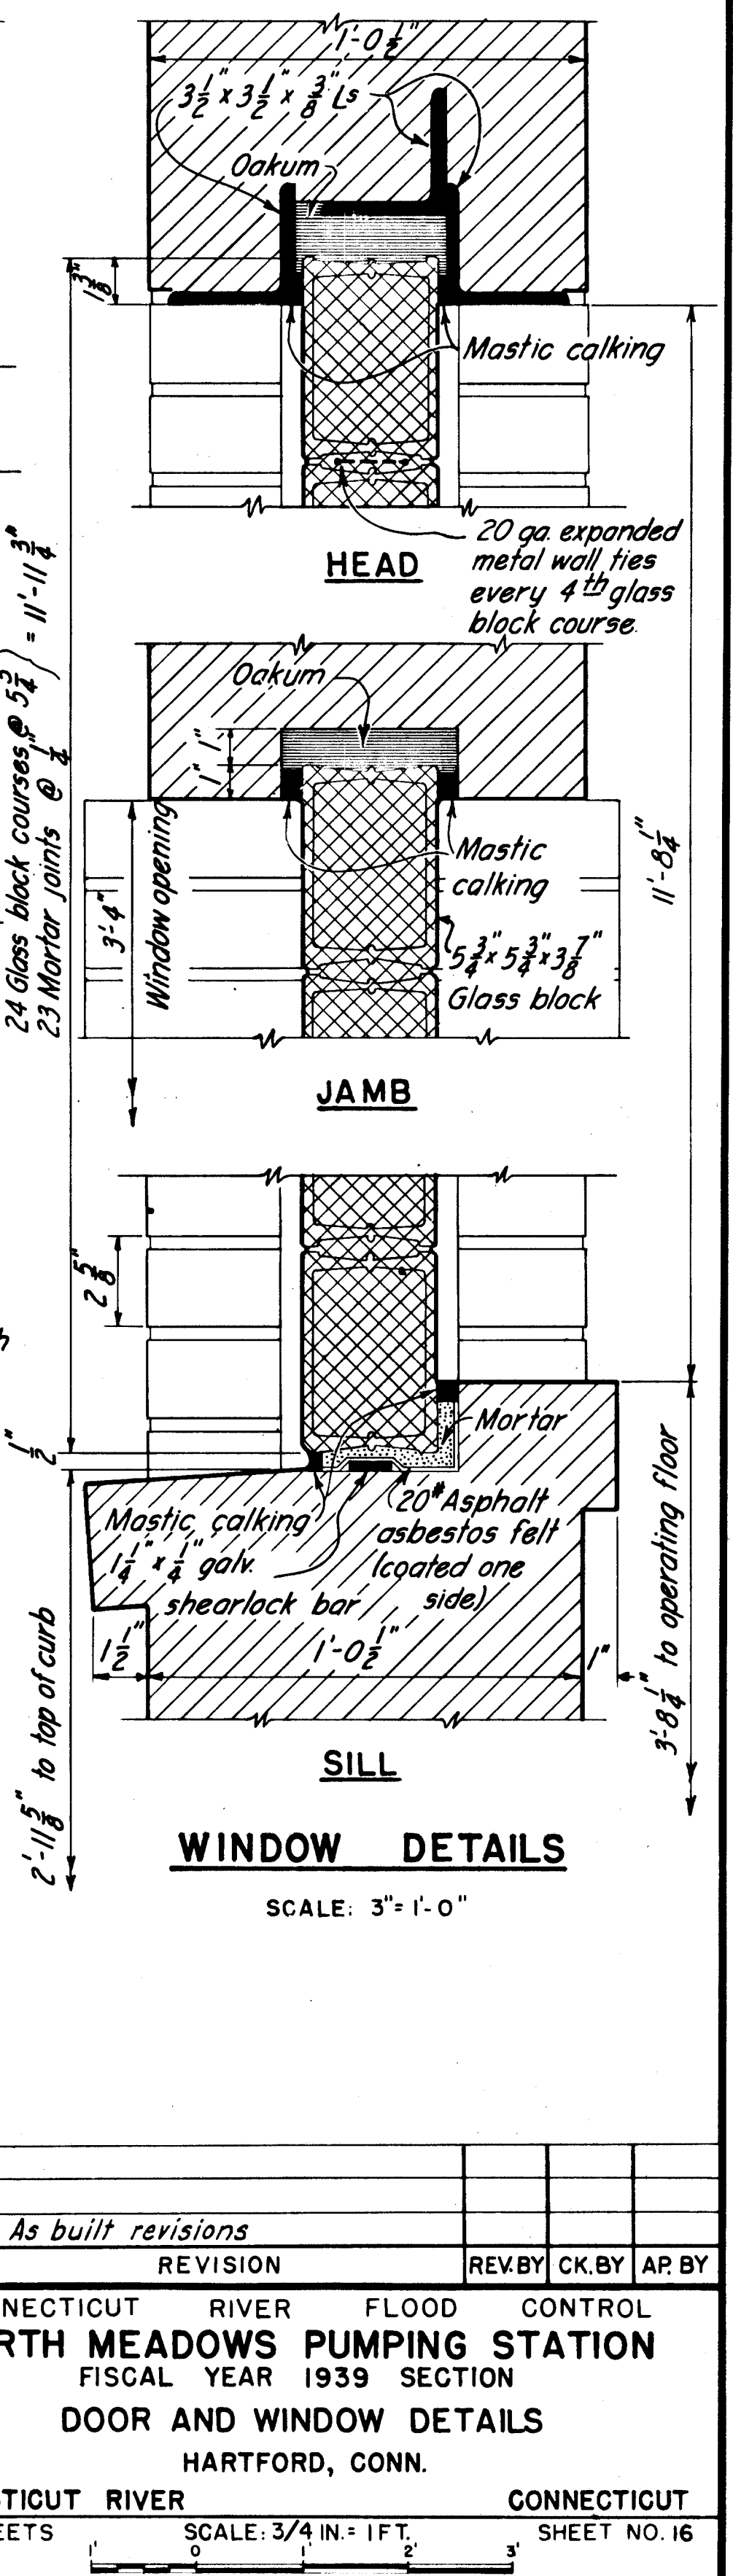

SCALE: 3" = 1'-0"

12/31/45	As built revisions				
DATE	REVISION			REV BY	CK BY
CONNECTICUT RIVER FLOOD CONTROL NORTH MEADOWS PUMPING STATION FISCAL YEAR 1939 SECTION DOOR AND WINDOW DETAILS HARTFORD, CONN.					
CONNECTICUT RIVER			CONNECTICUT		
IN 62 SHEETS		SCALE: 3/4 IN. = 1 FT.		SHEET NO. 16	
U. S. ENGINEER OFFICE, PROVIDENCE R.I., JAN 1939					
SUBMITTED:		APPROVAL RECOMMENDED:		APPROVED:	
<i>David C. Nelson</i>		<i>J. S. Burns</i>		<i>E. B. May Jr</i>	
SENIOR ENGINEER		PRINCIPAL ENGINEER		LT COL., CORPS OF ENGINEERS	
HEAD, DESIGN SECTION		CHIEF, F. C. ENGINEERING DIV.		DISTRICT ENGINEER	
DESIGNED:		DRAWN BY:		FILE NO. CT-4-1264	
<i>E. M. Vanier</i>		M. B. Mc			
ASSO. ENGINEER		CHECKED BY: <i>M. B. Mc.</i>			