


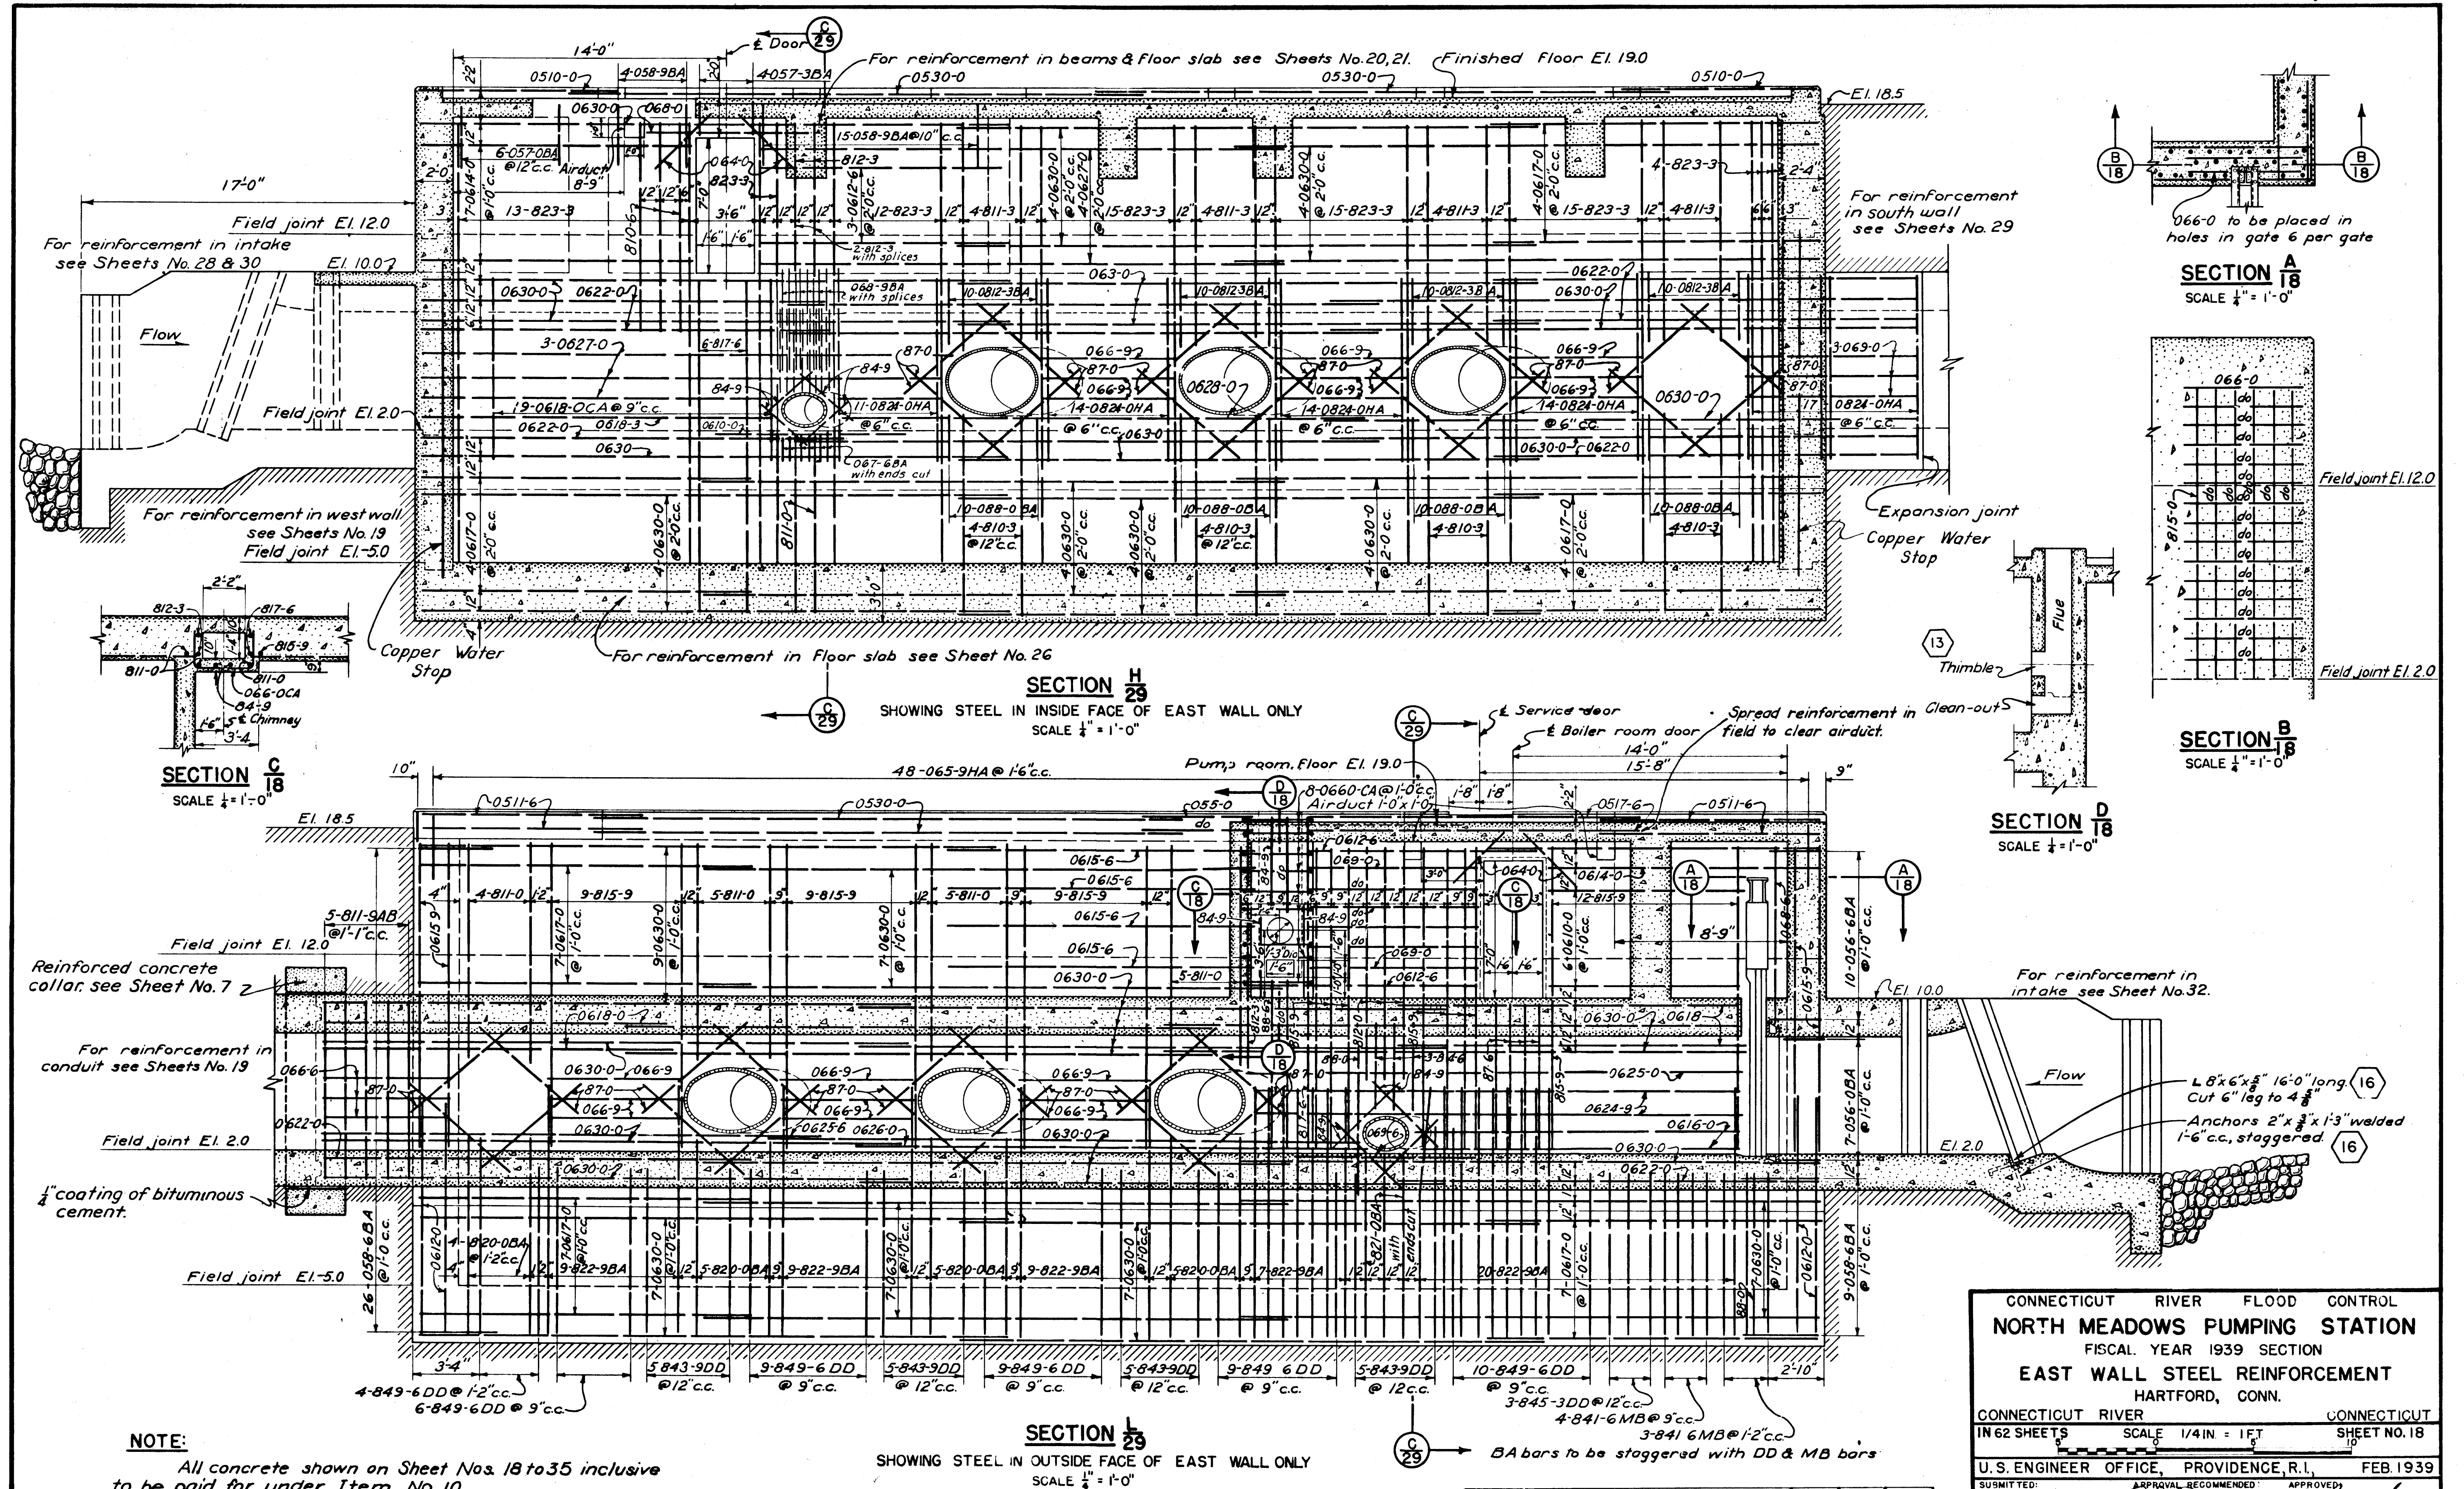

12/31/45	As built Revision			
6/28/39	Payment item for thimble added	LCB	1942	288
DATE	REVISION	REVBY	CK BY	AE BY

CONNECTICUT RIVER	FLOOD CONTROL	
NORTH MEADOWS PUMPING STATION		
FISCAL YEAR 1939 SECTION		
EAST WALL STEEL REINFORCEMENT		
HARTFORD, CONN.		
CONNECTICUT RIVER		CONNECTICUT
IN 62 SHEETS	SCALE 1/4 IN = 1 FT	SHEET NO. 18