


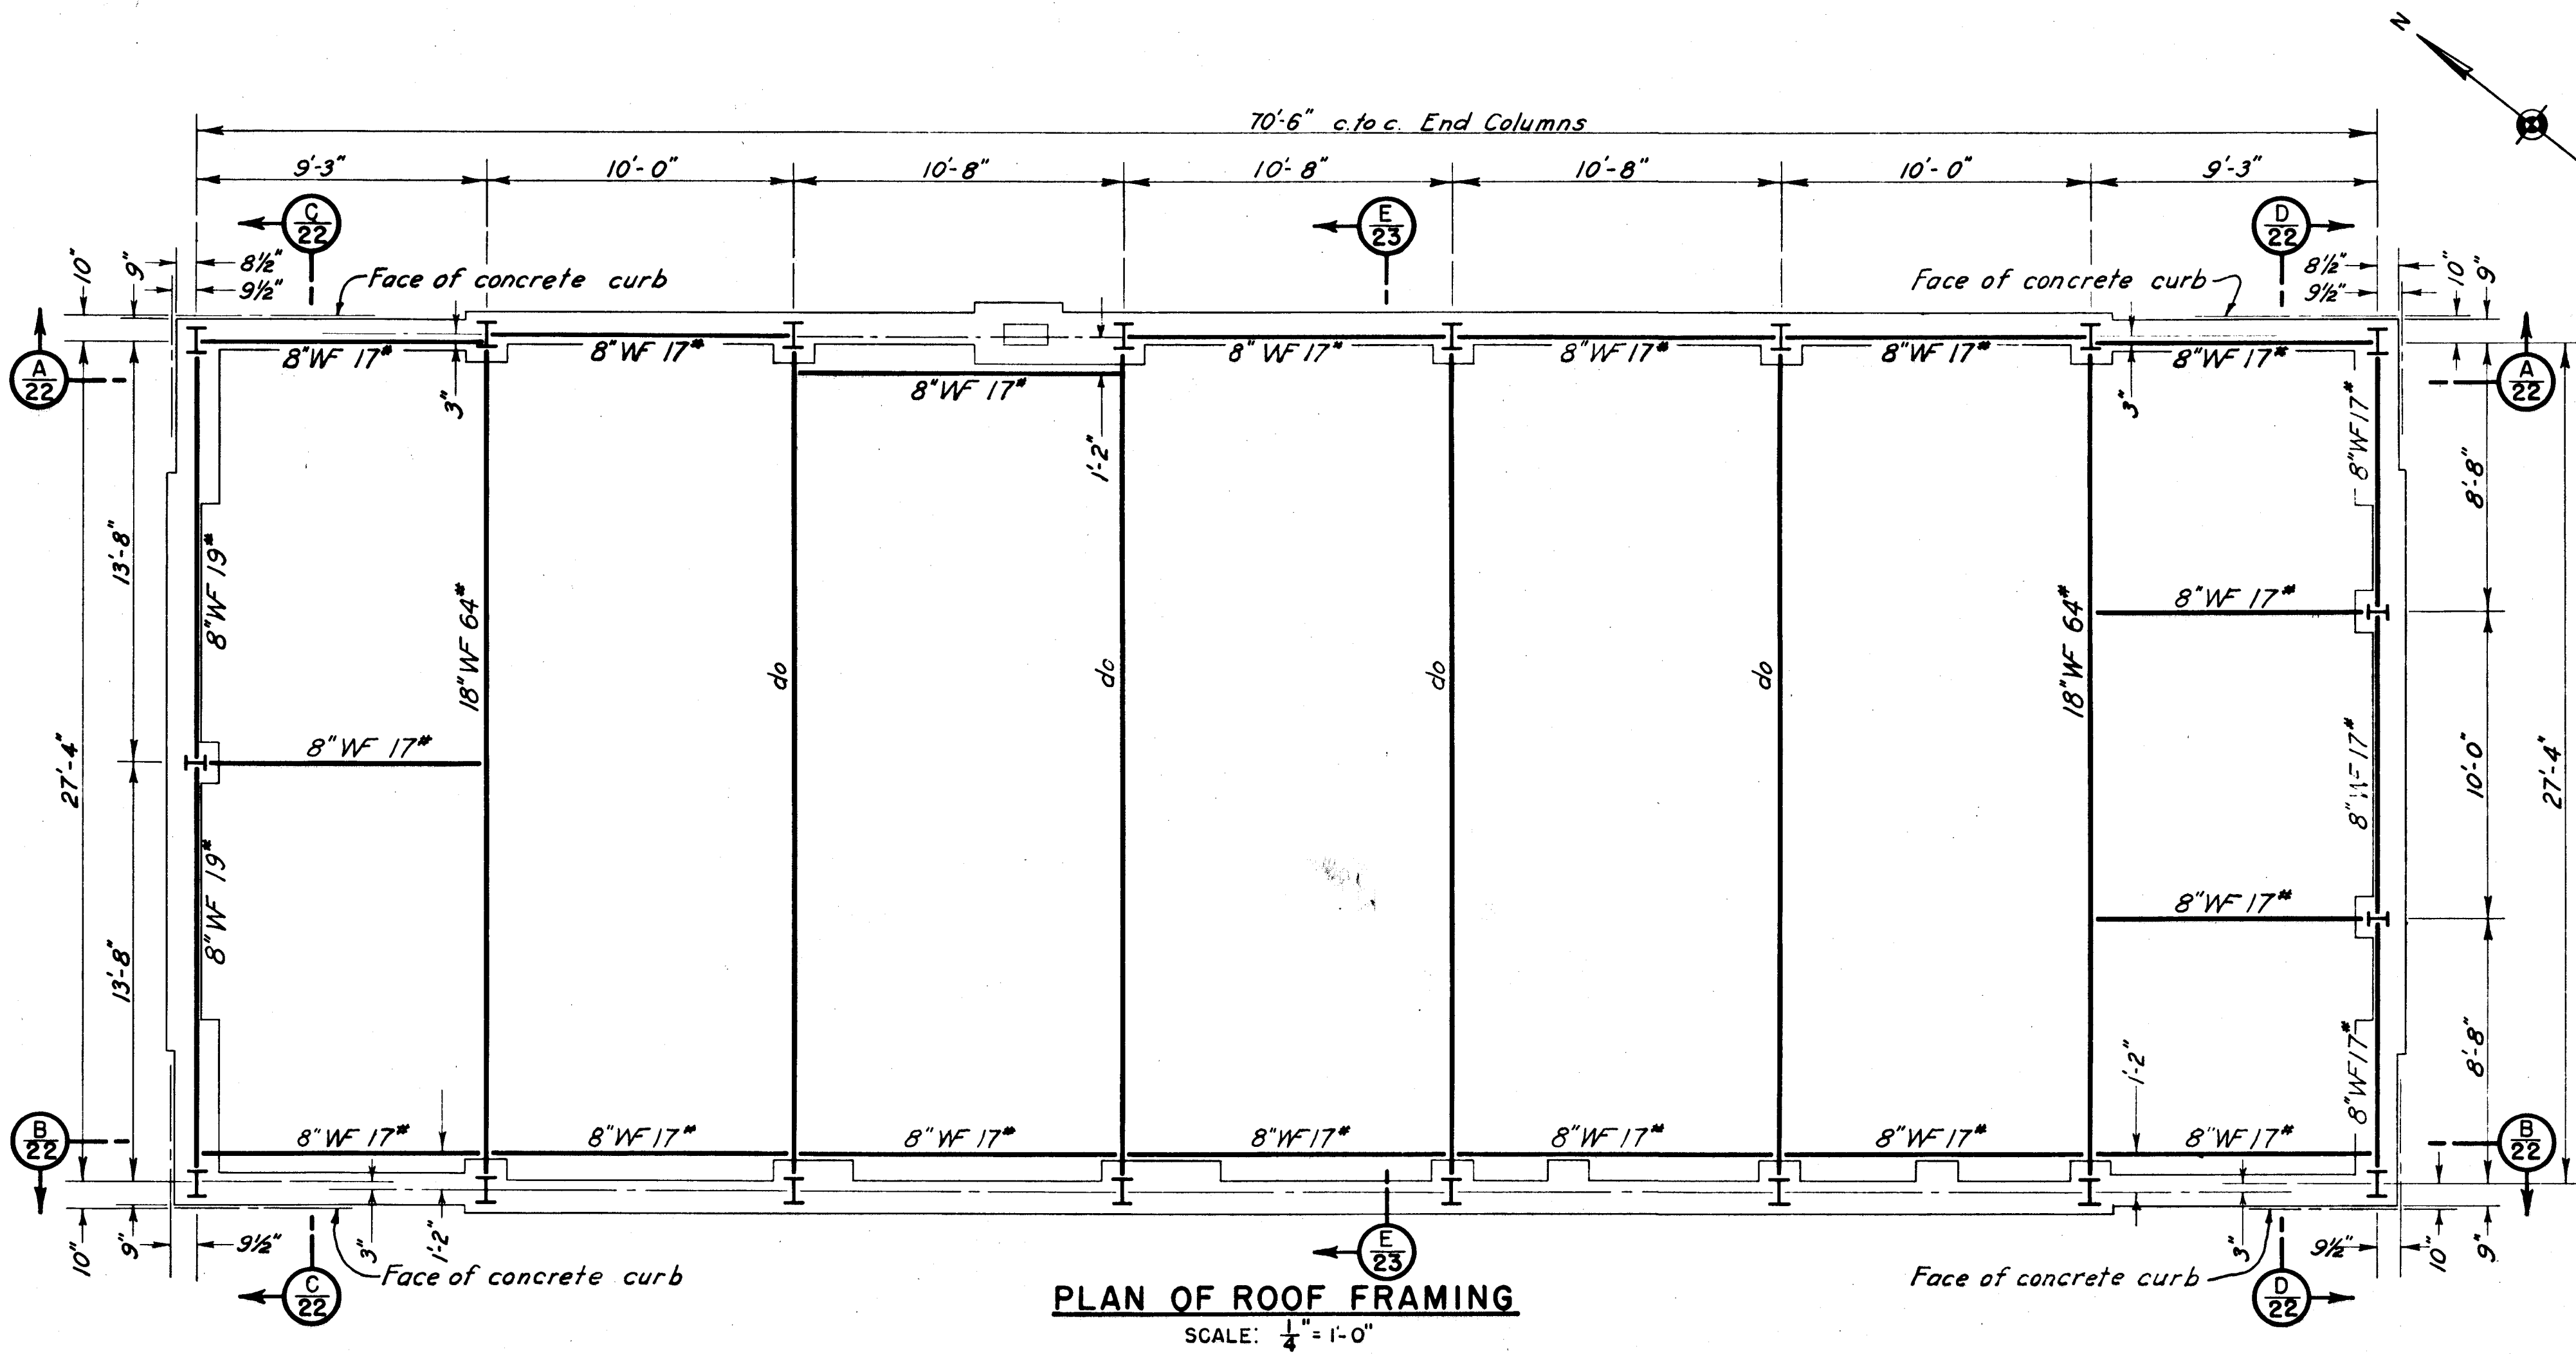


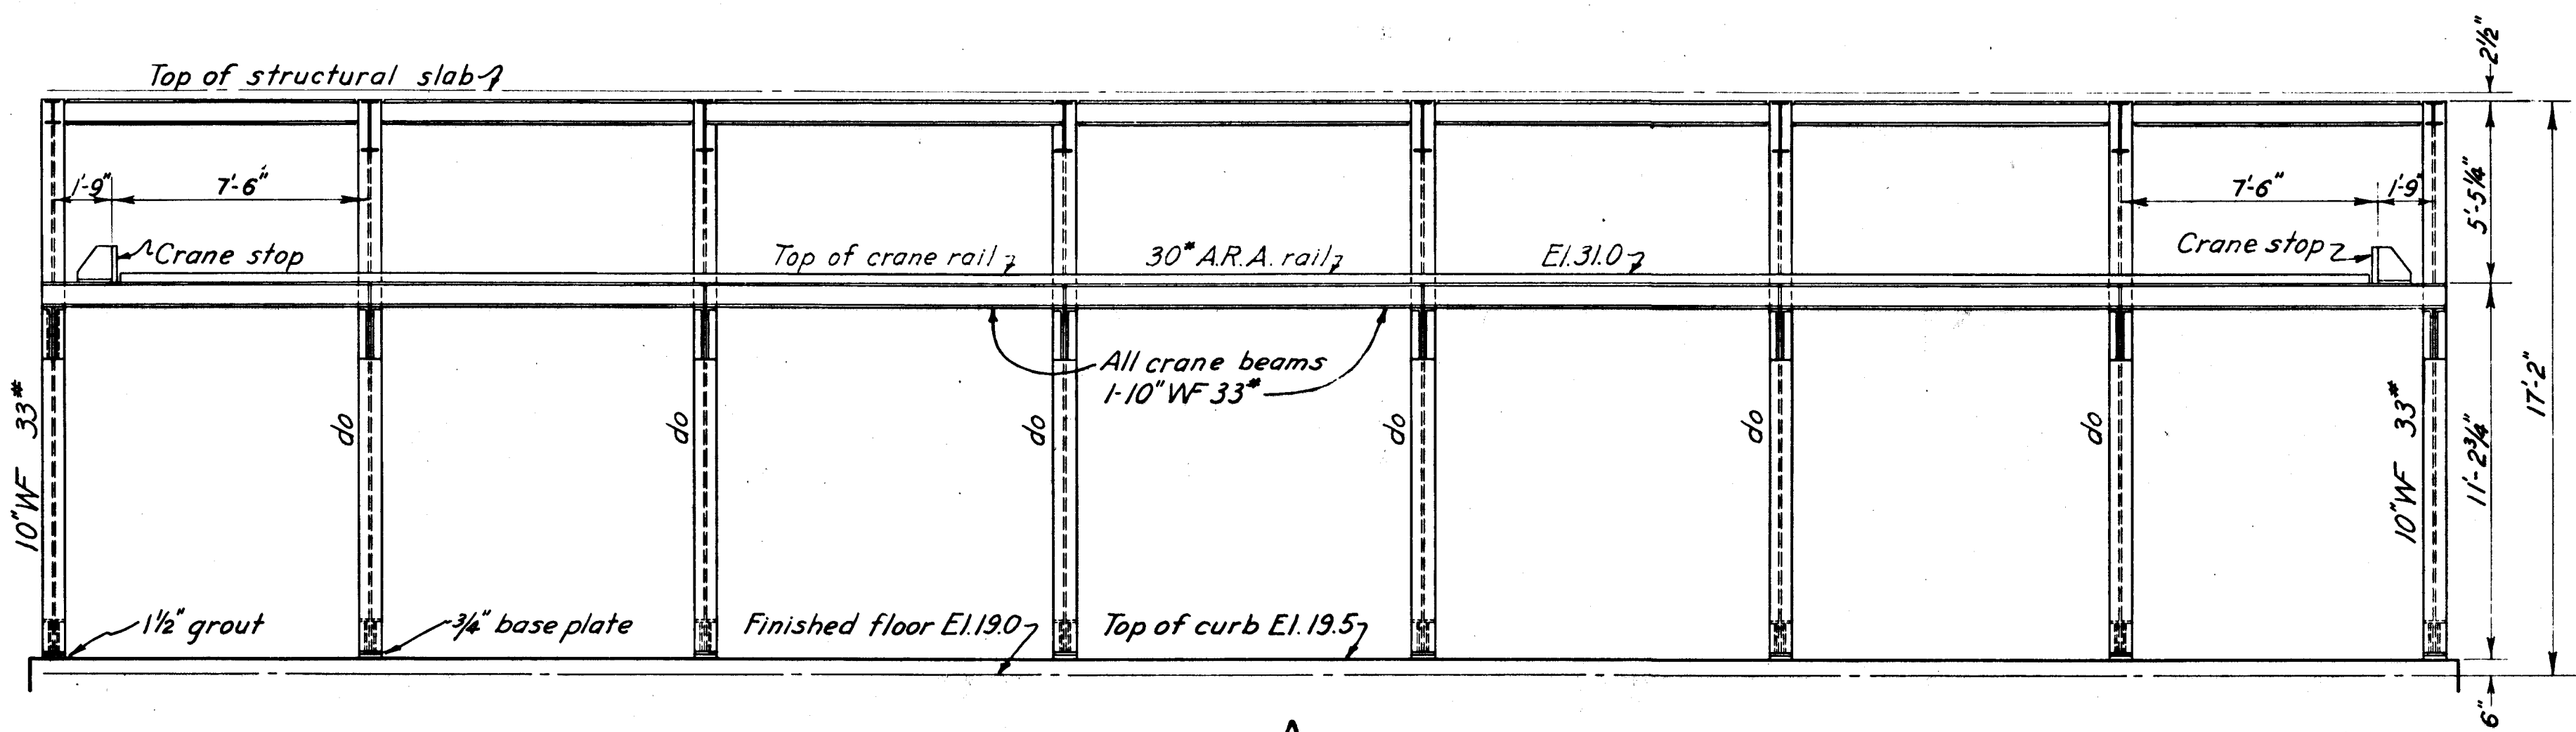

PLAN OF ROOF FRAMING
SCALE: $\frac{1}{4}'' = 1'-0''$

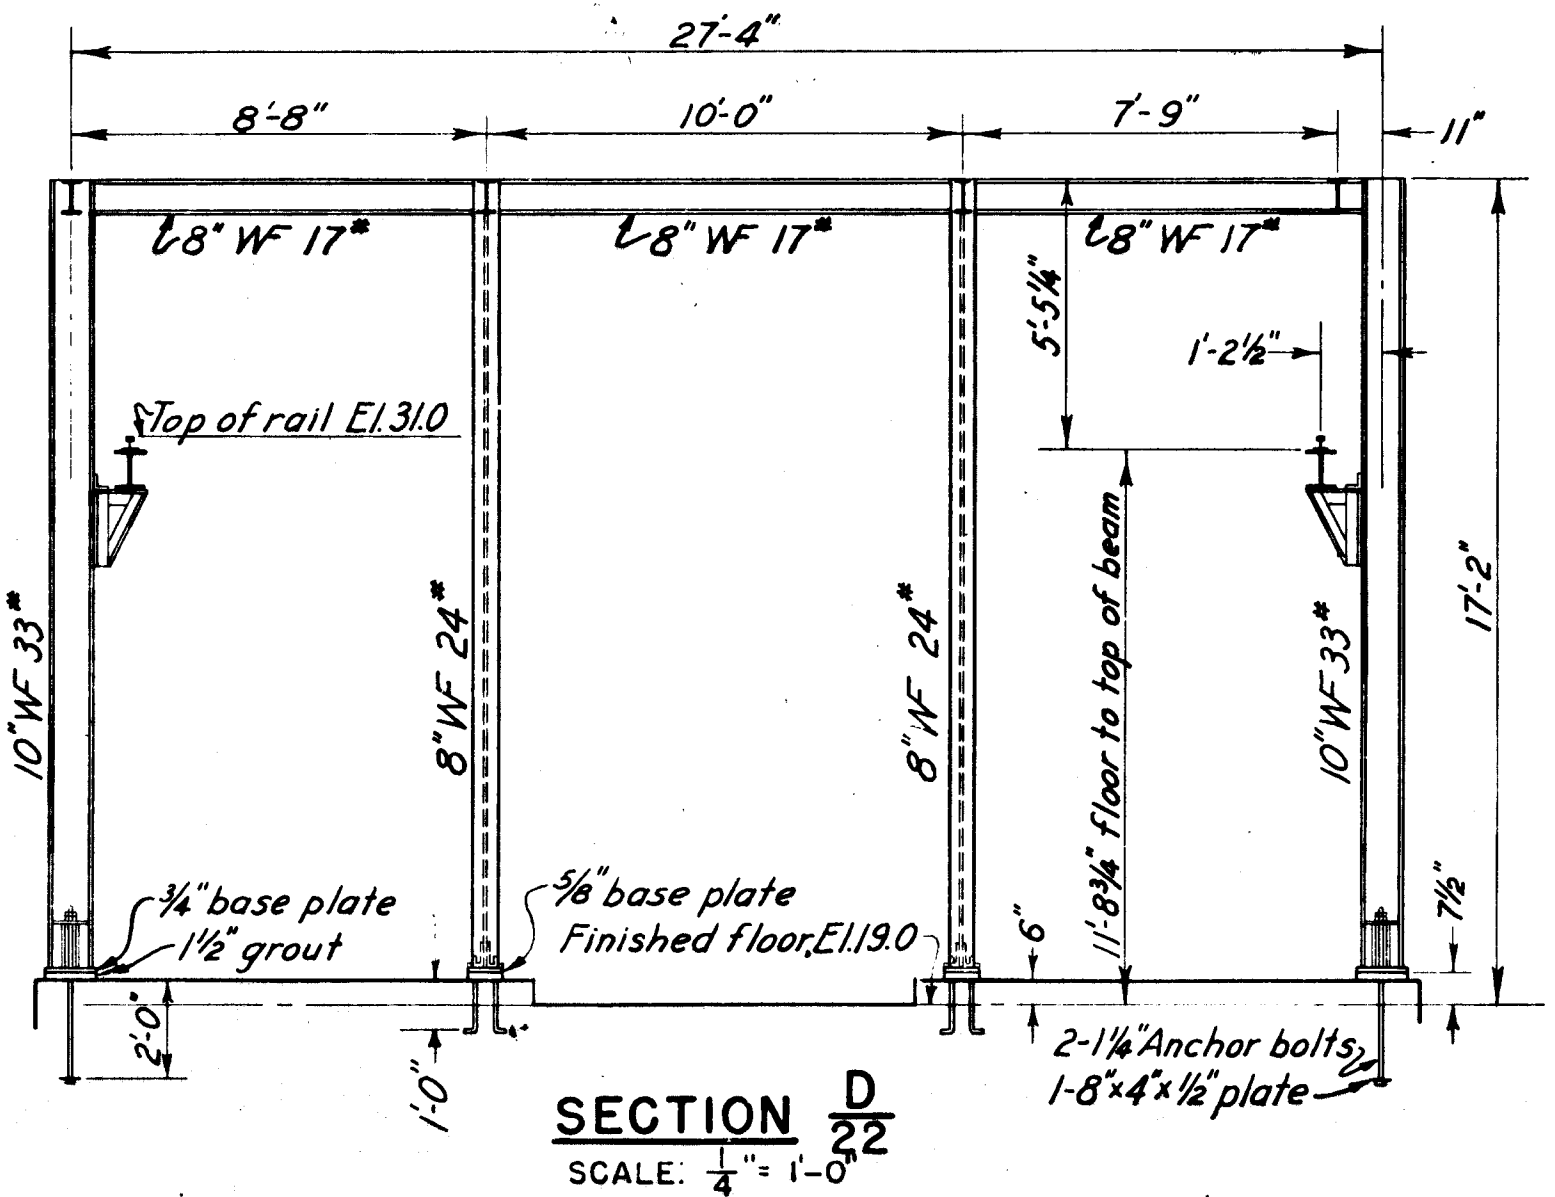

SECTION A-A
SCALE: $\frac{1}{4}'' = 1'-0''$
Section B-B opposite hand

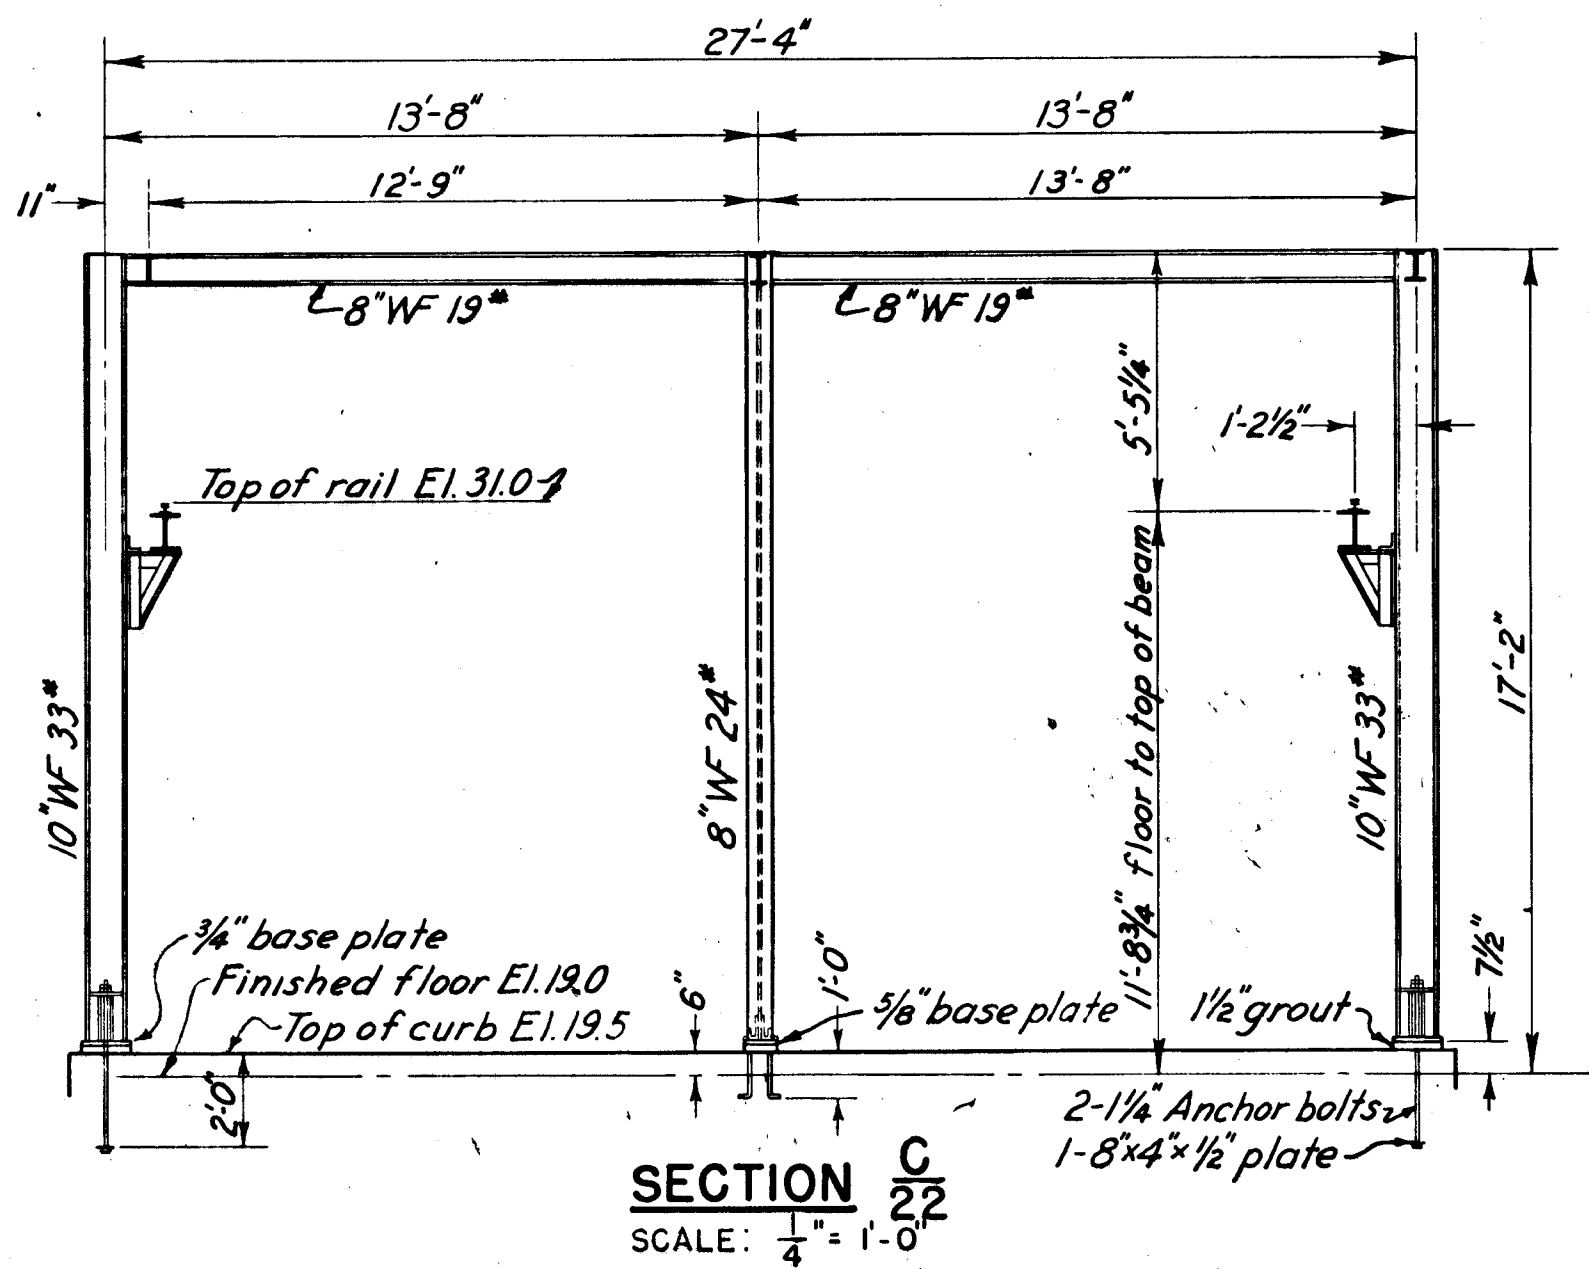

NOTE:
Rivets $\frac{3}{4}''$; open holes $\frac{3}{16}''$ unless otherwise noted.
Tops of all roof beams at El. 36.17
All material on this sheet except anchor bolts to be paid for under Item No. 12. Anchor bolts under Item No. 10.

CONNECTICUT RIVER FLOOD CONTROL			
NORTH MEADOWS PUMPING STATION			
FISCAL YEAR 1939 SECTION			
ROOF FRAMING PLAN			
HARTFORD, CONN.			
CONNECTICUT RIVER		CONNECTICUT	
IN 62 SHEETS		SHEET NO. 22	
SCALE: $\frac{1}{4}'' = 1'$			
U.S. ENGINEER OFFICE, PROVIDENCE, R.I., FEB. 1939			
SUBMITTED: <i>Wm. B. Wilson</i>		APPROVED: <i>J. D. Burns</i>	
SENIOR ENGINEER		PRINCIPAL ENGINEER	
HEAD, DESIGN SECTION		CHIEF, F.C. ENGINEERING DIV.	
DESIGNED: <i>E. M. V.</i>		DRAWN BY: <i>J. H. B.</i>	
ASSOC. ENGINEER		CHECKED BY: <i>E. M. V.</i>	
FILE NO. CT-4-1270			

12-31-45	As built				
DATE	REVISION	REV. BY	CK. BY	AP. BY	