


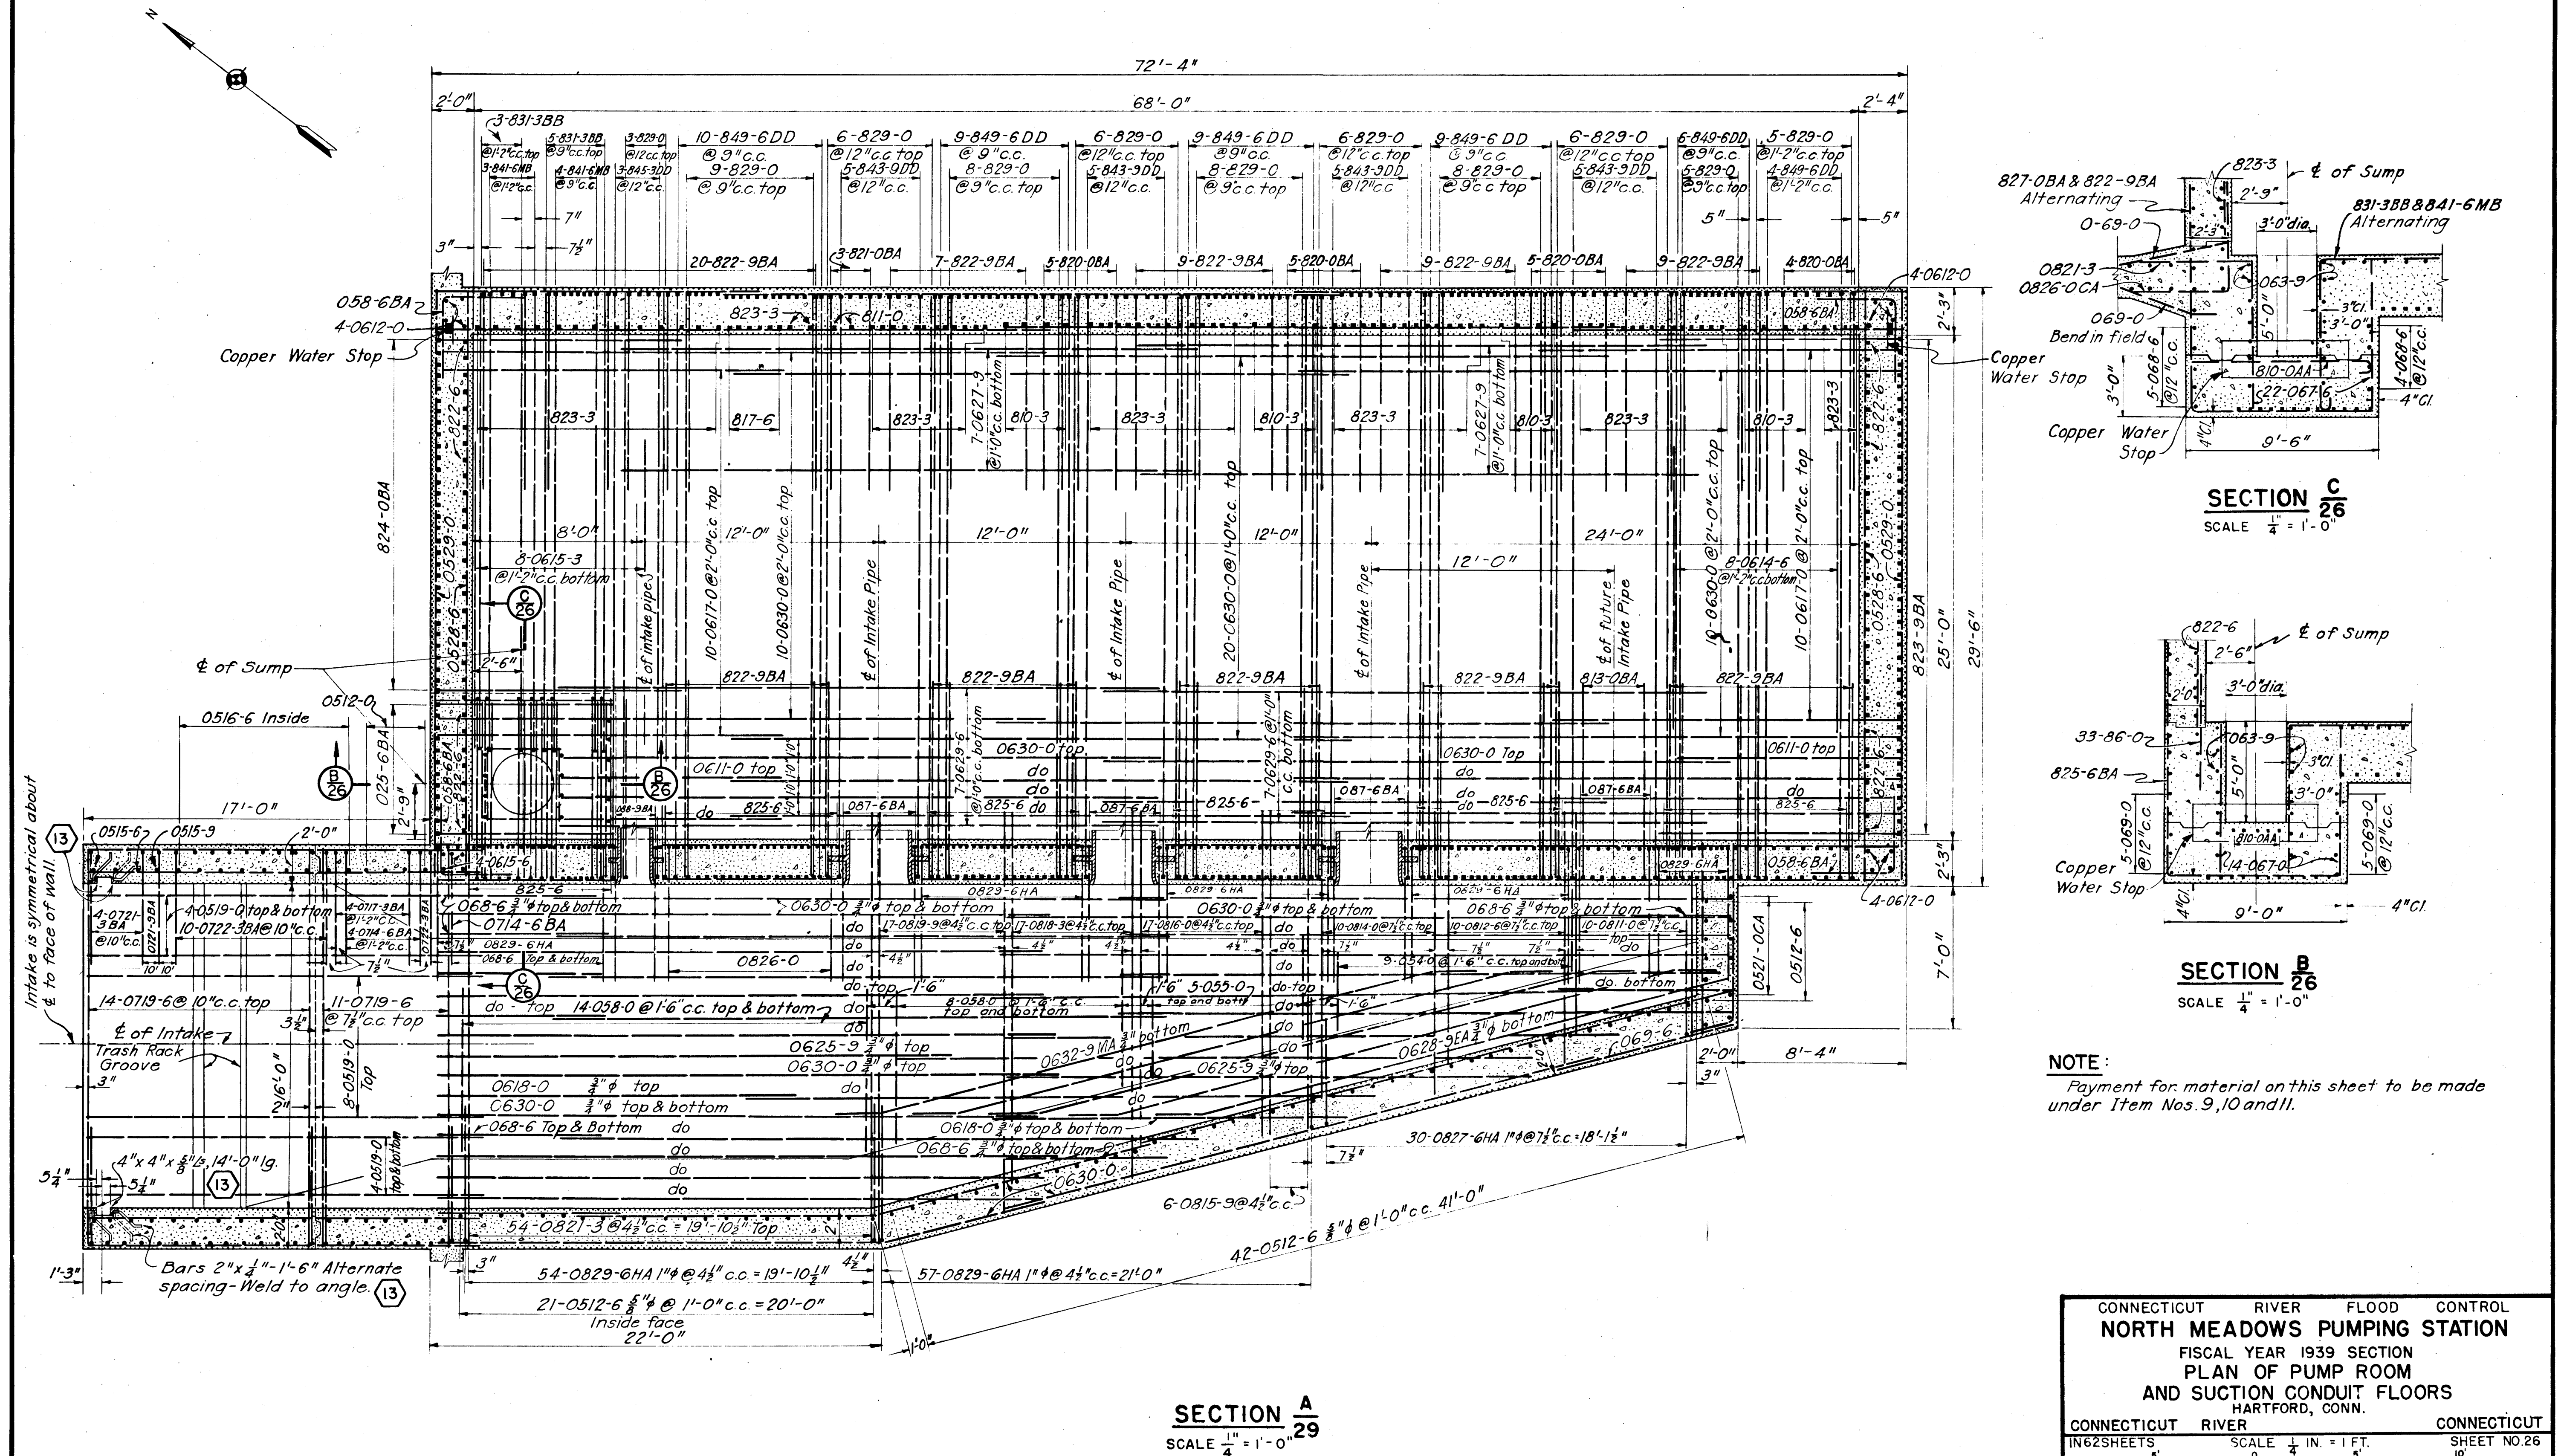

12/31/45	As built revisions				
DATE	REVISION	REV. BY	CK. BY	AP. BY	

CONNECTICUT RIVER FLOOD CONTROL			
NORTH MEADOWS PUMPING STATION			
FISCAL YEAR 1939 SECTION			
PLAN OF PUMP ROOM			
AND SUCTION CONDUIT FLOORS			
HARTFORD, CONN.			
CONNECTICUT	RIVER	CONNECTICUT	
IN 62 SHEETS	SCALE $\frac{1}{4}'' = 1'-0''$	SHEET NO. 26	
U. S. ENGINEER OFFICE, PROVIDENCE, R.I. FEB. 1939			
SUBMITTED	APPROVED	APPROVED	
Principal B. H. Burns	J. S. Burns	J. S. Burns	
SENIOR ENGINEER	PRINCIPAL ENGINEER	LTCOL CORPS OF ENGINEERS	
HEAD, DESIGN SECTION	CHIEF, F.C. ENGINEERING DIV.	DISTRICT ENGINEER	
DESIGNED	DRAWN BY	FILE NO.	
E. M. Vail	N. J. W. M. B. R.	CT-4-1274	
ASSOC. ENGINEER	CHECKED BY		