

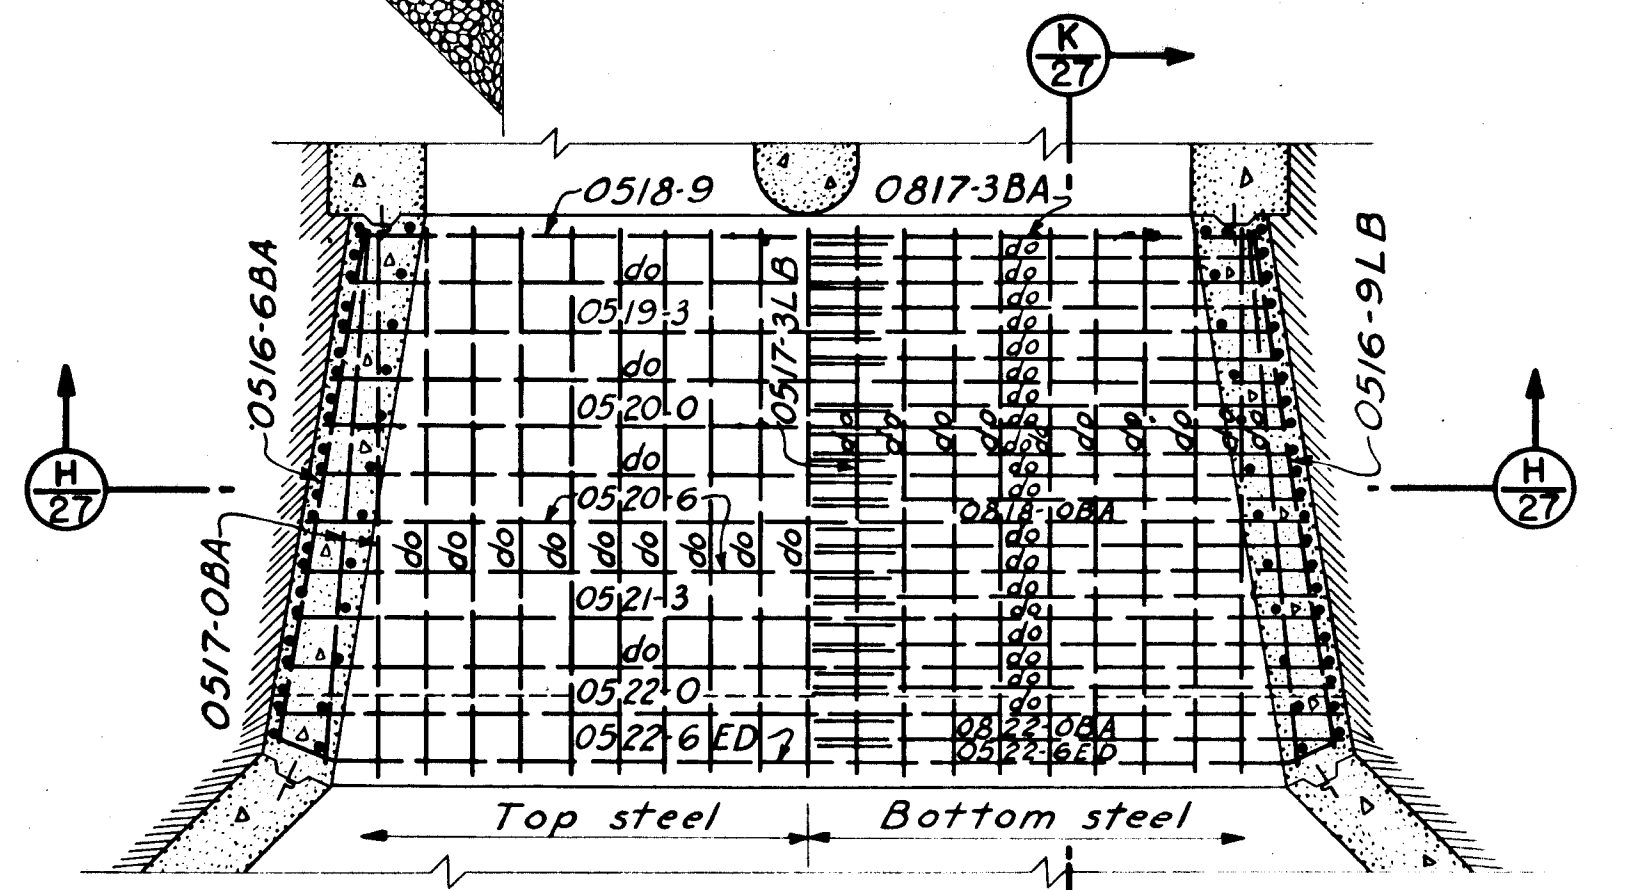
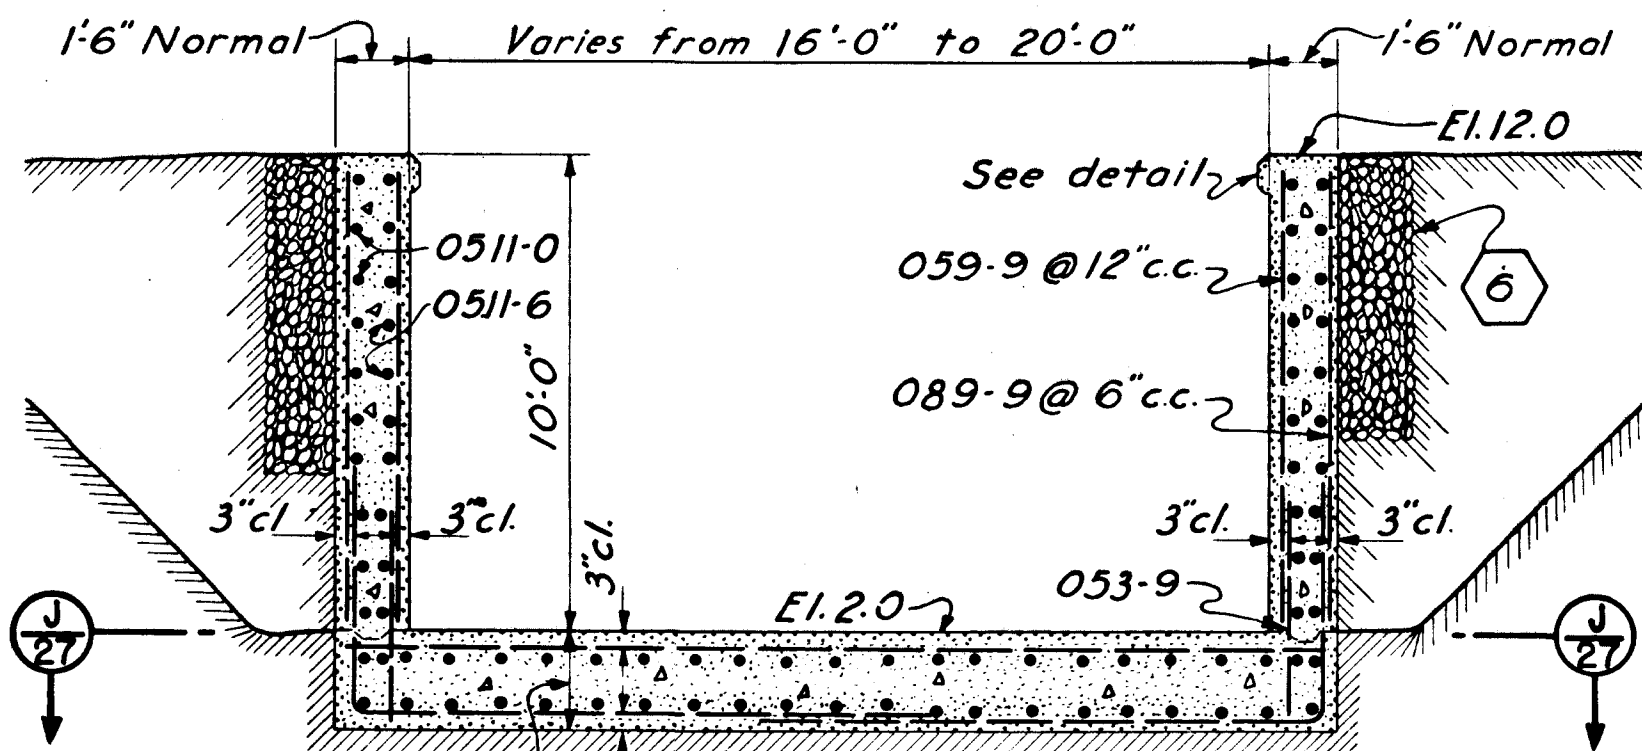
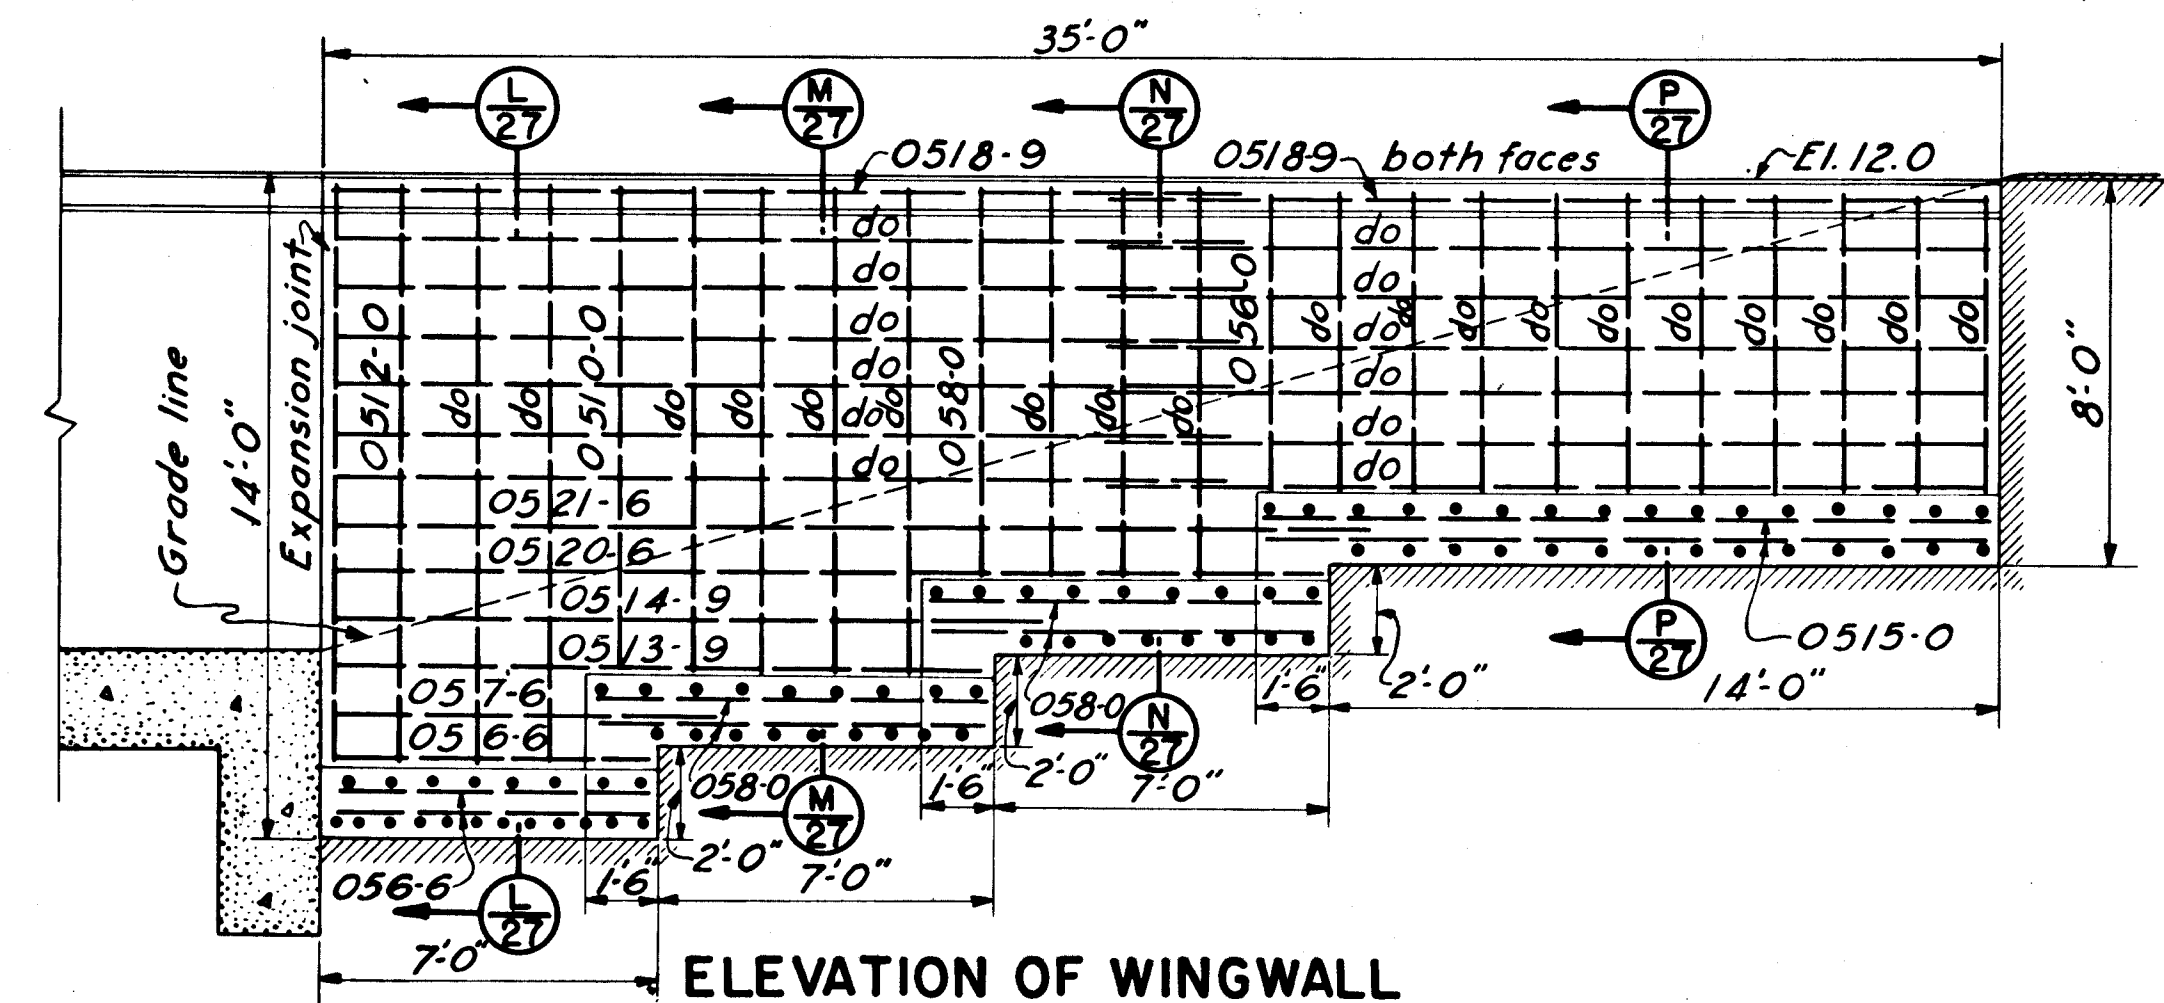


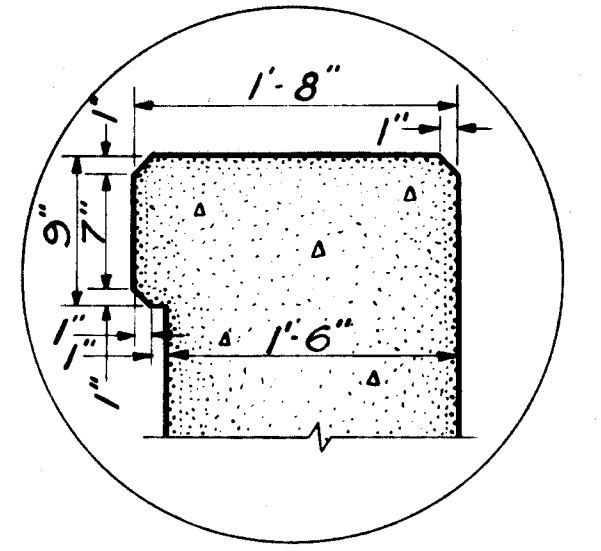

NOTES:
All reinforced concrete to be paid for under Items No. 9, 10 & 11.
For additional details of conduit see Sheets No. 34 & 35.
For details of expansion joints and copper water stops see Sheet No. 7.

CONNECTICUT RIVER FLOOD CONTROL			
NORTH MEADOWS PUMPING STATION			
FISCAL YEAR 1939 SECTION			
CONDUIT TRANSITION AND OUTLET			
CONNECTICUT RIVER		HARTFORD, CONN.	
IN 62 SHEETS		SCALE 1/4" = 1'-0"	
U. S. ENGINEER OFFICE, PROVIDENCE, R.I.		FEB. 1939	
SUBMITTED	APPROVED	RECOMMENDED	APPROVED
HEAD DESIGN SECTION	CHIEF, F.C. ENGINEERING DIV.	LT. COL. CORPS OF ENGINEERS	DISTRICT ENGINEER
DESIGNED	DRAWN BY	TRACED BY	CHECKED BY
12-31-45	As built	REV BY	CK BY
DATE	REVISION	REV BY	CK BY

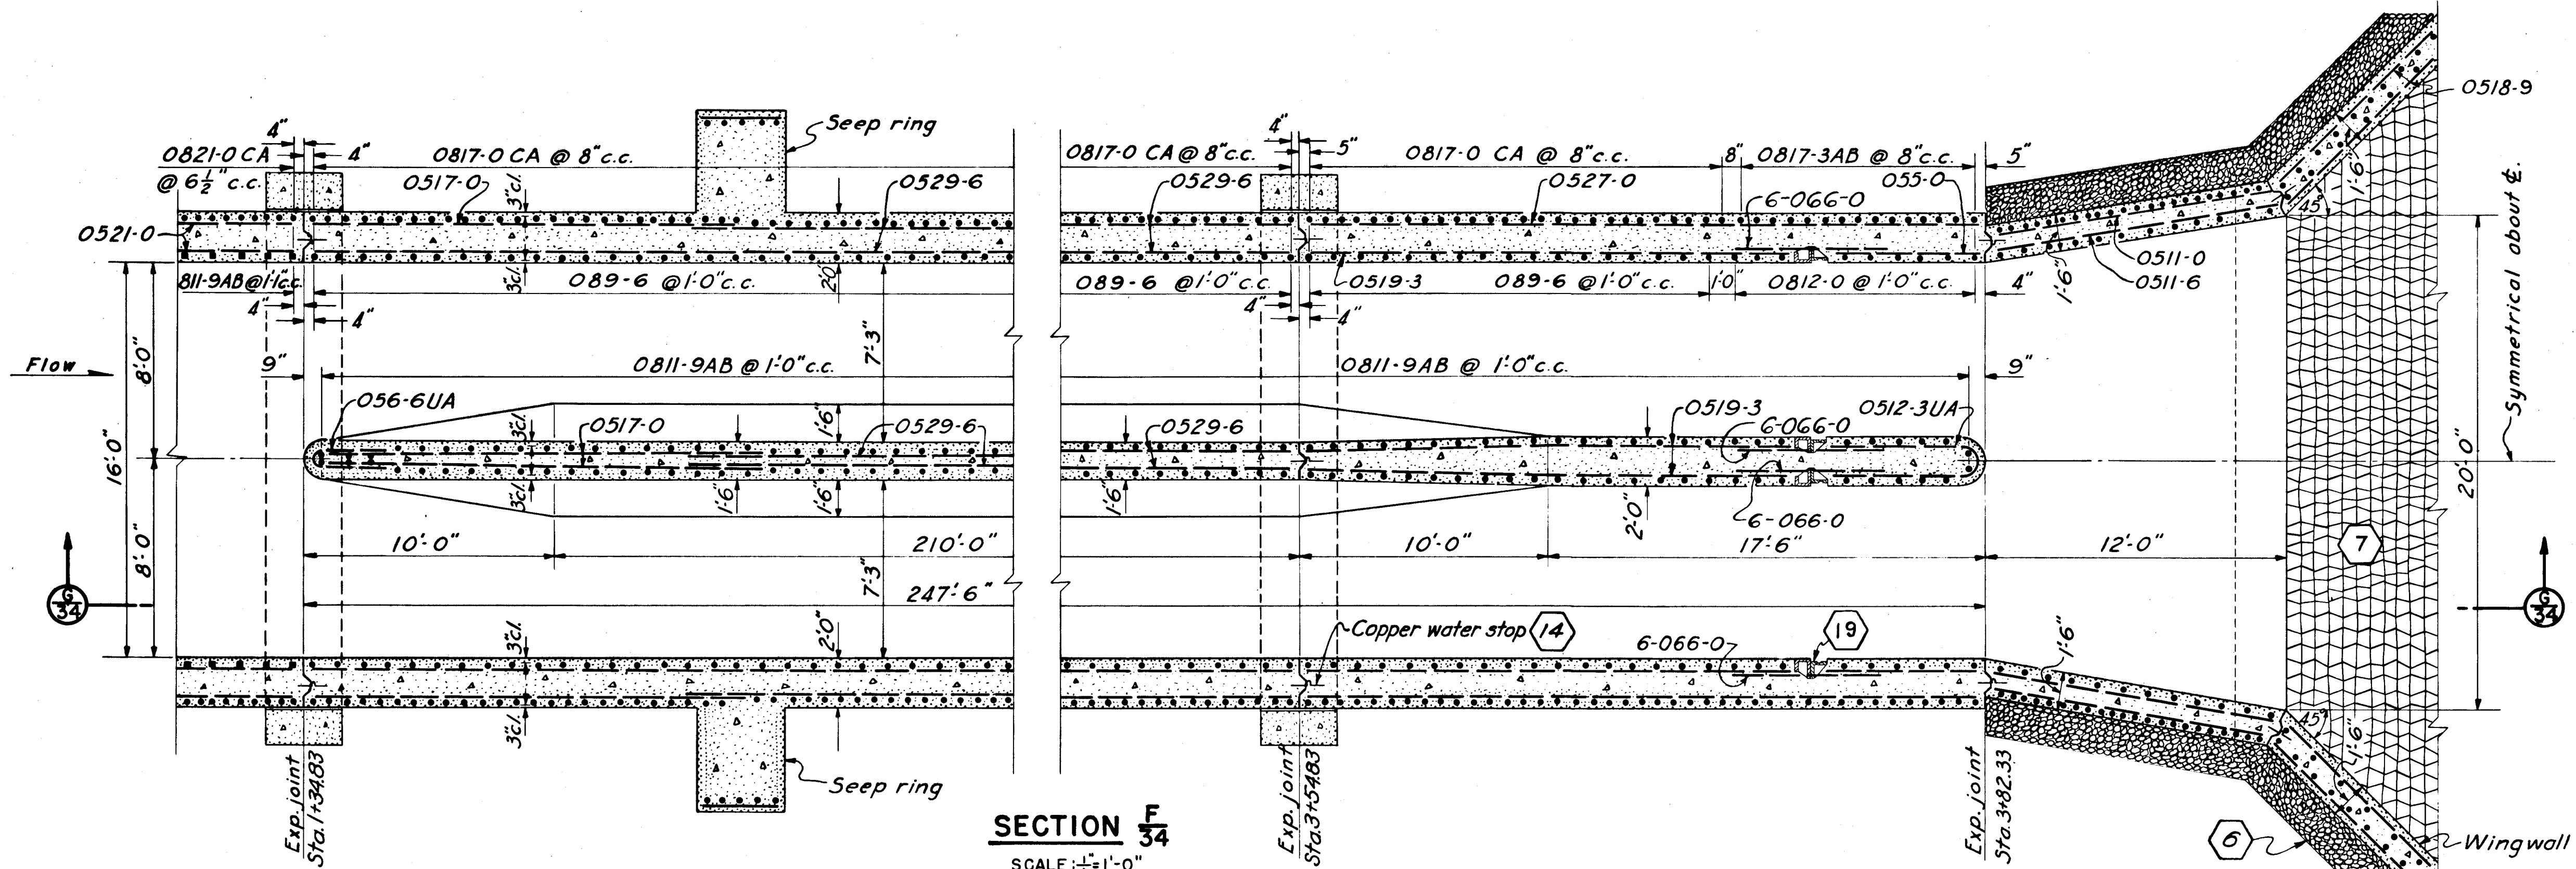