
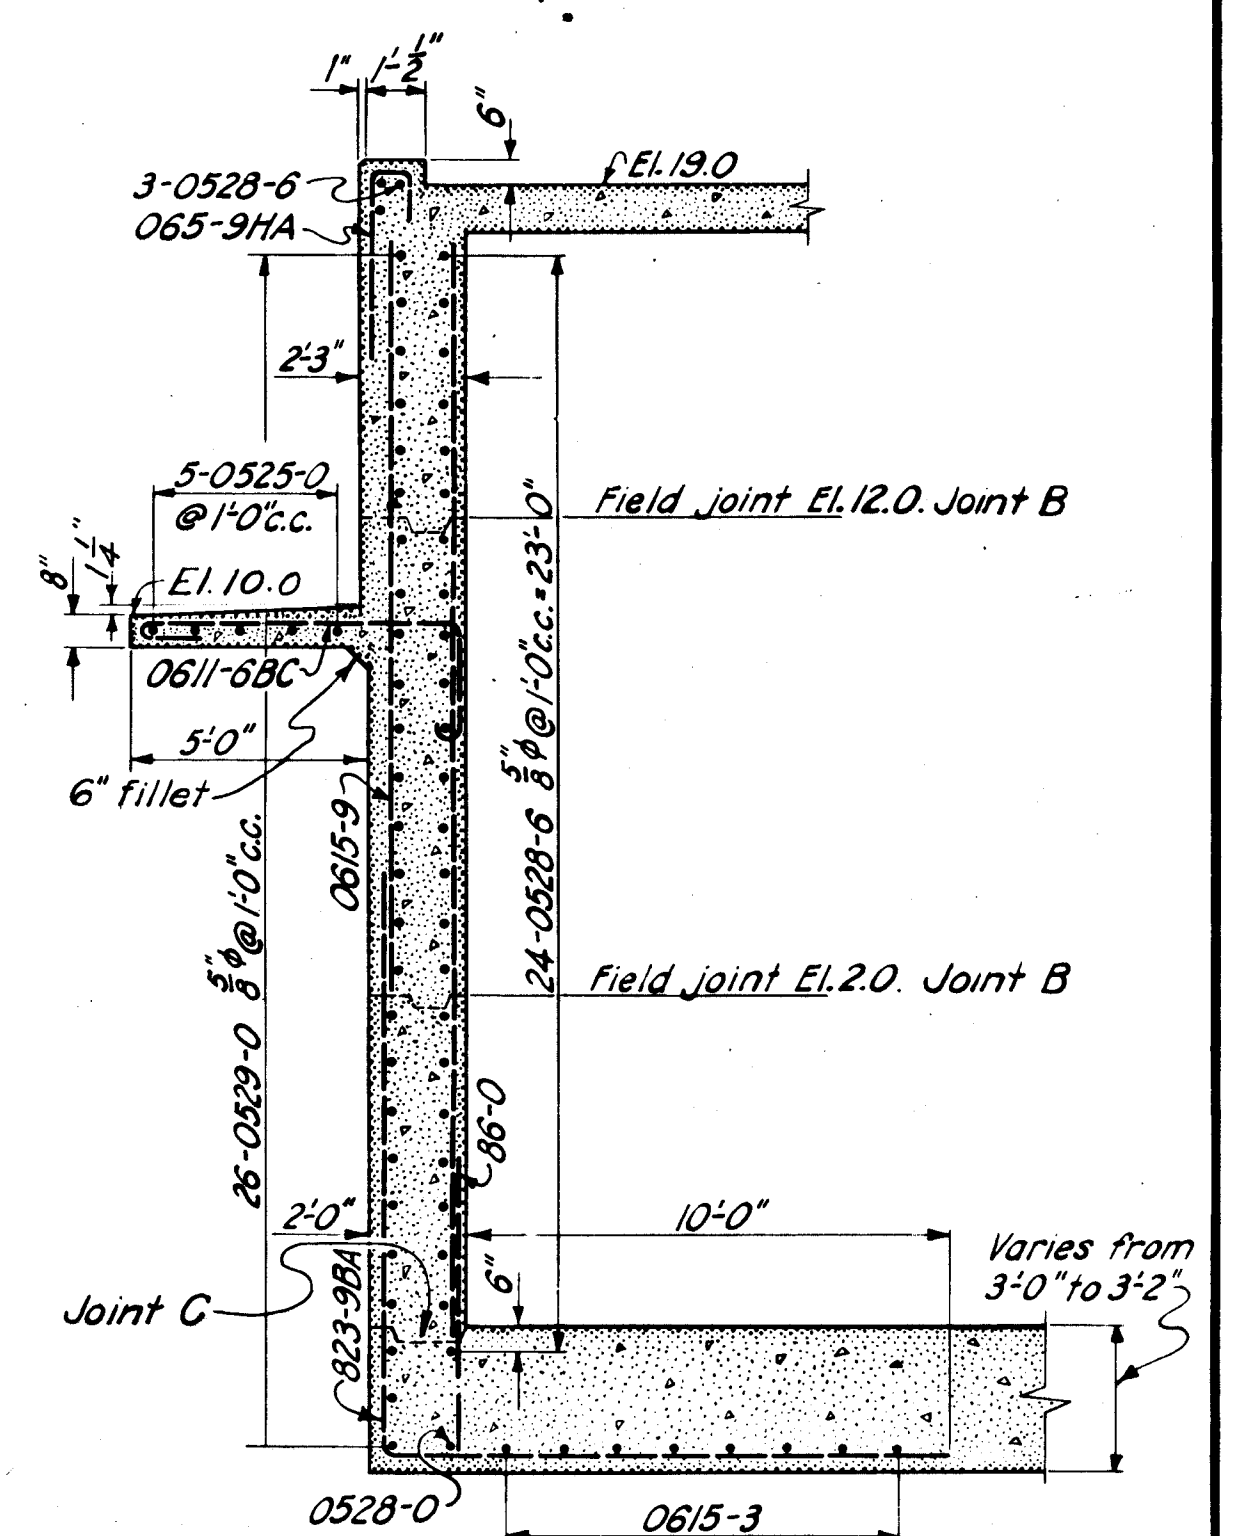
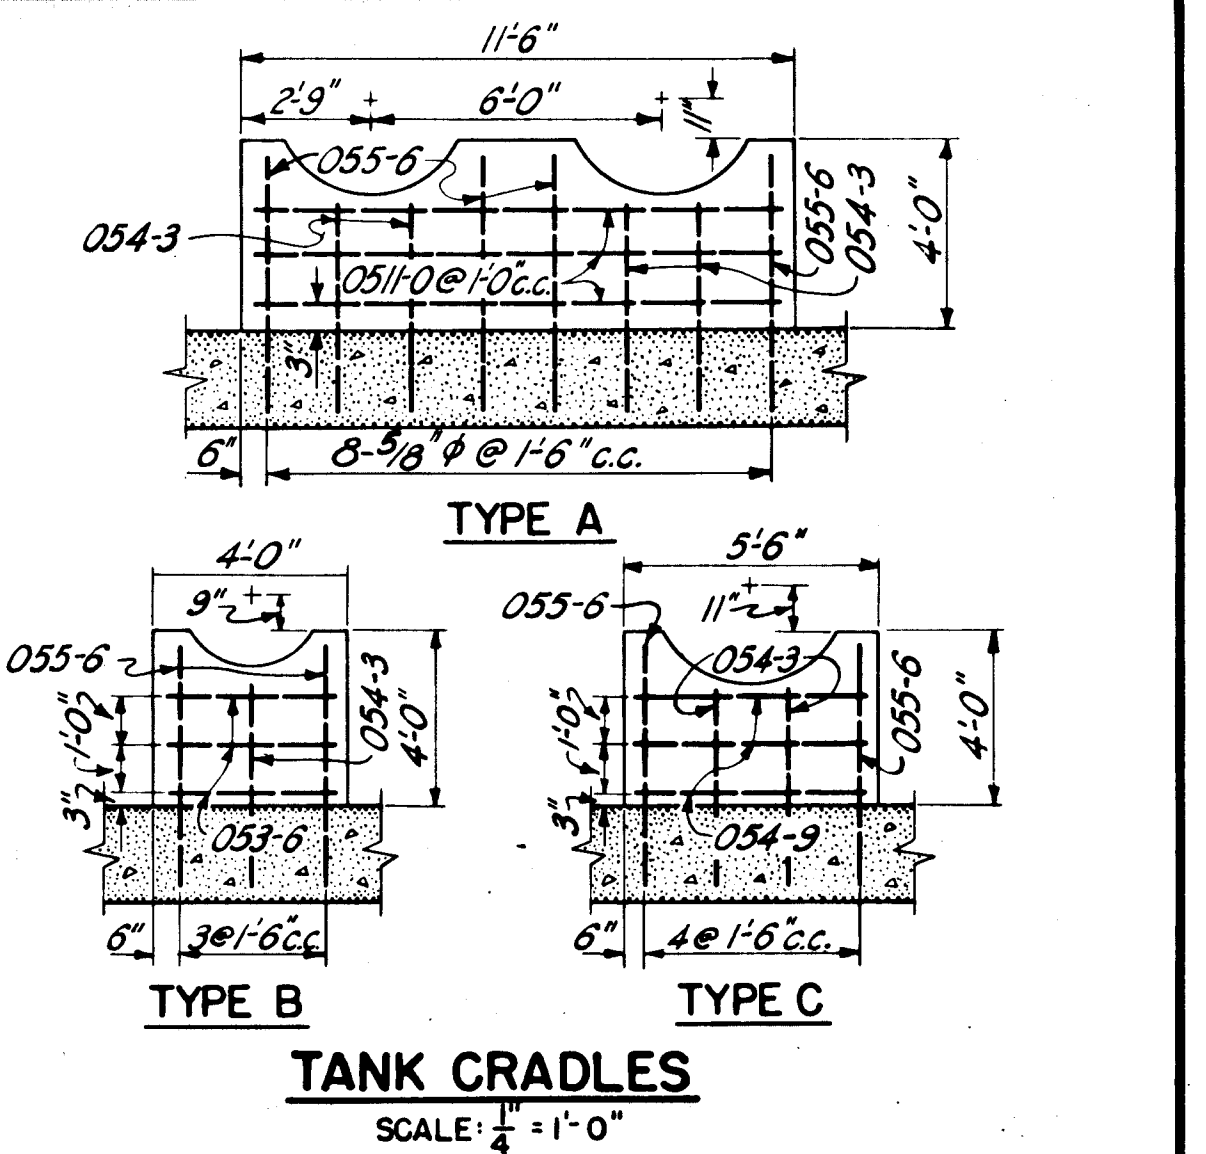


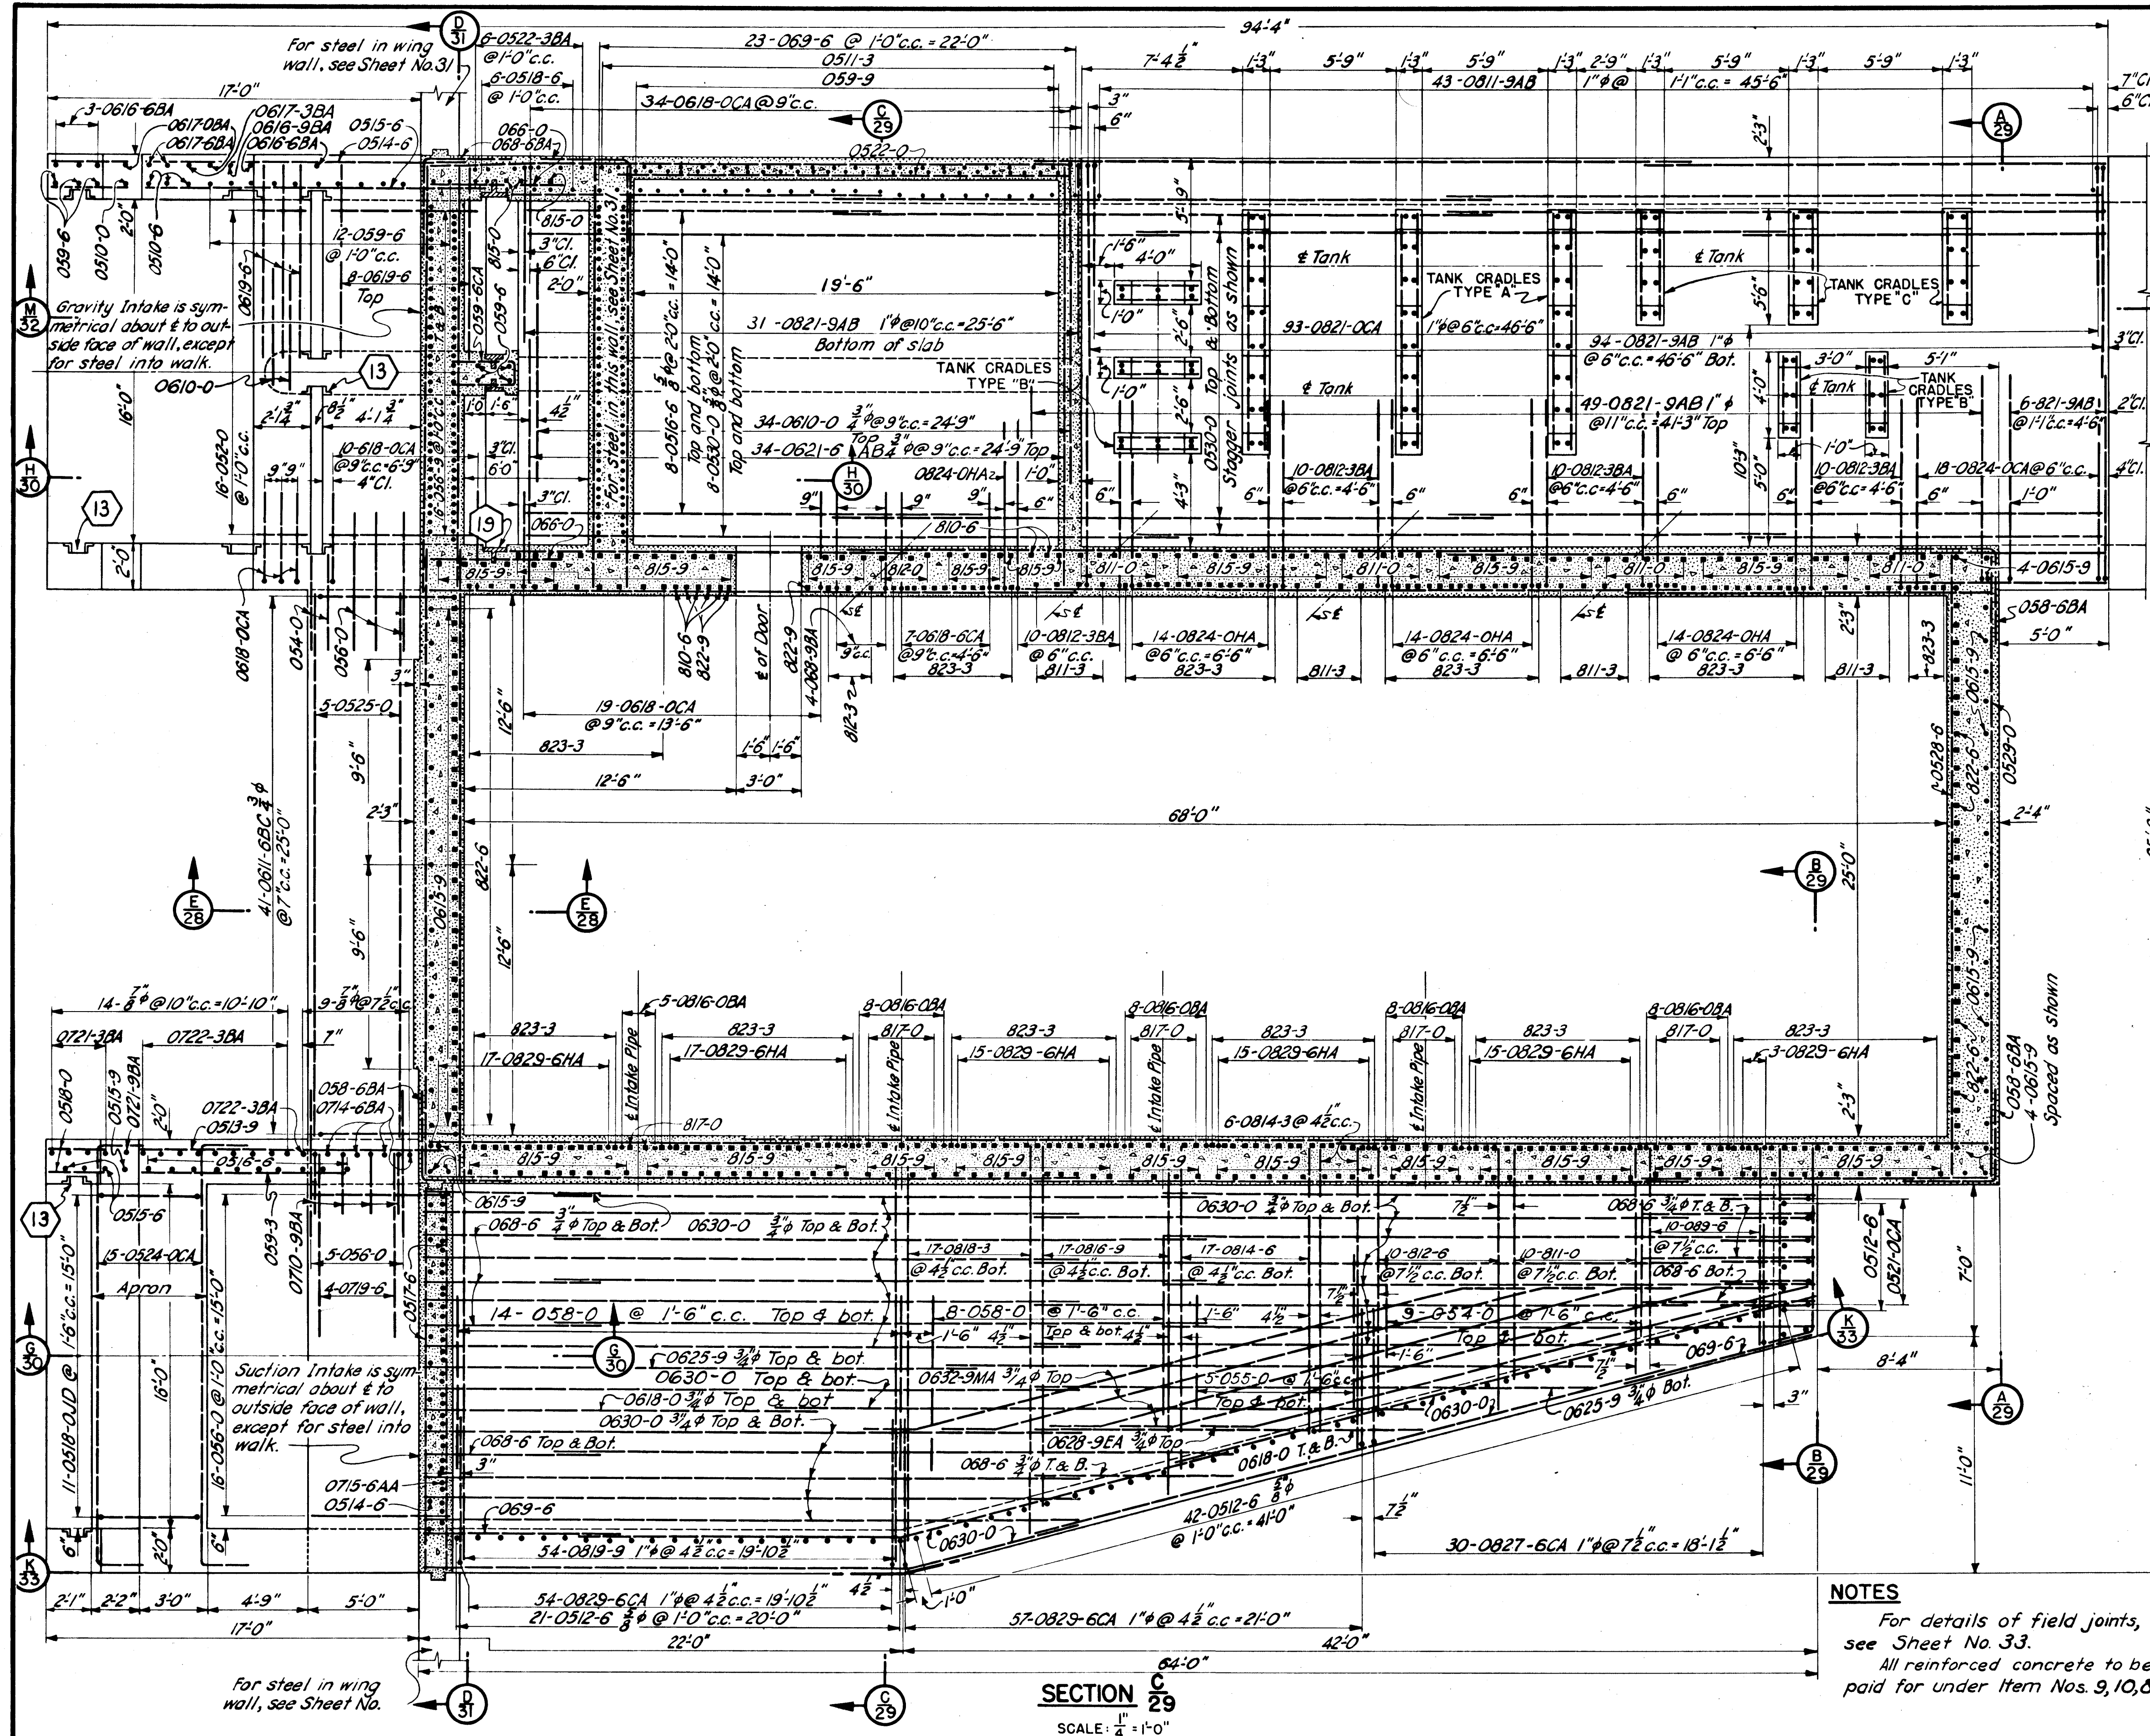

NOTES

For details of field joints, see Sheet No. 33.
All reinforced concrete to be paid for under Item Nos. 9, 10, & 11.

12/31/45	As built revisions				
DATE	REVISION	REV. BY	CK. BY	AR. BY	
CONNECTICUT RIVER FLOOD CONTROL					
NORTH MEADOWS PUMPING STATION					
FISCAL YEAR 1939 SECTION					
PLAN OF CONDUIT ROOF SLABS					
HARTFORD, CONN.					
CONNECTICUT RIVER			CONNECTICUT		
IN 62 SHEETS			SHEET NO. 28		
SCALE: 1/4" = 1' FT.					
U. S. ENGINEER OFFICE, PROVIDENCE, R. I., FEB. 1939					
SUBMITTED:		APPROVAL		RECOMMENDED:	
HEAD DESIGN SECTION		PRINCIPAL ENGINEER		CHIEF, F.C. ENGINEERING DIV.	
DESIGNED:		DRAWN BY:		FILE NO. CT-4-1276	
ASSOC. ENGINEER		CHECKED BY:			