



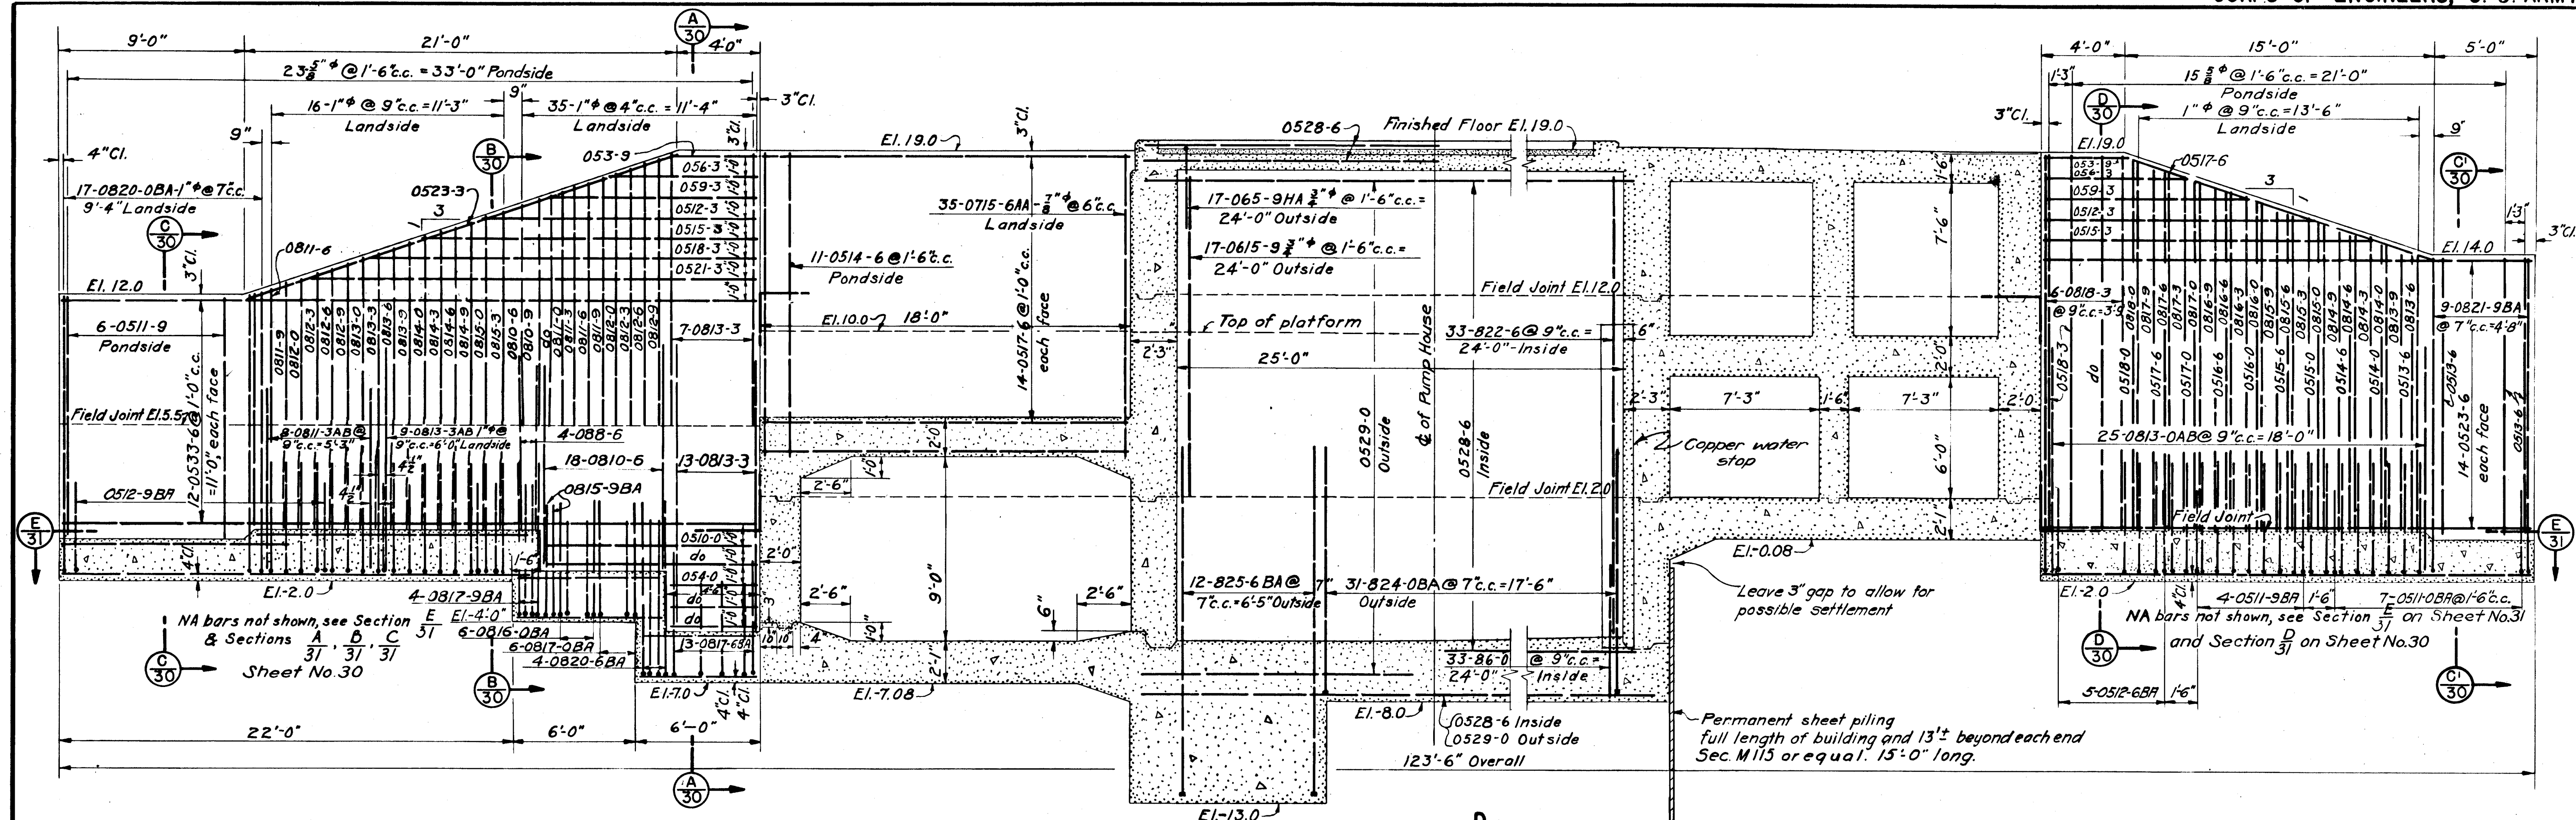

SECTION D
28

SCALE: $\frac{1}{4}'' = 1'-0''$

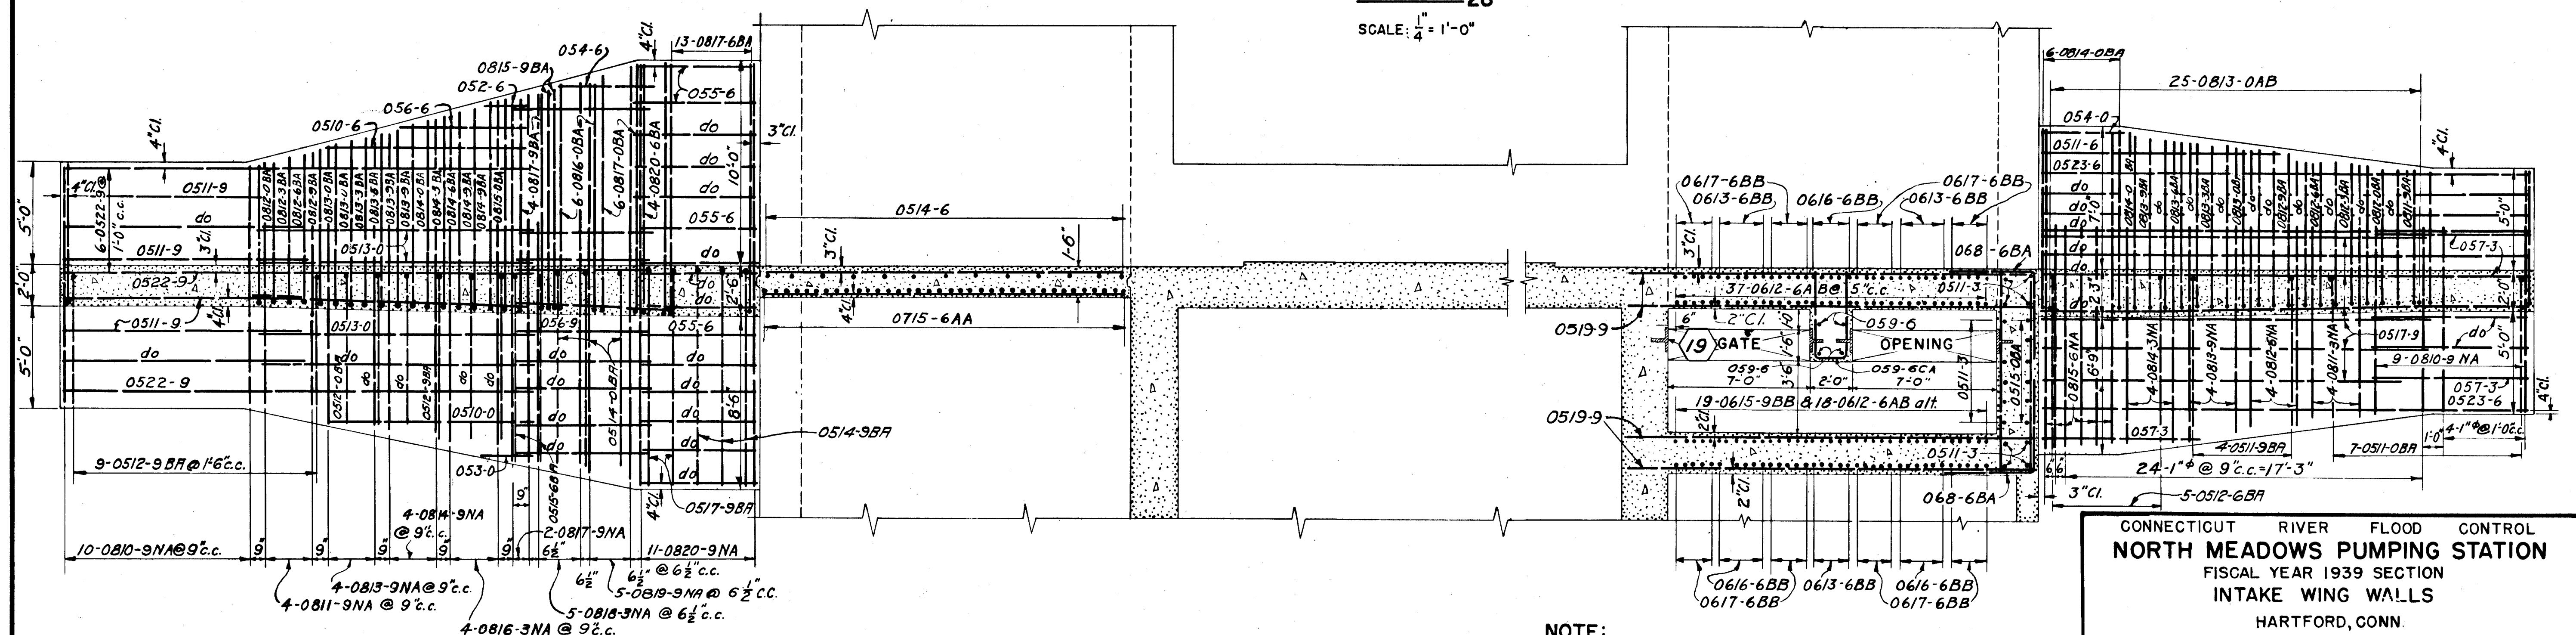

SECTION E
31

SCALE: $\frac{1}{4}'' = 1'-0''$

NOTE:
All reinforced concrete to be paid for under Item Nos. 9, 10 & 11.

DATE	REVISION	REV BY	CHK BY	AP BY
12/31/45	As built revisions			
6/28/39	Steel sheet piling note added	JCS	MW	JRB

CONNECTICUT RIVER FLOOD CONTROL	
NORTH MEADOWS PUMPING STATION	
FISCAL YEAR 1939 SECTION	
INTAKE WING WALLS	
HARTFORD, CONN.	
CONNECTICUT RIVER	CONNECTICUT
IN 62 SHEETS	SHEET NO. 31
SCALE: $\frac{1}{4}'' = 1'-0''$	
U. S. ENGINEER OFFICE, PROVIDENCE, R. I., FEB. 1939	
SUBMITTED:	APPROVED:
DESIGNED:	TRACED BY:
CHECKED BY:	FILE NO. CT-4-1279