


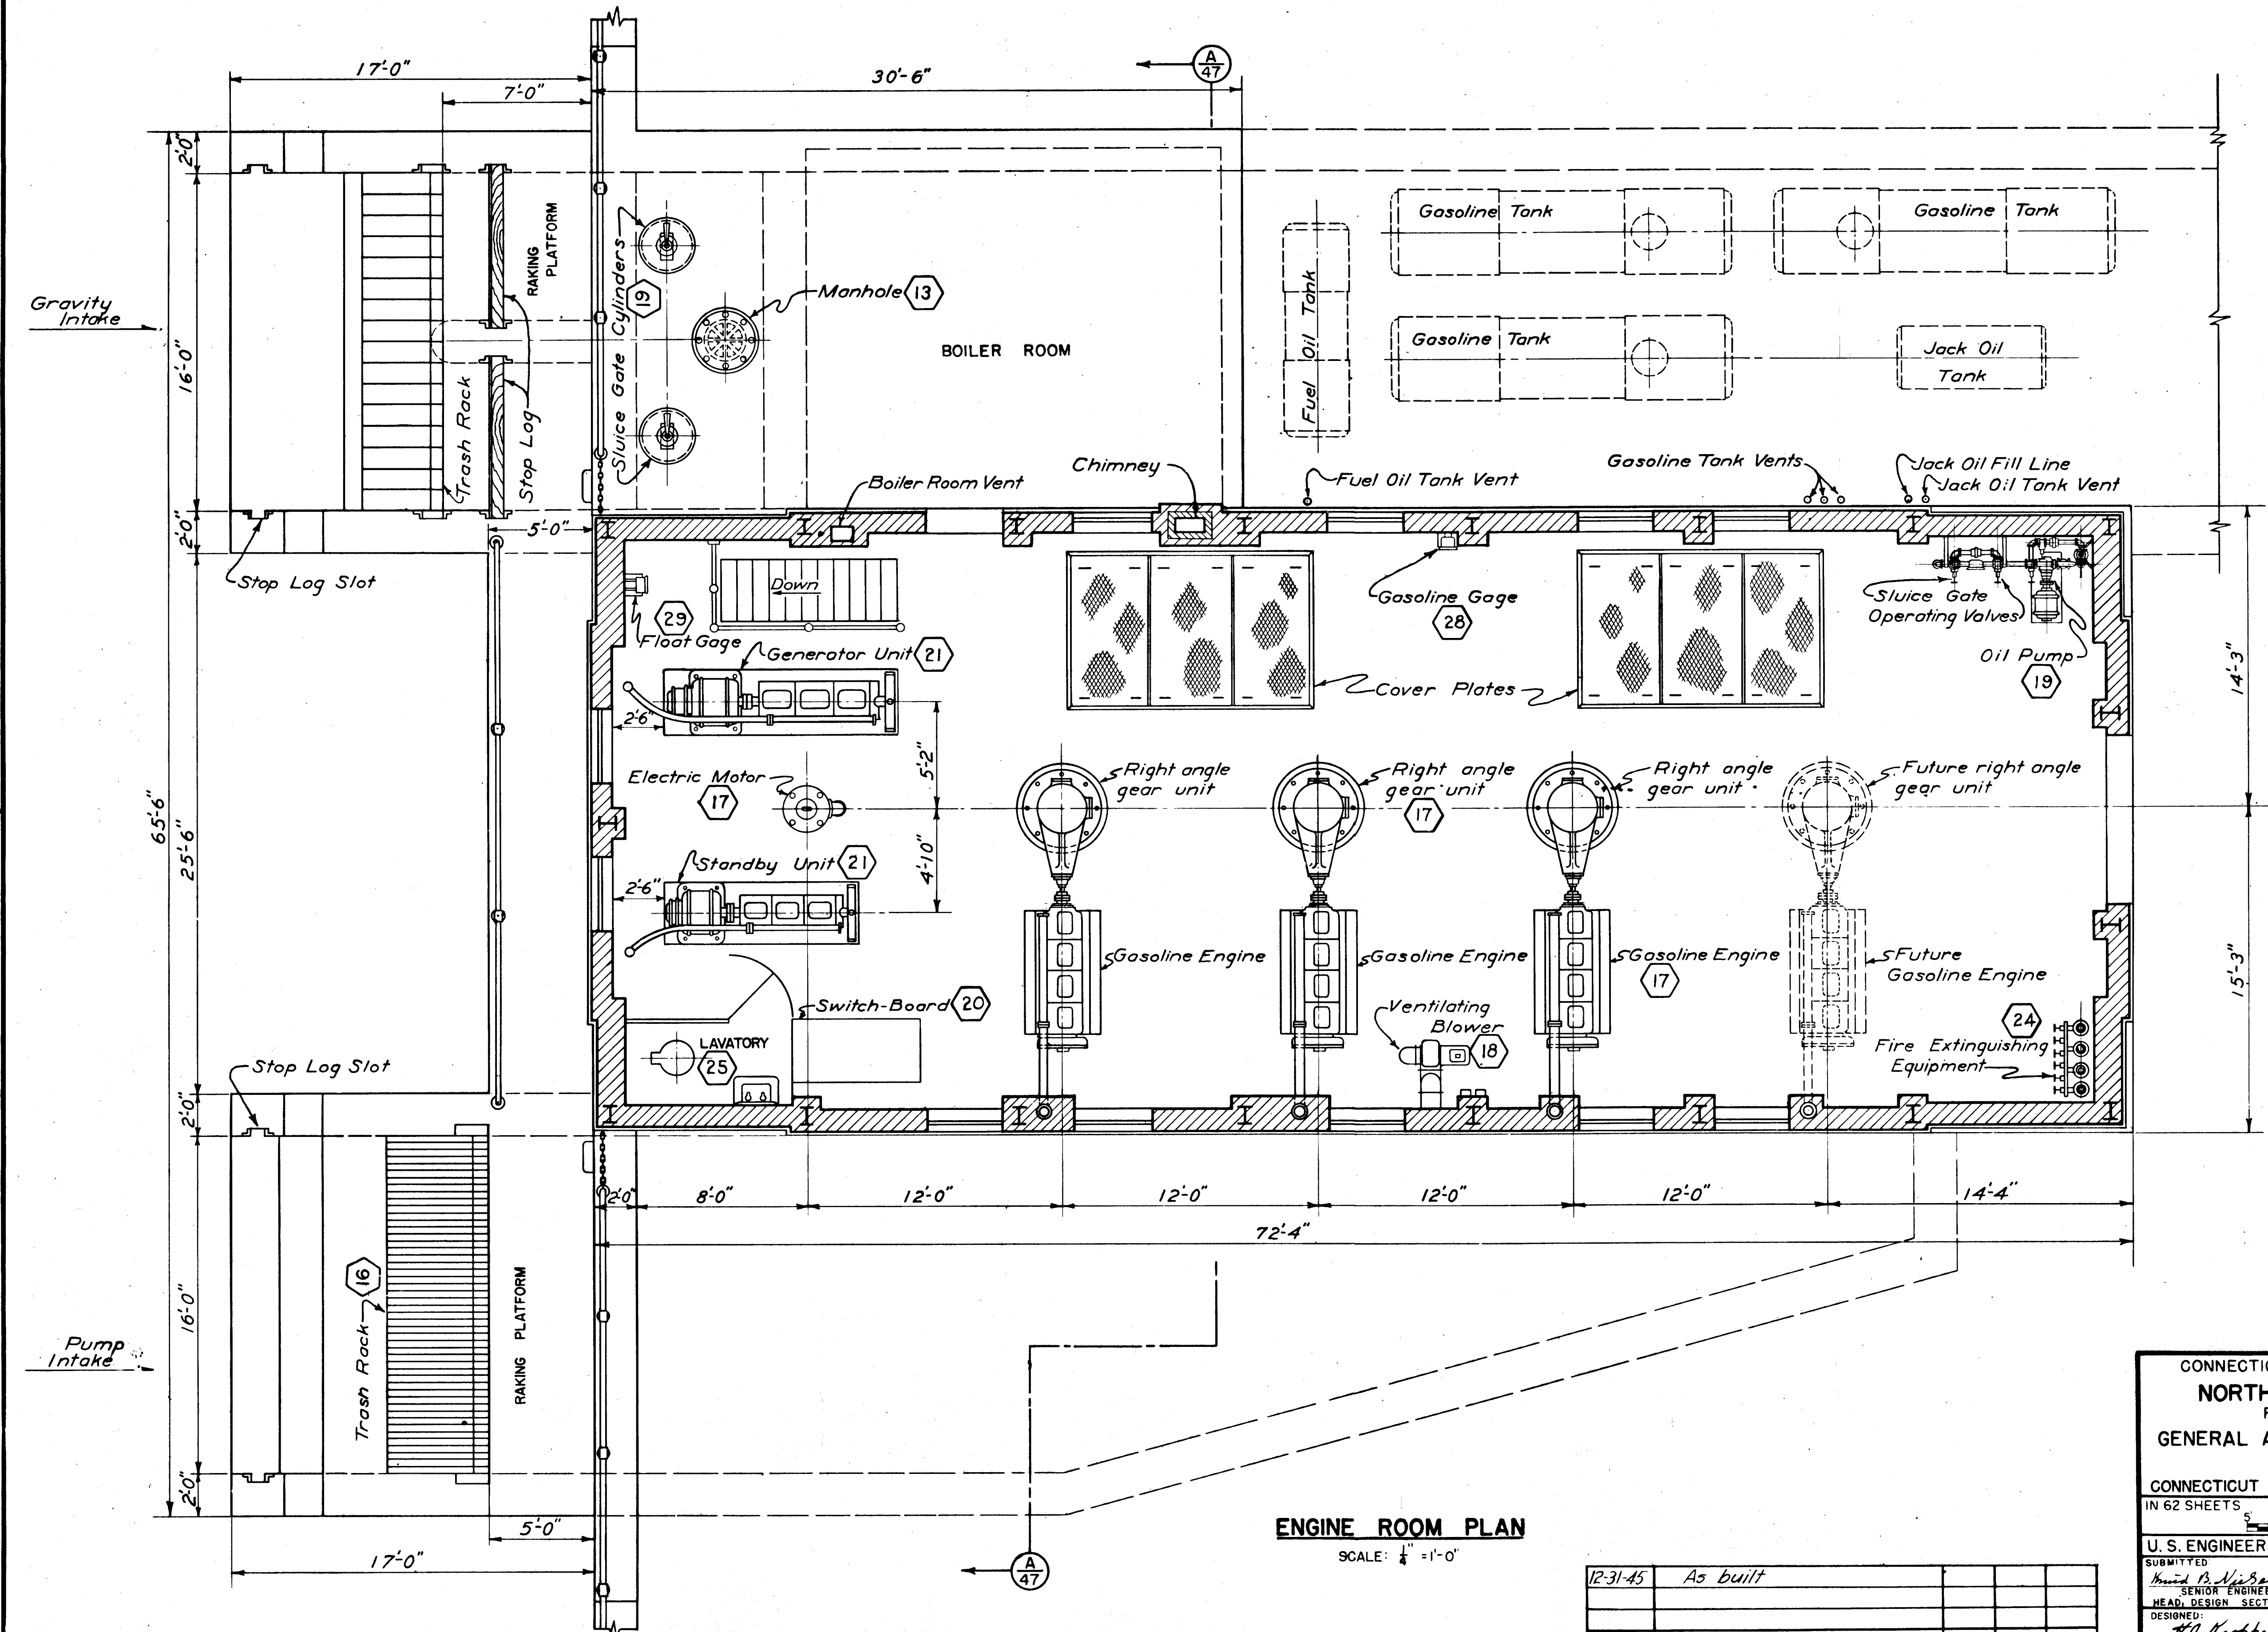

ENGINE ROOM PLAN

SCALE: 1/4" = 1'-0"

12-31-45	As built				
DATE	REVISION	REV. BY	CK. BY	AP. BY	

CONNECTICUT RIVER FLOOD CONTROL		
NORTH MEADOWS PUMPING STATION		
FISCAL YEAR 1939 SECTION		
GENERAL ARRANGEMENT OF EQUIPMENT NO. 1		
HARTFORD, CONN.		
CONNECTICUT RIVER	CONNECTICUT	
IN 62 SHEETS	SCALE 1/4 IN. = 1 FT.	SHEET NO 45
U. S. ENGINEER OFFICE, PROVIDENCE, R. I., FEB. 1939		
SUBMITTED	APPROVAL RECOMMENDED	APPROVED
David B. Nibben	J. S. Burns	J. S. Burns
SENIOR ENGINEER	PRINCIPAL ENGINEER	LT COL. CORPS OF ENGINEERS
HEAD DESIGN SECTION	CHIEF, F.C. ENGINEERING DIV.	DISTRICT ENGINEER
DESIGNED BY	DRAWN BY: O. F. TRACED BY: E. J. B. CHECKED BY: S. R. L.	FILE NO CT-4-1293