


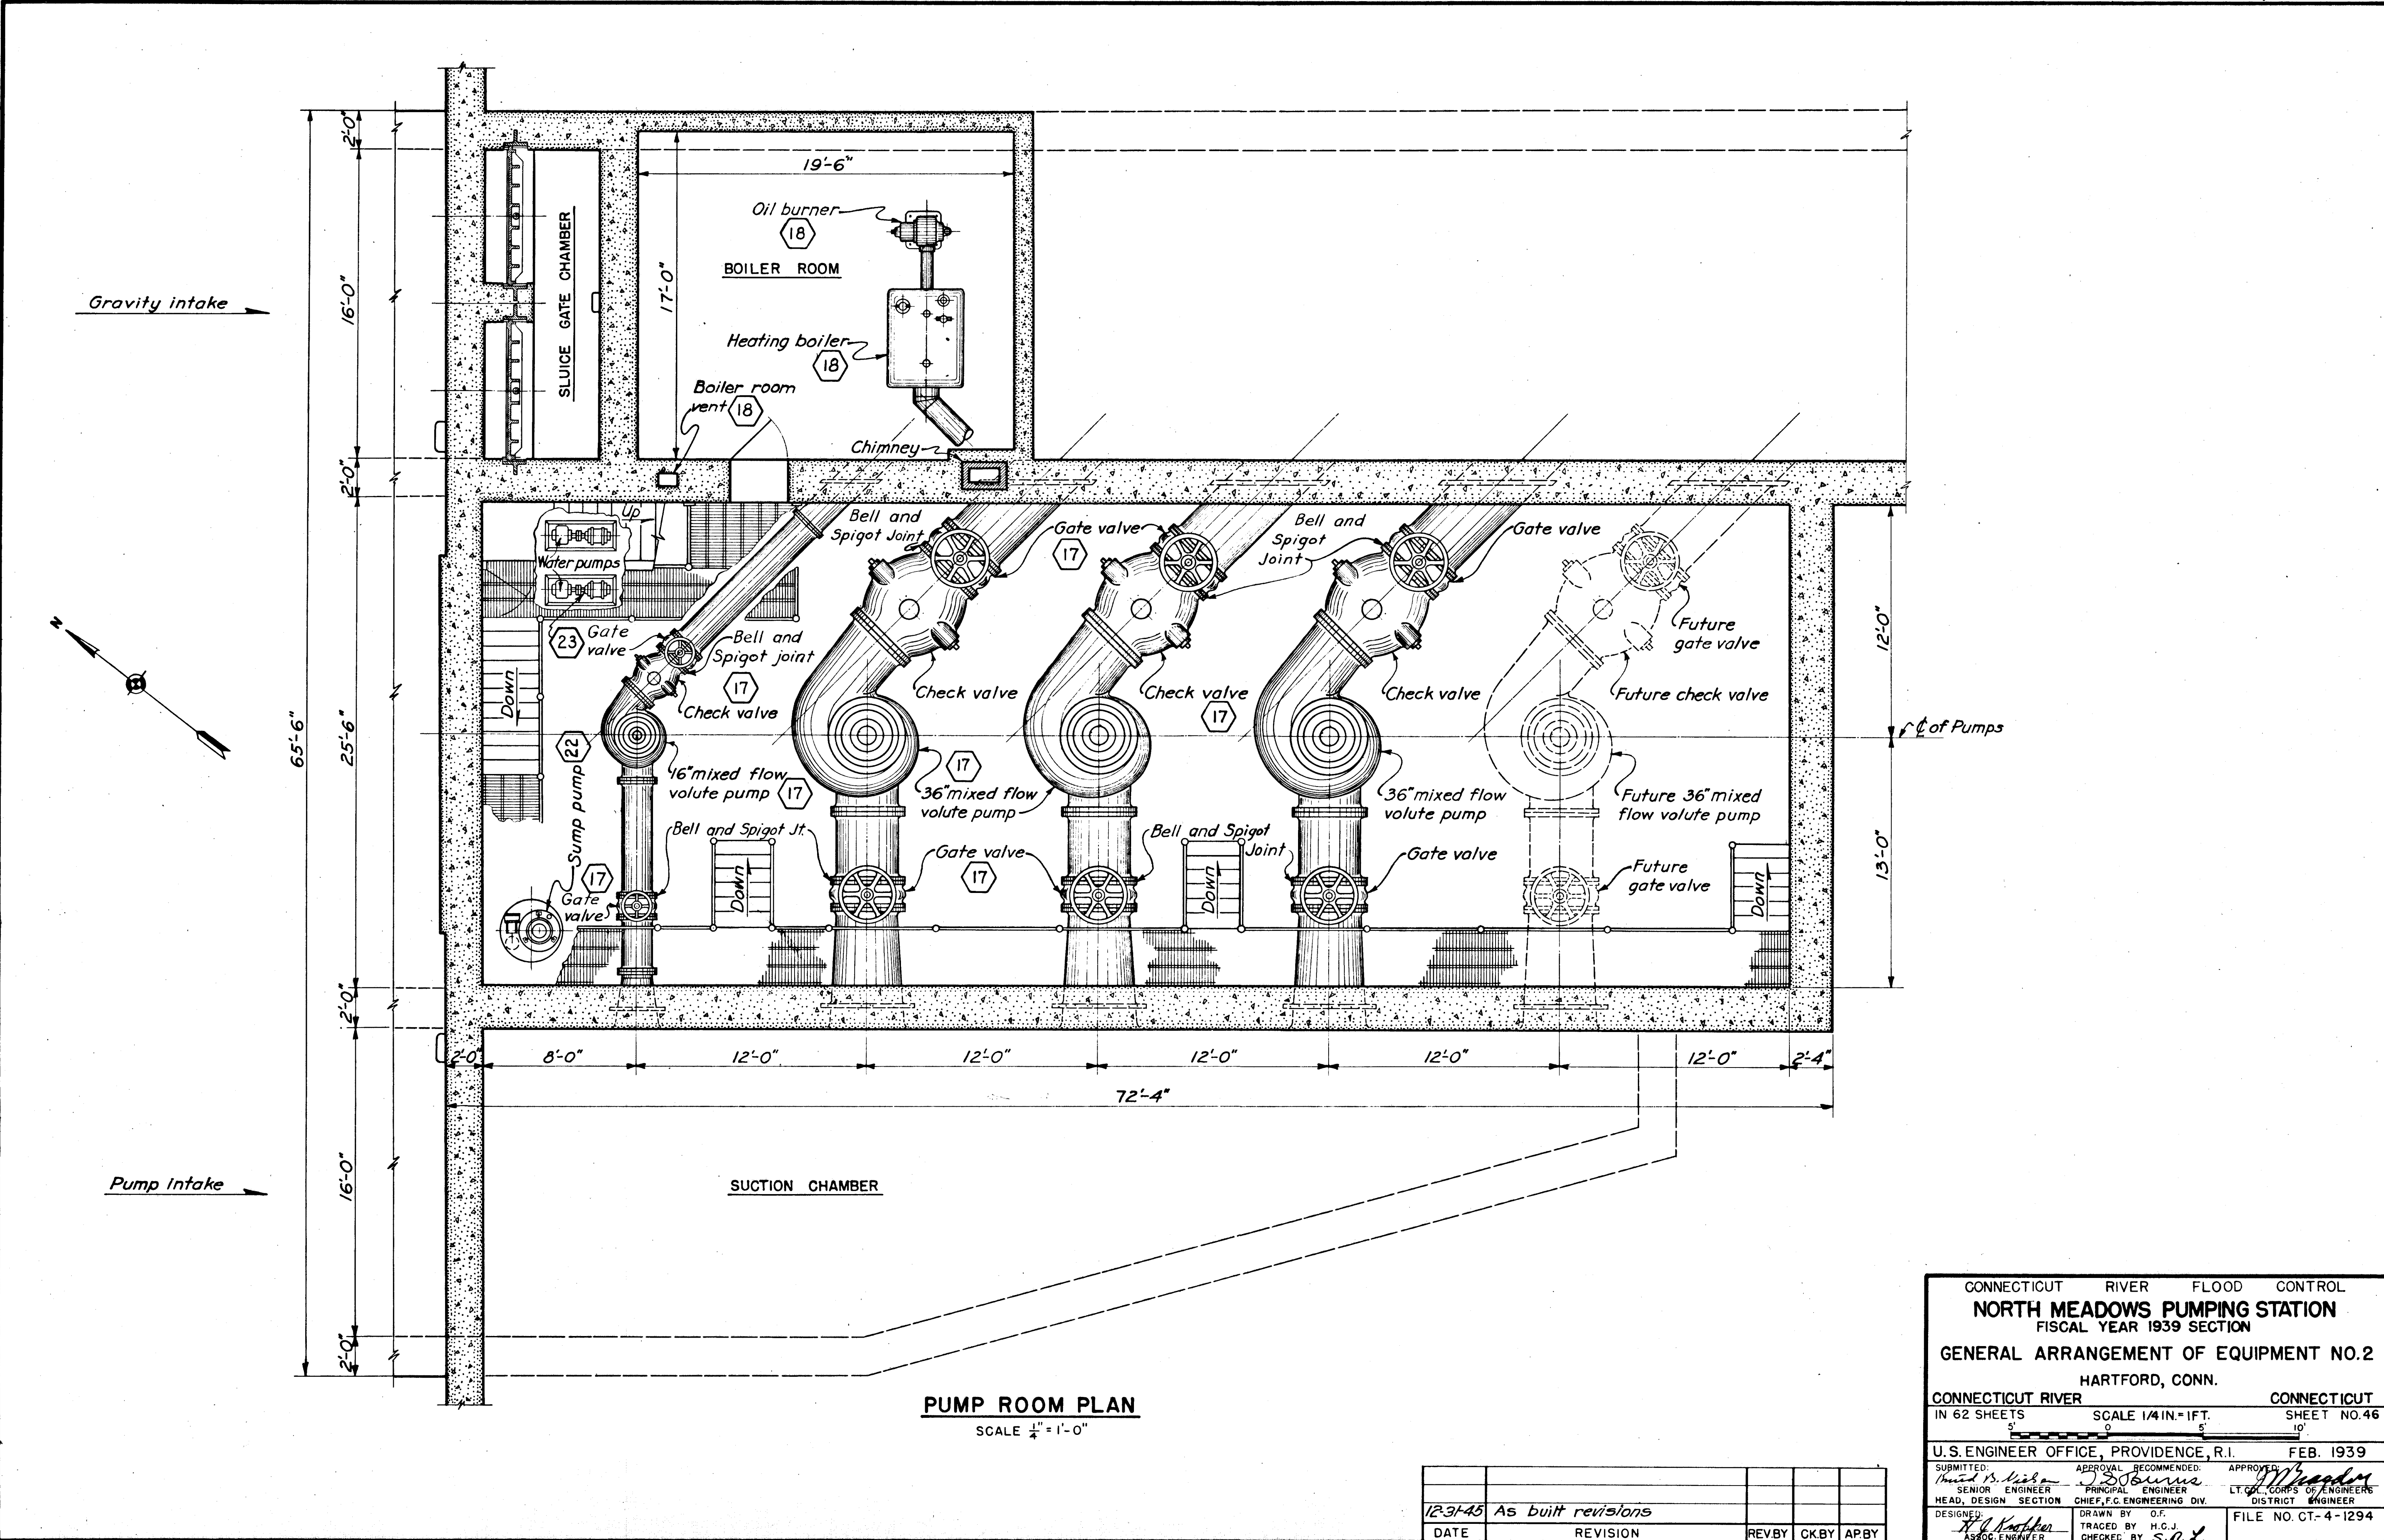

CONNECTICUT RIVER FLOOD CONTROL
NORTH MEADOWS PUMPING STATION
FISCAL YEAR 1939 SECTION
GENERAL ARRANGEMENT OF EQUIPMENT NO.2
HARTFORD, CONN.

CONNECTICUT RIVER CONNECTICUT
IN 62 SHEETS SCALE 1/4"=1'-0" SHEET NO.46

U.S. ENGINEER OFFICE, PROVIDENCE, R.I. FEB. 1939

SUBMITTED: <i>David B. Lishan</i> SENIOR ENGINEER	APPROVAL RECOMMENDED: <i>D. B. Burns</i> PRINCIPAL ENGINEER	APPROVED: <i>M. Mead</i> LT. COL. CORPS OF ENGINEERS
HEAD, DESIGN SECTION	CHIEF, F.C. ENGINEERING DIV.	DISTRICT ENGINEER

DESIGNED BY: *H. D. Knapp* ASSOC. ENGINEER
DRAWN BY: O.F.
TRACED BY: H.C.J.
CHECKED BY: *S. A. L.*

FILE NO. CT-4-1294

12-31-45	As built revisions				
DATE	REVISION	REVBY	CKBY	APBY	