


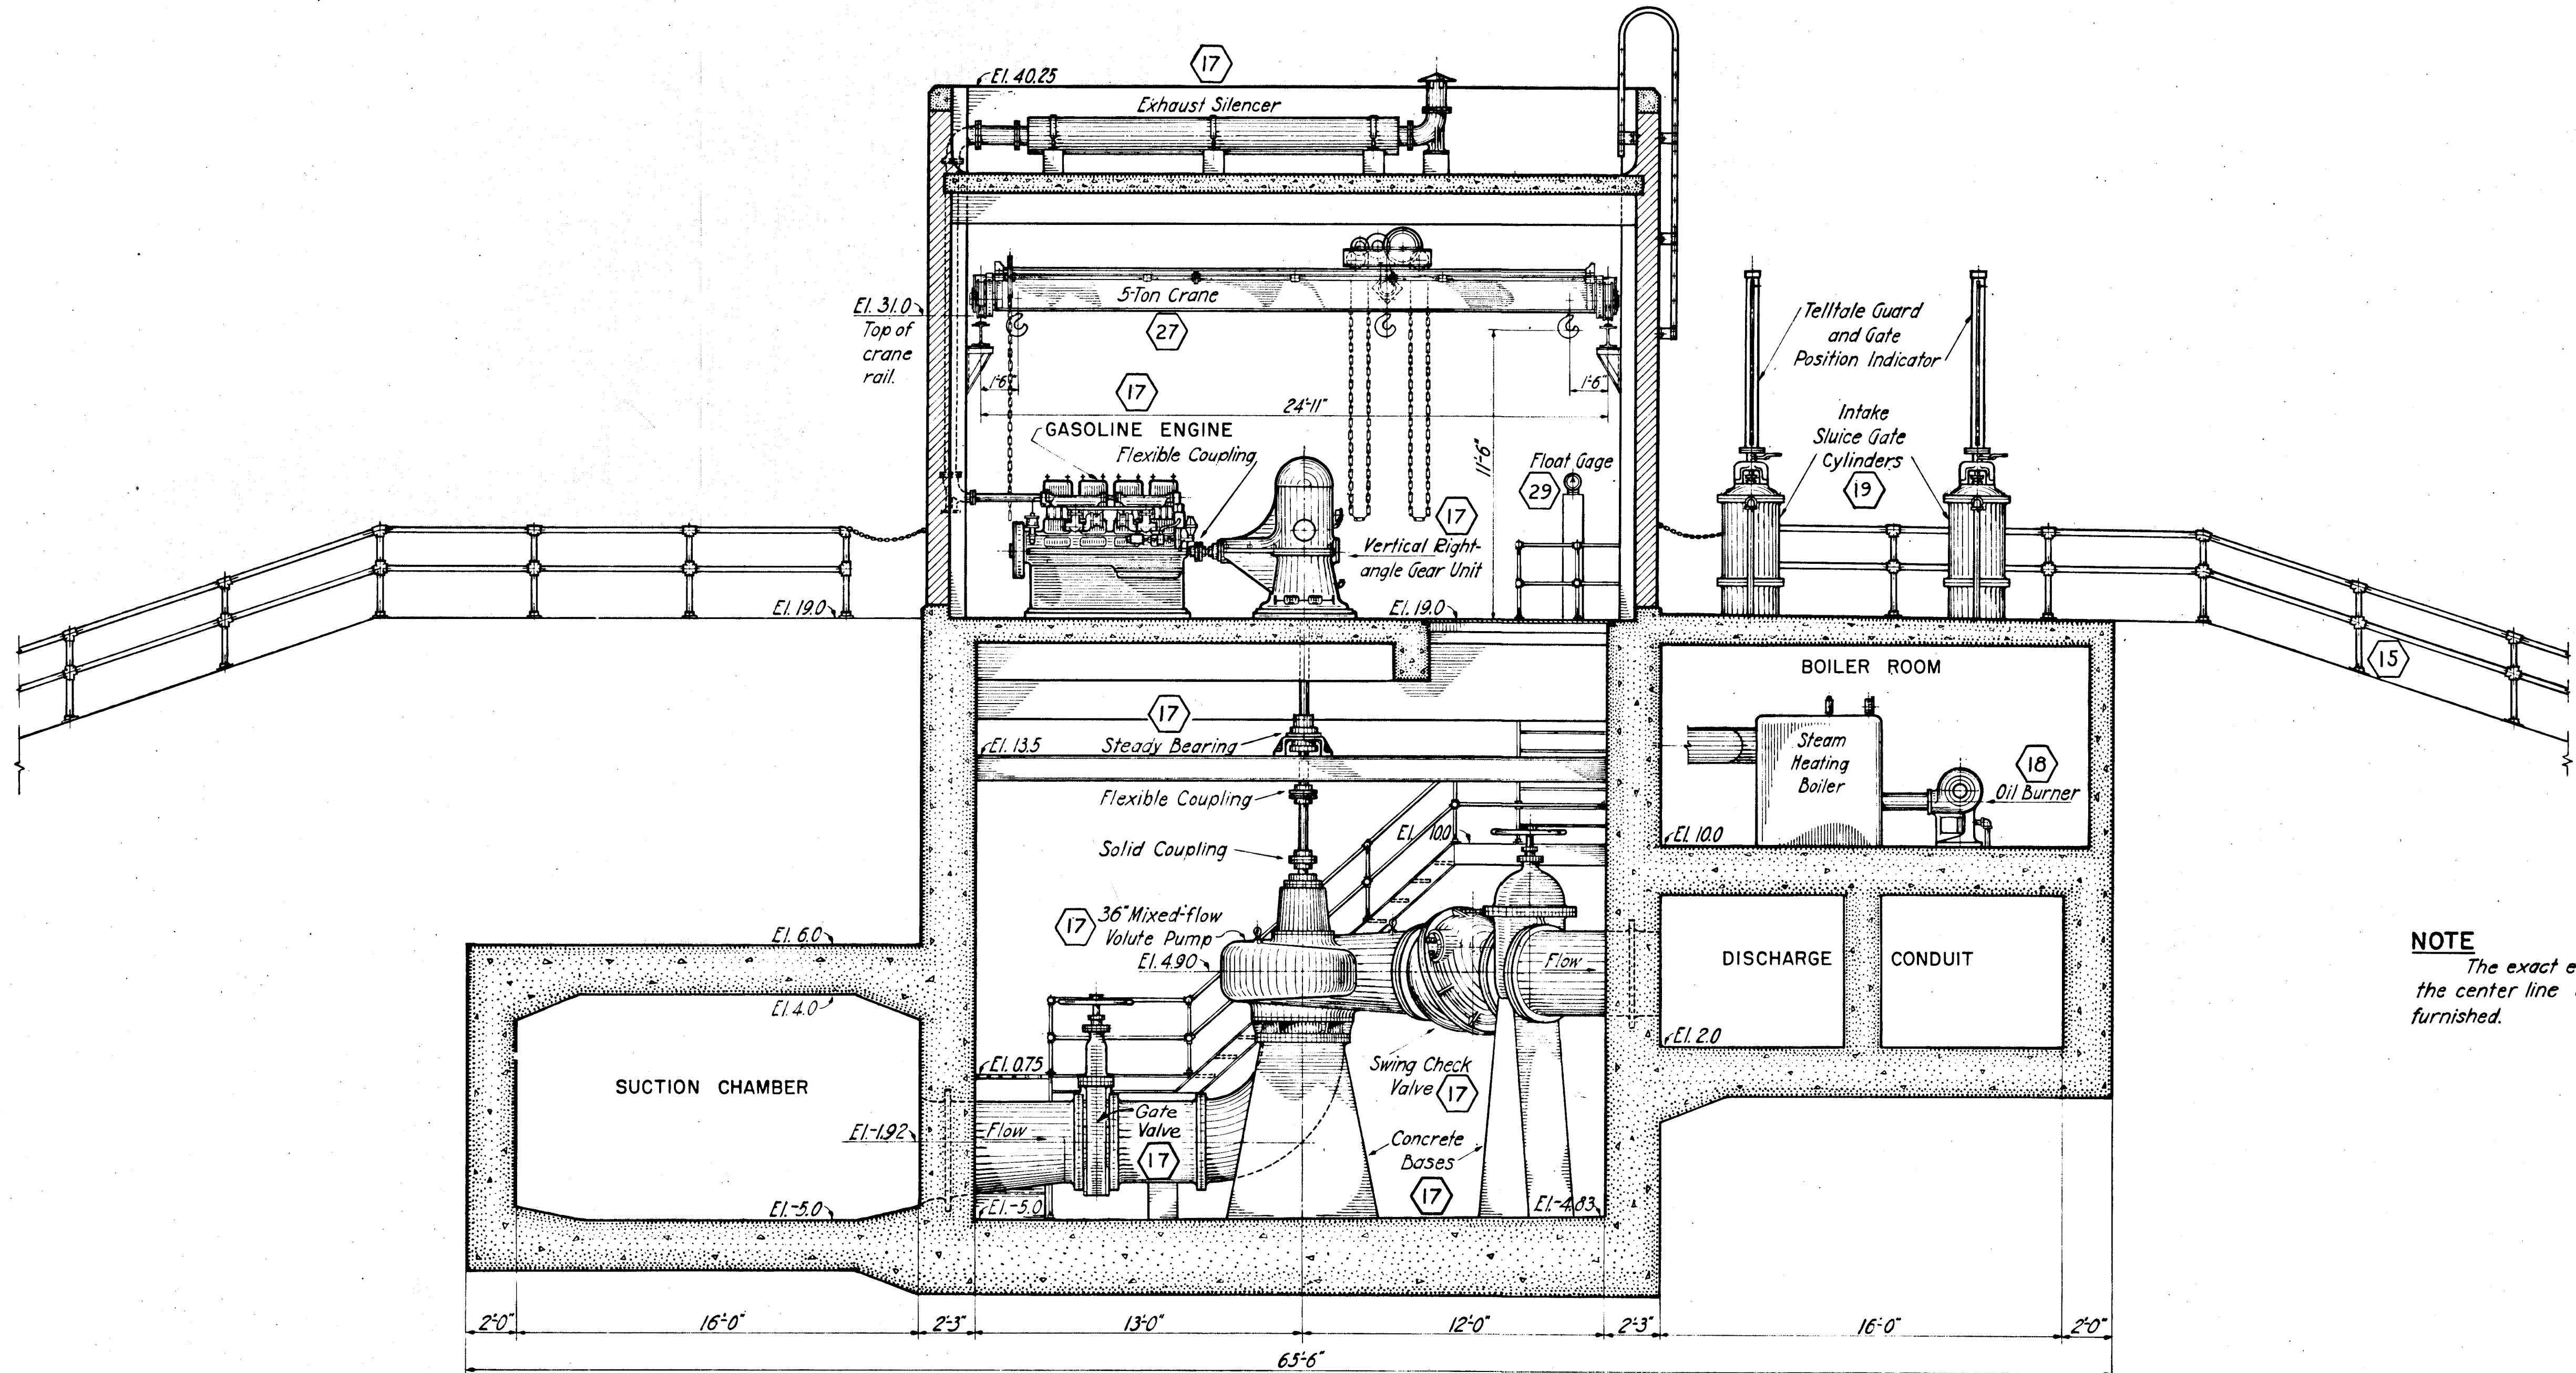

NOTE
The exact elevation of the steady bearing and the center line of the pump shall suit the equipment furnished.

SECTION A
45
SCALE 1/4" = 1'-0"

12-31-45	As built revisions				
DATE	REVISION	REV.BY	CK.BY	AP.BY	

CONNECTICUT RIVER FLOOD CONTROL			
NORTH MEADOWS PUMPING STATION			
FISCAL YEAR 1939 SECTION			
GENERAL ARRANGEMENT OF EQUIPMENT NO. 3			
HARTFORD, CONN.			
CONNECTICUT RIVER		CONNECTICUT	
IN 62 SHEETS		SCALE: 1/4 IN. = 1 FT.	
U.S. ENGINEER OFFICE, PROVIDENCE, R.I.		FEB. 1939	
SUBMITTED: <i>David B. Nielsen</i>		APPROVED: <i>J. S. Buons</i>	
SENIOR ENGINEER		PRINCIPAL ENGINEER	
HEAD, DESIGN SECTION		CHIEF, F.C. ENGINEERING DIV.	
DESIGNED: <i>St. J. Knapp</i>		DRAWN BY: <i>O. F.</i>	
CHECKED BY: <i>S. R. L.</i>		FILE NO. CT-4-1295	