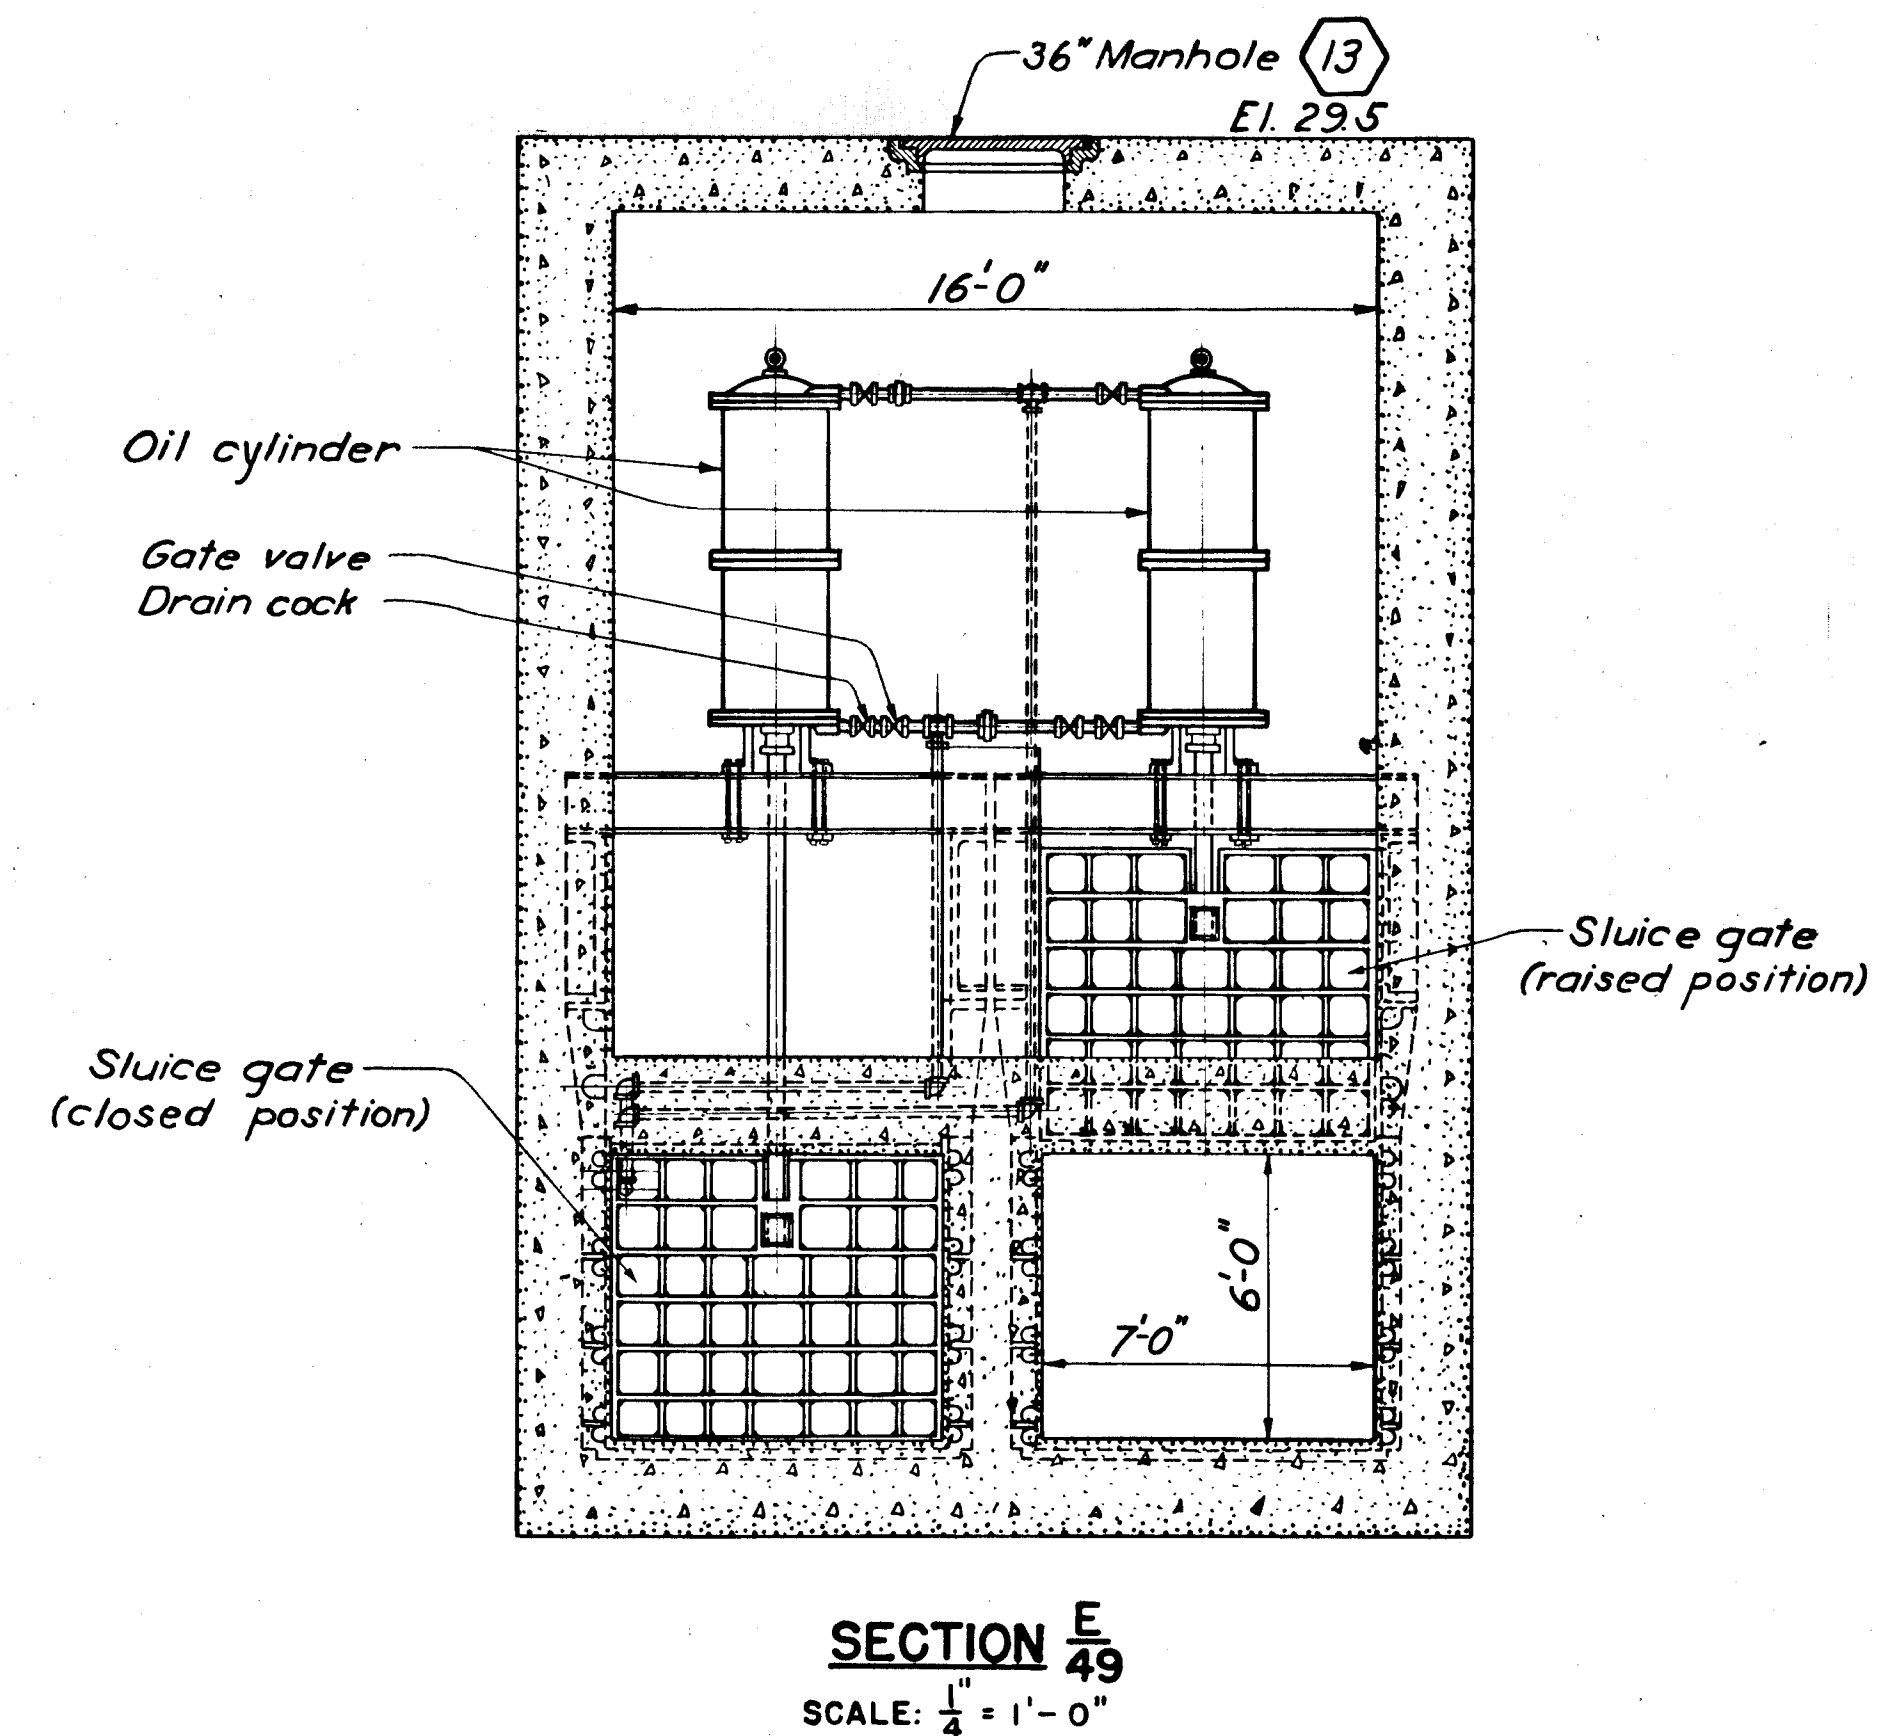
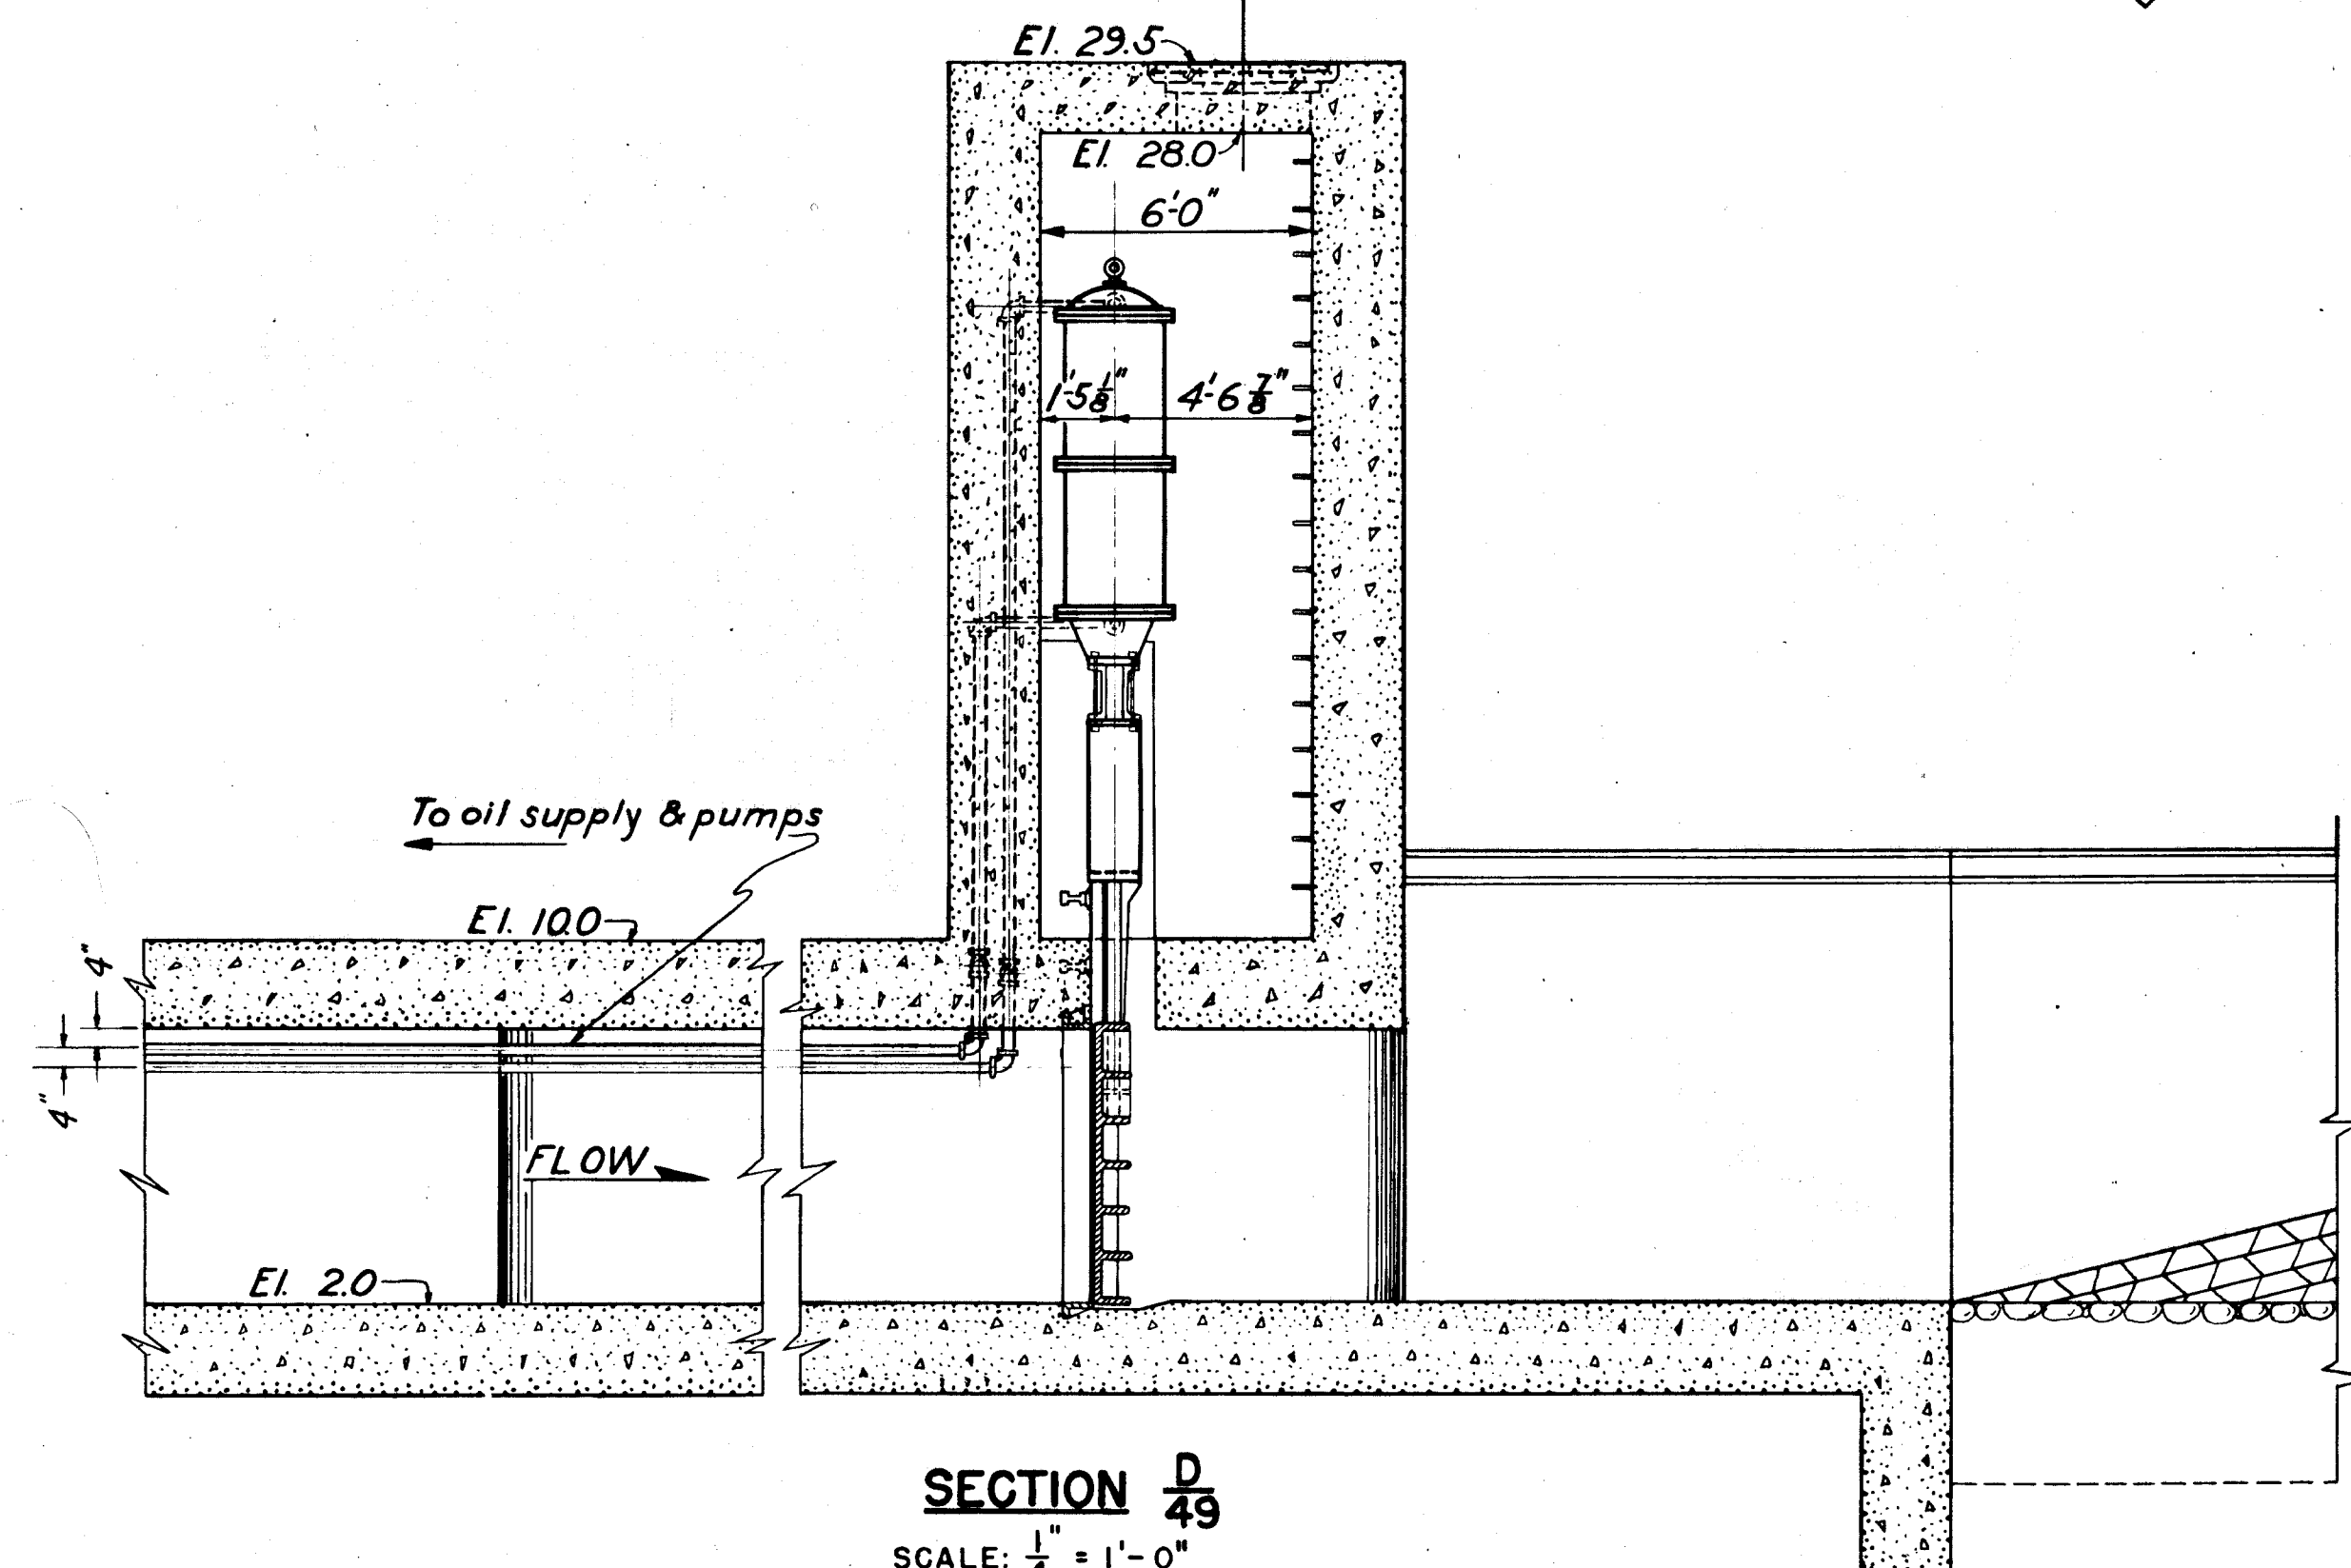
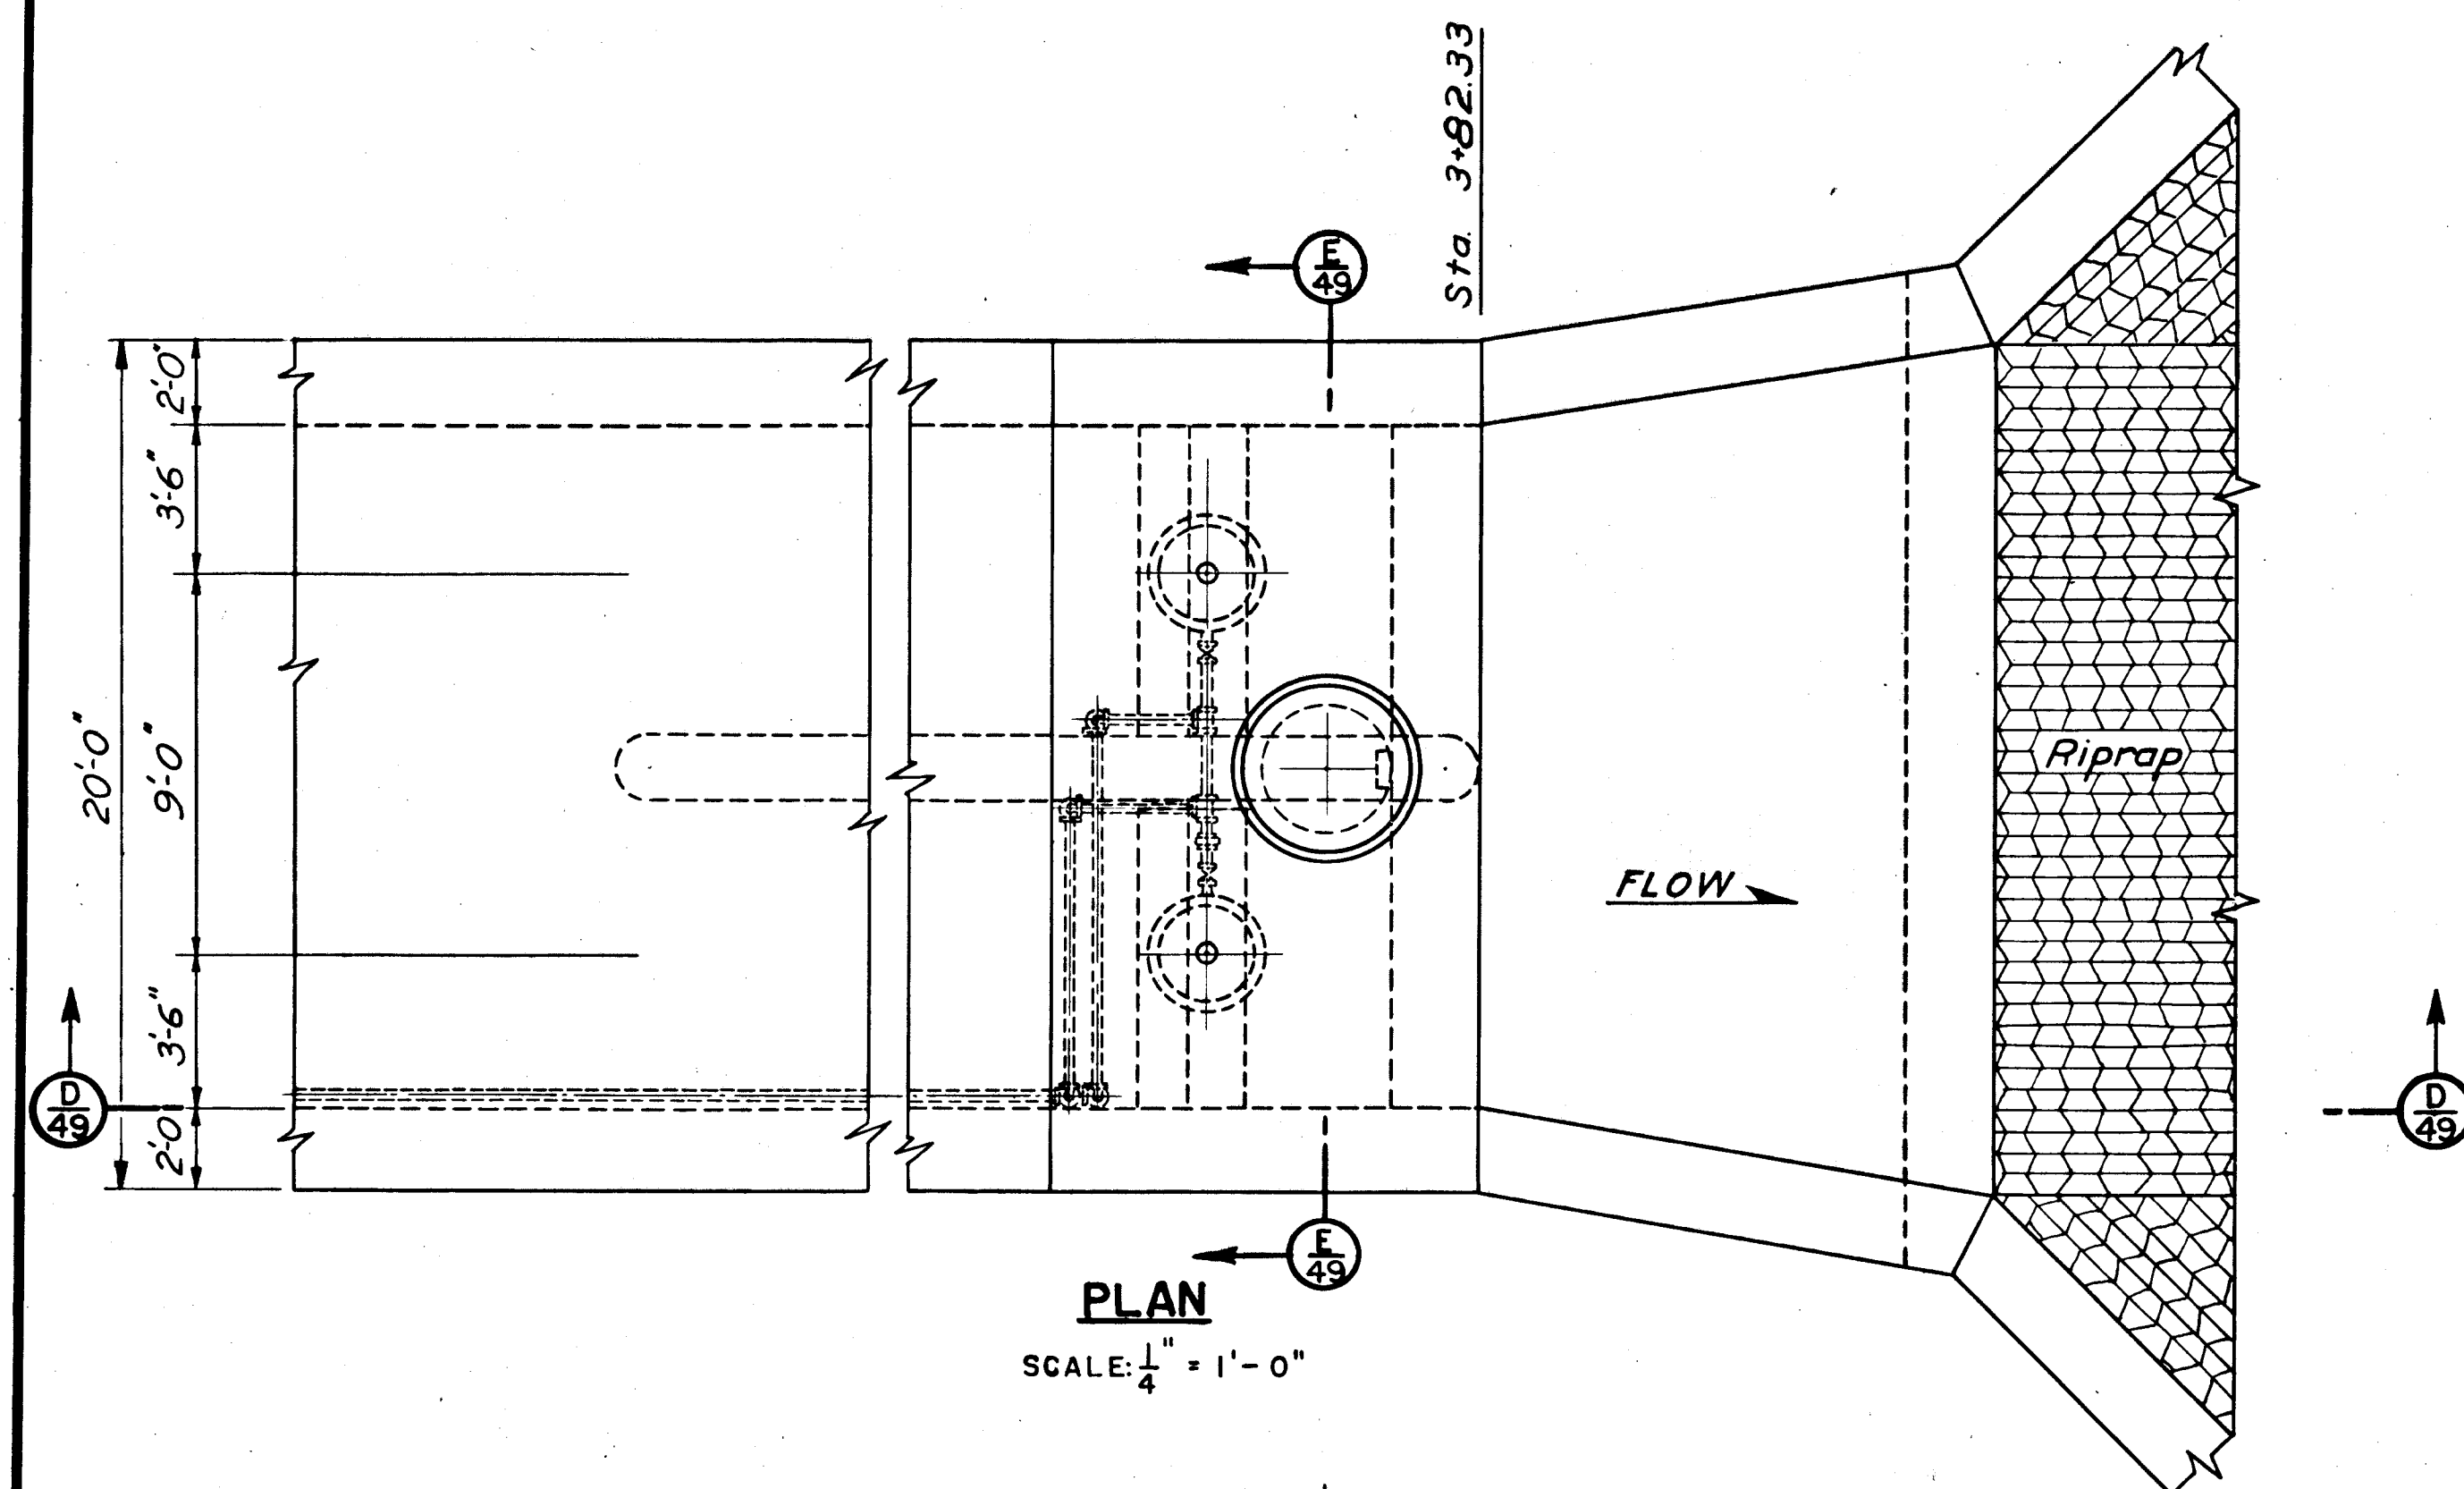


**NOTES:**

- All pipe to be 2" extra strong wrought iron.
- All fittings to be heavy malleable iron.
- See sheet No. 50 for piping from oil pump.
- See sheet No. 48 for piping to gates on intake end of conduit.
- No telltale rod is to be provided on outlet sluice gates. Gates to be supported in the open position by safety links.
- Piping shall be supported by hangers spaced at 10 foot intervals.
- Furnishing and installing sluice gates and oil piping will be paid for under Item No. 19.

CONNECTICUT RIVER FLOOD CONTROL	
NORTH MEADOWS PUMPING STATION	
FISCAL YEAR 1939 SECTION	
OUTLET SLUICE GATES	
CONNECTICUT RIVER	HARTFORD, CONN.
IN 62 SHEETS	SCALE: 1/4" = 1 FT.
5	10
SHEET NO. 49	
U.S. ENGINEER OFFICE, PROVIDENCE, R.I., FEB. 1939	
SUBMITTED:	APPROVAL RECOMMENDED: APPROVED:
DESIGNED BY: <i>H. A. H.</i>	PRINCIPAL ENGINEER: <i>H. A. H.</i>
HEAD, DESIGN SECTION	CHIEF, C.E. ENGINEERING DIV.
DESIGNED BY: <i>H. A. H.</i>	DRAWN BY: <i>A. A. H.</i>
ASSOC. ENGINEER	TRACED BY: <i>H. M. Z.</i>
	CHECKED BY: <i>S. R. K.</i>
FILE NO. CT-4-1297	

DATE	REVISION	REV BY	CK BY	AP BY
12-31-45	As built revisions			