

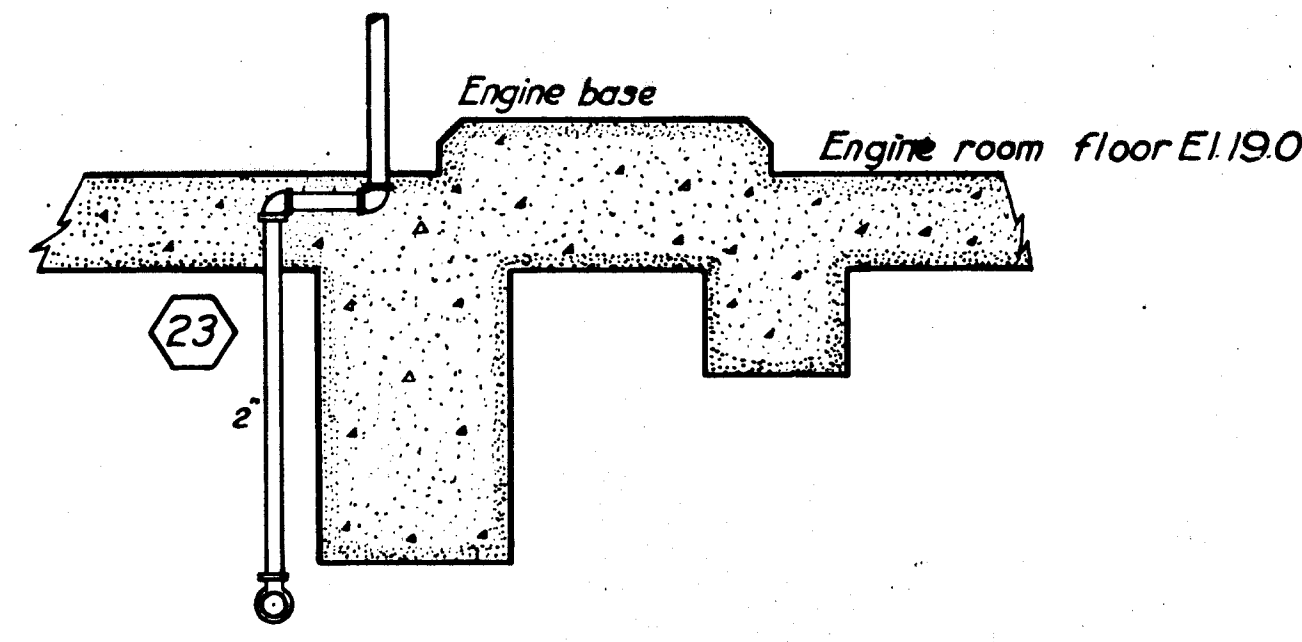


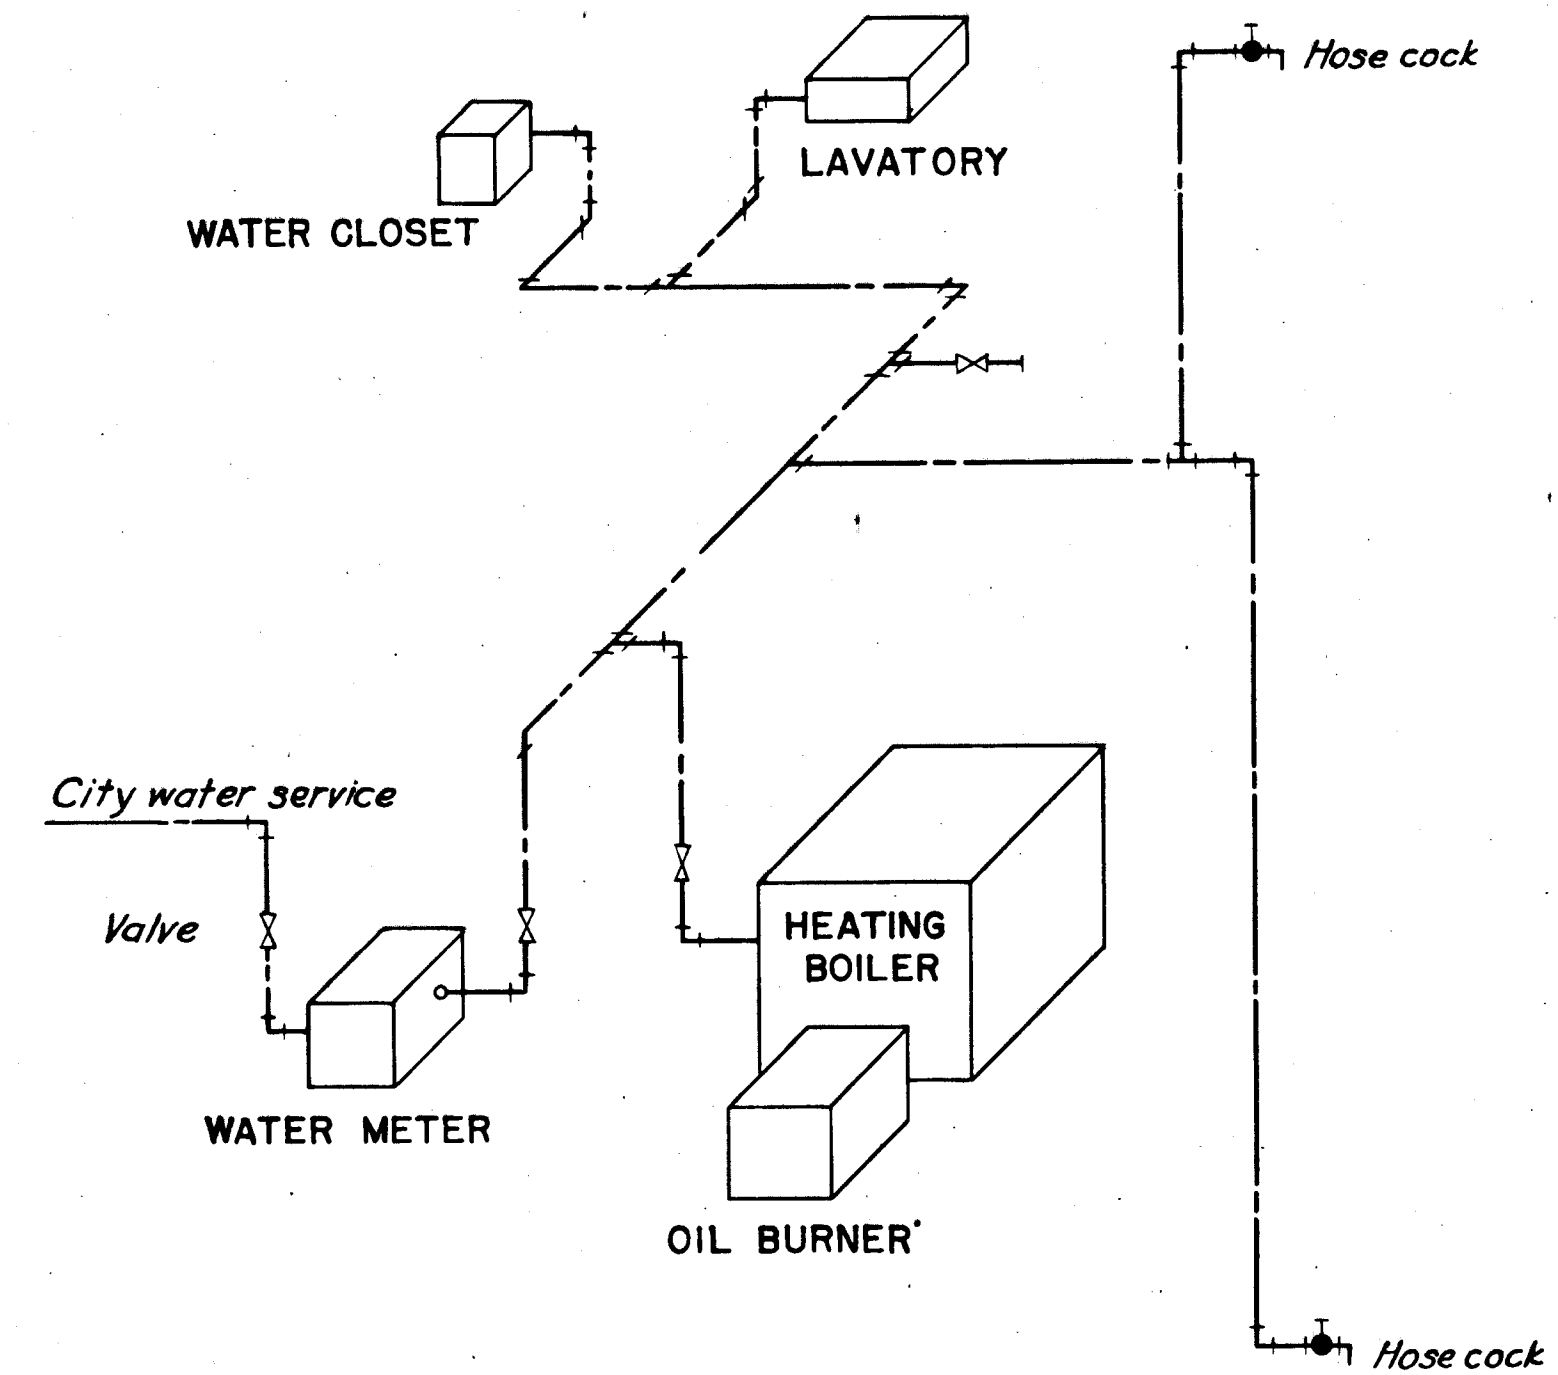


METHOD OF OFFSETTING WATER AND WASTE AT ENGINES
SCALE 1/2" = 1'-0"

METHOD OF VENTILATING
PUMP ROOM
SCALE 1/2" = 1'-0"

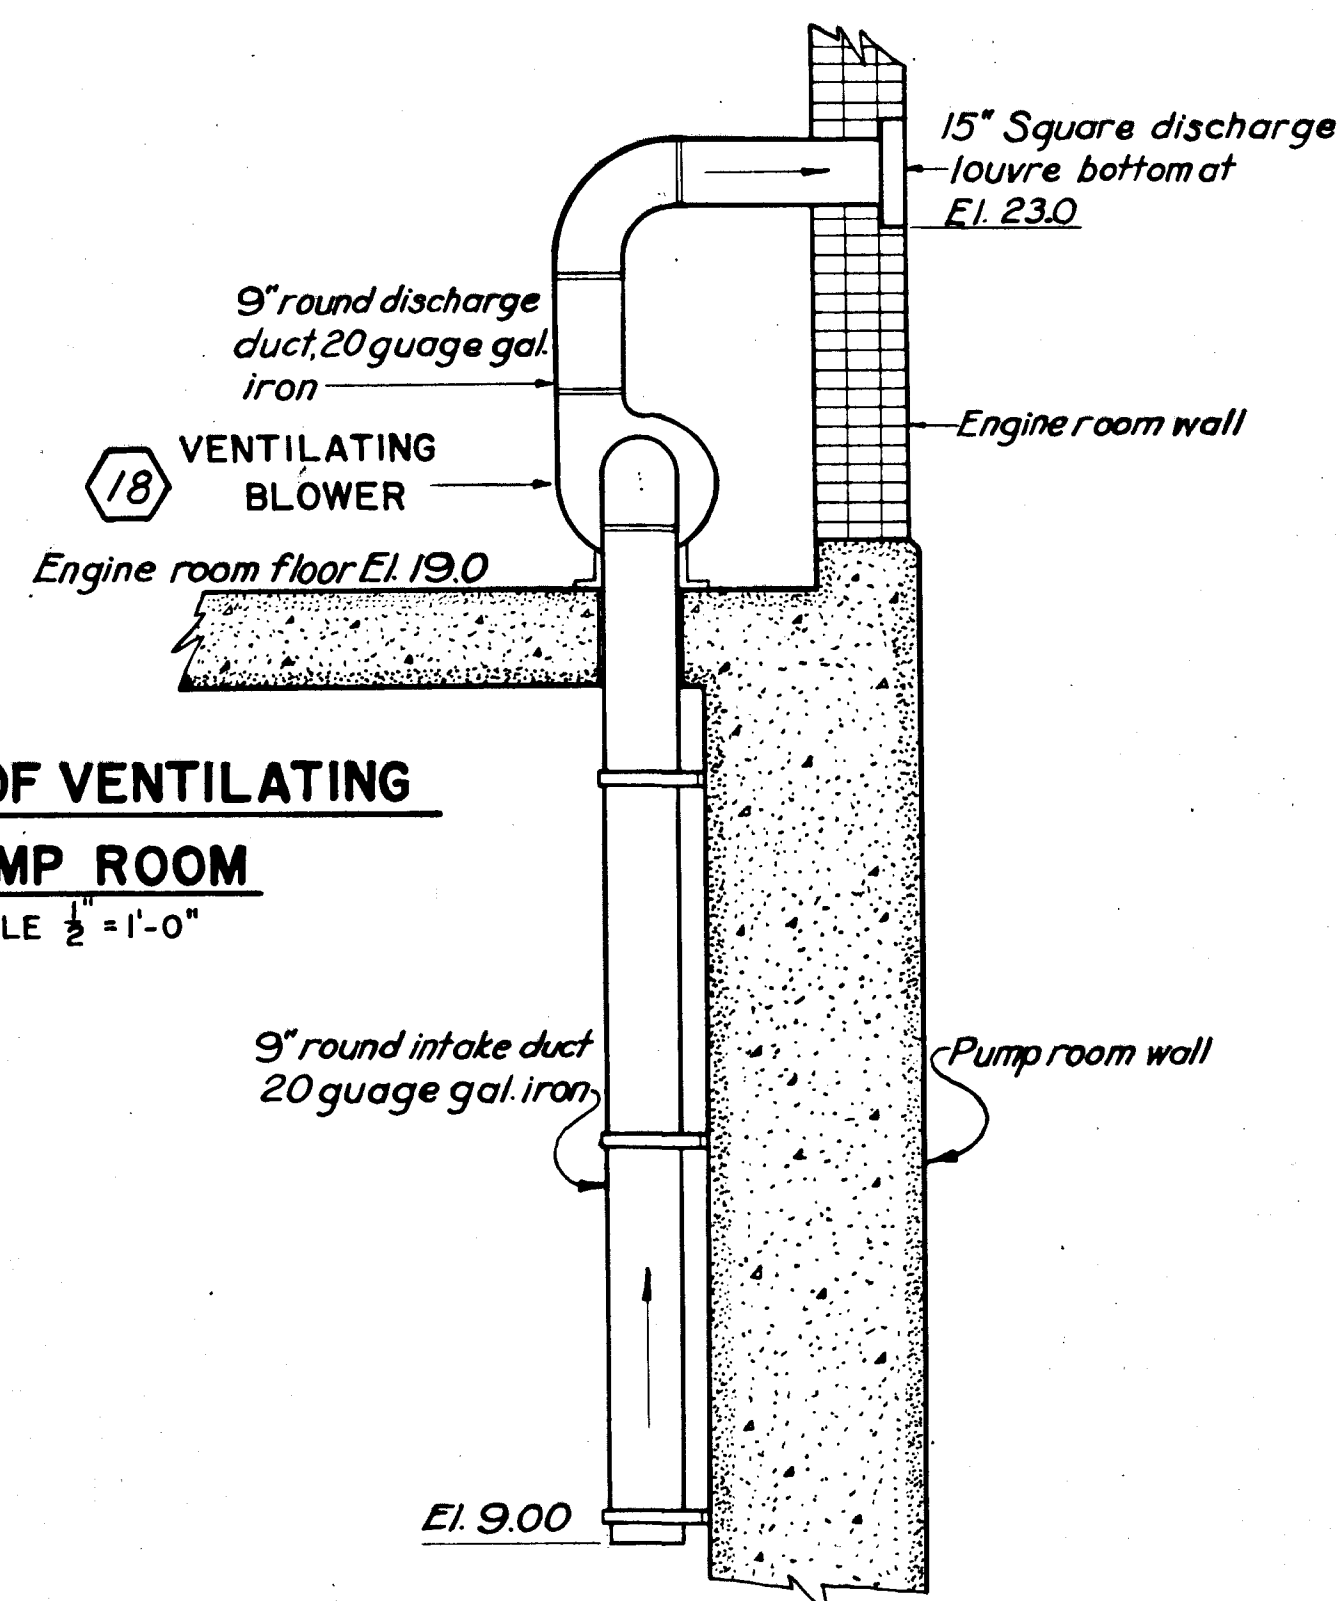

CITY WATER PIPING
NO SCALE

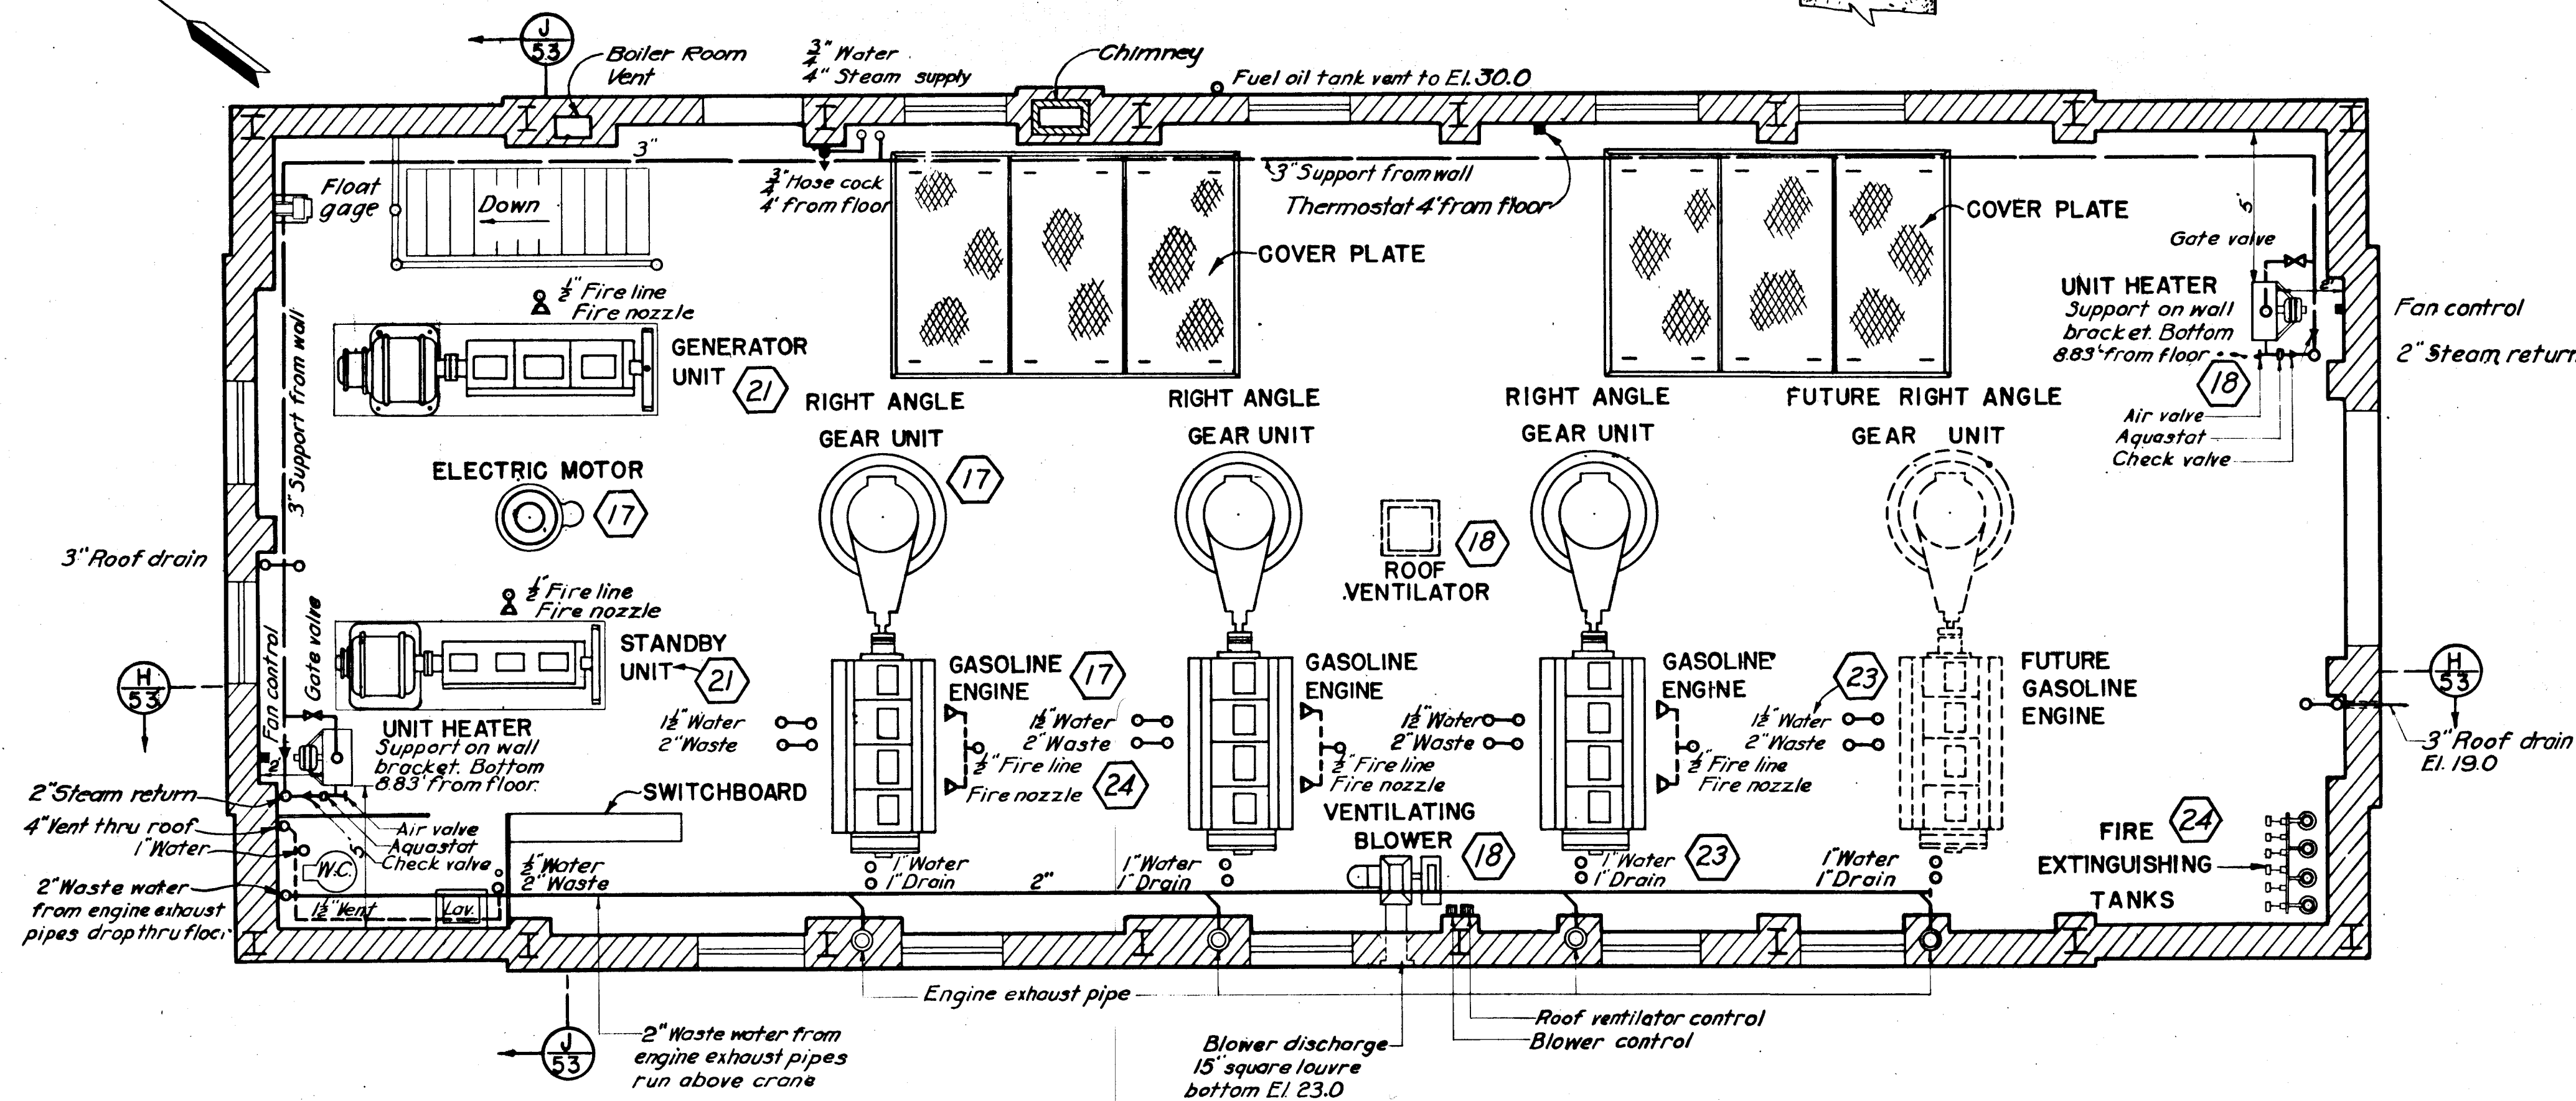

ENGINE ROOM
SCALE 1/4" = 1'-0"

LEGEND

- Steam supply
- Steam return
- City water
- Valve
- Fire line

NOTE

Furnishing and installing heating and ventilating equipment will be paid for under Item No. 18.
All piping in the heating system shall have one inch magnesia covering with an eight ounce canvas jacket sewed on.
Piping shall be supported by hangers spaced at 10 foot intervals.
Piping is shown diagrammatically. The exact location shall suit the equipment furnished.
All piping thru floors shall be set in sleeves. All piping thru outside walls shall be set in sleeves and caulked with lead.
Sleeves for waste and cooling water serving future installed engine, shall be placed by contractor.
See sheet No. 53 for vertical location of pipes.
All pipe lines to pitch so that lines will drain.

CONNECTICUT RIVER FLOOD CONTROL			
NORTH MEADOWS PUMPING STATION			
FISCAL YEAR 1939 SECTION			
PLUMBING AND HEATING NO. 1			
HARTFORD, CONN.			
CONNECTICUT RIVER		CONNECTICUT	
IN 62 SHEETS		SCALE 1/4 IN. = 1 FT.	
SHEET NO. 51			
U.S. ENGINEER OFFICE, PROVIDENCE, R.I., FEB. 1939			
SUBMITTED		APPROVAL RECOMMENDED	
DESIGNED		DRAWN BY	
CHECKED BY		FILE NO	

12/31/45	As built				
DATE	REVISION	REVBY	CK BY	AP BY	