
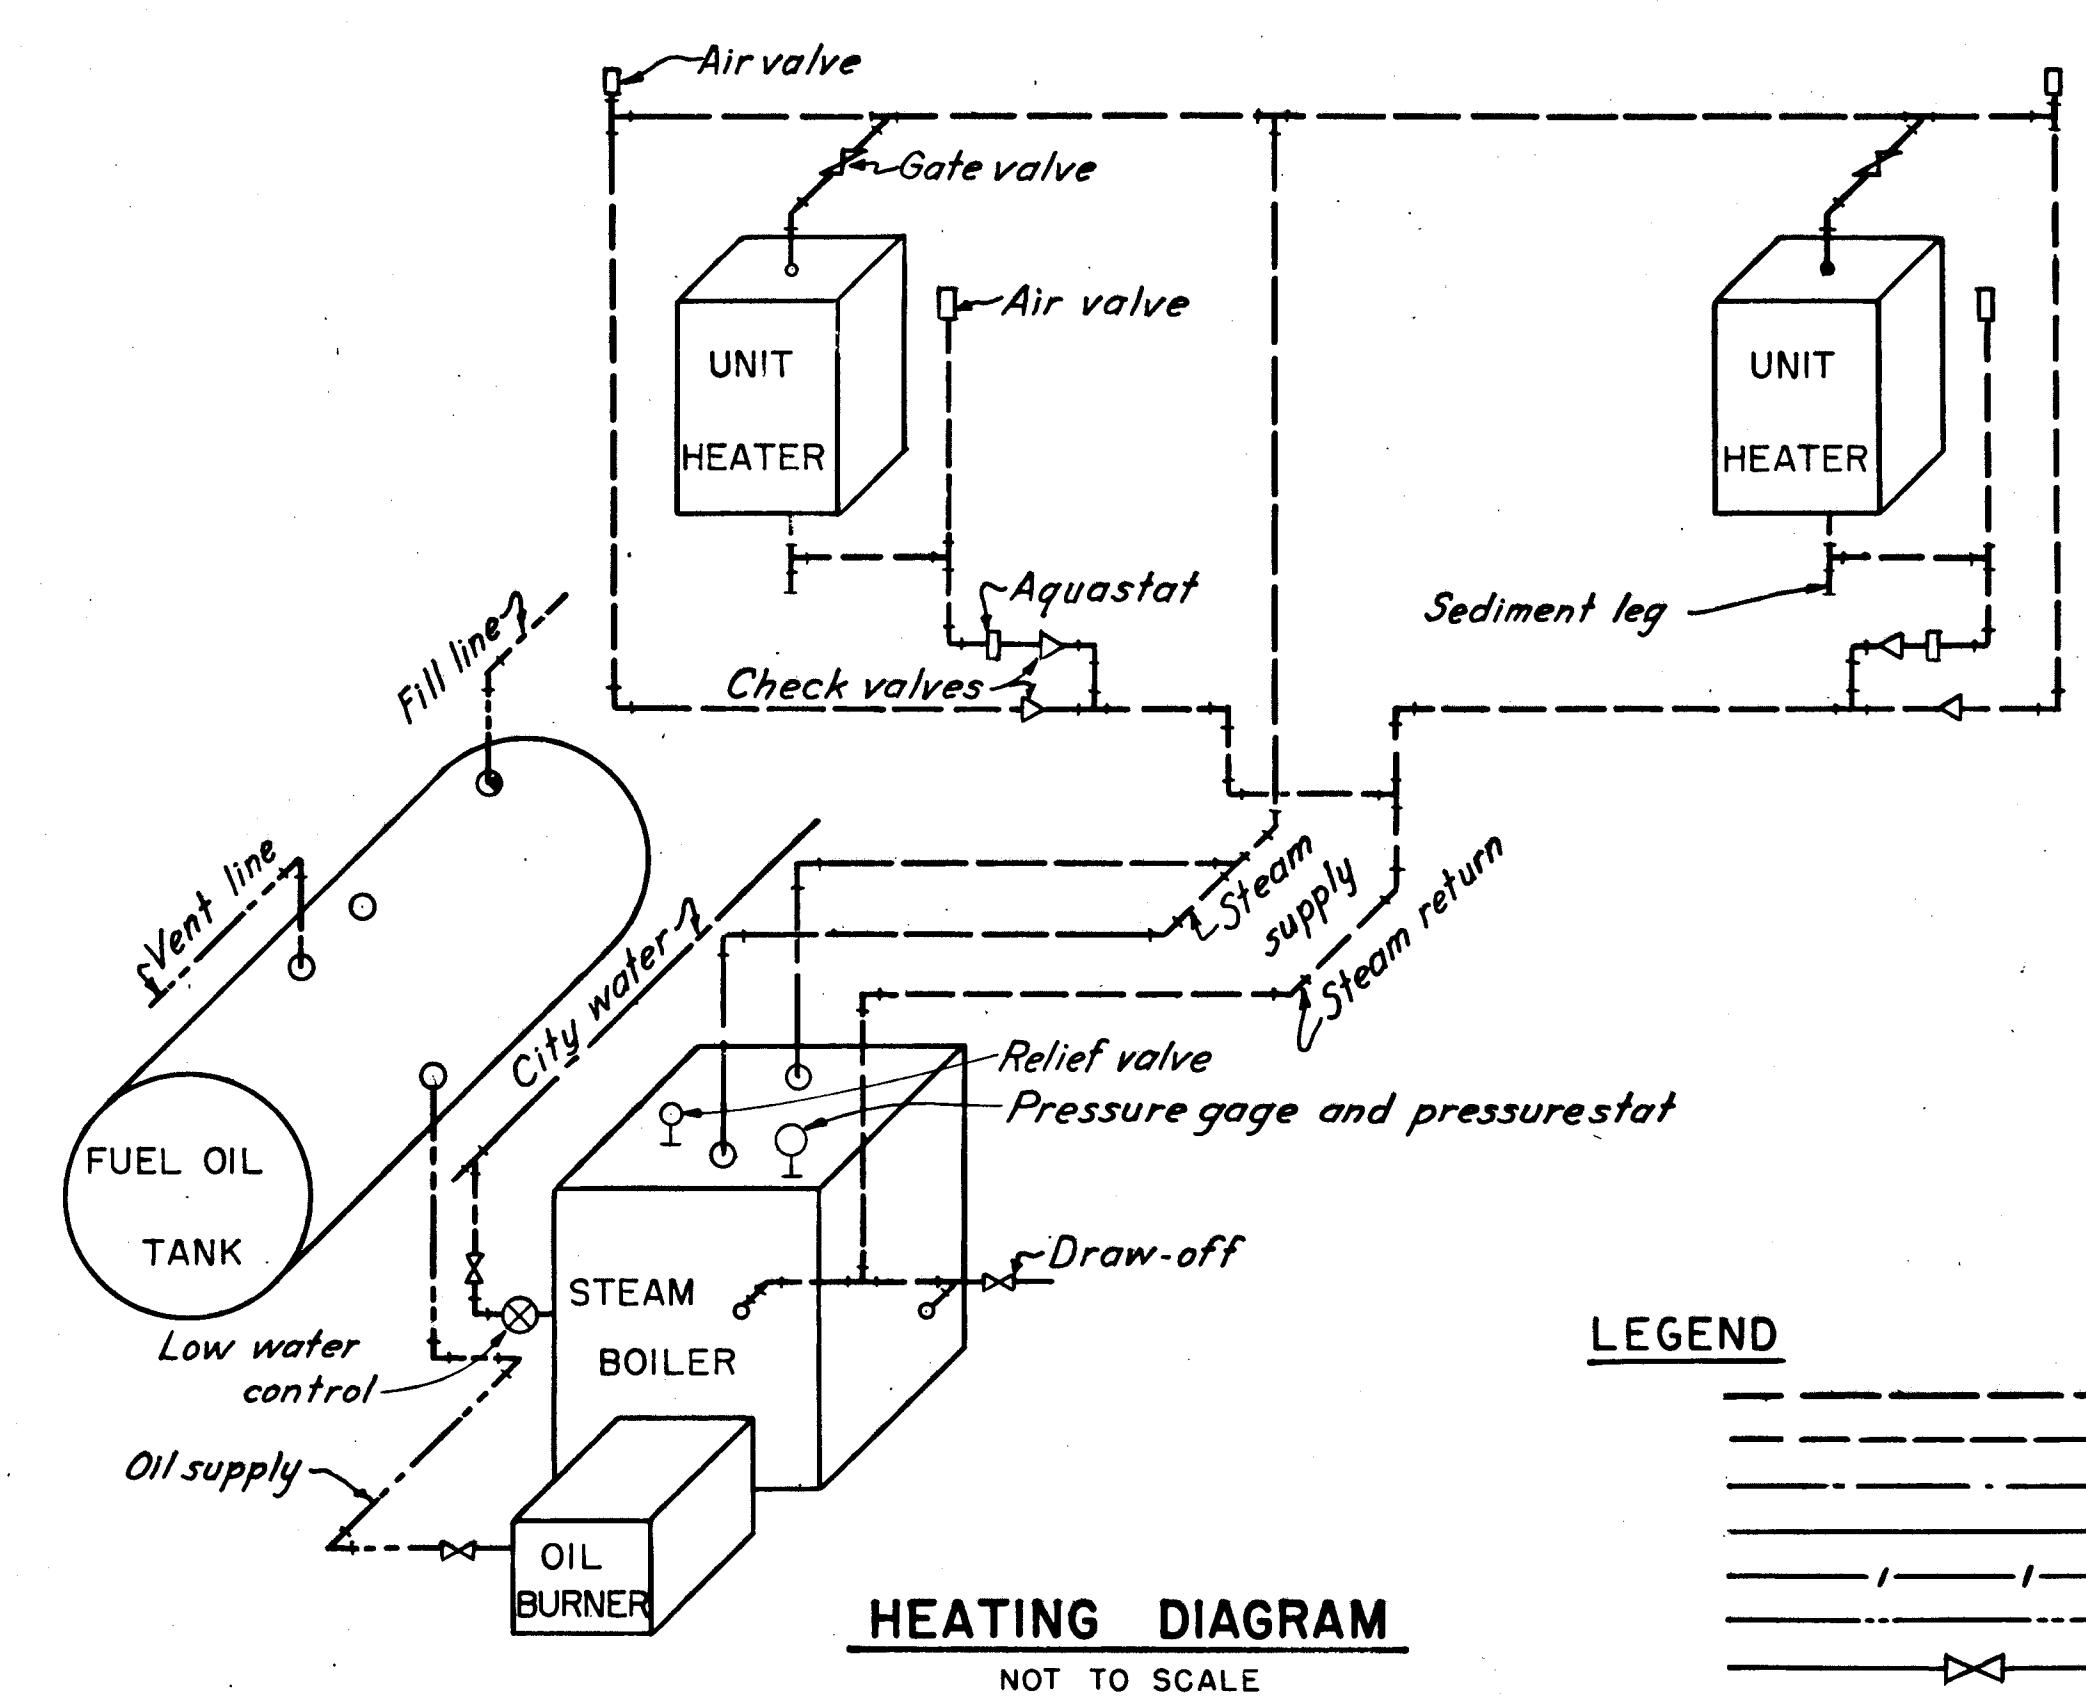


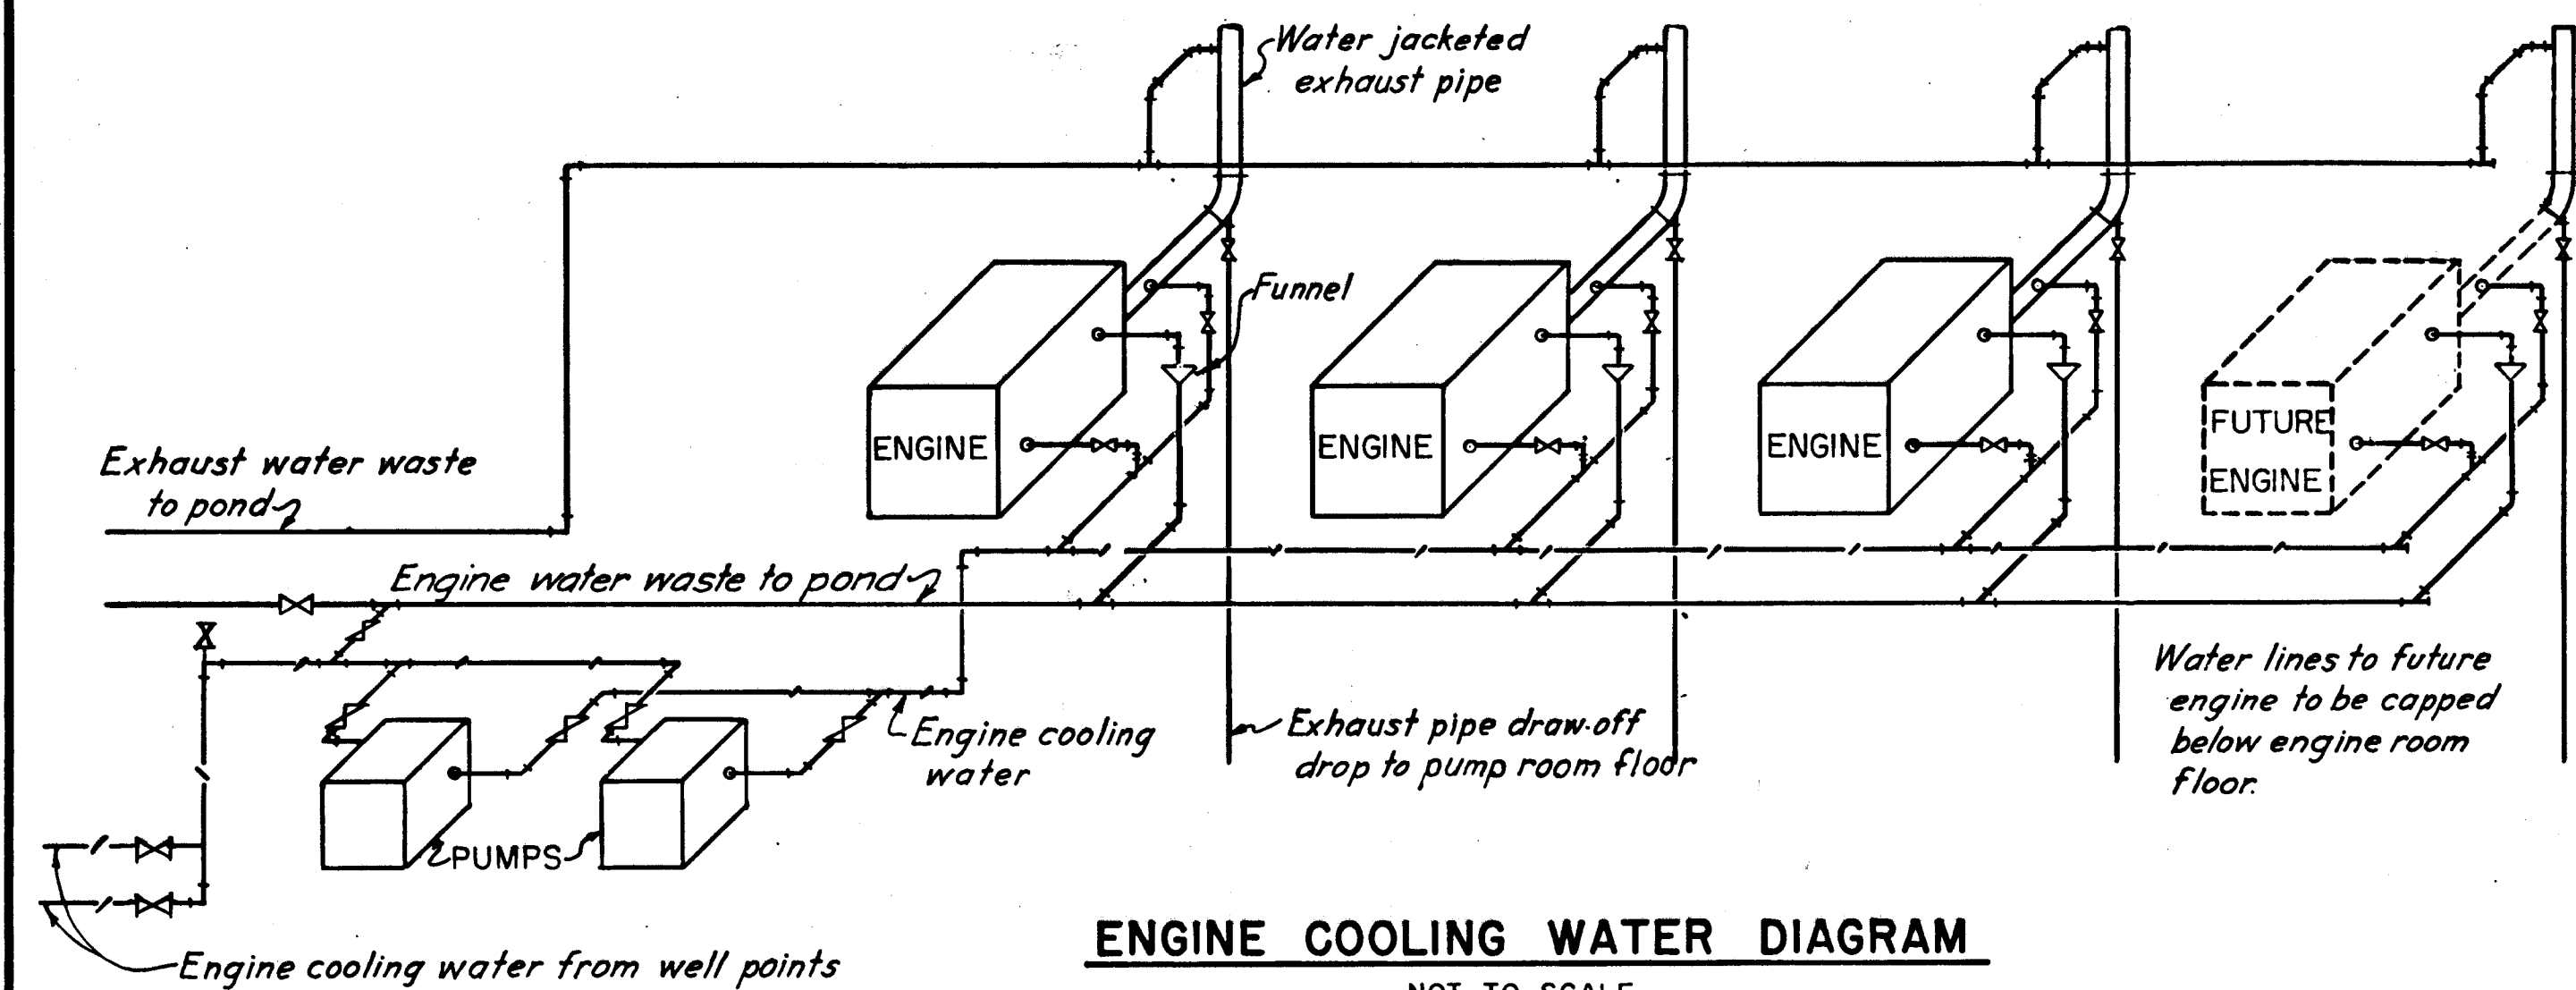

- LEGEND
- Steam supply
 - Steam return
 - City water
 - Waste
 - Cooling water
 - Fuel supply
 - Valve
 - Fire line

NOTE

Piping is shown diagrammatically, the exact location shall suit the equipment furnished.

All piping thru floors shall be set in sleeves, all piping thru outside walls shall be set in sleeves and caulked with lead.


Sleeves for waste and cooling water serving future installed engine shall be placed by the contractor.

See Sheet No.53 for vertical location of pipe lines.

All pipes to pitch so that lines will drain.

Piping shall be supported by hangers spaced at 10 foot intervals.

All piping in the heating system shall have a one inch magnesia covering with an eight ounce canvas jacket sewed on.

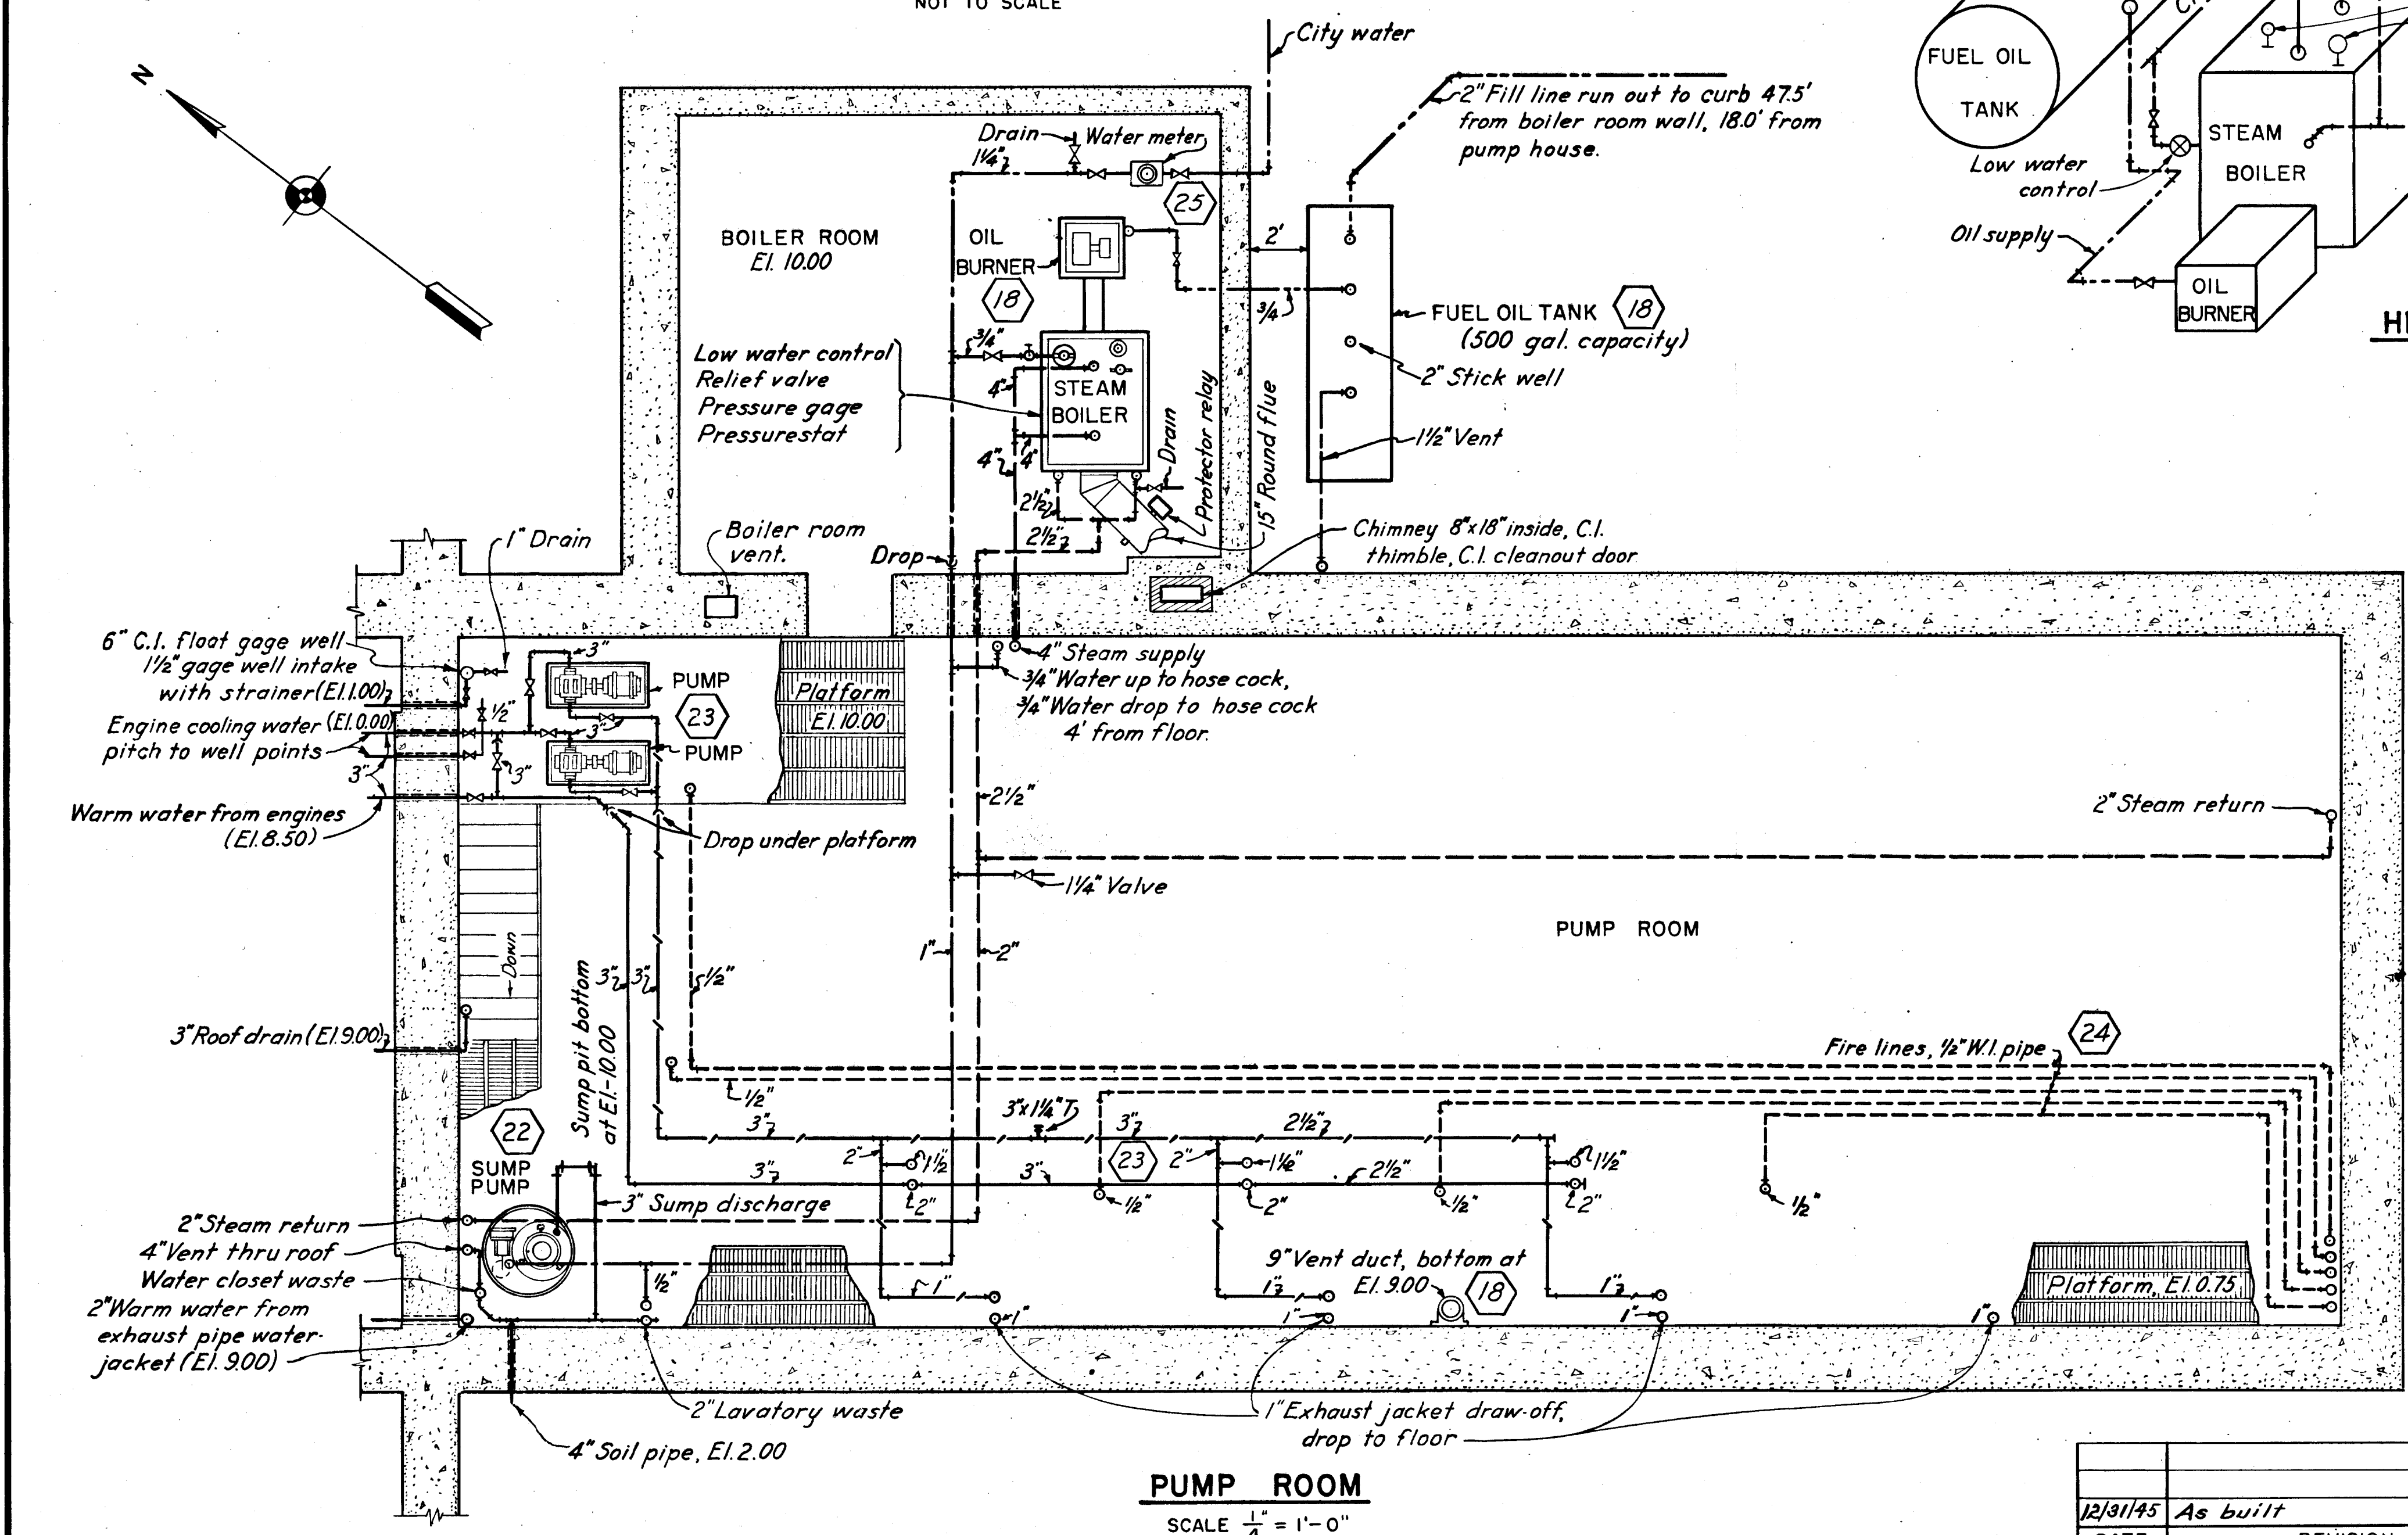

12/31/45	As built				
DATE	REVISION	REV. BY	CK. BY	AP. BY	

CONNECTICUT RIVER FLOOD CONTROL		
NORTH MEADOWS PUMPING STATION		
FISCAL YEAR 1939 SECTION		
PLUMBING AND HEATING NO. 2		
HARTFORD, CONN.		
CONNECTICUT RIVER		CONNECTICUT
IN 62 SHEETS	SCALE: 1/4 IN. = 1 FT.	SHEET NO. 52
U. S. ENGINEER OFFICE, PROVIDENCE, R.I., FEB. 1939		
SUBMITTED:	APPROVAL RECOMMENDED:	APPROVED:
HEAD DESIGN SECTION	PRINCIPAL ENGINEER	LOCAL CORPS OF ENGINEERS
DESIGNED	CHIEF, F.C. ENGINEERING DIV.	DISTRICT ENGINEER
DRAWN BY J.J.S.	TRACED BY J.M.C.	FILE NO. CT-4-1300
CHECKED BY S.R.L.		