


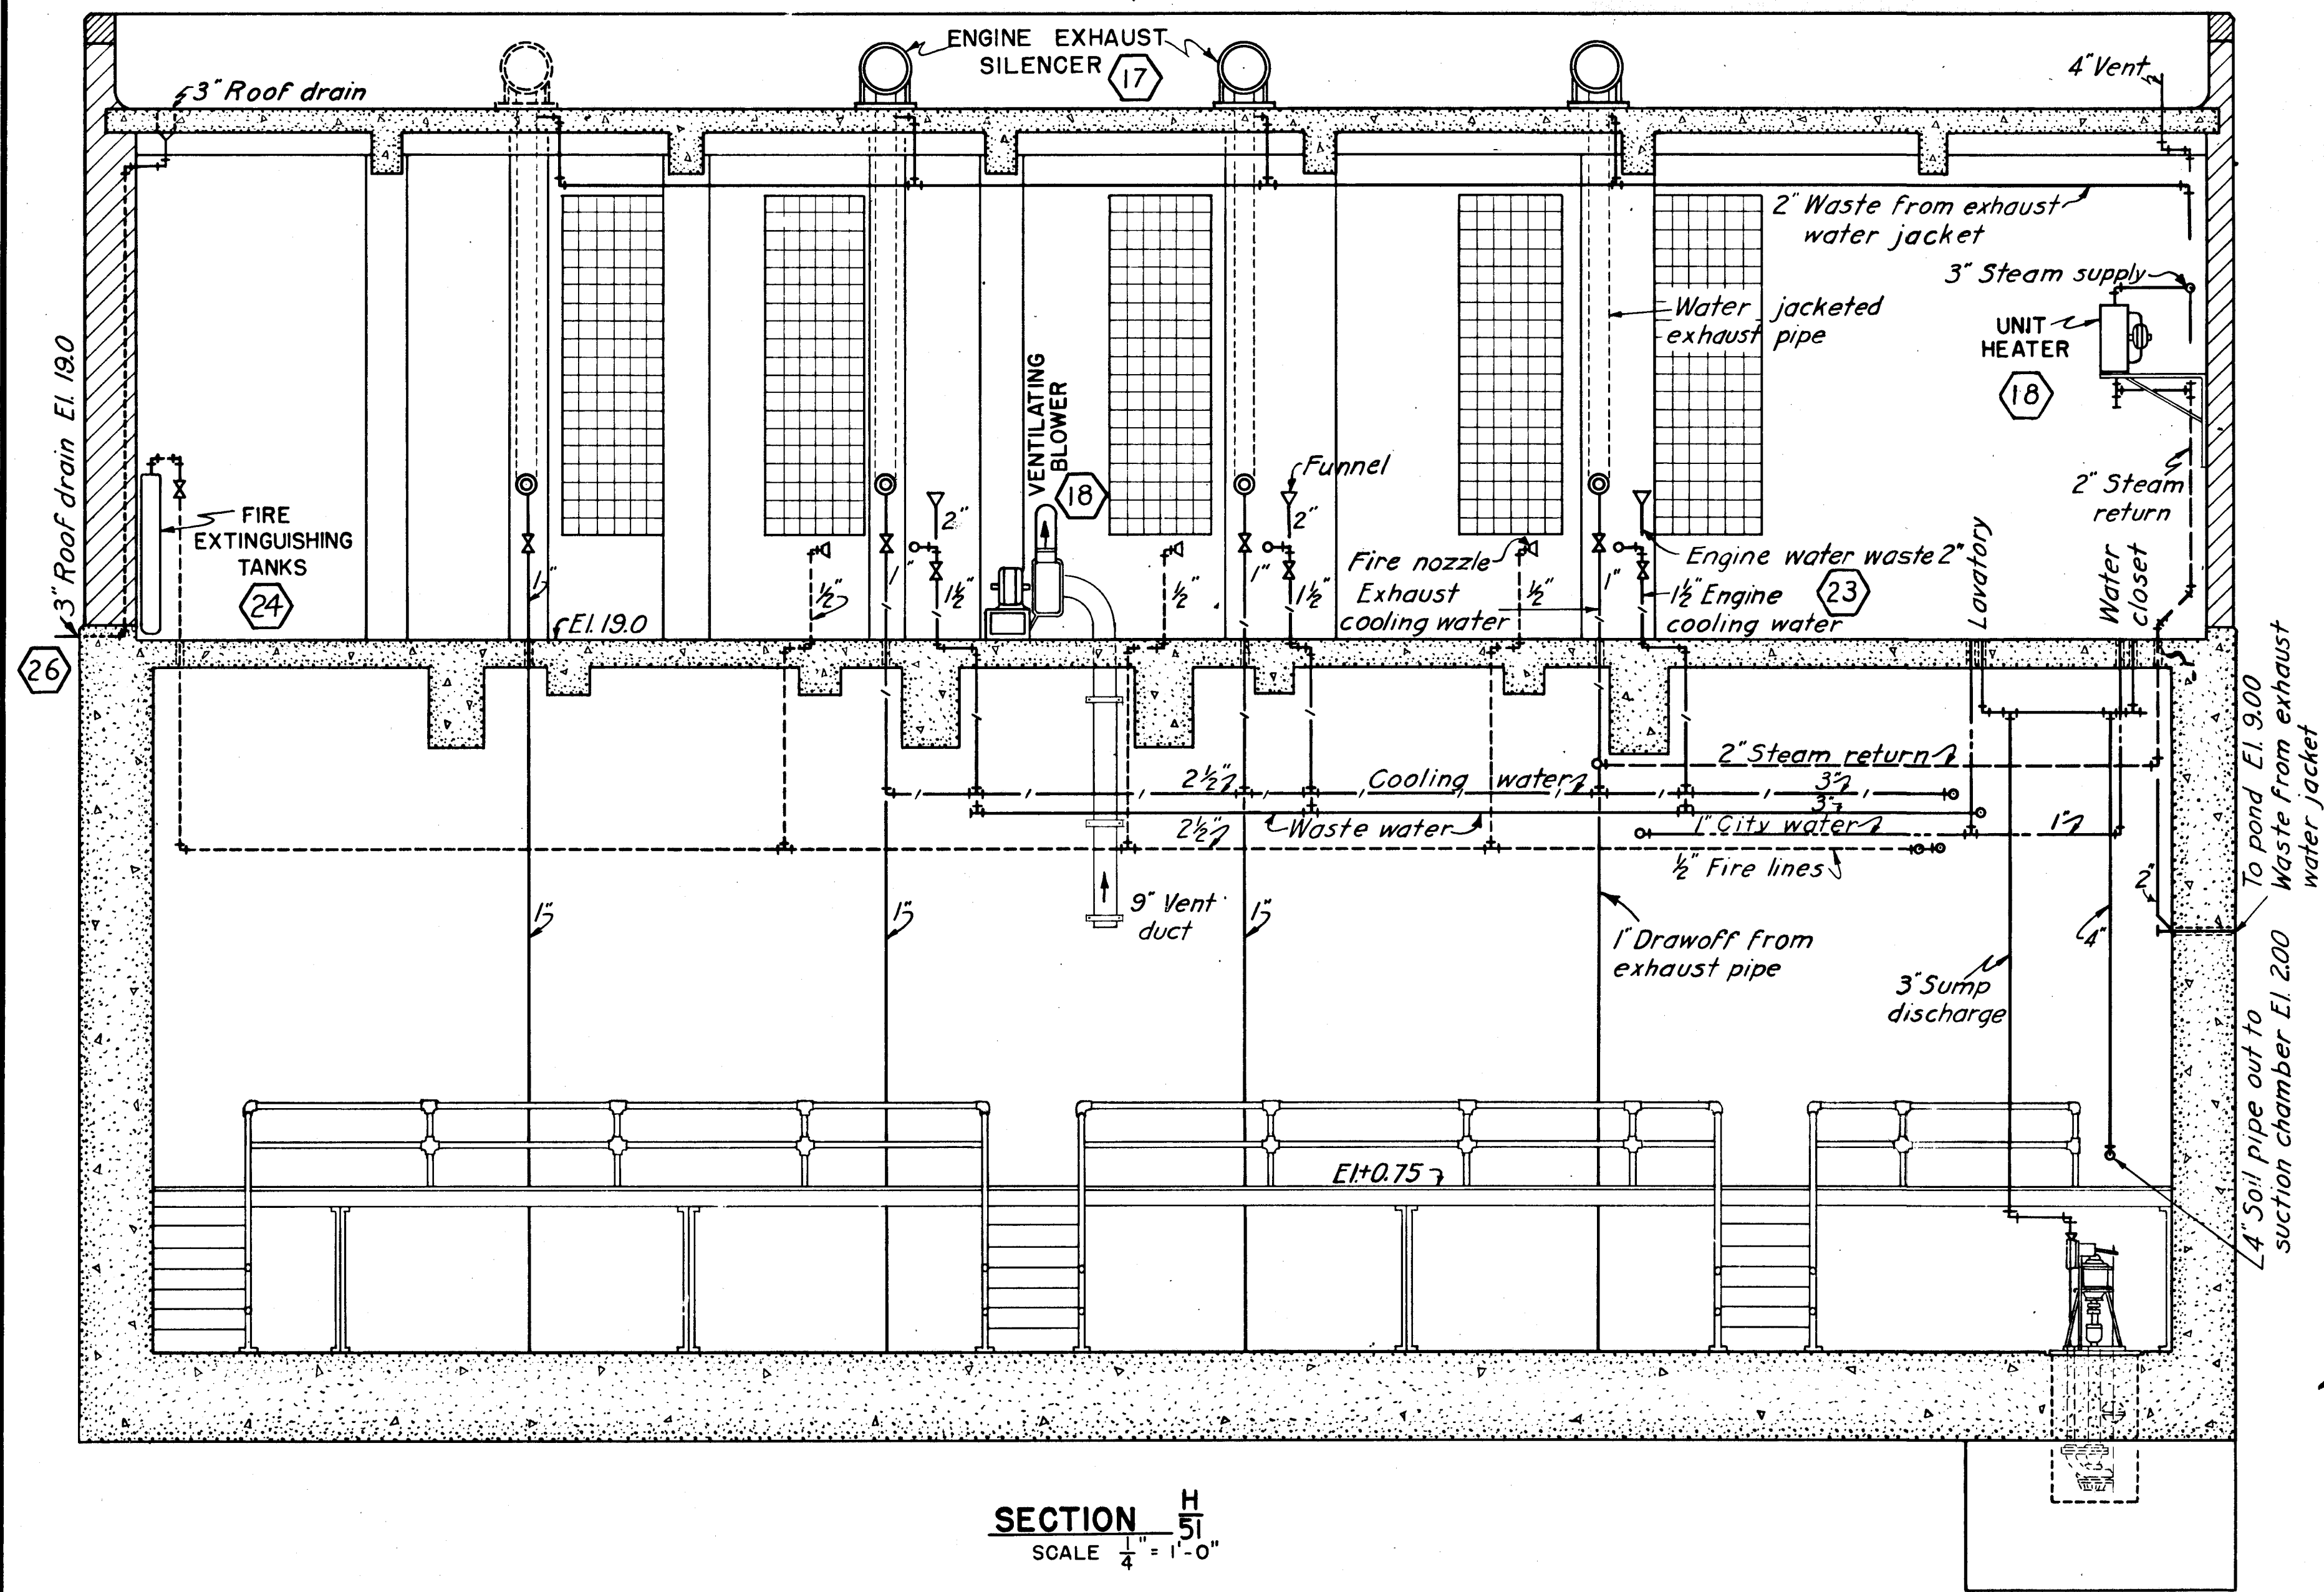


SECTION $\frac{H}{51}$
SCALE $\frac{1}{4}'' = 1'-0''$

LEGEND:

- Steam Supply
- - - - - Steam Return
- City Water
- Waste
- Cooling Water
- Fire Line
- Valve

NOTE:

Piping is shown diagrammatically. The exact location shall suit the equipment furnished. All lines to pitch so that lines will drain. See Sheets No. 51 & 52 for horizontal location of pipe lines. All piping thru floors shall be set in sleeves, all piping thru outside walls shall be set in sleeves and caulked with lead. Piping shall be supported by hangers spaced at 10 foot intervals.

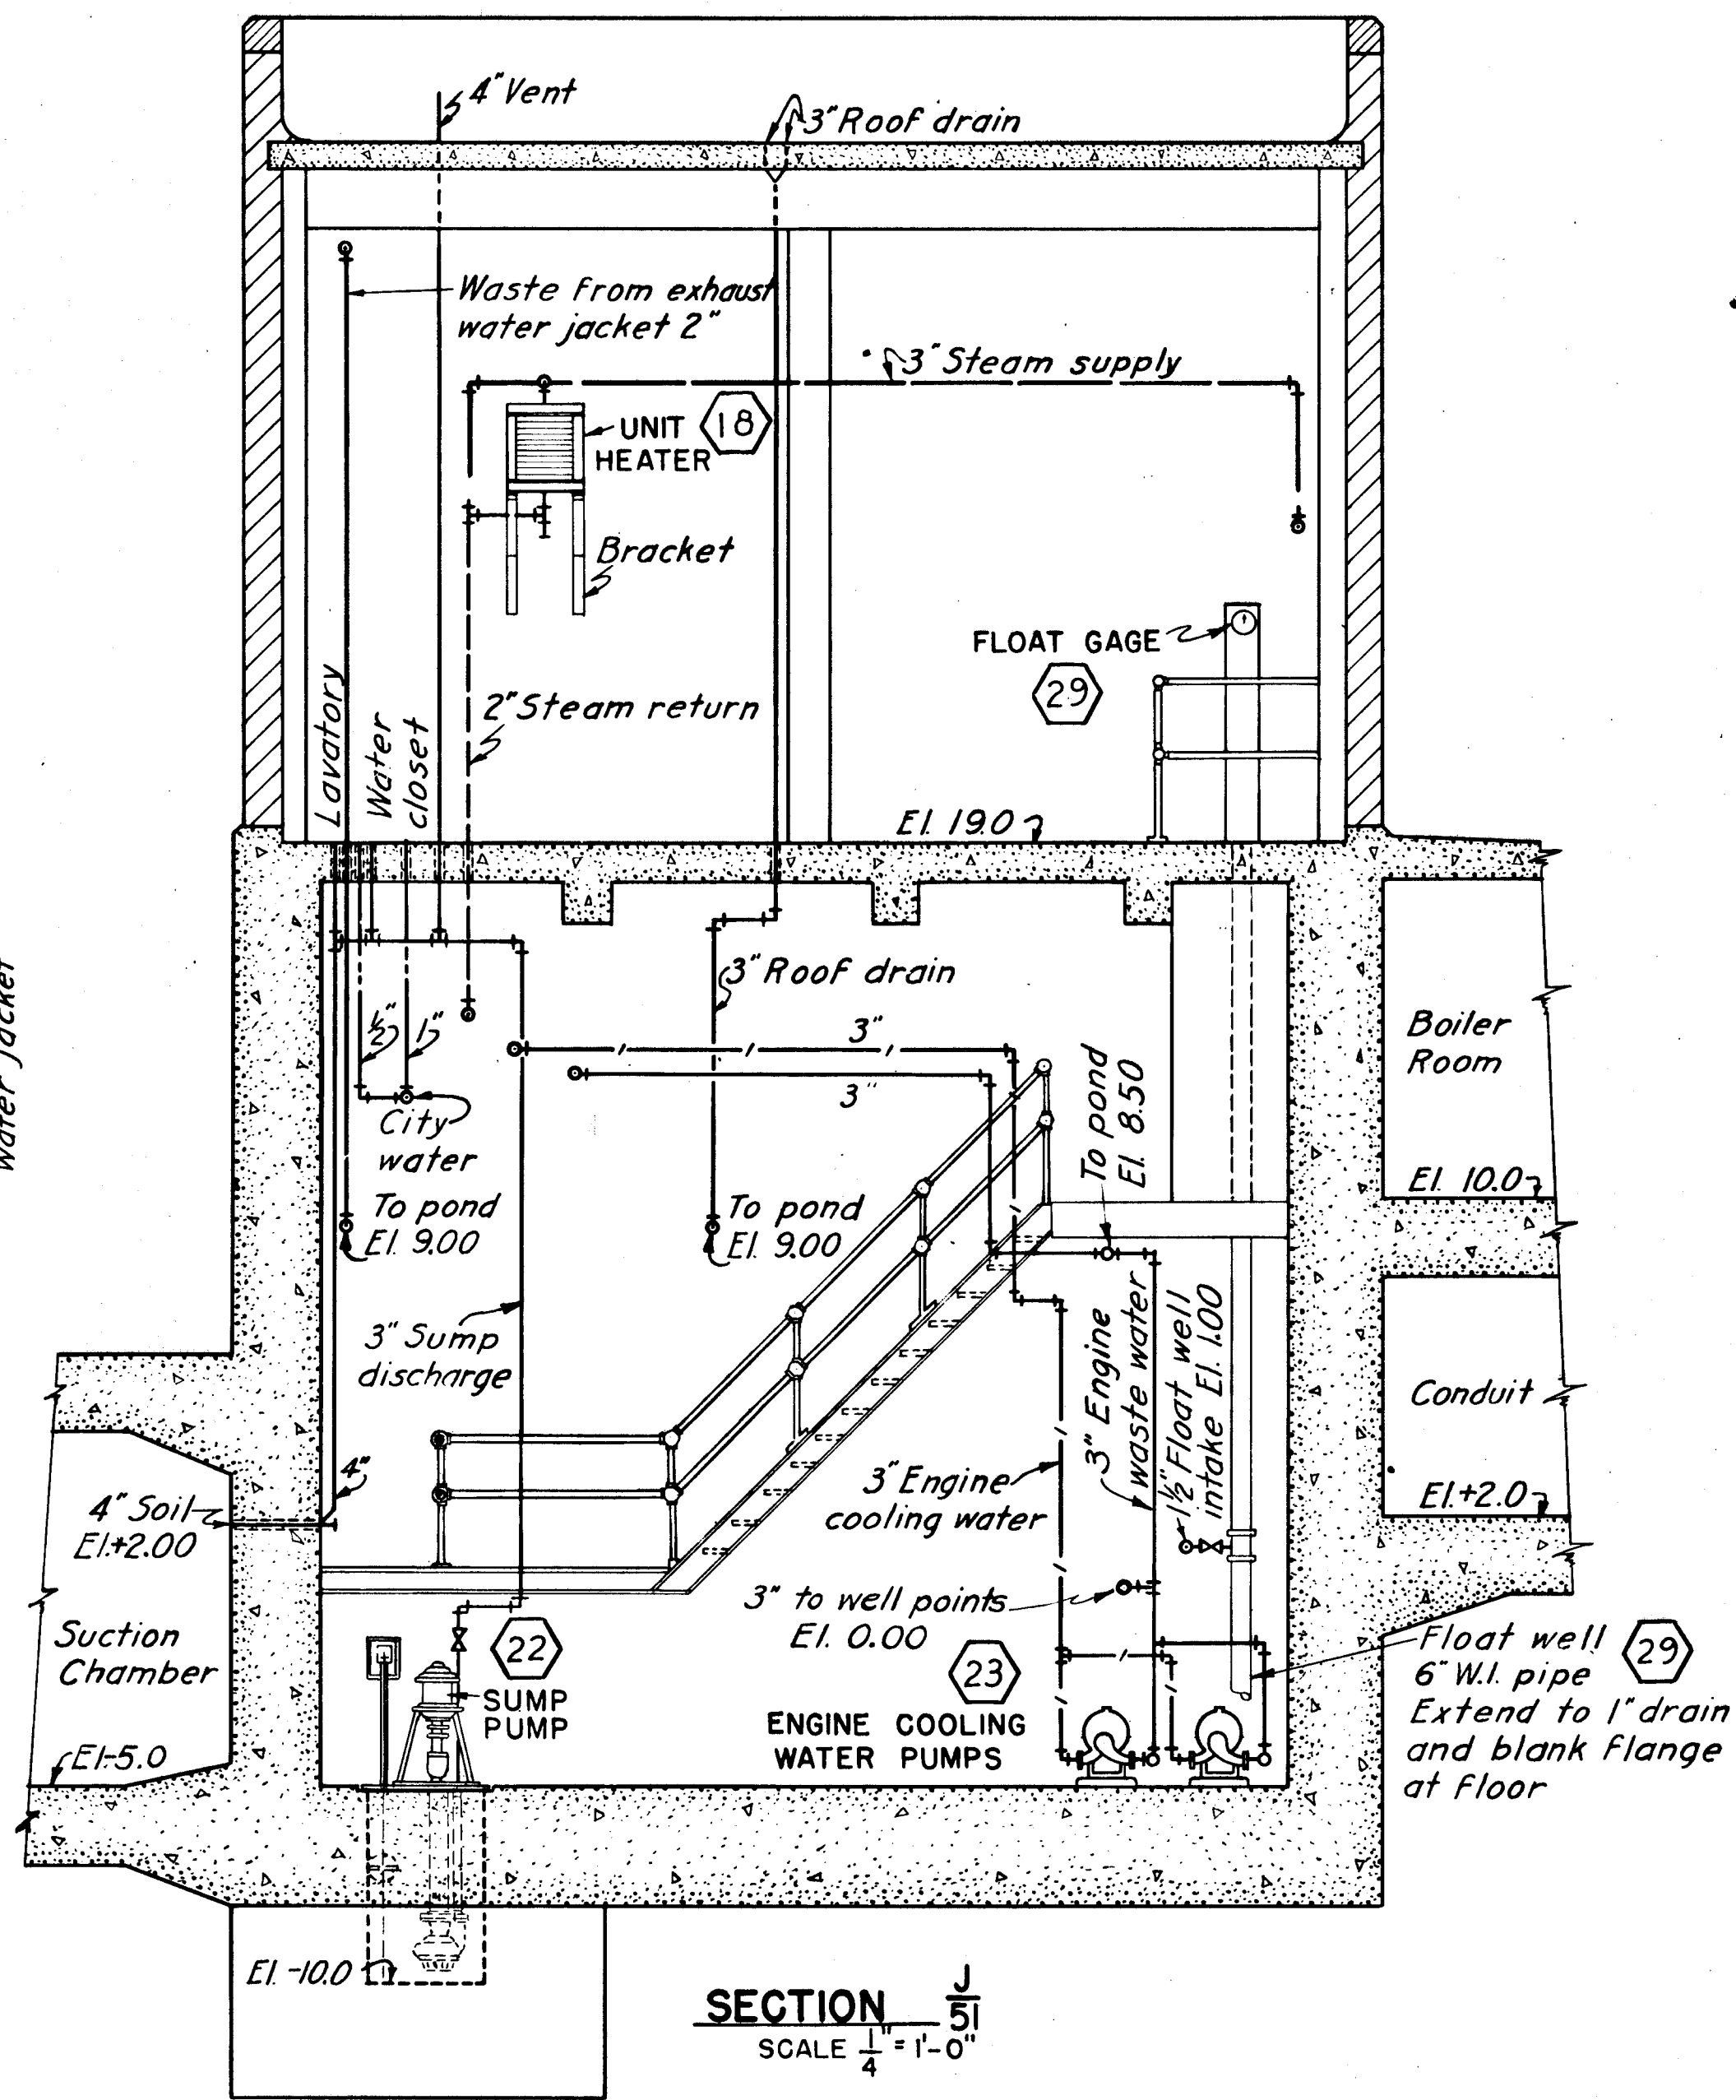

SECTION $\frac{J}{51}$
SCALE $\frac{1}{4}'' = 1'-0''$

12/31/45	As built revisions			
DATE	REVISION	REV. BY	CK. BY	AP. BY

CONNECTICUT RIVER FLOOD CONTROL		
NORTH MEADOWS PUMPING STATION		
FISCAL YEAR 1939 SECTION		
PLUMBING AND HEATING NO. 3		
HARTFORD, CONN.		
CONNECTICUT RIVER		CONNECTICUT
IN 62 SHEETS	SCALE 1/4 IN. = 1 FT.	SHEET NO 53
U.S. ENGINEER OFFICE, PROVIDENCE, R.I., FEB. 1939		
SUBMITTED: <i>David B. H. H.</i>	APPROVED: <i>D. B. H.</i>	APPROVED: <i>M. H. H.</i>
SENIOR ENGINEER	PRINCIPAL ENGINEER	LTCOL. CORPS OF ENGINEERS
HEAD, DESIGN SECTION	CHIEF, F.O. ENGINEERING DIV.	DISTRICT ENGINEER
DESIGNED: <i>D. B. H.</i>	DRAWN BY: J. J. S.	FILE NO. CT-4-1301
ASSOC. ENGINEER	TRACED BY: H. B.	CHECKED BY: S. R. L.