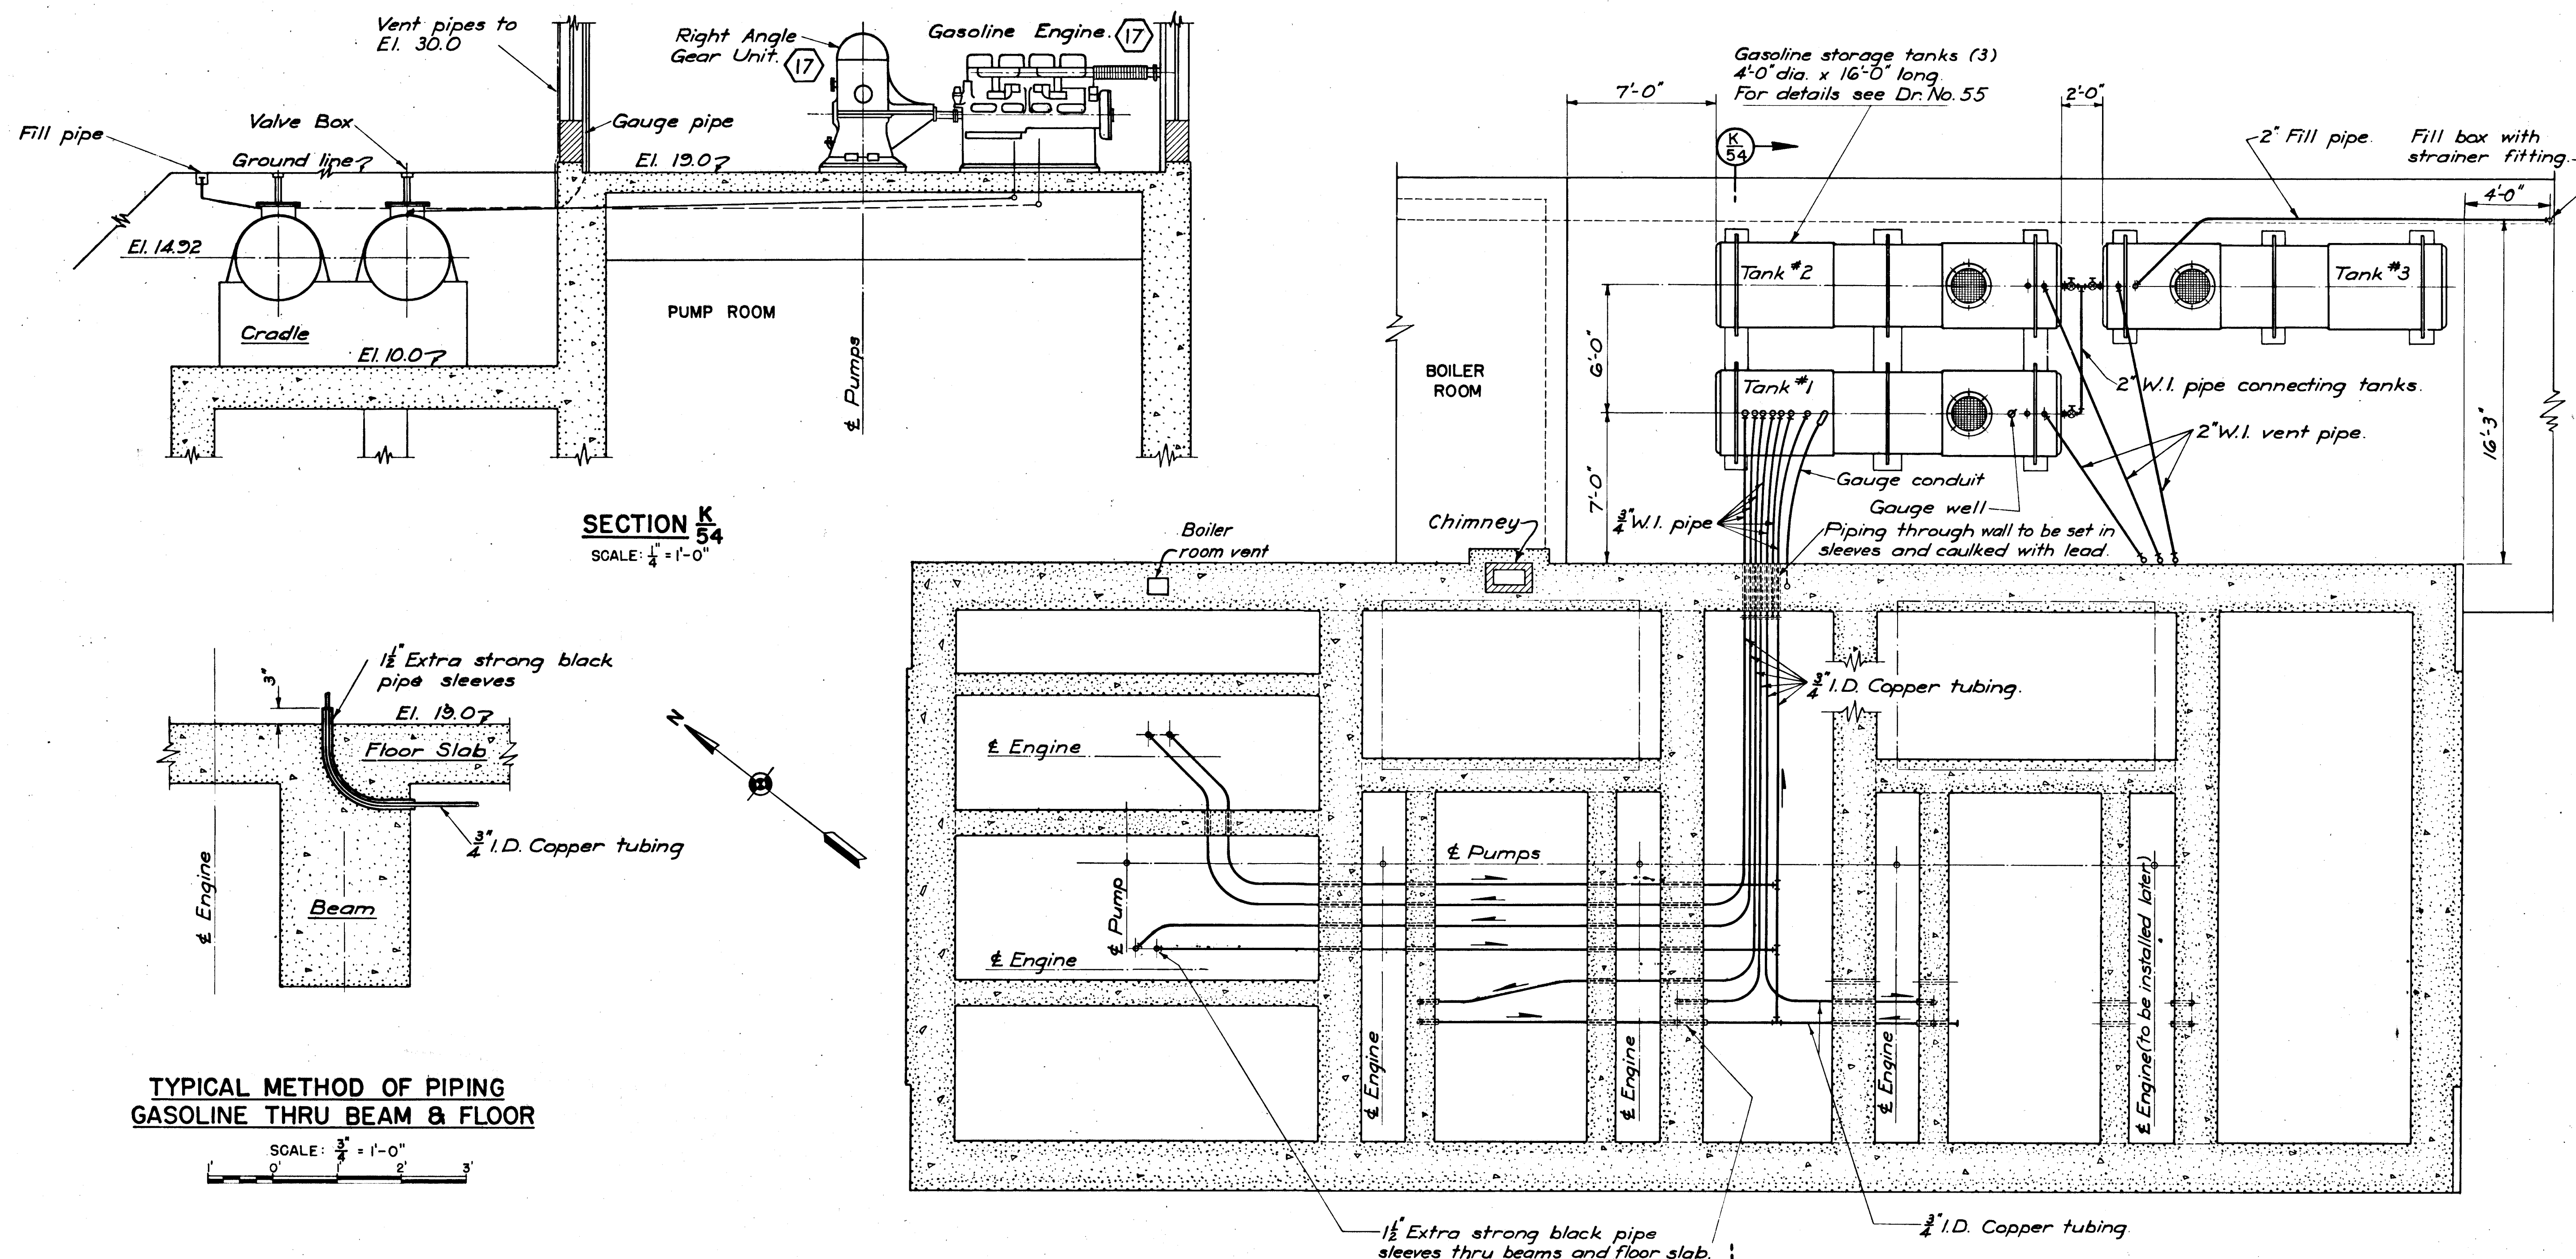


**NOTES:**

- Furnishing and installing gasoline tanks and piping will be paid for under Item No. 28.
 See Sheet No. 55 for details of gasoline tank and fittings.
 All sleeves including those for gasoline lines servicing future installed engine shall be placed by the contractor.
 Gasoline lines to have constant pitch towards the tanks.
 Piping is shown diagrammatically; the exact location shall suit the equipment furnished.
 Feed line from tank to future installed engine shall be brought inside of pump room wall and blanked off.
 Piping shall be supported on hangers spaced at 8 ft. intervals.

12/31/45	As built				
DATE	REVISION	REV. BY	CK. BY	AP. BY	

CONNECTICUT RIVER FLOOD CONTROL			
NORTH MEADOWS PUMPING STATION			
FISCAL YEAR 1939 SECTION			
GASOLINE PIPING SYSTEM			
HARTFORD, CONN.			
CONNECTICUT RIVER		CONNECTICUT	
IN 62 SHEETS	SCALE: 1/4" = 1' FT.	SHEET NO. 54	
U.S. ENGINEER OFFICE, PROVIDENCE, R.I. FEB. 1939			
SUBMITTED:	APPROVAL RECOMMENDED:	APPROVED:	
SENIOR ENGINEER	PRINCIPAL ENGINEER	DISTRICT ENGINEER	
HEAD DESIGN SECTION	CHIEF, F.C. ENGINEERING DIV.	FILE NO. CT-4-1302	
DESIGNED BY: <i>W. M. M.</i>	DRAWN BY: <i>W. M. M.</i>	CHECKED BY: <i>S. R. L.</i>	
ASSOC. ENGINEER			