
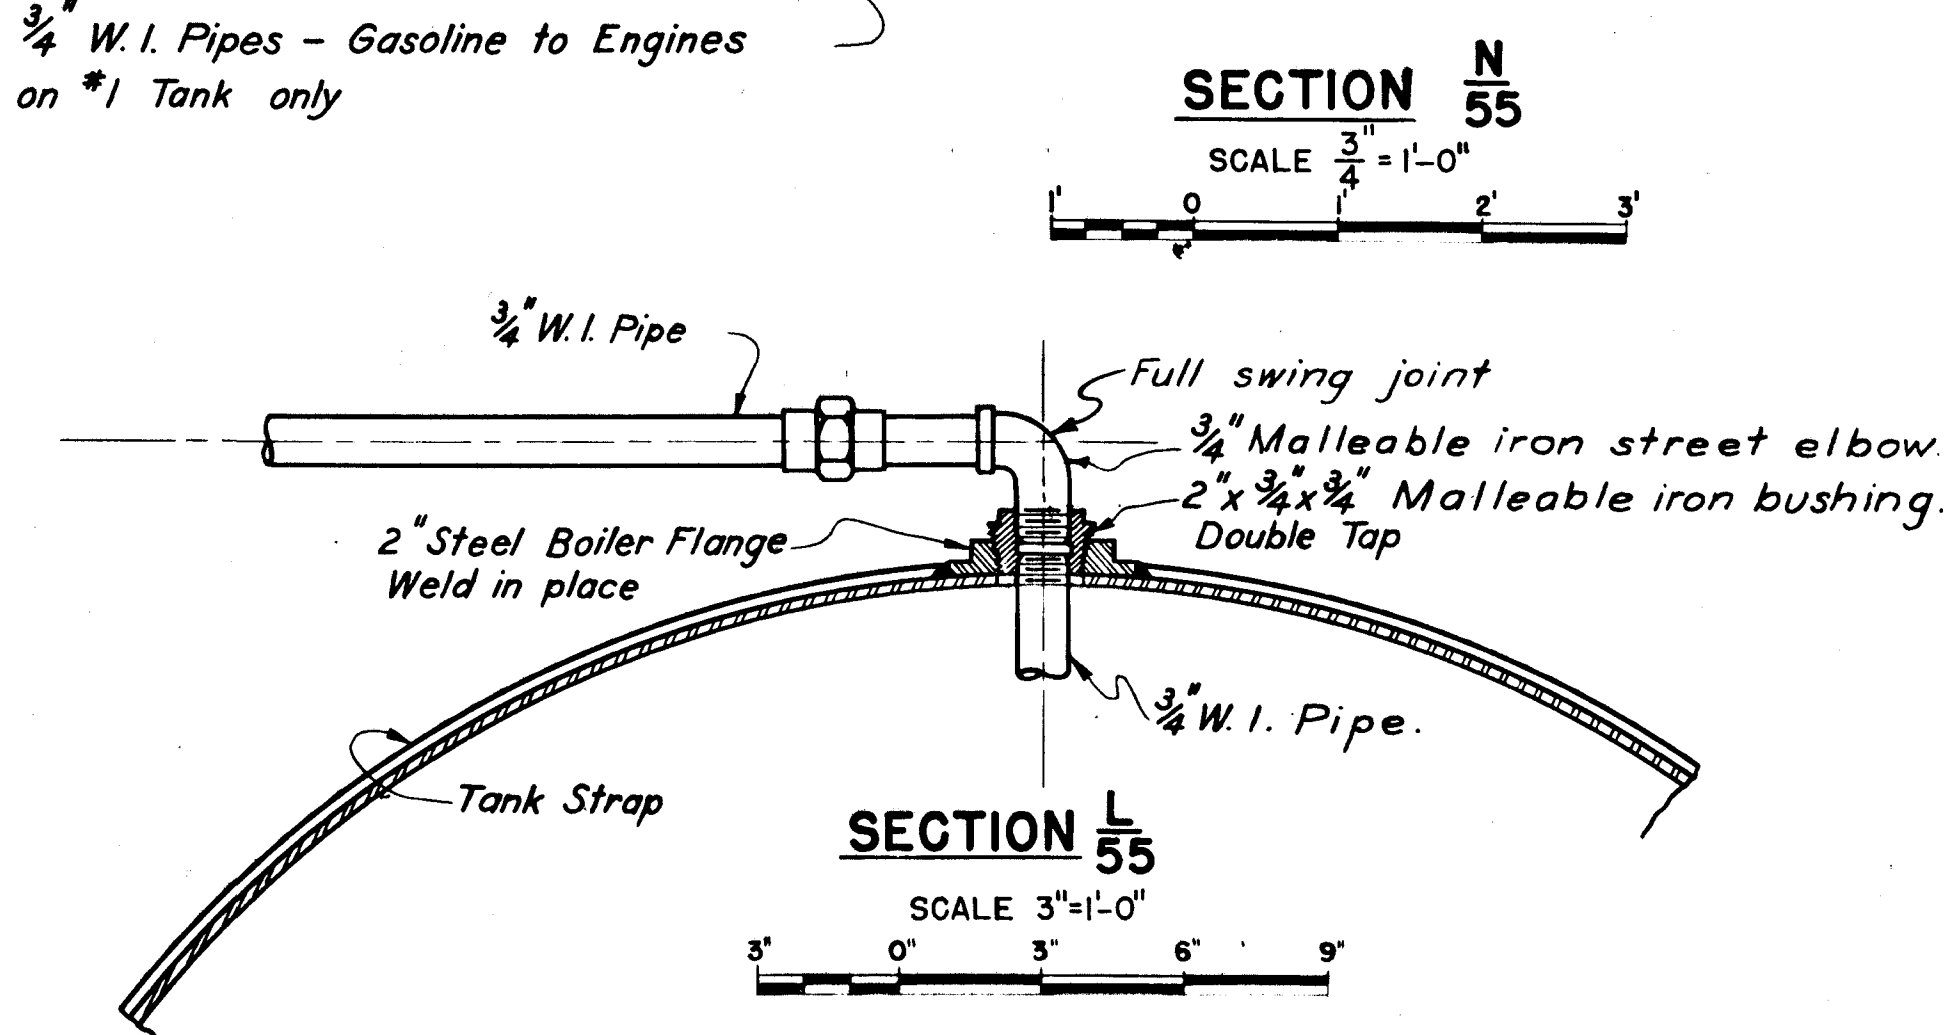
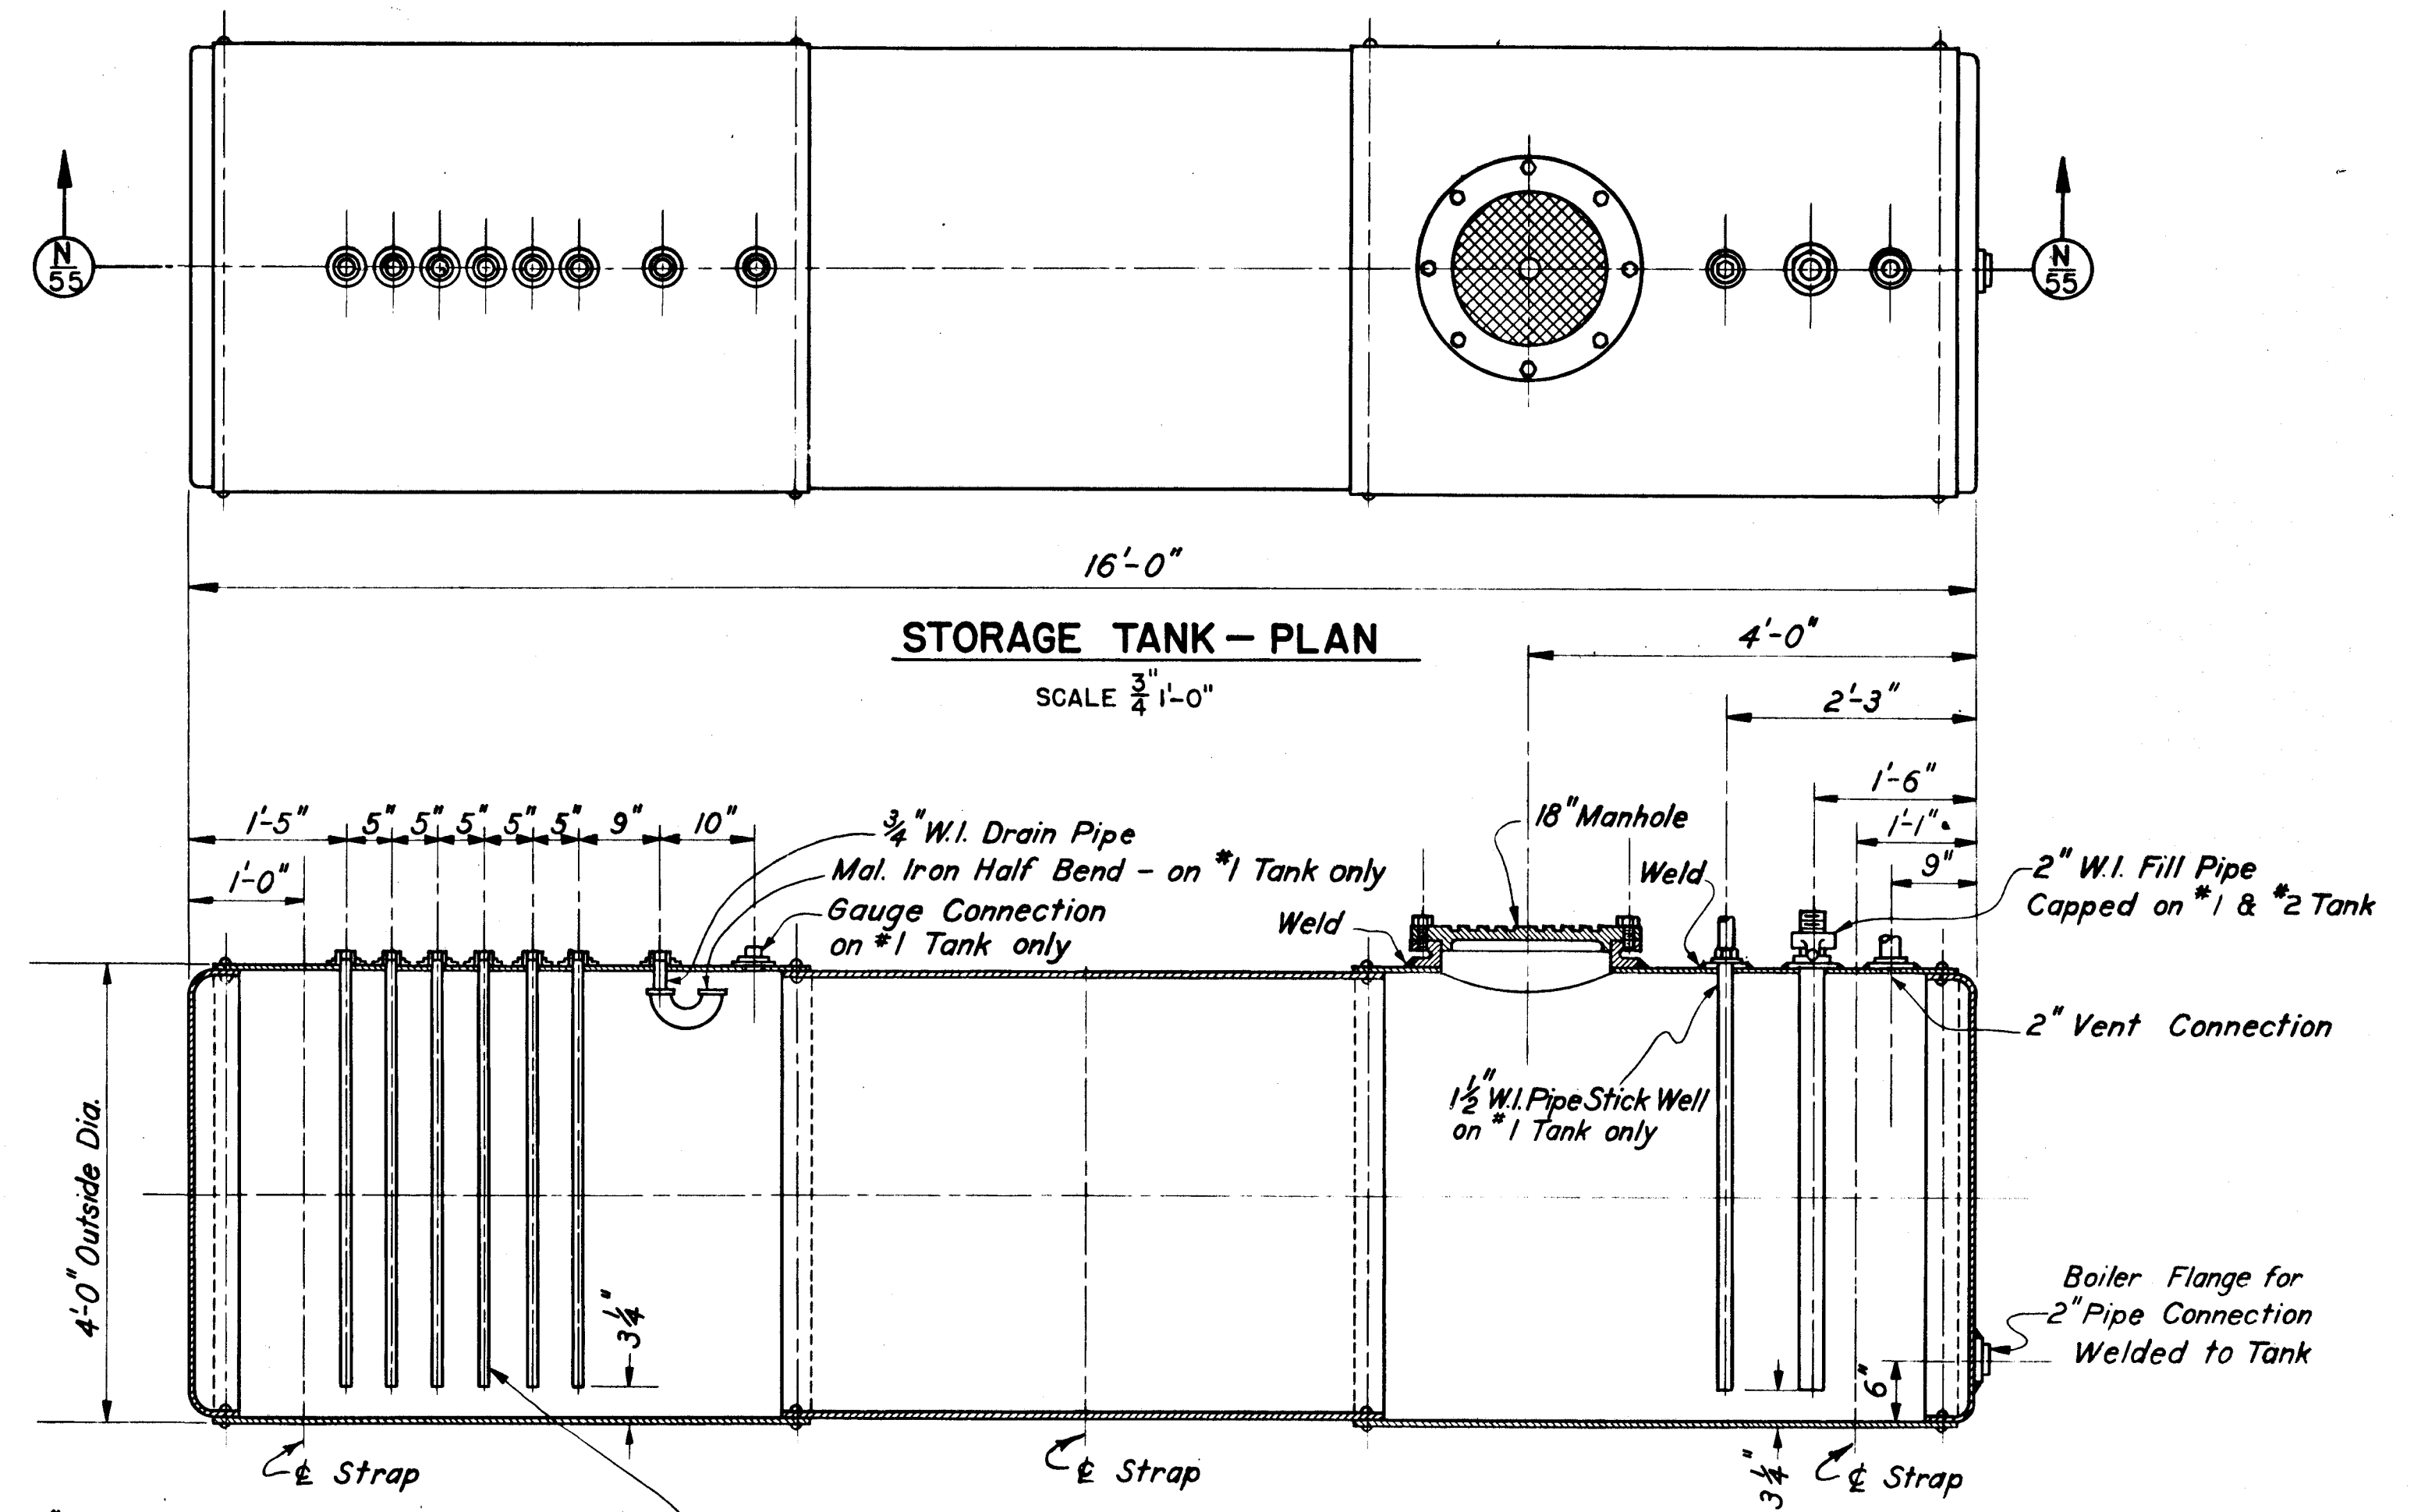
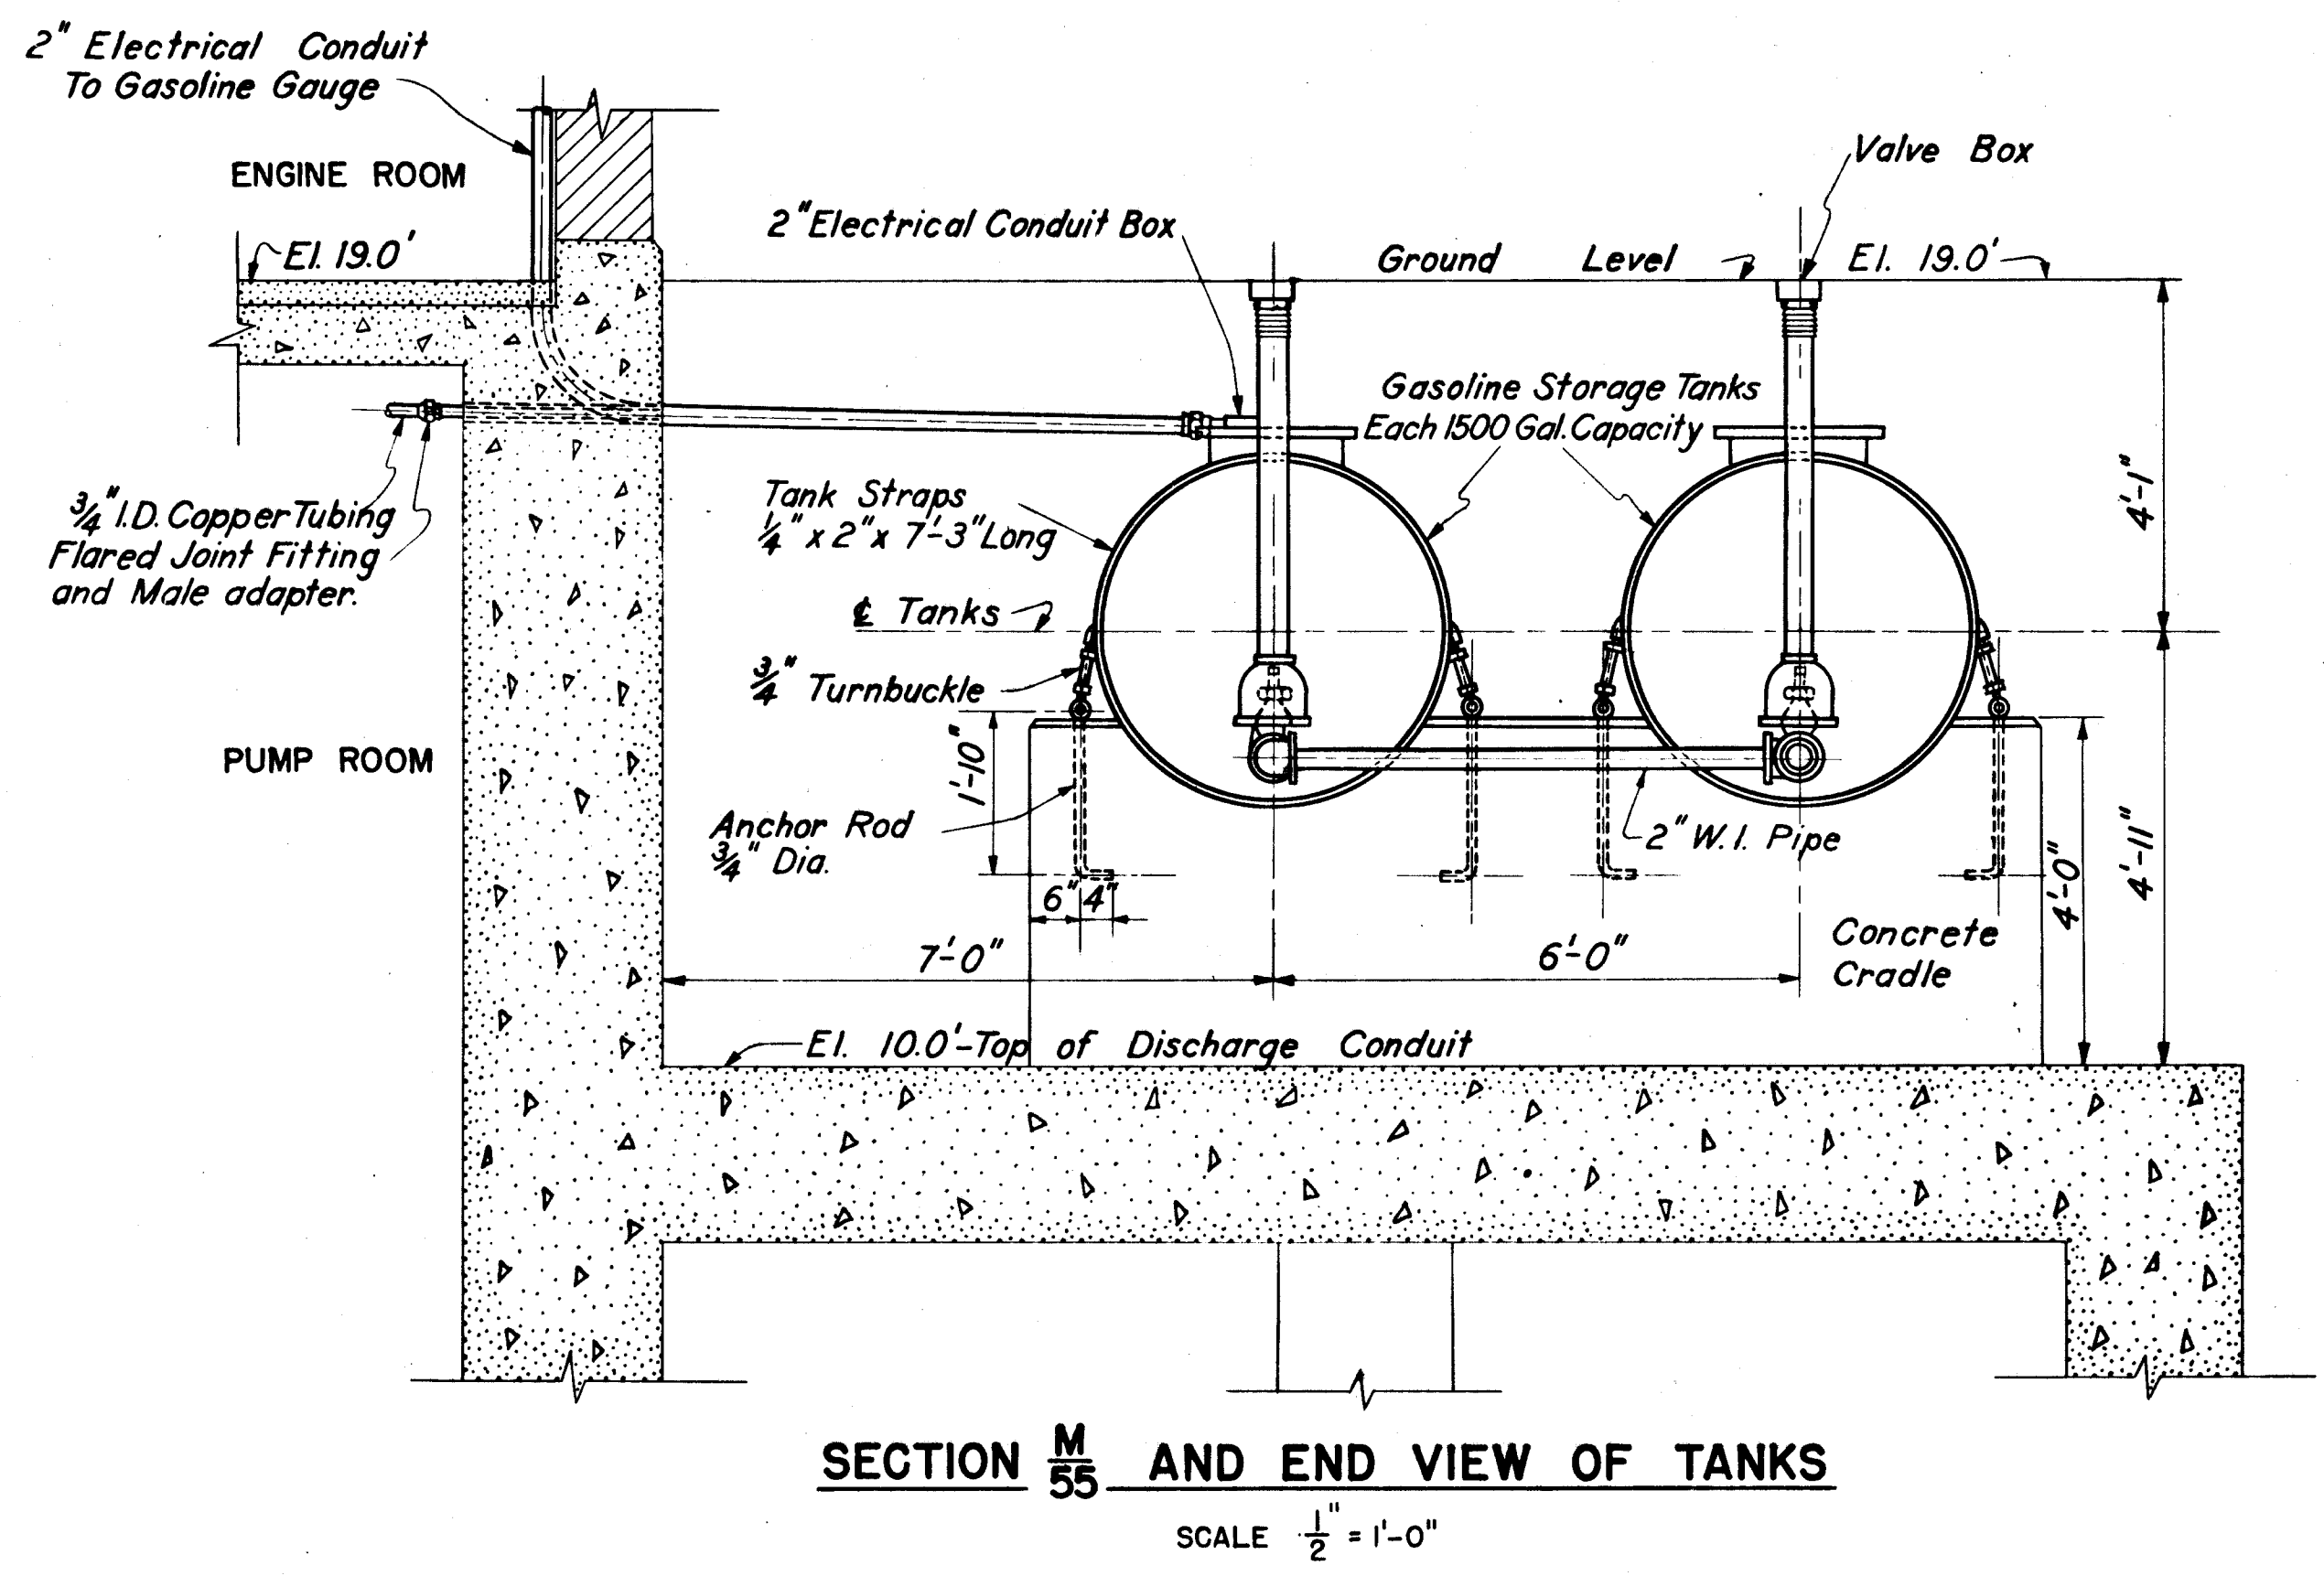


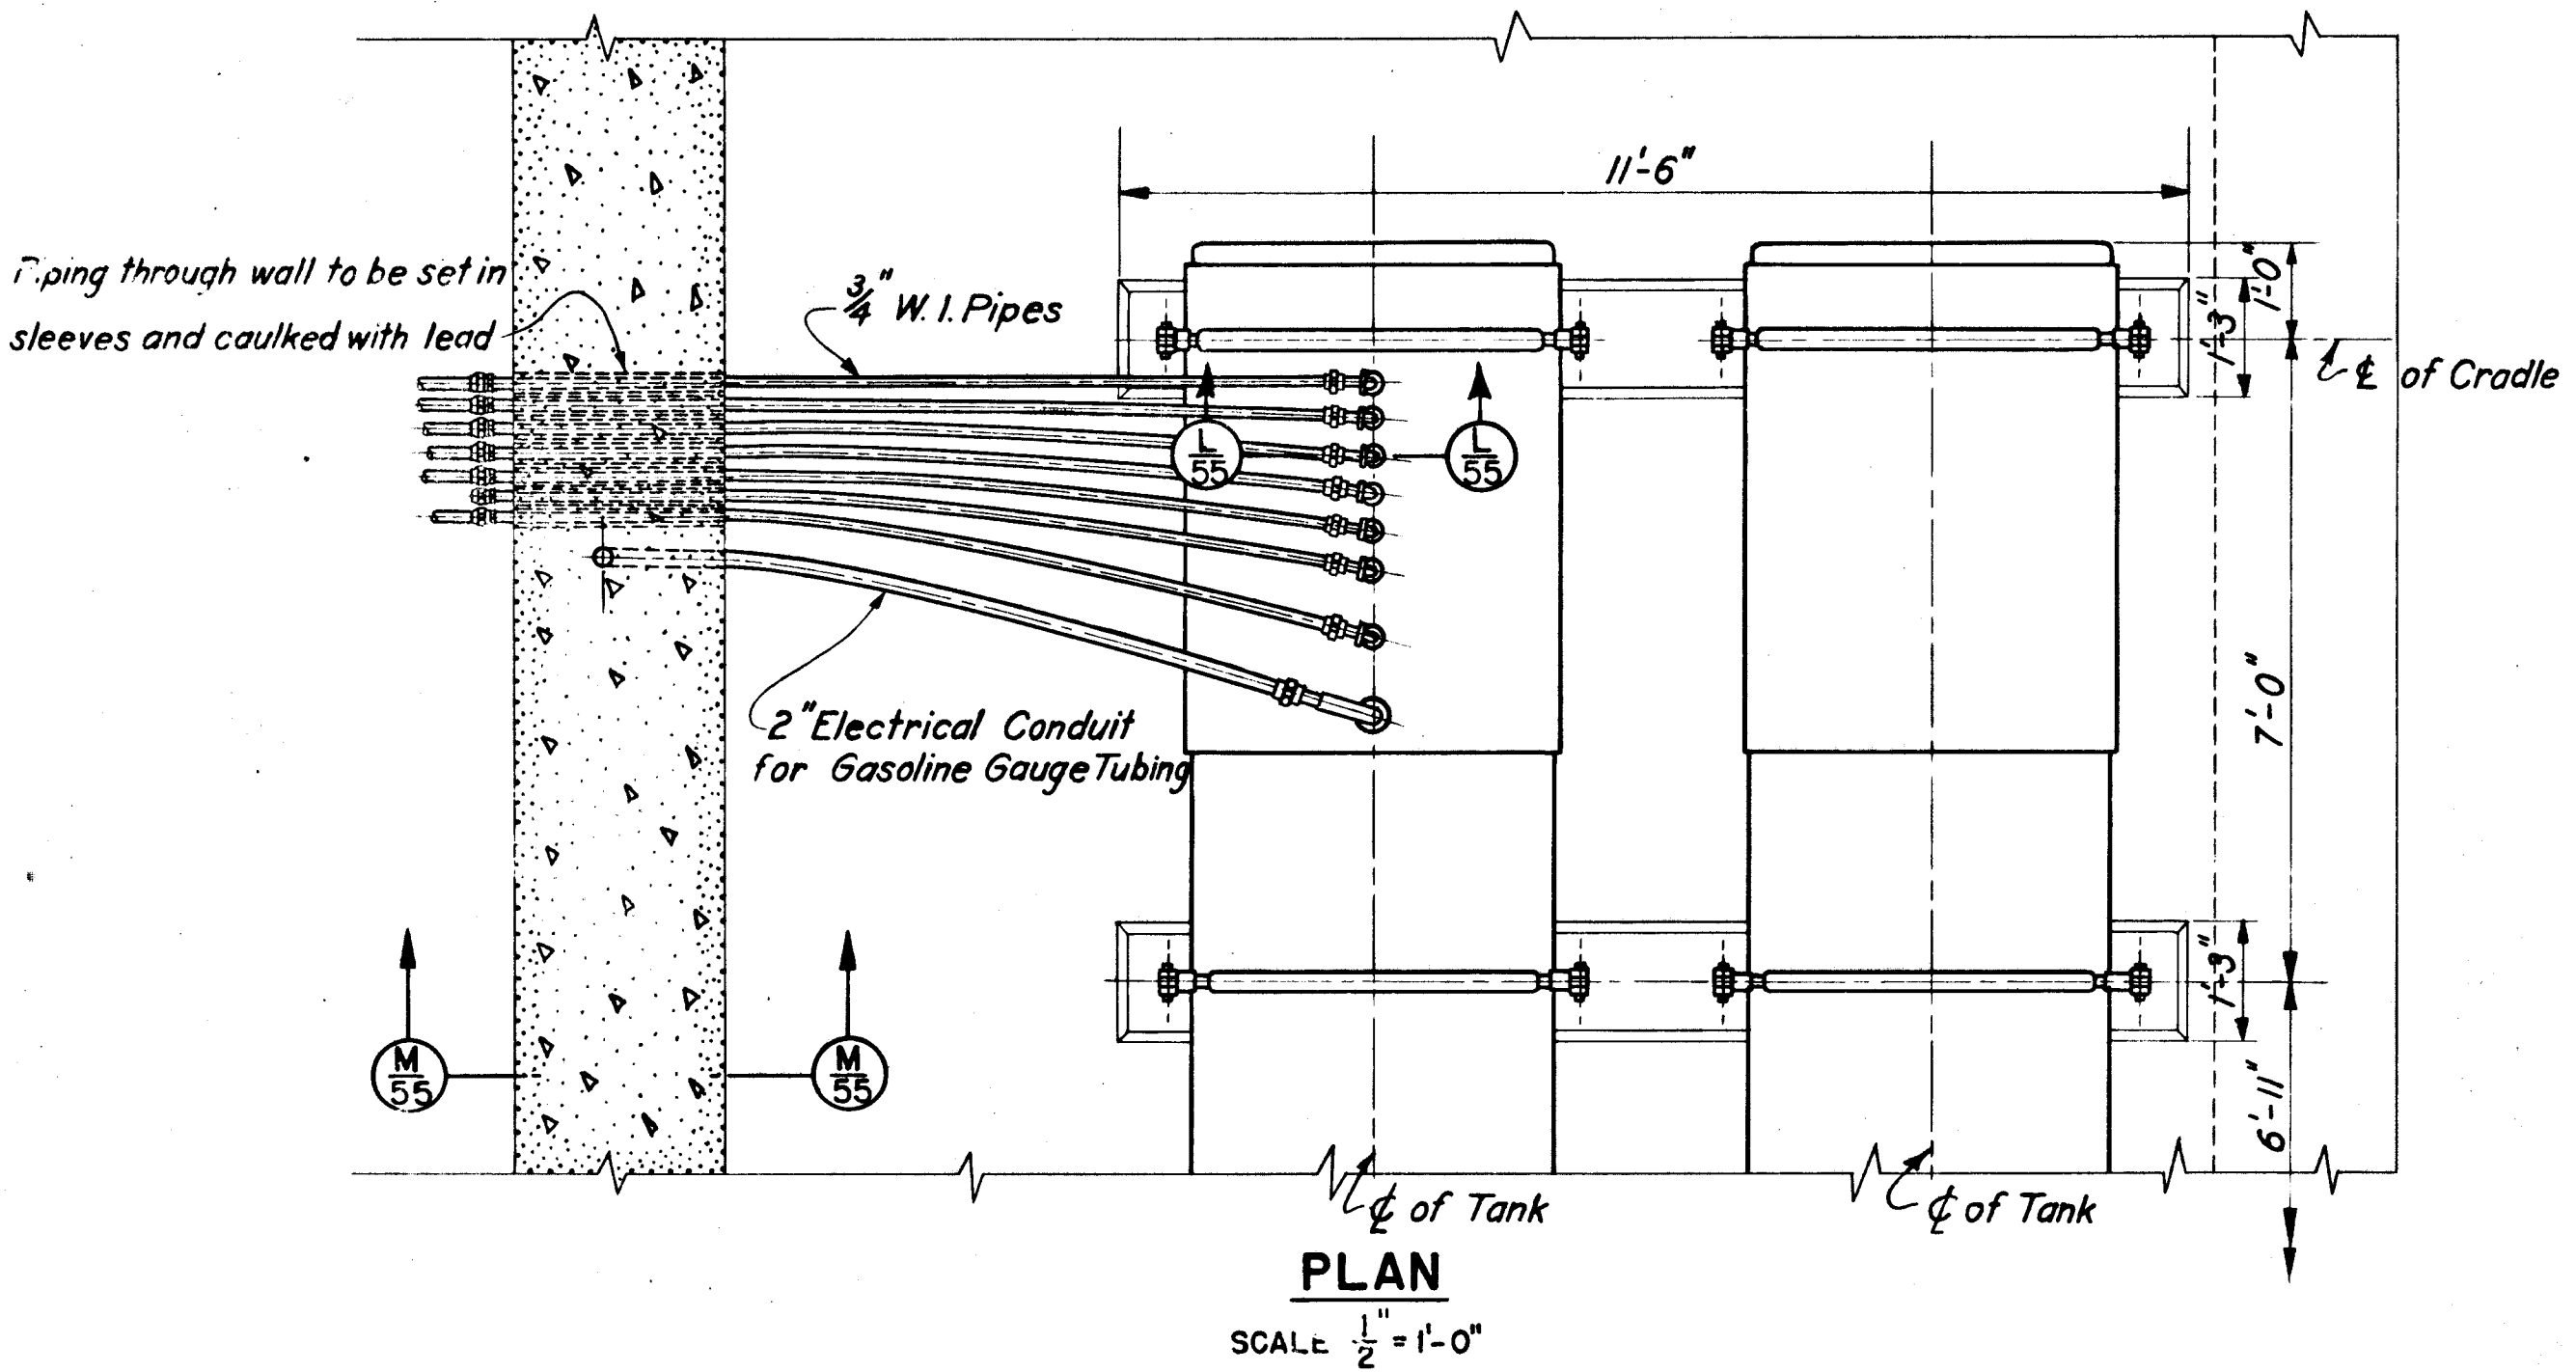

NOTES:

See Sheet No. 54 for Location of Gasoline Tanks and Gasoline Pipe Lines.

Furnishing and installing gasoline tanks and piping will be paid for under Item No. 28.

12-31-40	As built revisions				
DATE	REVISION	REV. BY	CK. BY	AP. BY	

CONNECTICUT RIVER FLOOD CONTROL		
NORTH MEADOWS PUMPING STATION		
FISCAL YEAR 1939 SECTION		
GASOLINE PIPING DETAILS		
HARTFORD, CONN.		
CONNECTICUT RIVER,	CONNECTICUT	
IN 62 SHEETS	SCALE: 1/2" = 1 FT.	SHEET NO. 55
U. S. ENGINEER OFFICE, PROVIDENCE, R.I., FEB. 1939		
SUBMITTED: <i>W. B. Brown</i>	APPROVED: <i>W. B. Brown</i>	APPROVED: <i>W. B. Brown</i>
DESIGNED: <i>W. B. Brown</i>	CHIEF, E. C. ENGINEERING DIV.	1ST. COL. CORPS OF ENGINEERS
DRAWN BY: <i>A. A. H.</i>	TRACED BY: <i>E. W. F.</i>	FILE NO. CT-4 1303
ASSOC. ENGINEER	CHECKED BY: <i>S. R. L.</i>	