
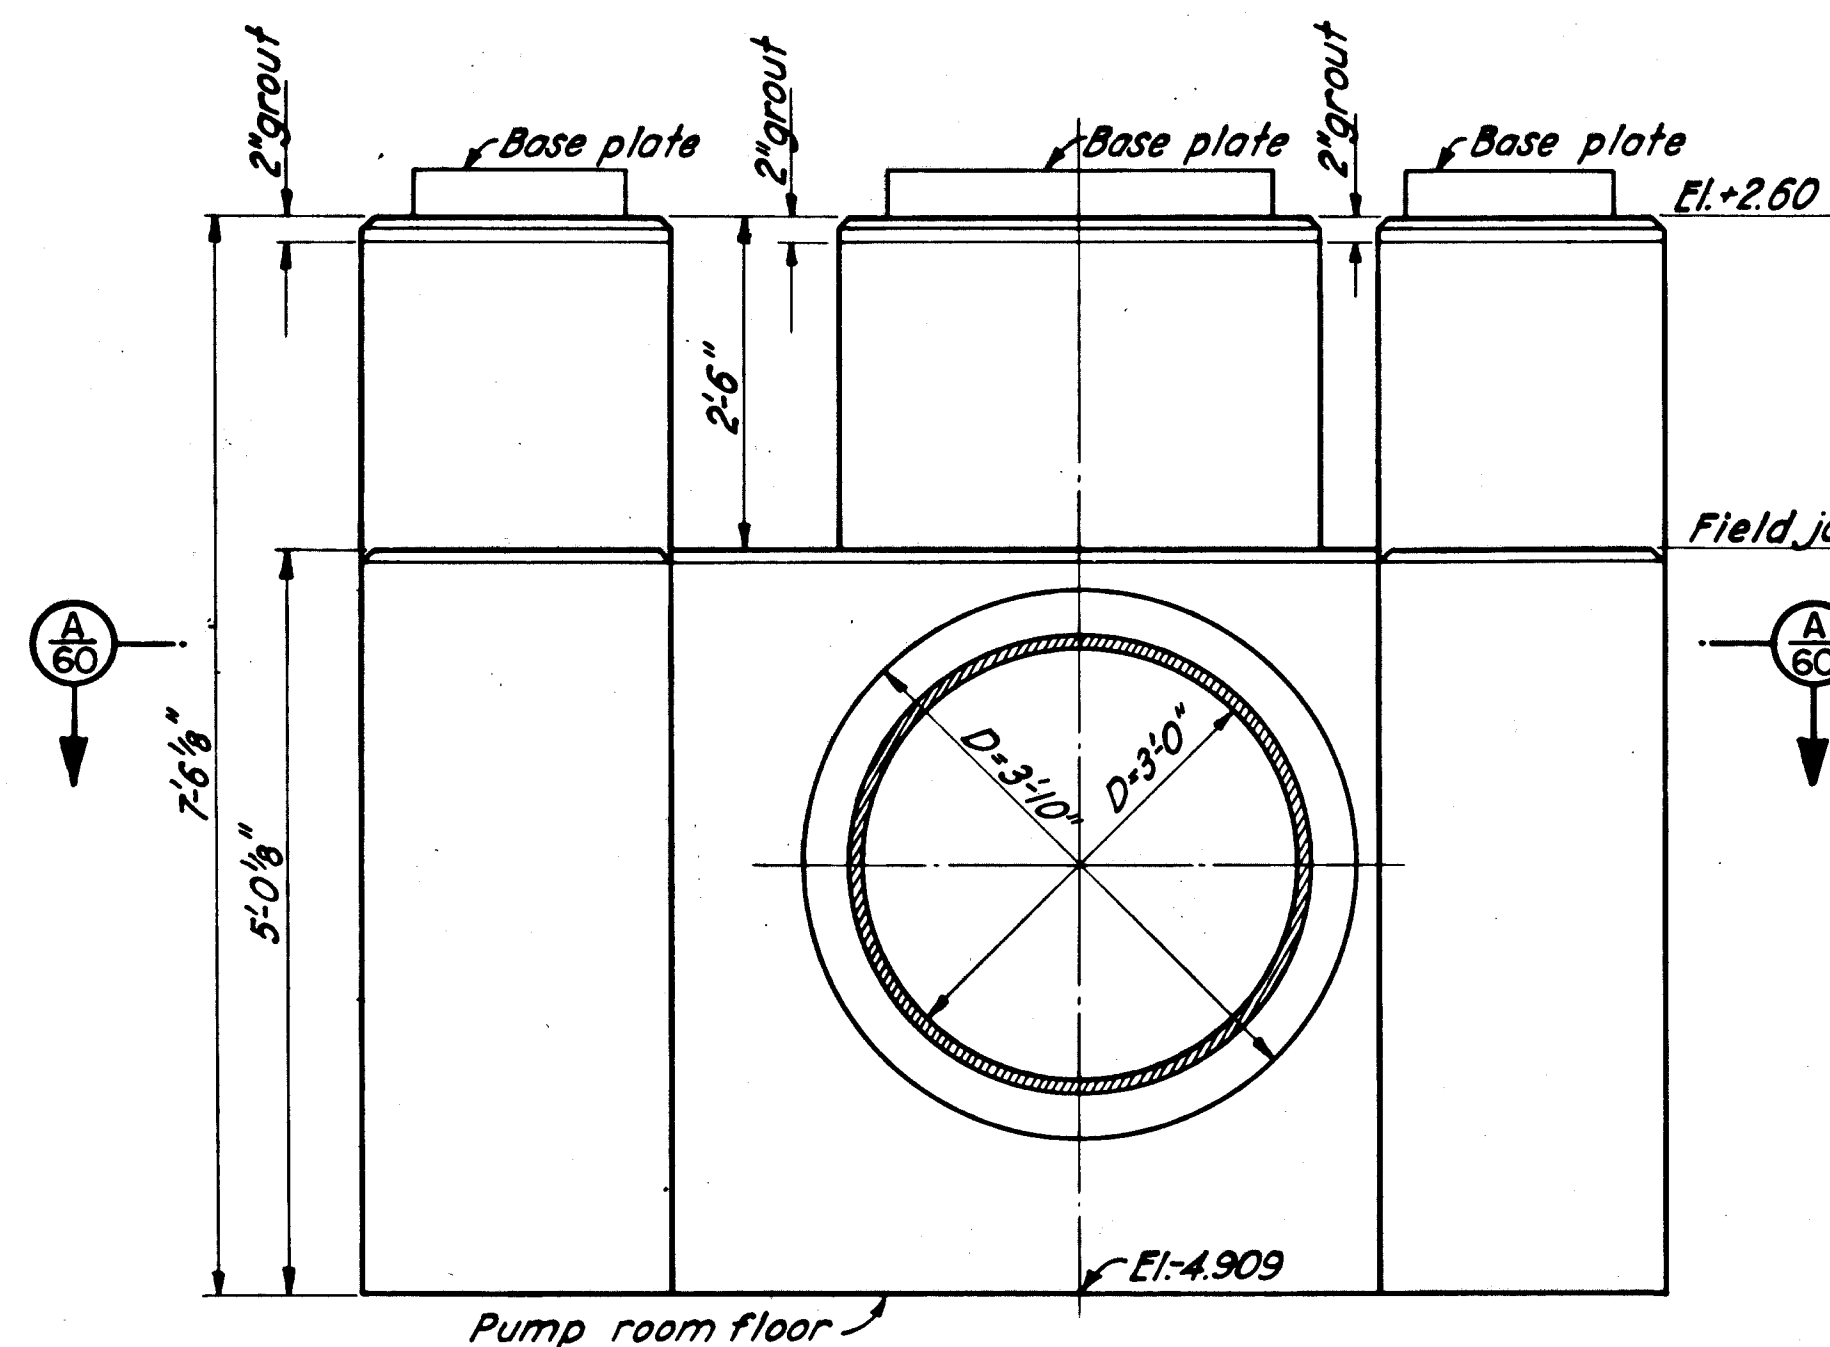
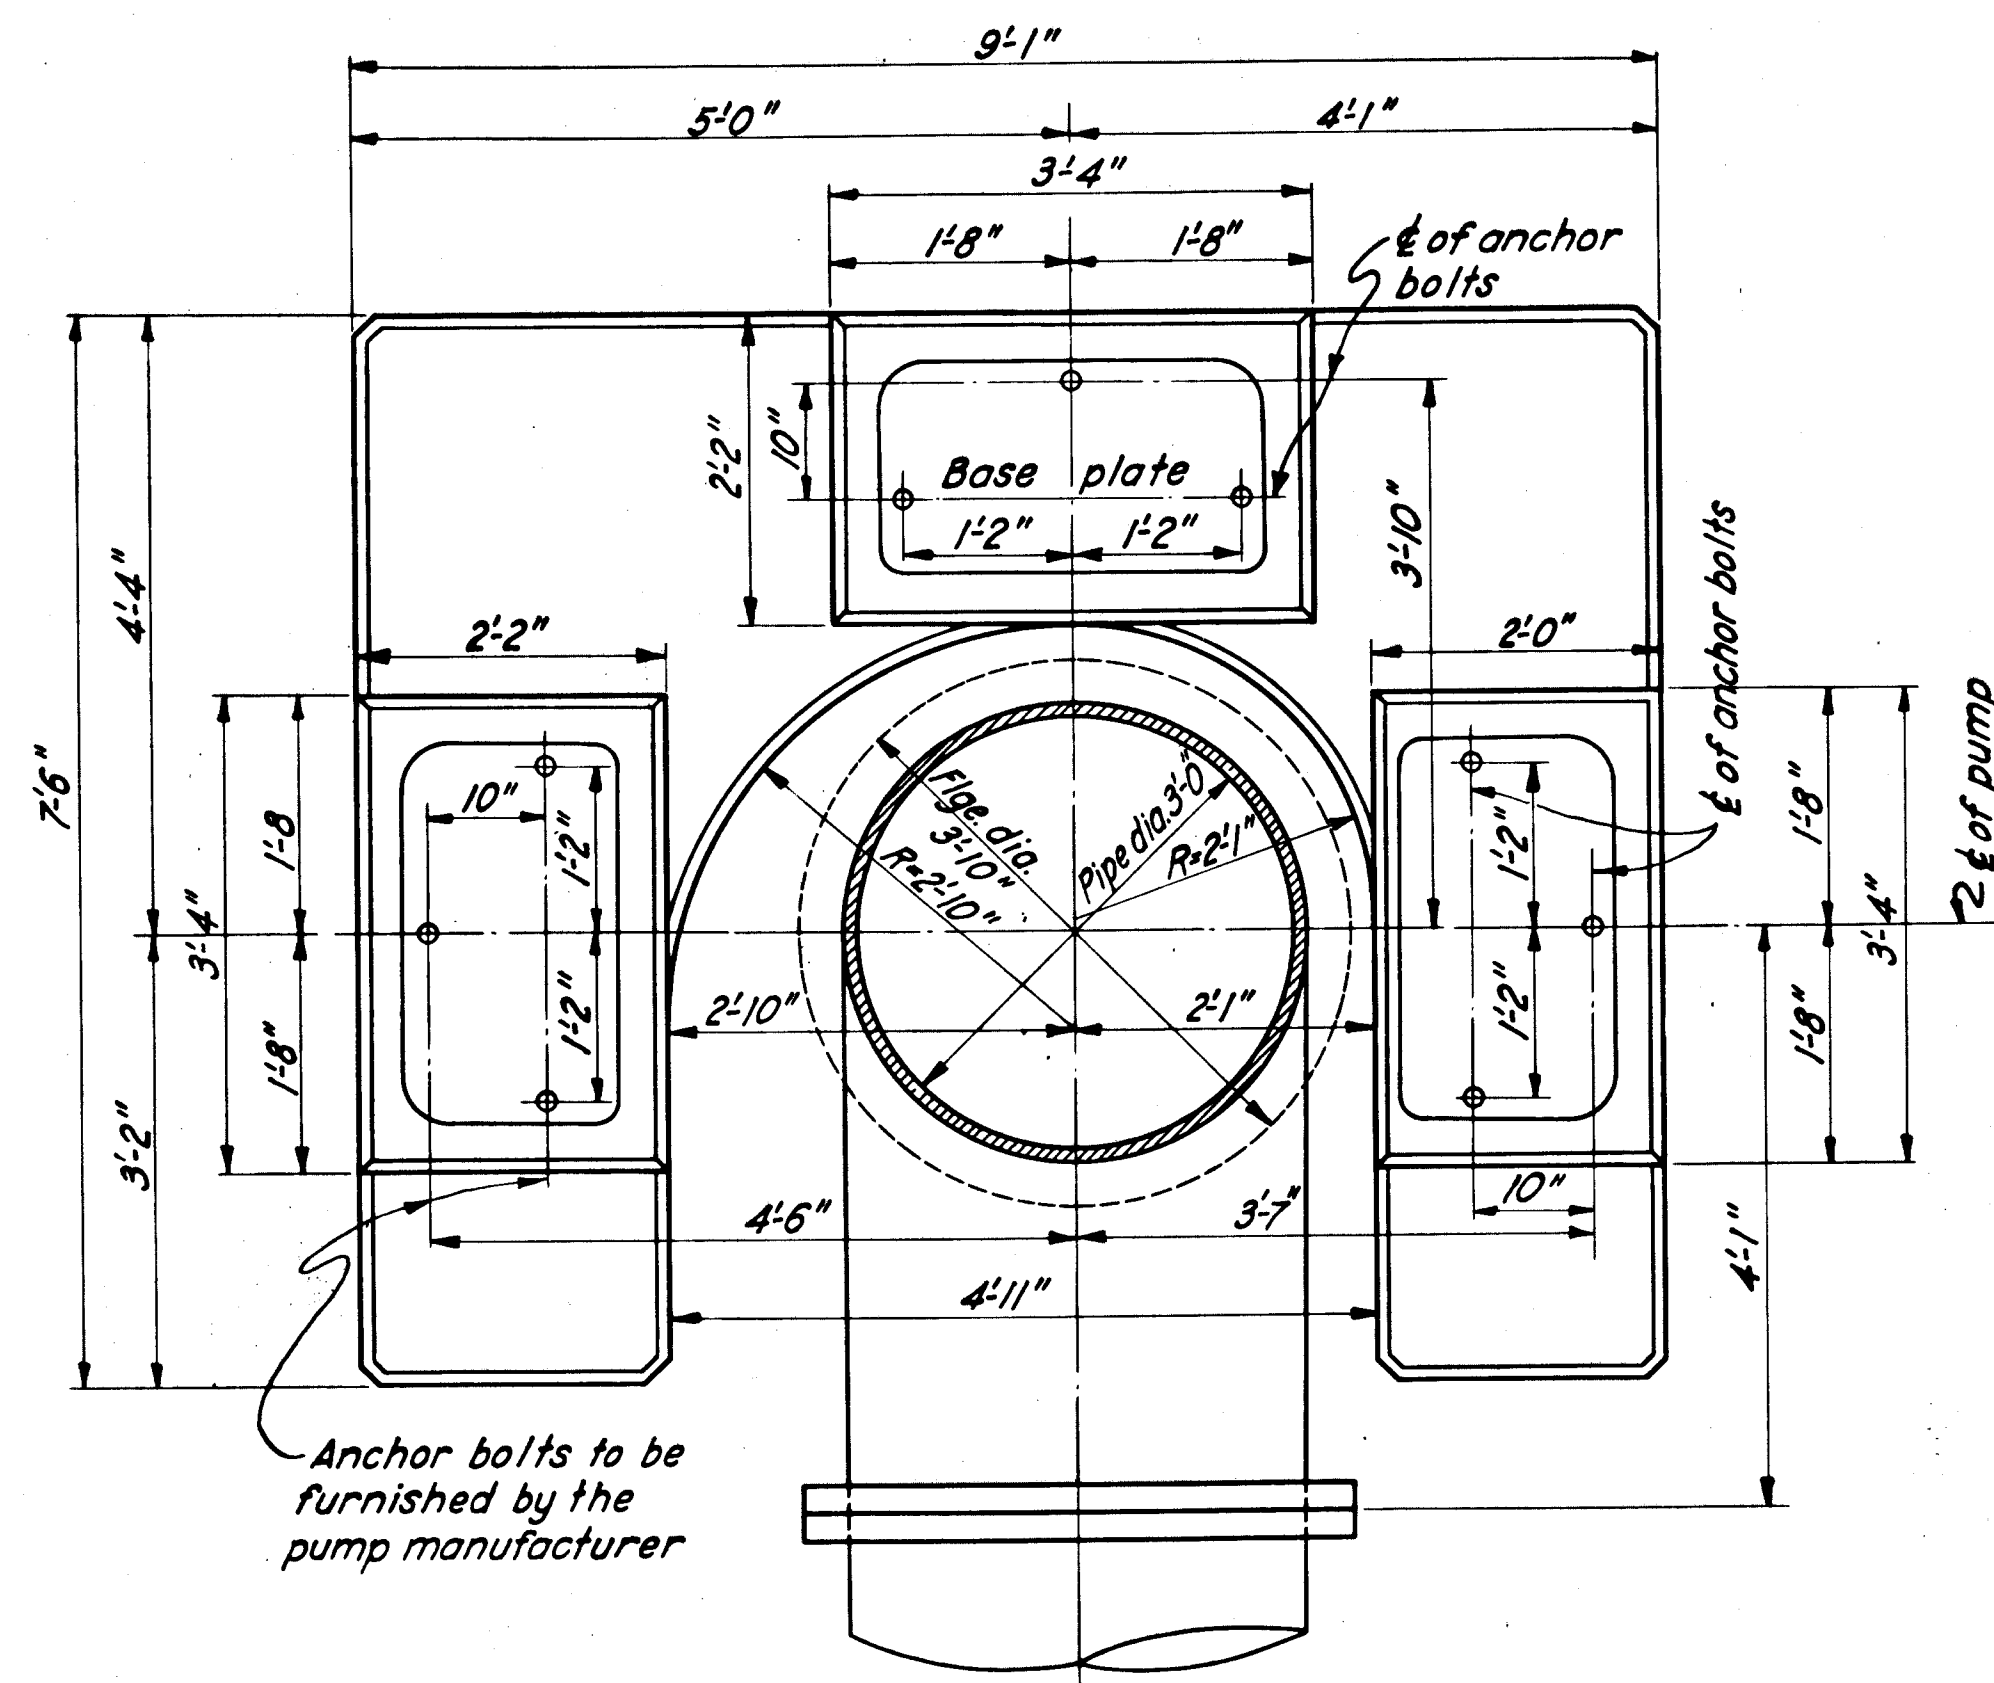
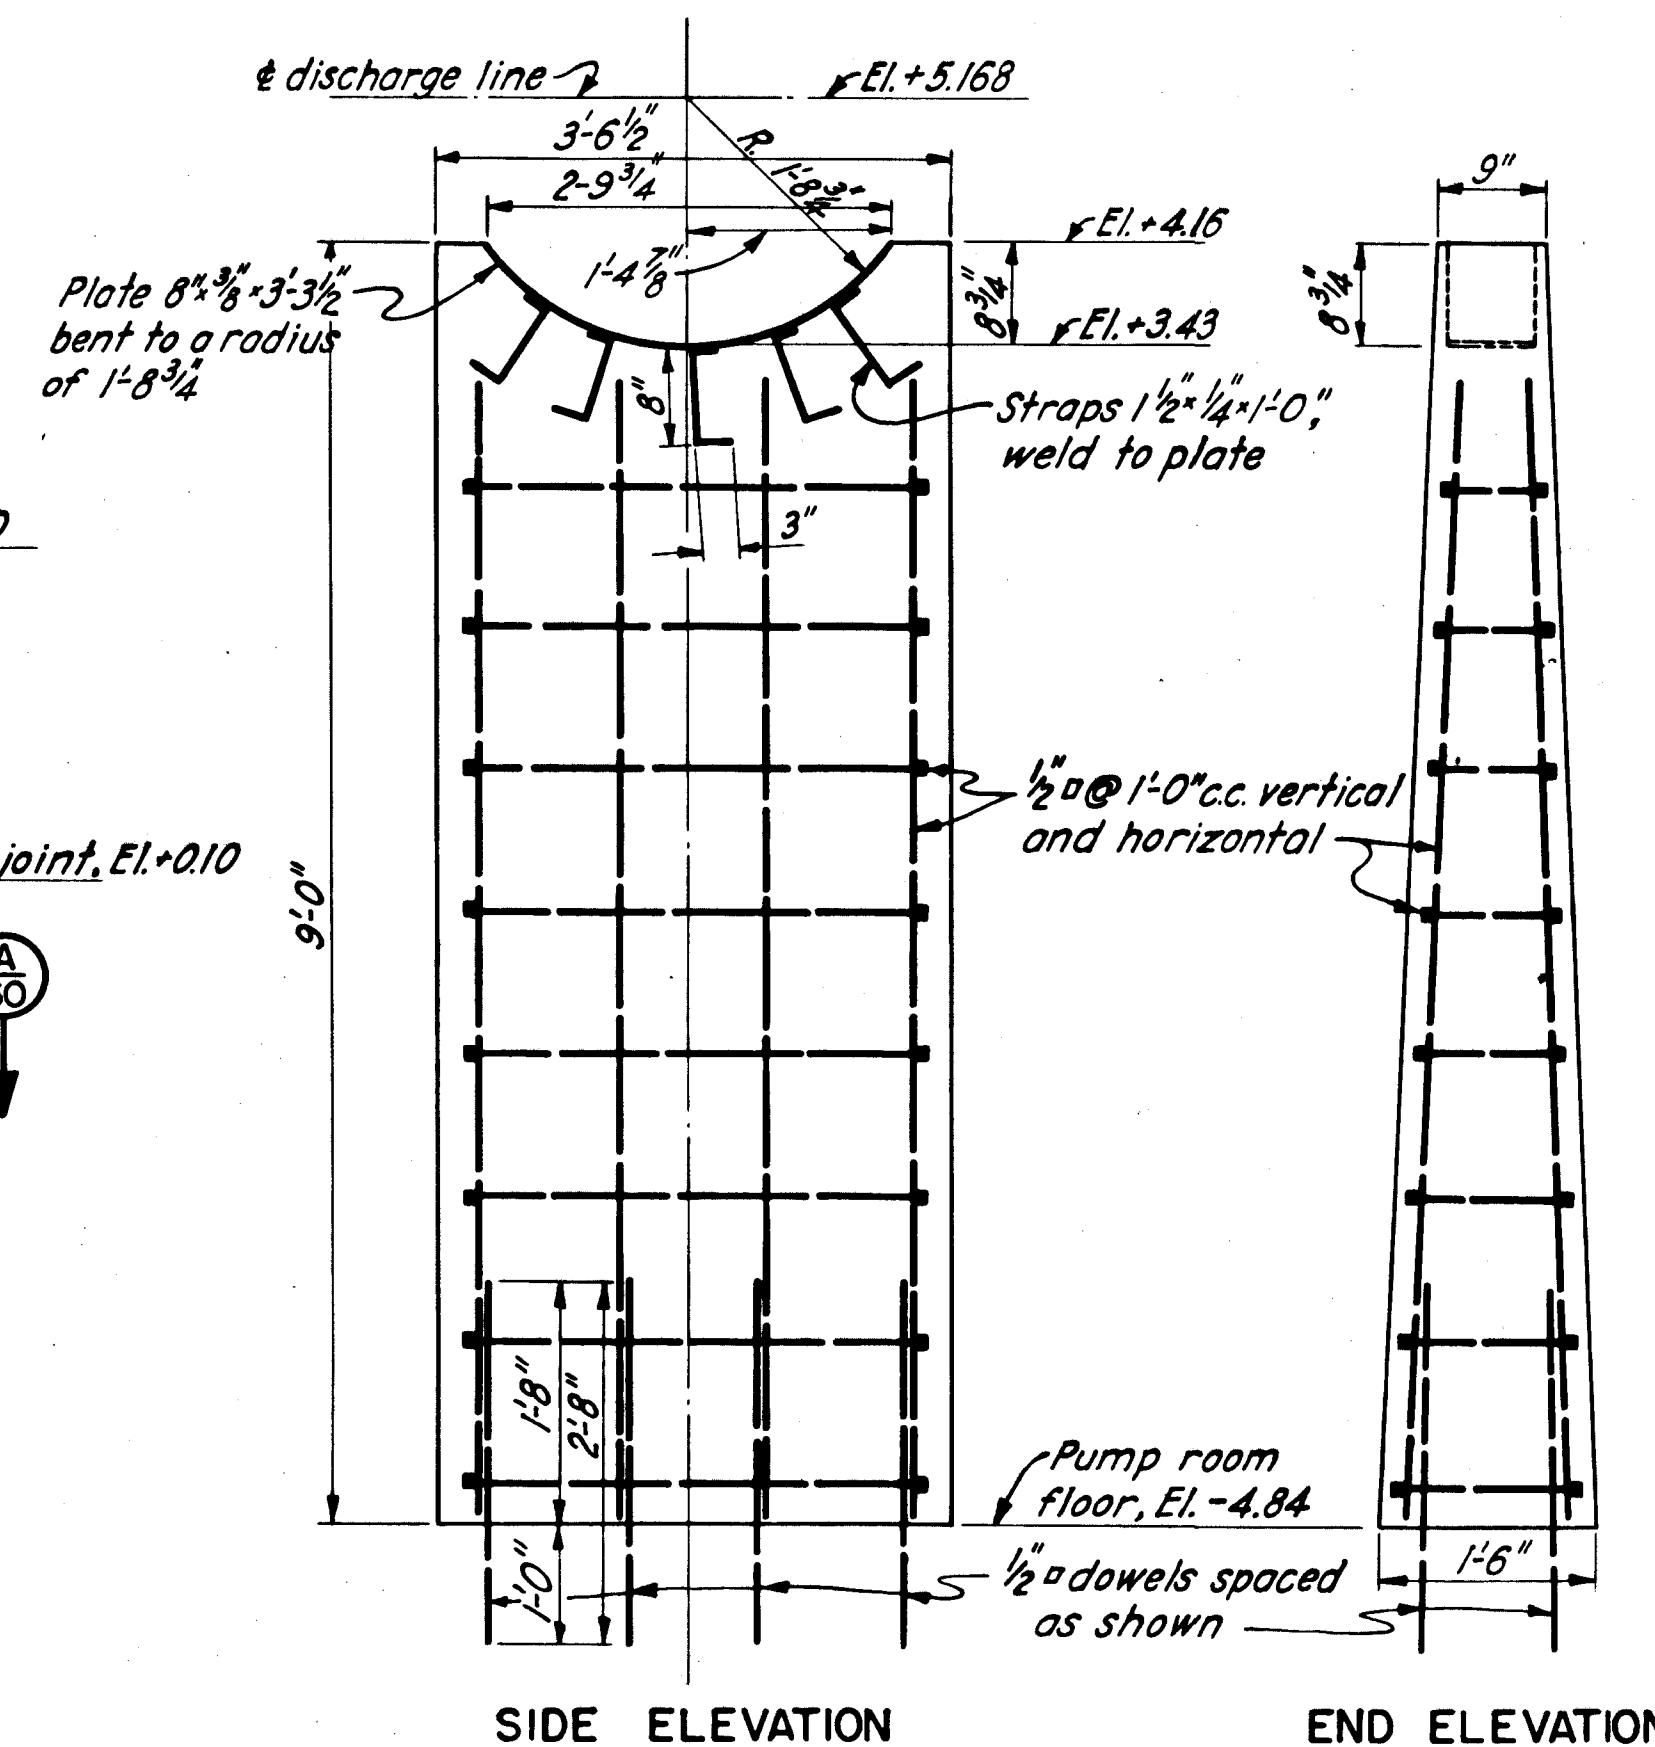


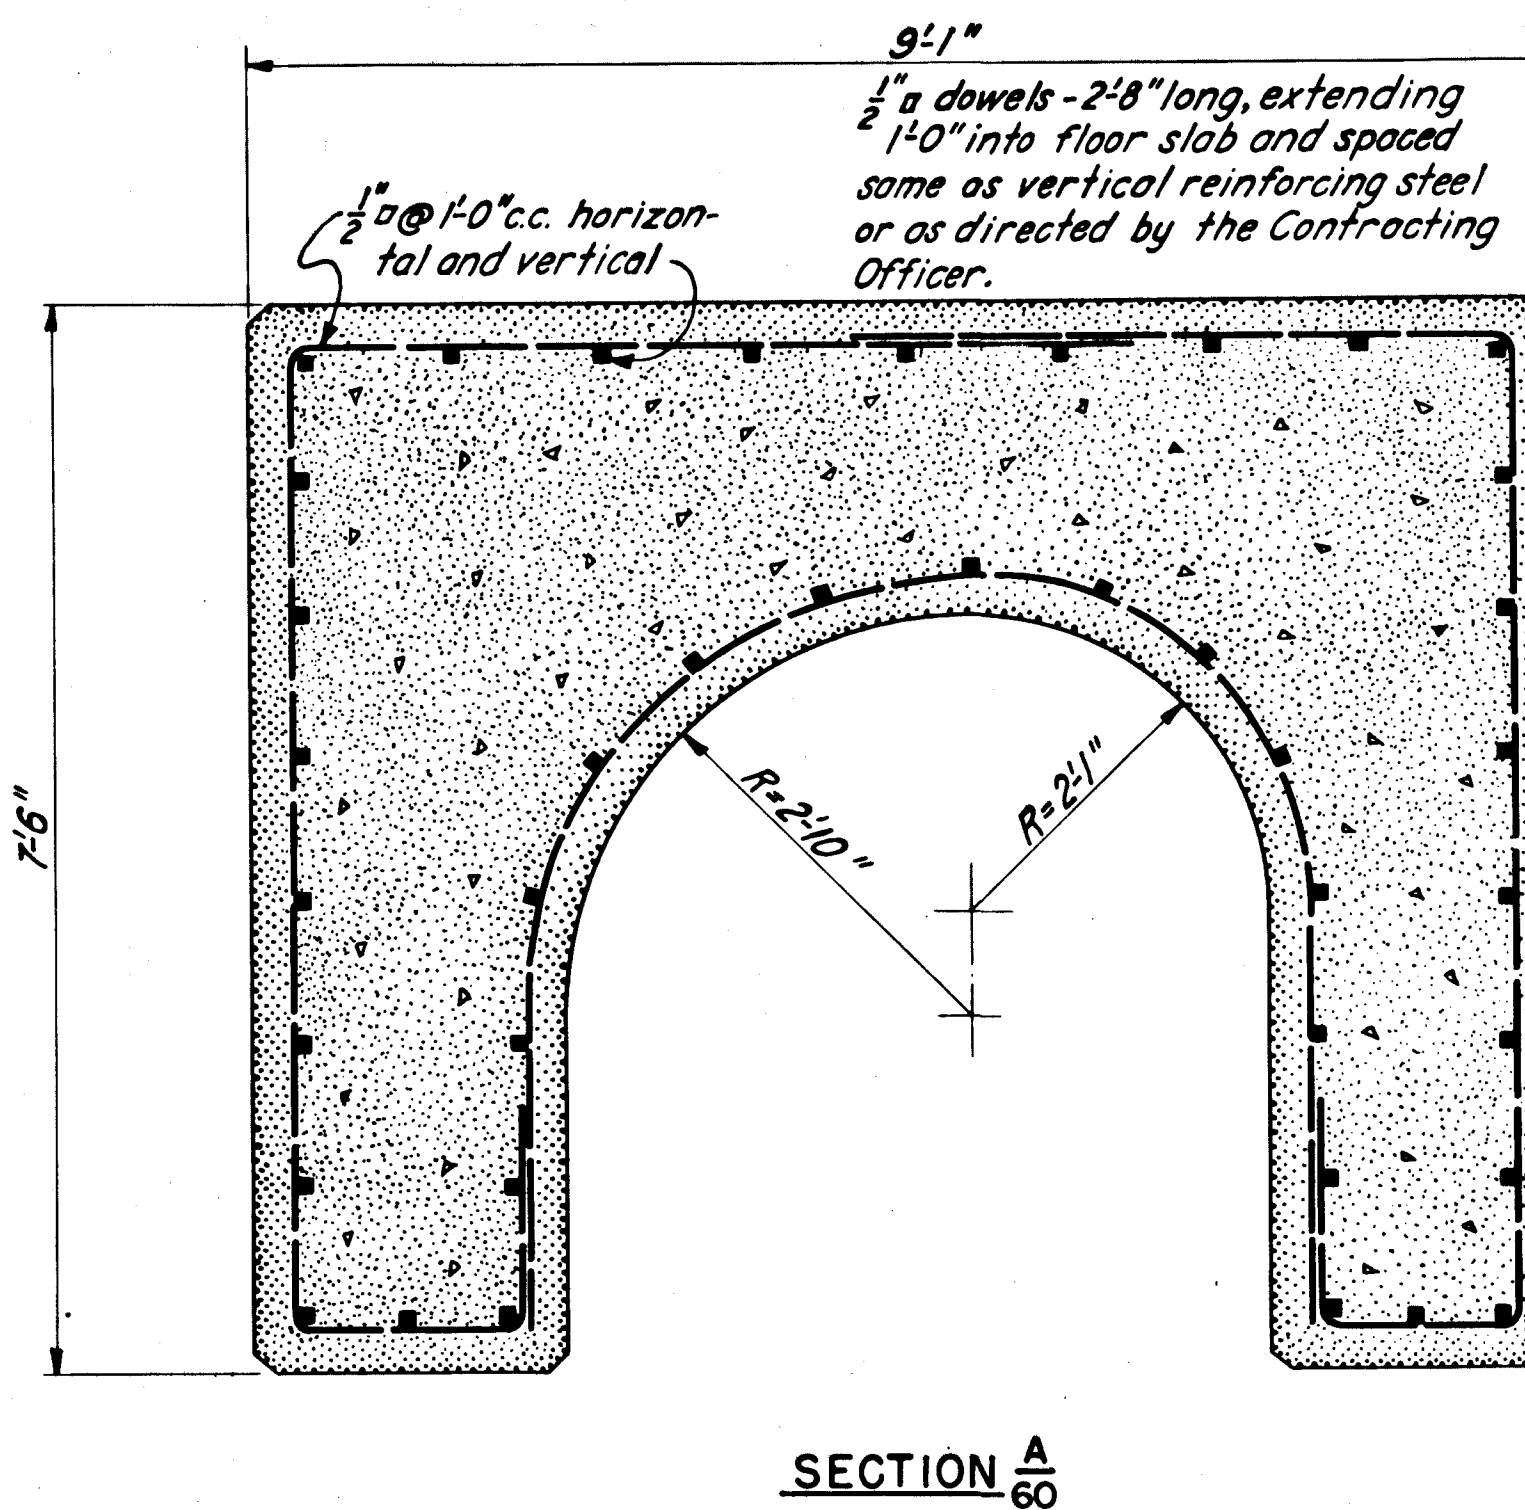


36" PUMP FOUNDATION


SCALE: $\frac{3}{4}$ " = 1'-0"

36" DISCHARGE LINE VALVE FOUNDATION

36" DISCHARGE LINE VALVE FOUNDATION

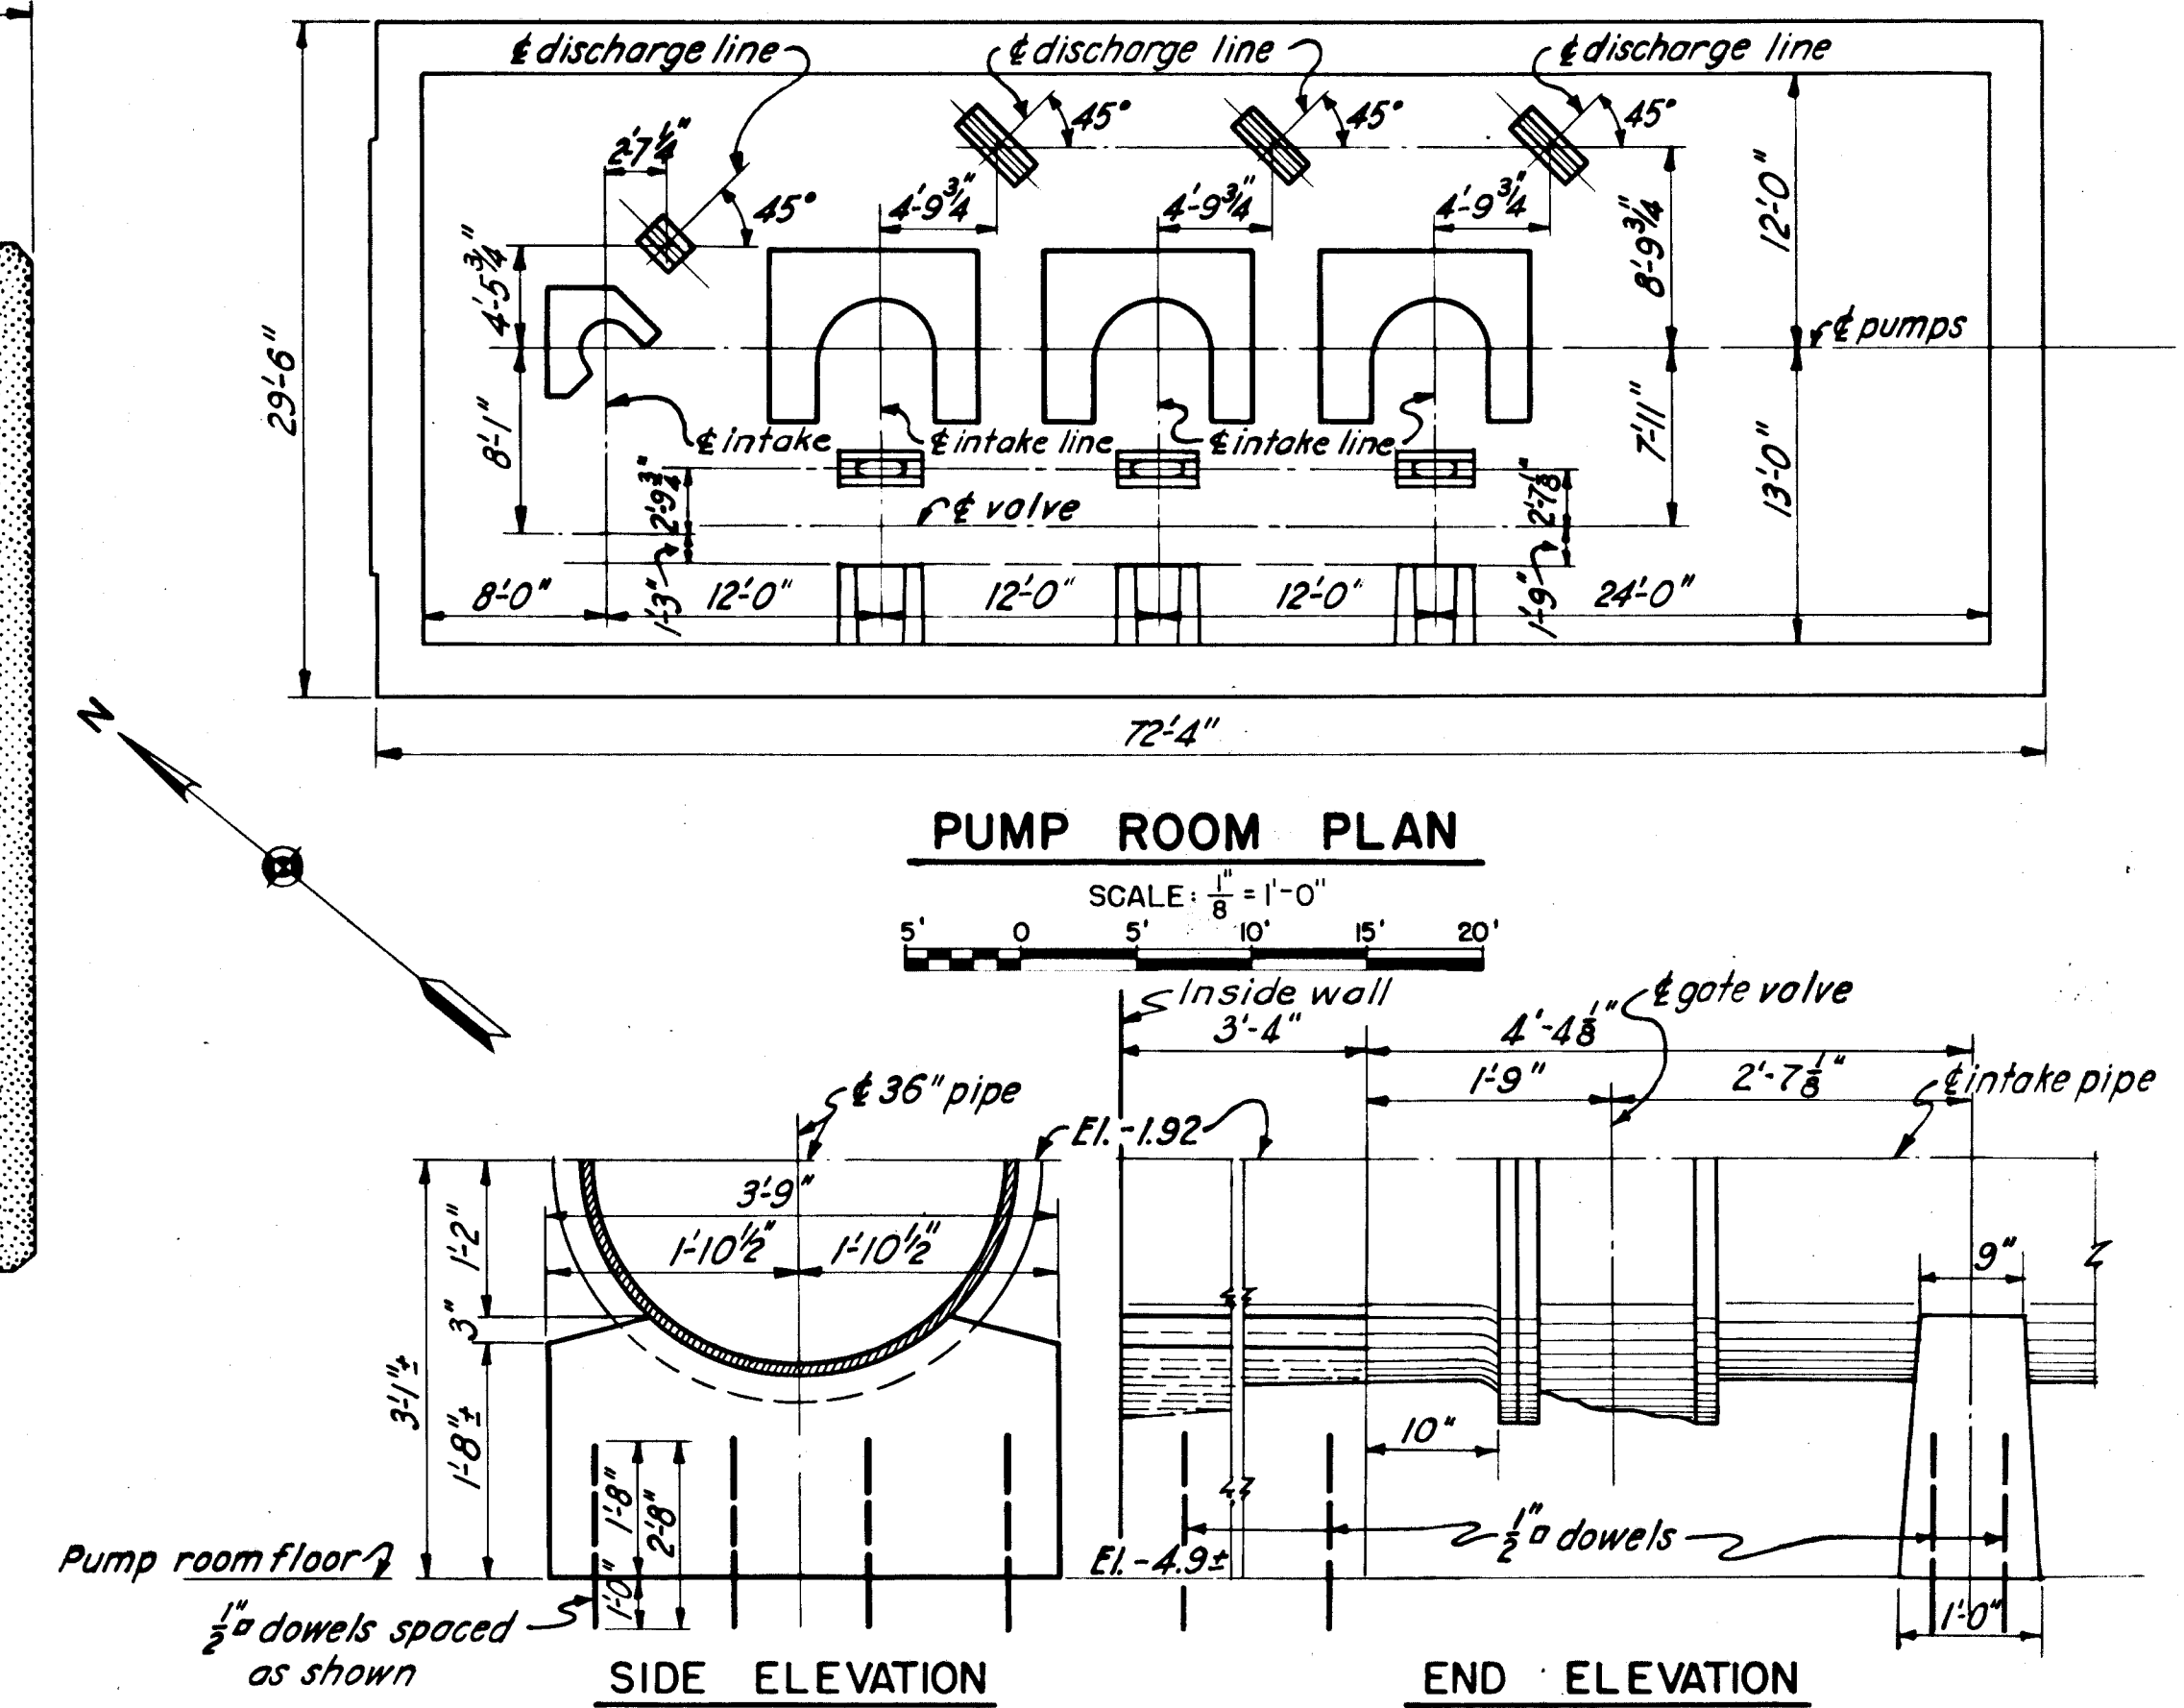SCALE: $\frac{3}{4}$ " = 1'-0"

36" INTAKE LINE VALVE FOUNDATION

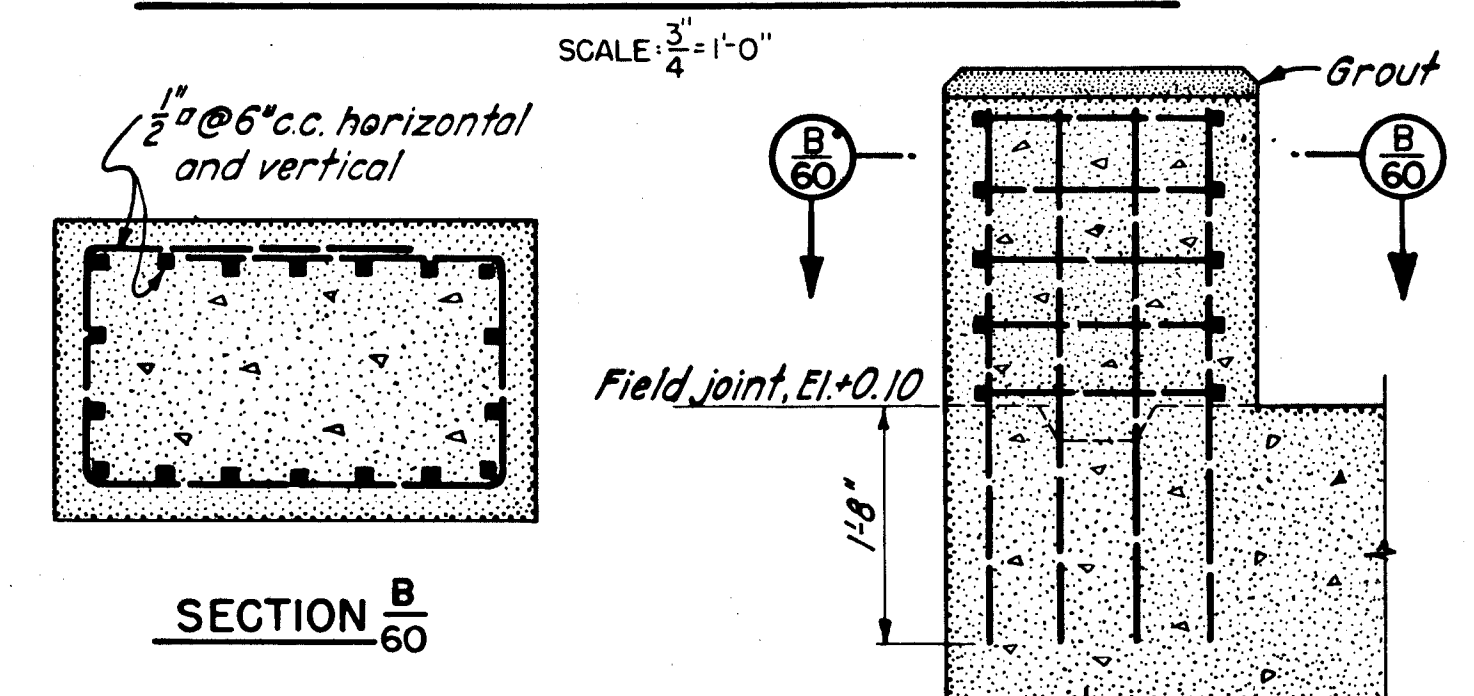

TYPICAL SECTIONS OF PUMP SUPPORTS

SCALE: $\frac{3}{4}$ " = 1'-0"

NOTES

- All concrete shall be Class A
- Chamfer all exposed corners 1" or as directed by the Contracting Officer.
- Payment for construction of equipment foundations including all materials used therein will be made under Item No. 17.
- Minimum cover for reinforcing steel shall be 2".

KEY	DATE	REVISION (Indicated by Δ)	REV BY	CK BY	AP BY
	12-31-45	As built revisions			

CONNECTICUT RIVER FLOOD CONTROL		
NORTH MEADOWS PUMPING STATION		
FISCAL YEAR 1939 SECTION		
PUMPING EQUIPMENT FOUNDATIONS		
HARTFORD, CONN.		
CONNECTICUT RIVER	CONNECTICUT	
IN 62 SHEETS	SCALE: 3/4 IN. = 1 FT.	SHEET NO. 60
U. S. ENGINEER OFFICE, PROVIDENCE, R. I., - SEPT. 1939		
SUBMITTED:	APPROVAL RECOMMENDED:	APPROVED:
(Signed) B. N. N. N.	(Signed) J. D. D. D.	(Signed) M. M. M. M.
SENIOR ENGINEER	PRINCIPAL ENGINEER	LT. COL., CORPS OF ENGINEERS
HEAD DESIGN SECTION	CHIEF F. C. ENGINEERING DIV.	DISTRICT ENGINEER
DESIGNED:	DRAWN: J. A. C.	FILE NO. CT-4-1950
(Signed) J. A. C.	TRACED: G. F. B.	
ASSOC. ENGINEER	CHECKED: G. F. B.	