



PLAN

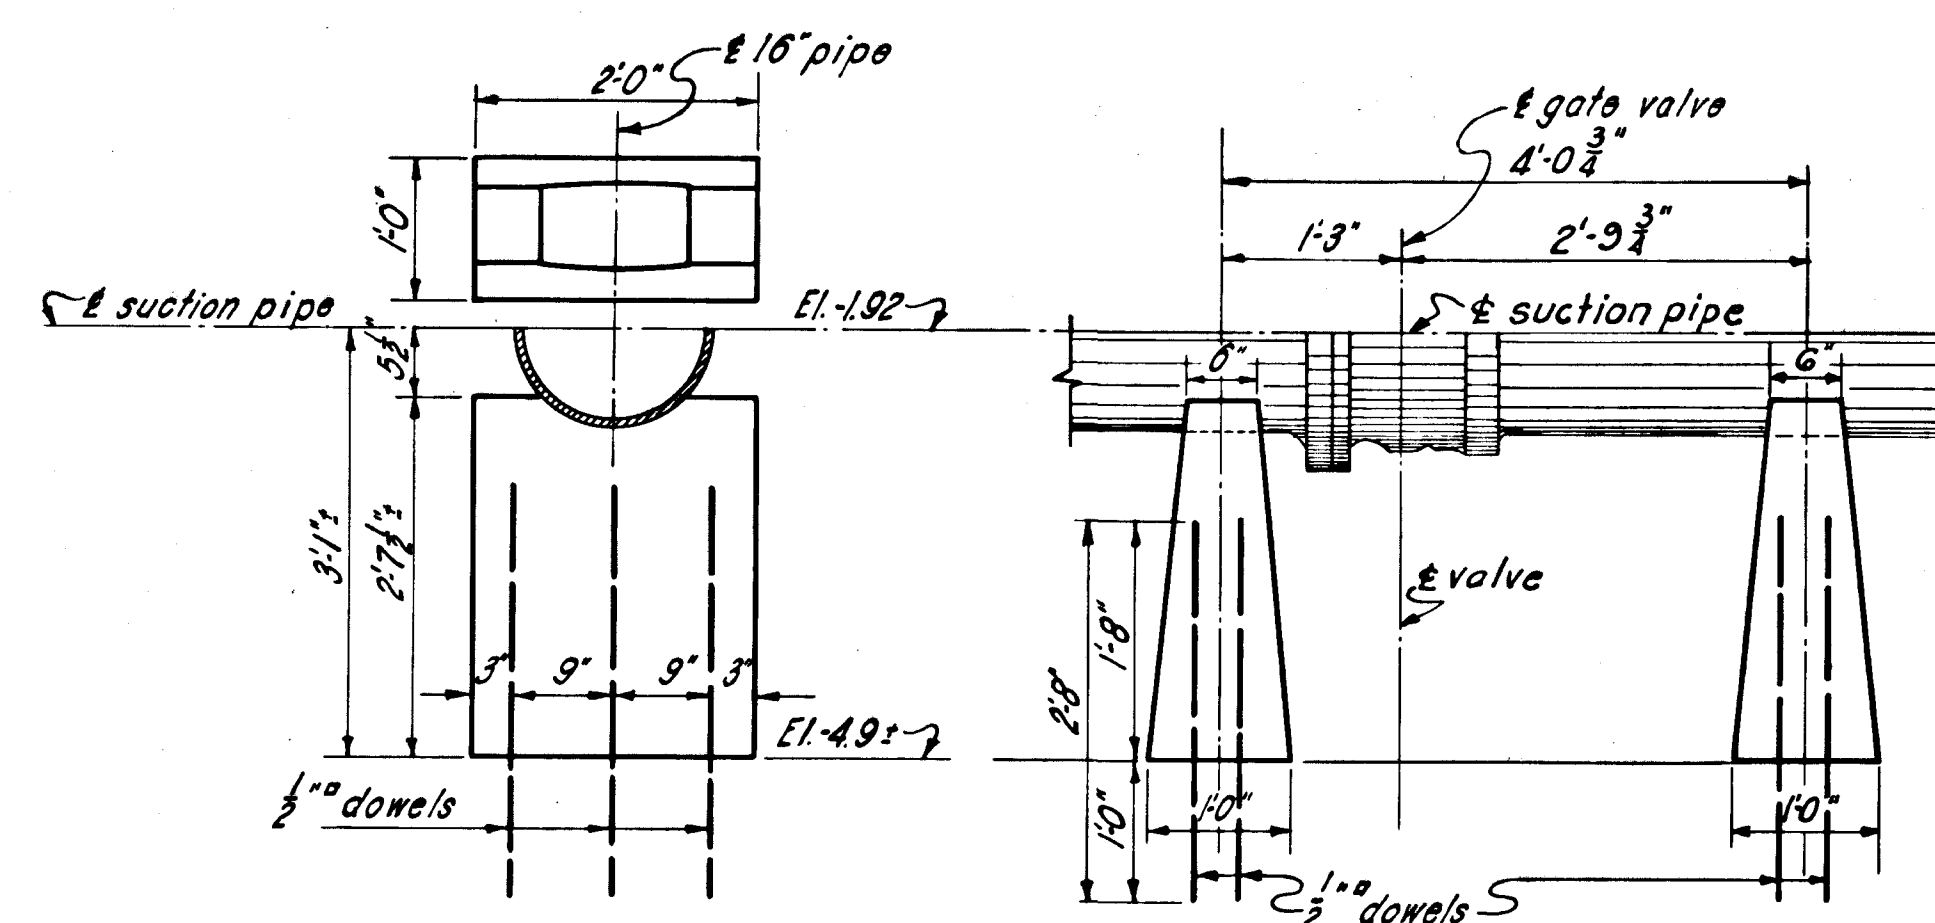


16" SUCTION LINE VALVE FOUNDATION

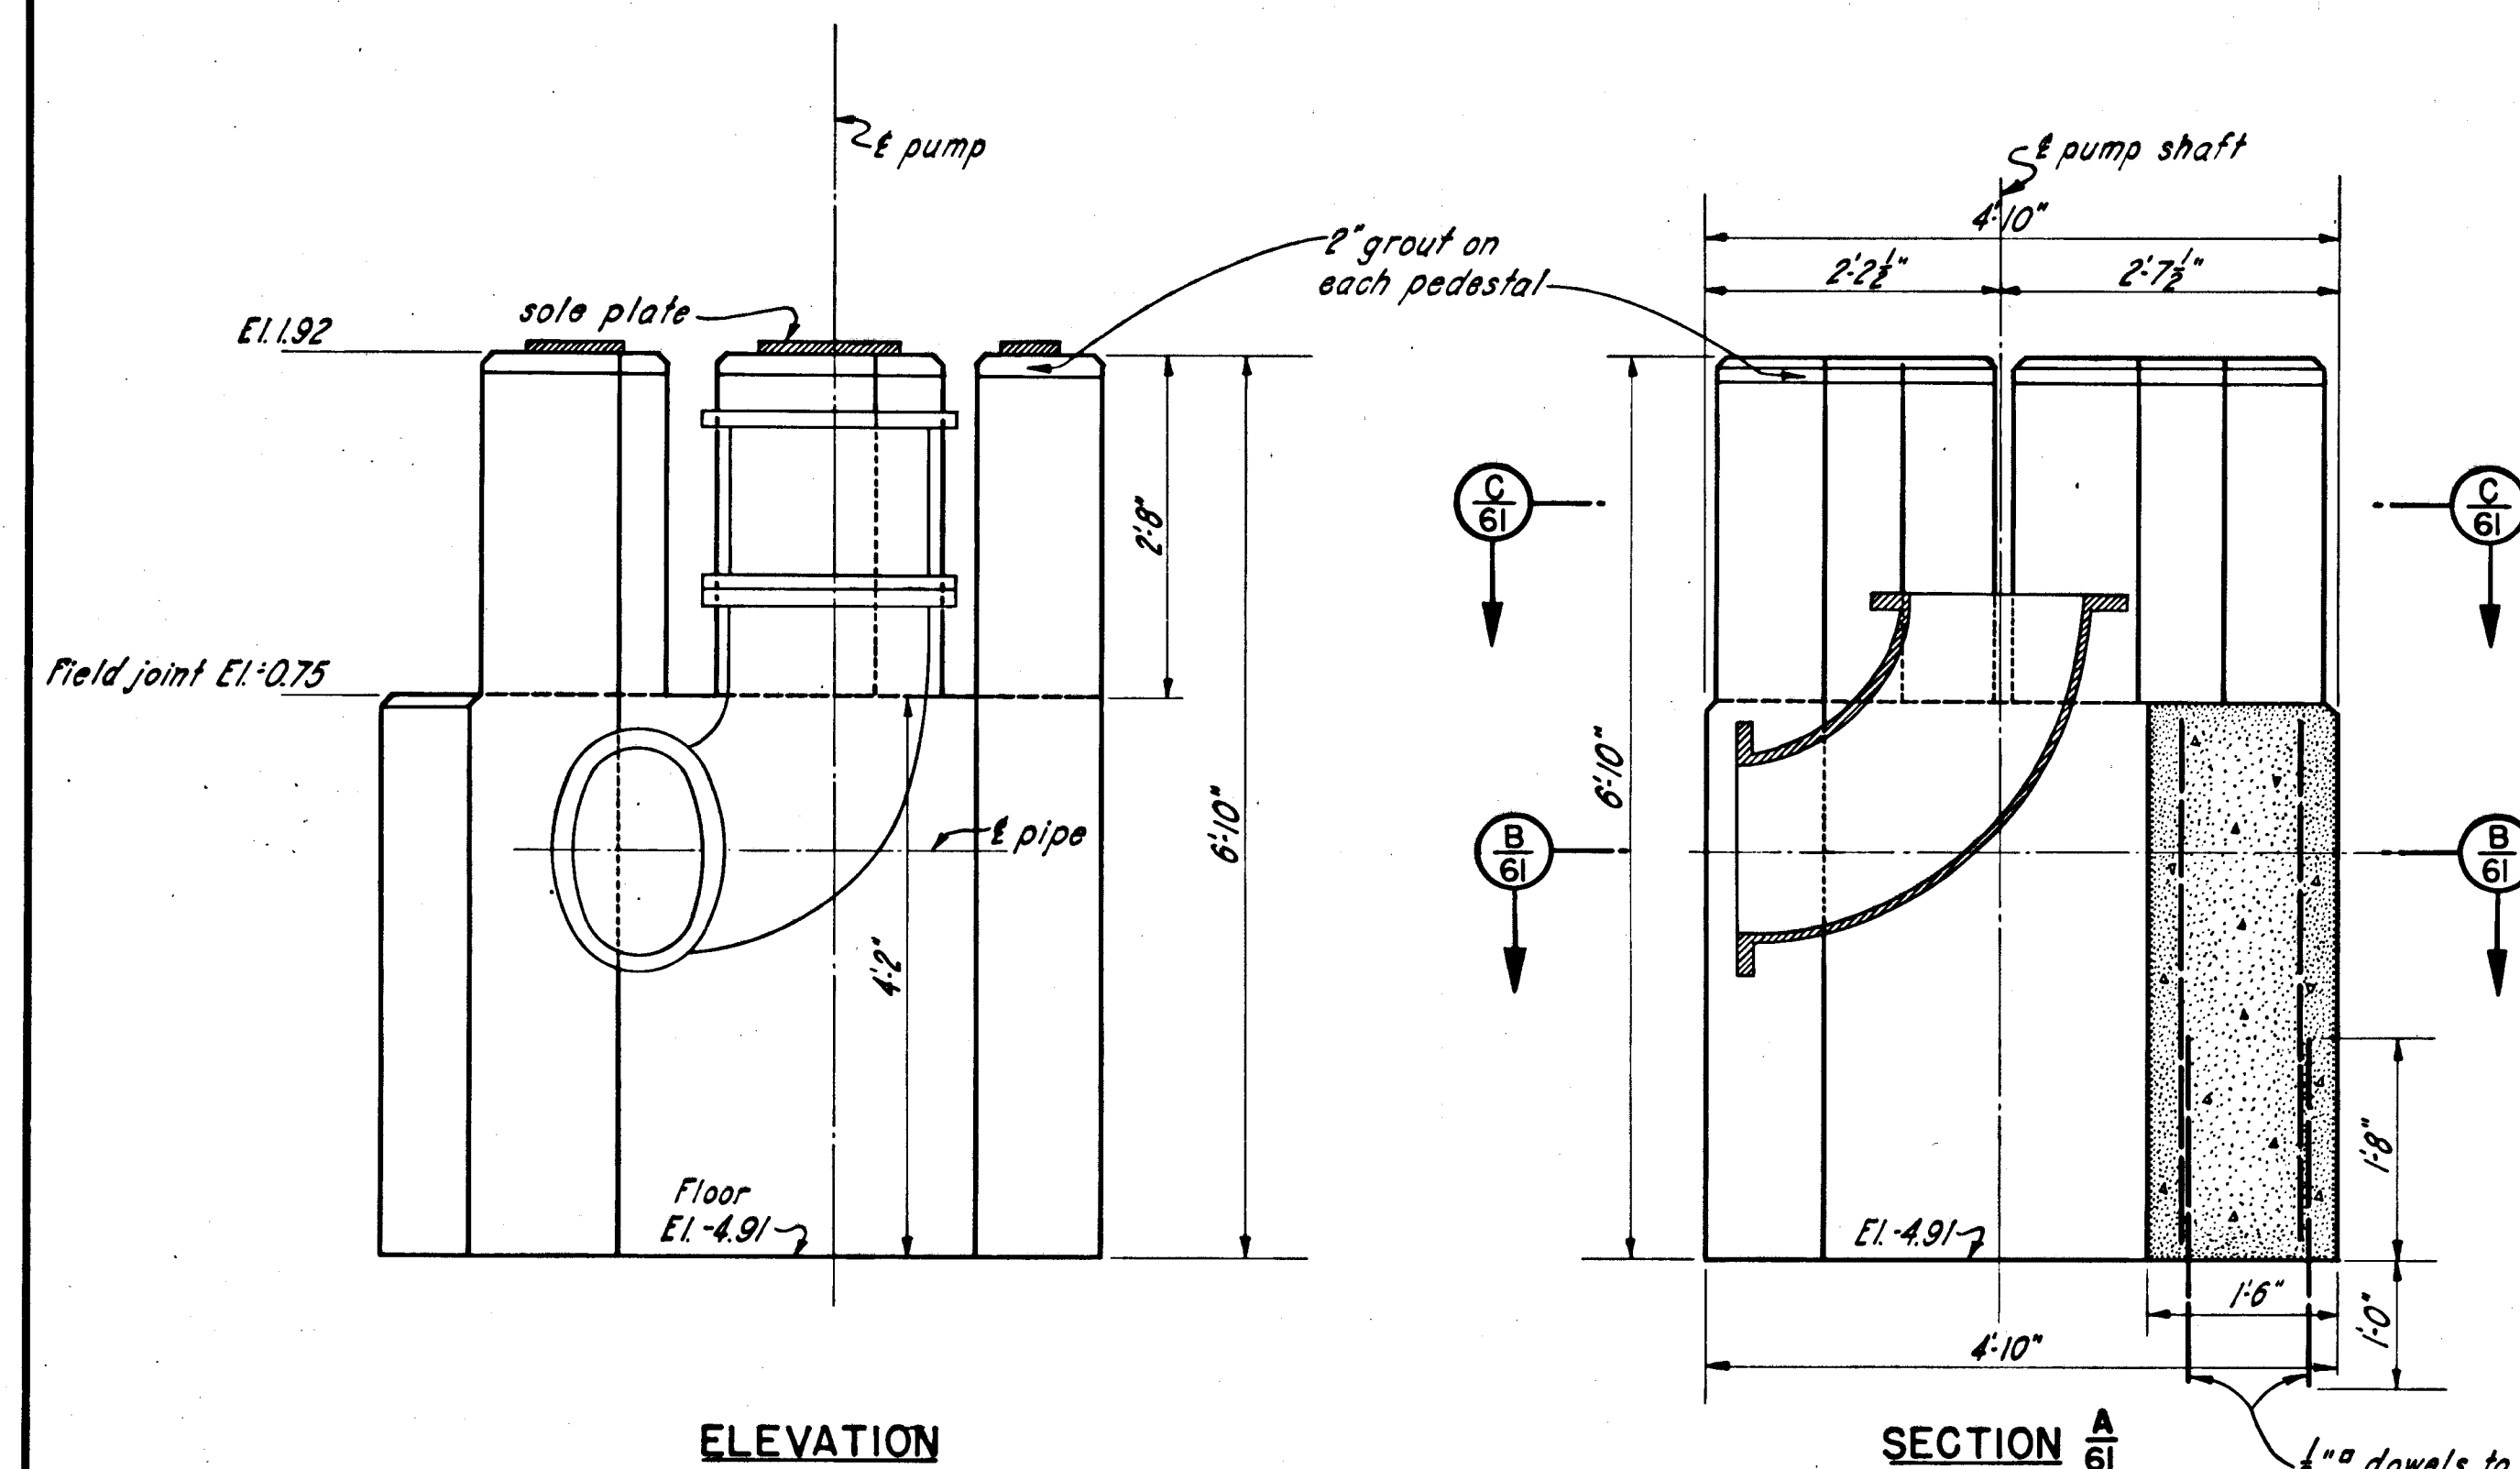


ELEVATION

16" PUMP FOUNDATION

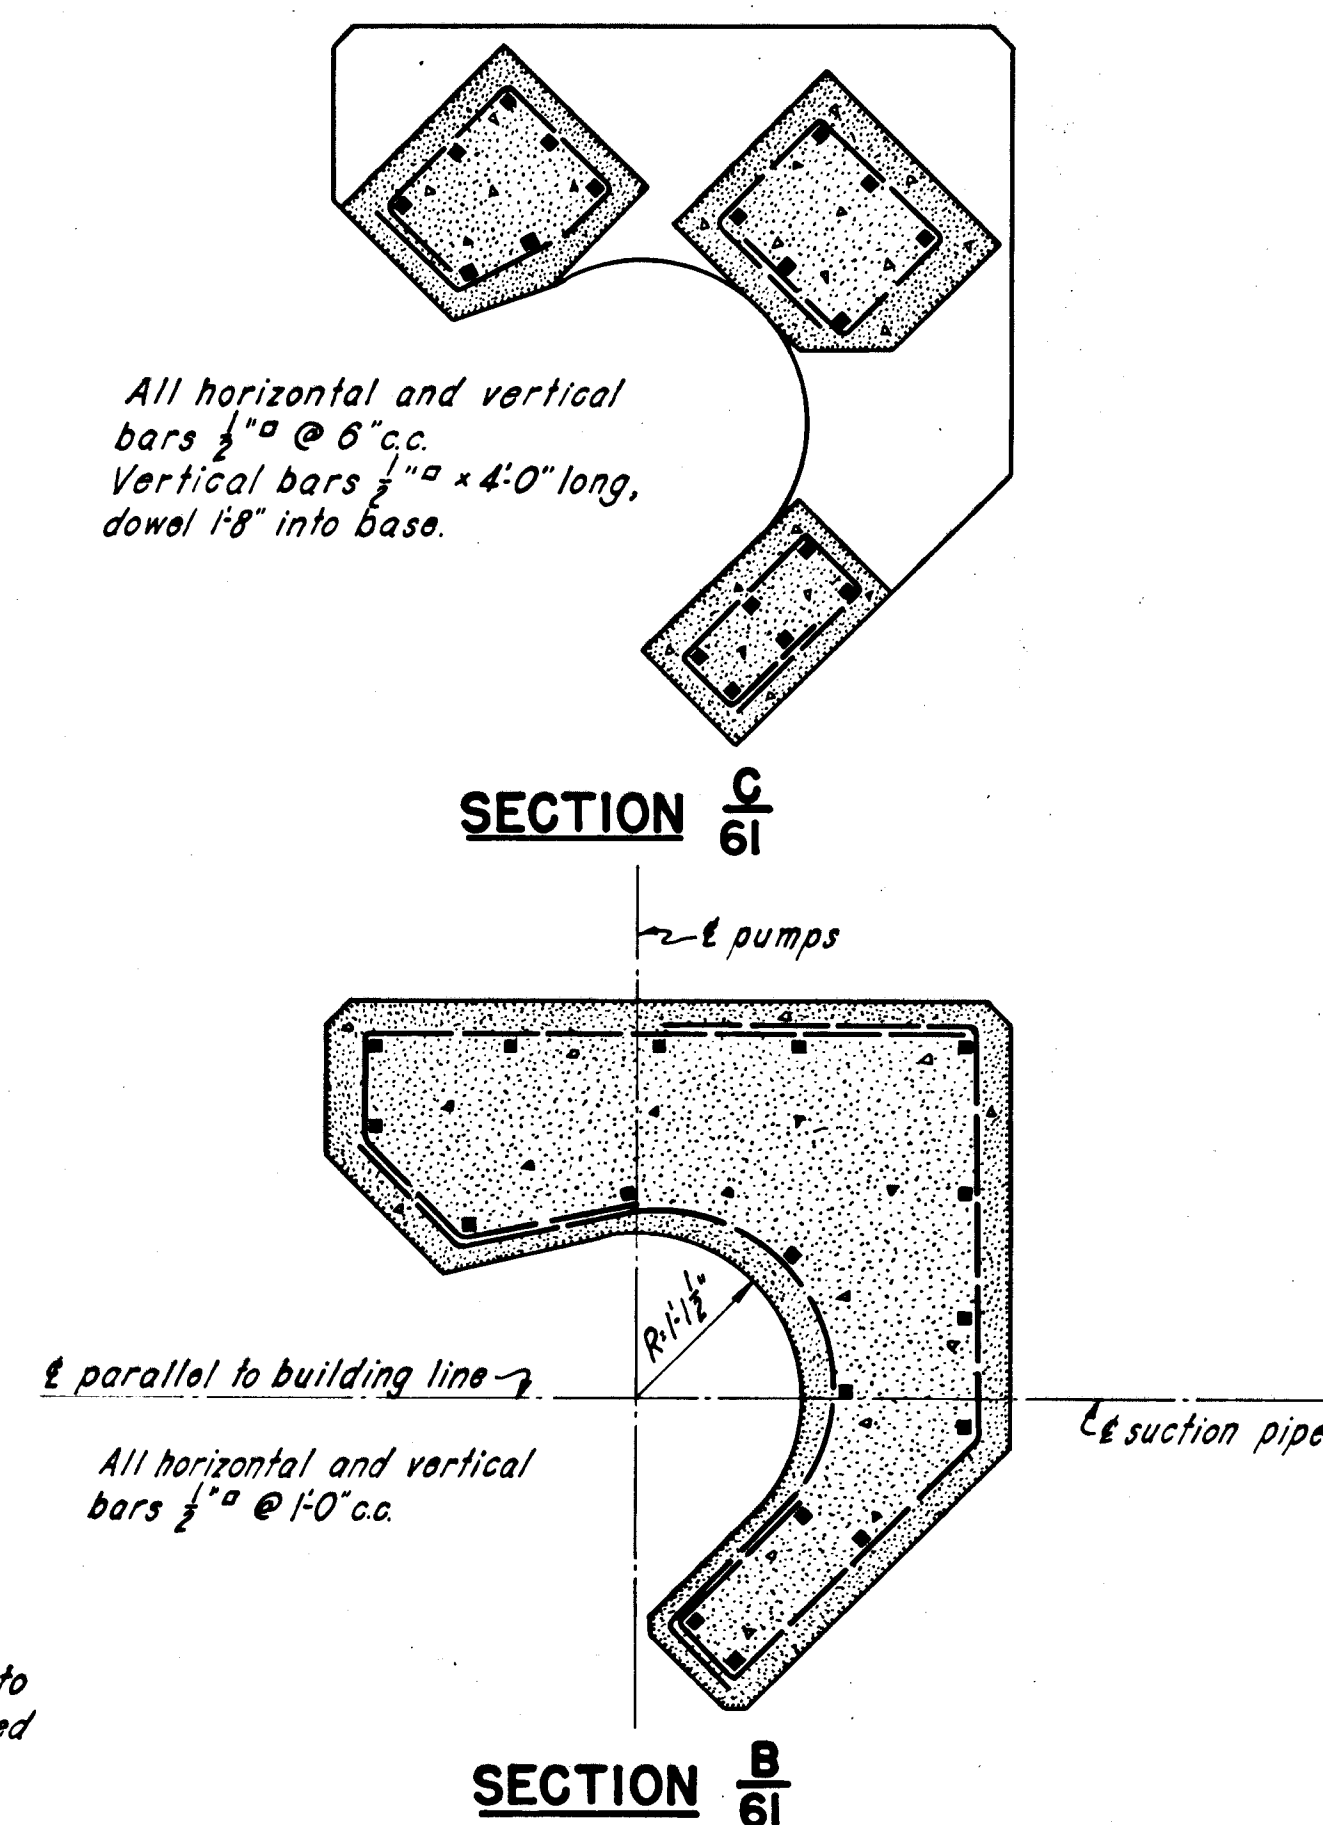

SECTION **C**
61

SECTION B
6

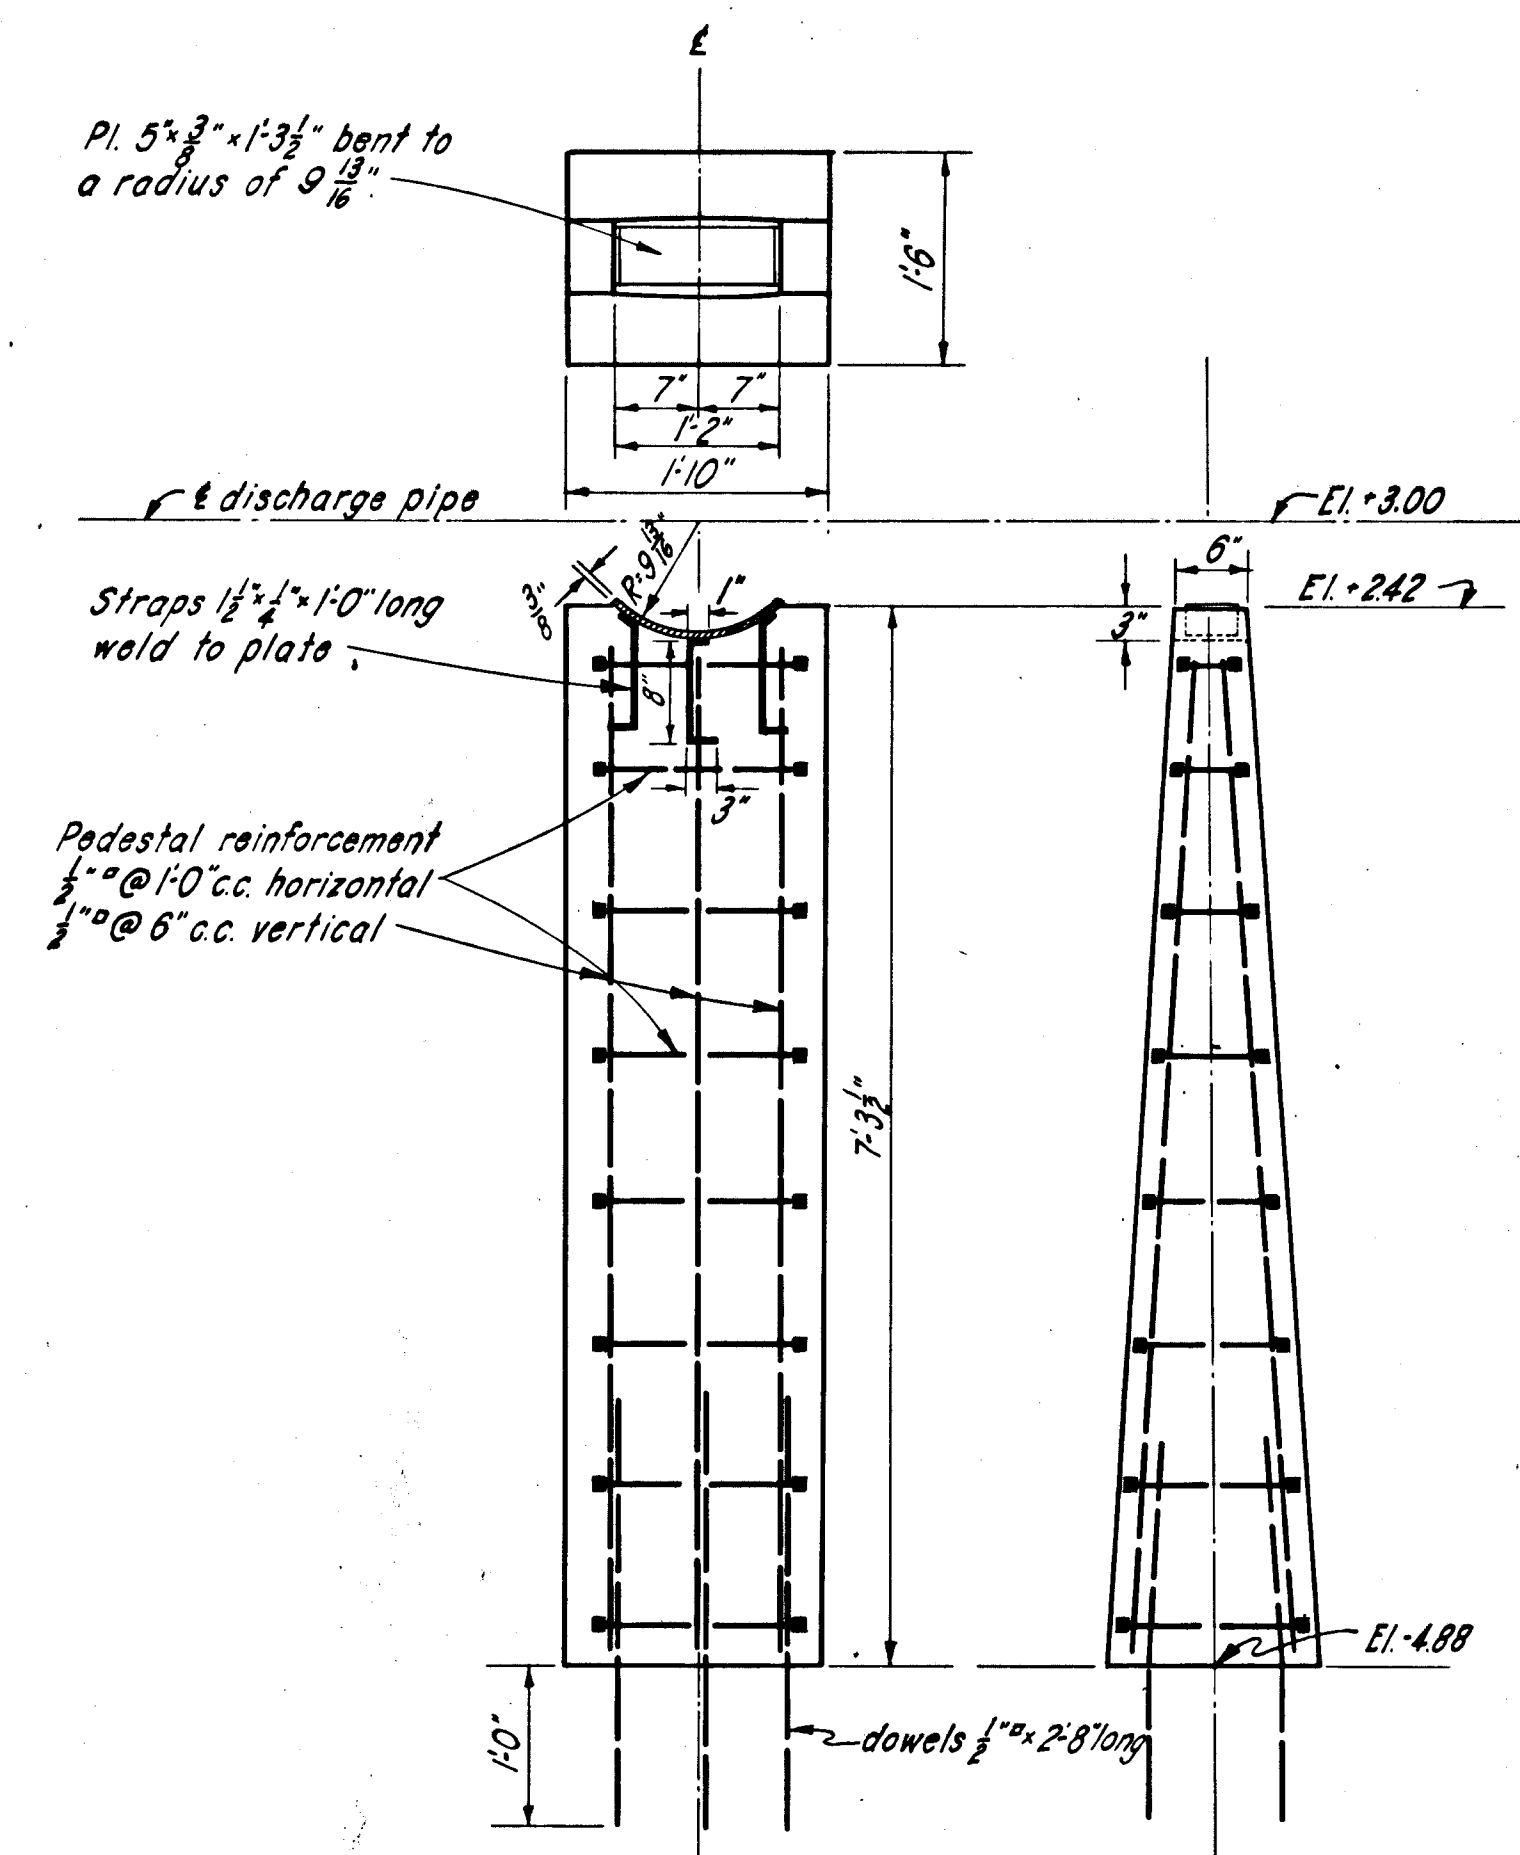

16" DISCHARGE LINE FOUNDATION

NOTES

NOTES

Concrete shall be class "A".

Chamfer all exposed corners 1" or as directed by contracting officer.

Payment for construction of equipment foundations including all materials used therein will be made under bid item No. 17.

Minimum cover for reinforcing steel shall be 2"

	12-31-45	As built revisions			
KEY	DATE	REVISION (Indicated by Δ)	REVBY	CK.BY	AP.

CONNECTICUT RIVER		FLOOD CONTROL	
NORTH MEADOWS PUMPING STATION			
FISCAL YEAR 1939 SECTION			
PUMPING EQUIPMENT FOUNDATIONS			
HARTFORD, CONN.			
CONNECTICUT RIVER		CONNECTICUT	
IN 62 SHEETS		SHEET NO. 61	
U. S. ENGINEER OFFICE, PROVIDENCE, R. I.,		SEPT. 1939	
SUBMITTED: <i>David B. Nichols</i> SENIOR ENGINEER HEAD, DESIGN SECTION	APPROVAL RECOMMENDED: <i>J. D. Burns</i> PRINCIPAL ENGINEER CHIEF F. C. ENGINEERING DIV.	APPROVED: <i>W. H. Mayhew</i> COL., CORPS ENGINEERS DISTRICT ENGINEER	
DESIGNED: <i>A. C. Singwall</i> ASST. ENGINEER	DRAWN: W.H.M. TRACED: J.A.C. CHECKED: <i>dm</i>	FILE NO. CT-4-1951	