

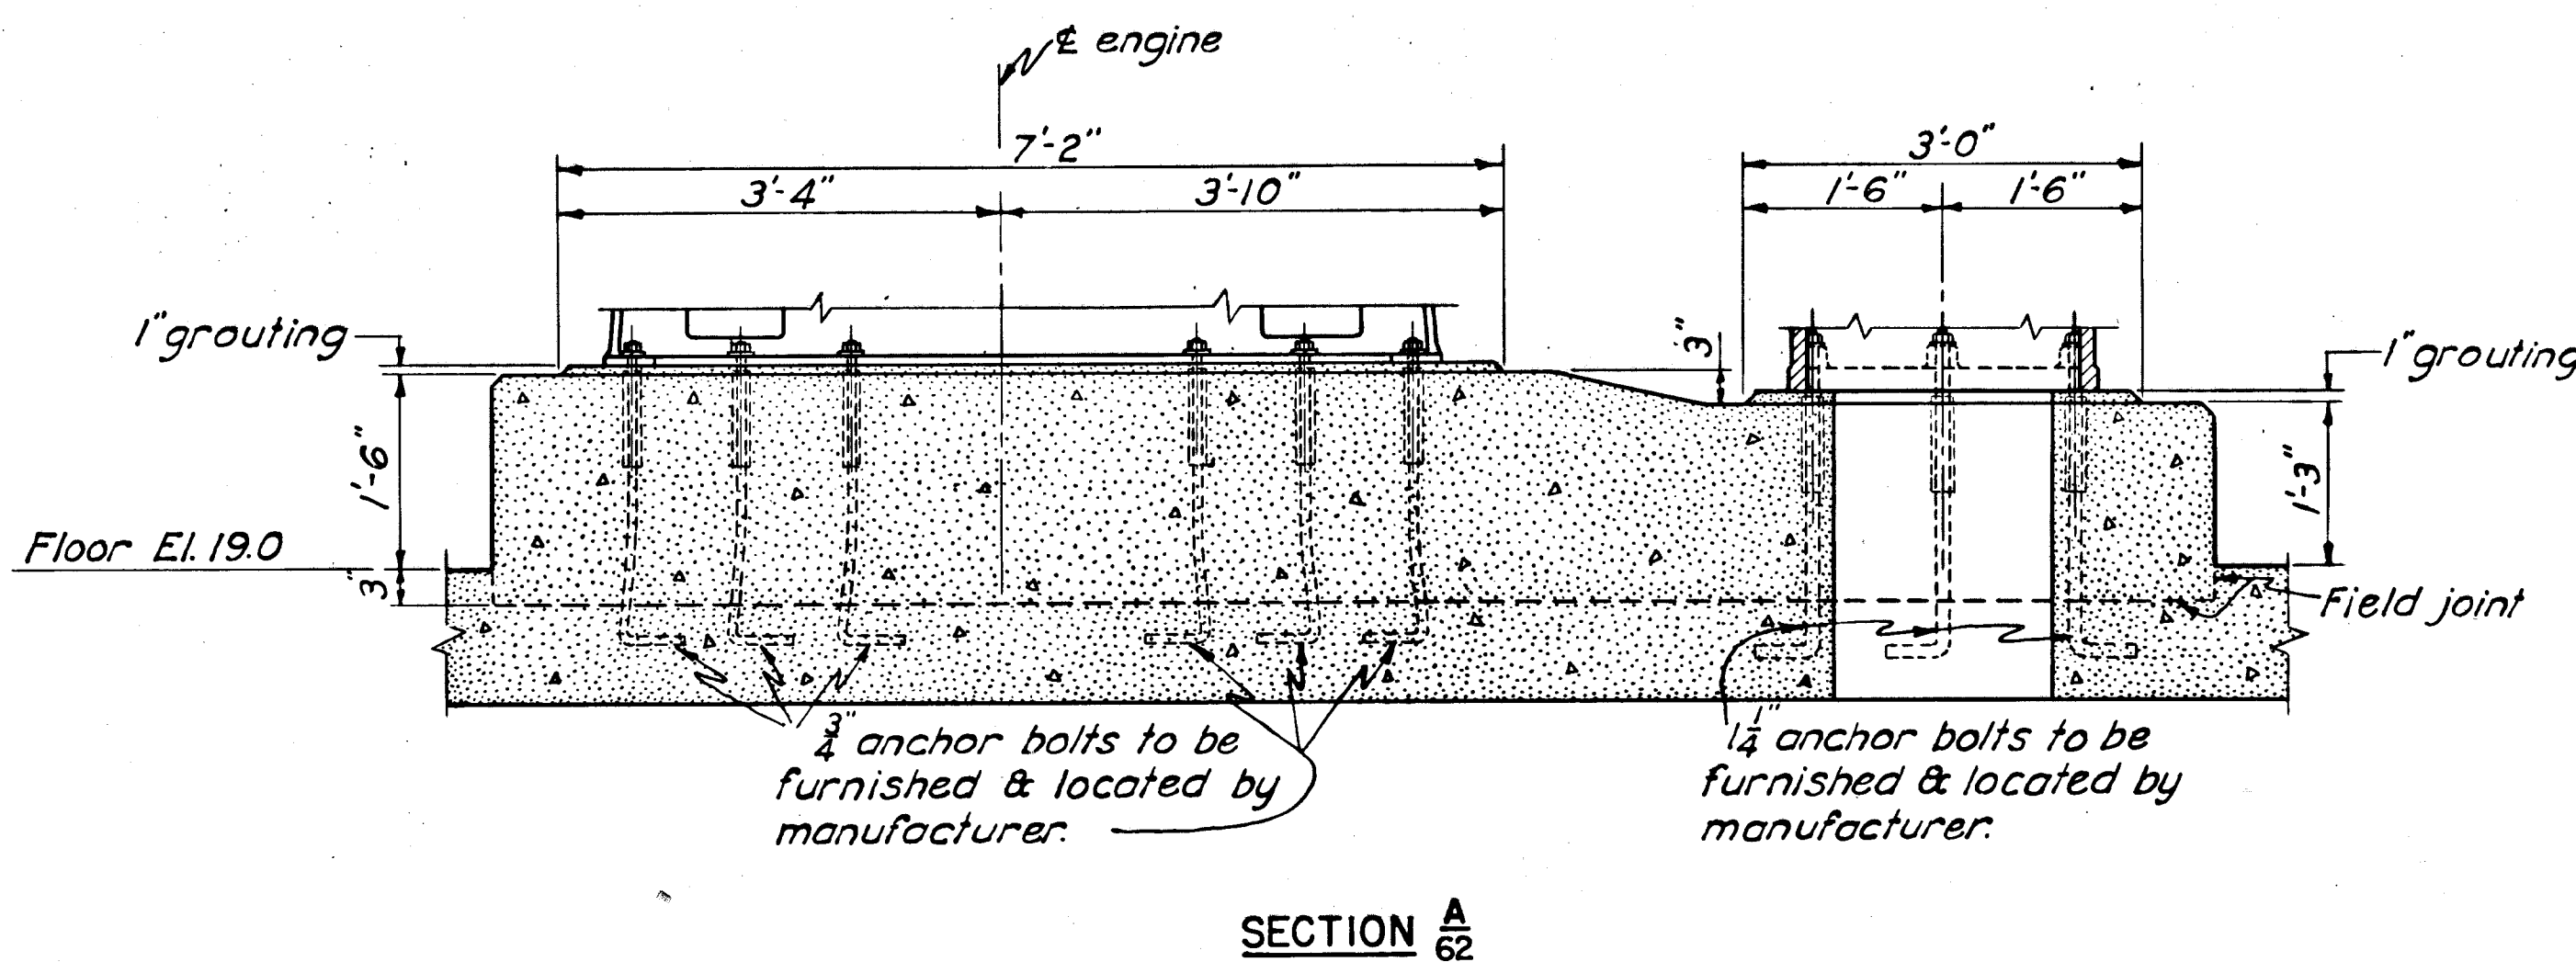
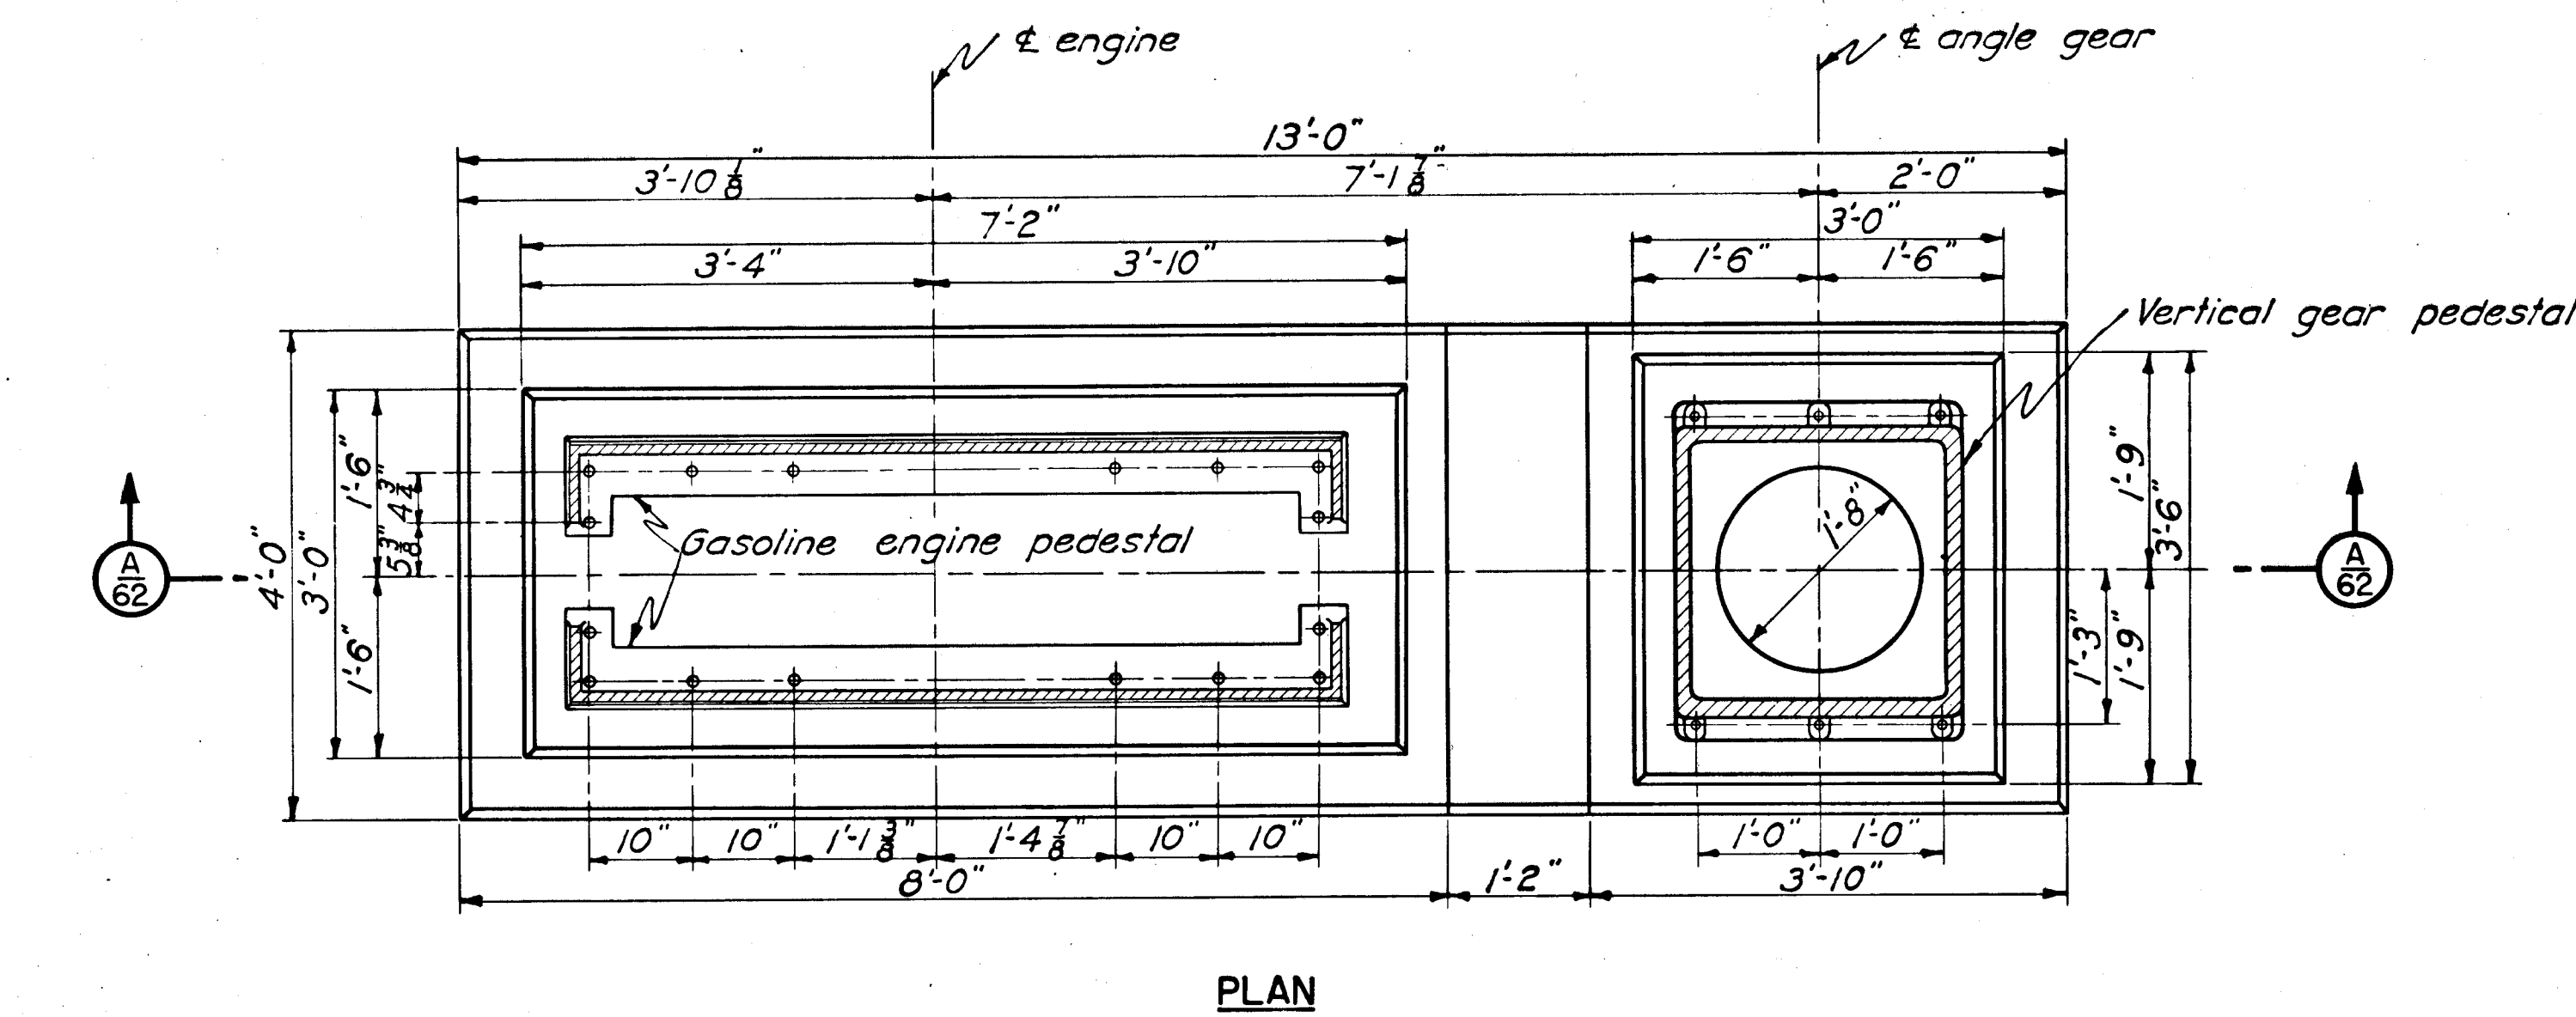


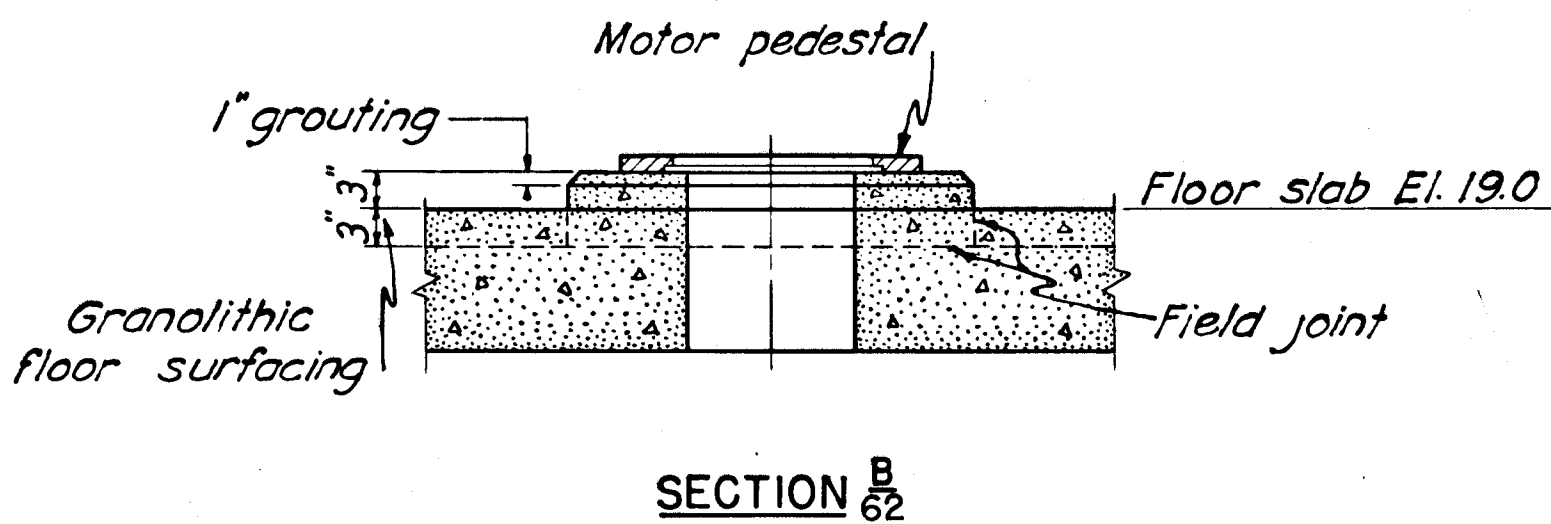

BASE FOR GASOLINE ENGINE AND GEAR UNIT

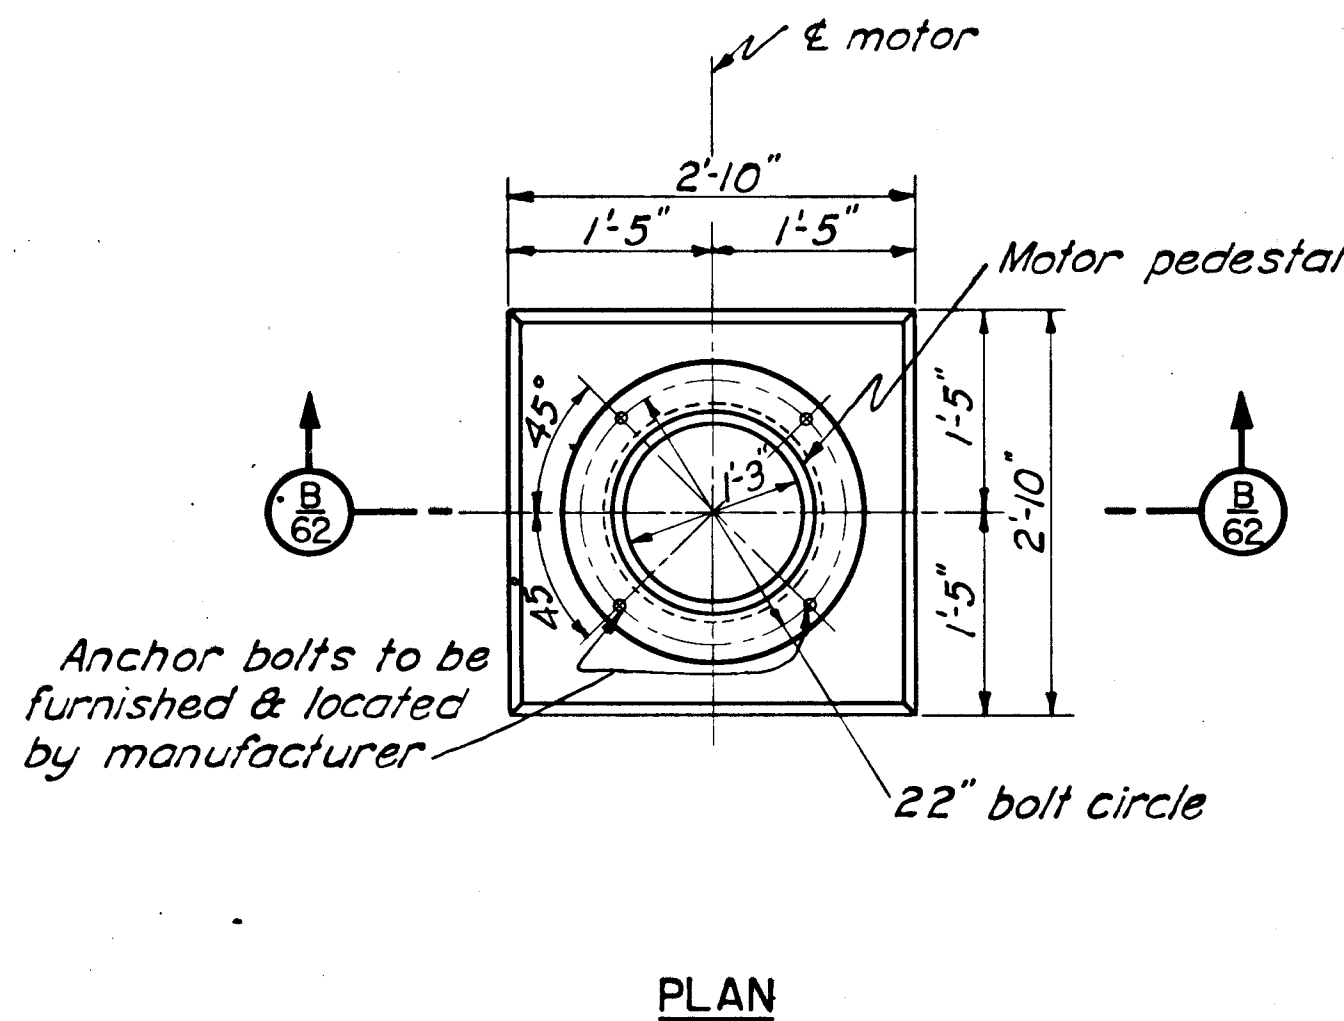

BASE FOR ELECTRIC MOTOR

NOTES:
Concrete shall be Class "A".
Chamfer all exposed corners 1 inch or as directed by the contracting officer.
Payment for construction of equipment foundations including all materials used therein will be made under bid item No. 17.

KEY	DATE	REVISION	(Indicated by Δ)	REV. BY	CK. BY	AP. BY
	12-31-45	As built				

CONNECTICUT RIVER FLOOD CONTROL		
NORTH MEADOWS PUMPING STATION		
FISCAL YEAR 1939 SECTION		
EQUIPMENT FOUNDATIONS		
HARTFORD, CONN.		
CONNECTICUT RIVER	CONNECTICUT	
IN 62 SHEETS	SCALE: 3/4 IN. = 1 FT.	SHEET NO. 62
U. S. ENGINEER OFFICE, PROVIDENCE, R. I., SEPT. 1939		
SUBMITTED: <i>David B. Nichols</i>	APPROVAL RECOMMENDED: <i>J. S. Osburn</i>	APPROVED: <i>M. H. M.</i>
SENIOR ENGINEER	PRINCIPAL ENGINEER	LTCOL., CORPS OF ENGINEERS
HEAD, DESIGN SECTION	CHIEF F. C. ENGINEERING DIV.	DISTRICT ENGINEER
DESIGNED: <i>J. C. Sigmond</i>	DRAWN: J. H. L.	FILE NO. CT-4-1952
ASSOC. ENGINEER	CHECKED: <i>M. H. M.</i>	