



REFERENCE MAPS

SITE PLAN WEST SERVICE ROAD
HARTFORD, CONNECTICUT SCALE 1" = 50 FT.
NOVEMBER 1993

BOUNDARY SURVEY WEST SERVICE ROAD - WESTON
STREET PREPARED FOR S S A & S REALTY
HARTFORD, CONN. DATE 2-21-98 SCALE 1" = 50'
MAP NO. 98018-1 PREPARED BY AESCHLIMAN
LAND SURVEYING

TYPE OF SURVEY: Improvement Location - Record
Survey Determination Category: Dependent Resurvey
Class of Accuracy: A 12 B 7-2
To my knowledge and belief, this map is substantially correct as noted herein. This survey
was prepared pursuant to the Regulations of Connecticut State Agencies Section 20-300b-1
through 20-300b-20 and the "Standards for Surveys and Maps in the State of Connecticut" as
adopted by the Connecticut Association of Land Surveyors, Inc., on September 26, 1996

Richard A. Siegal
Richard A. Siegal - 16-41401

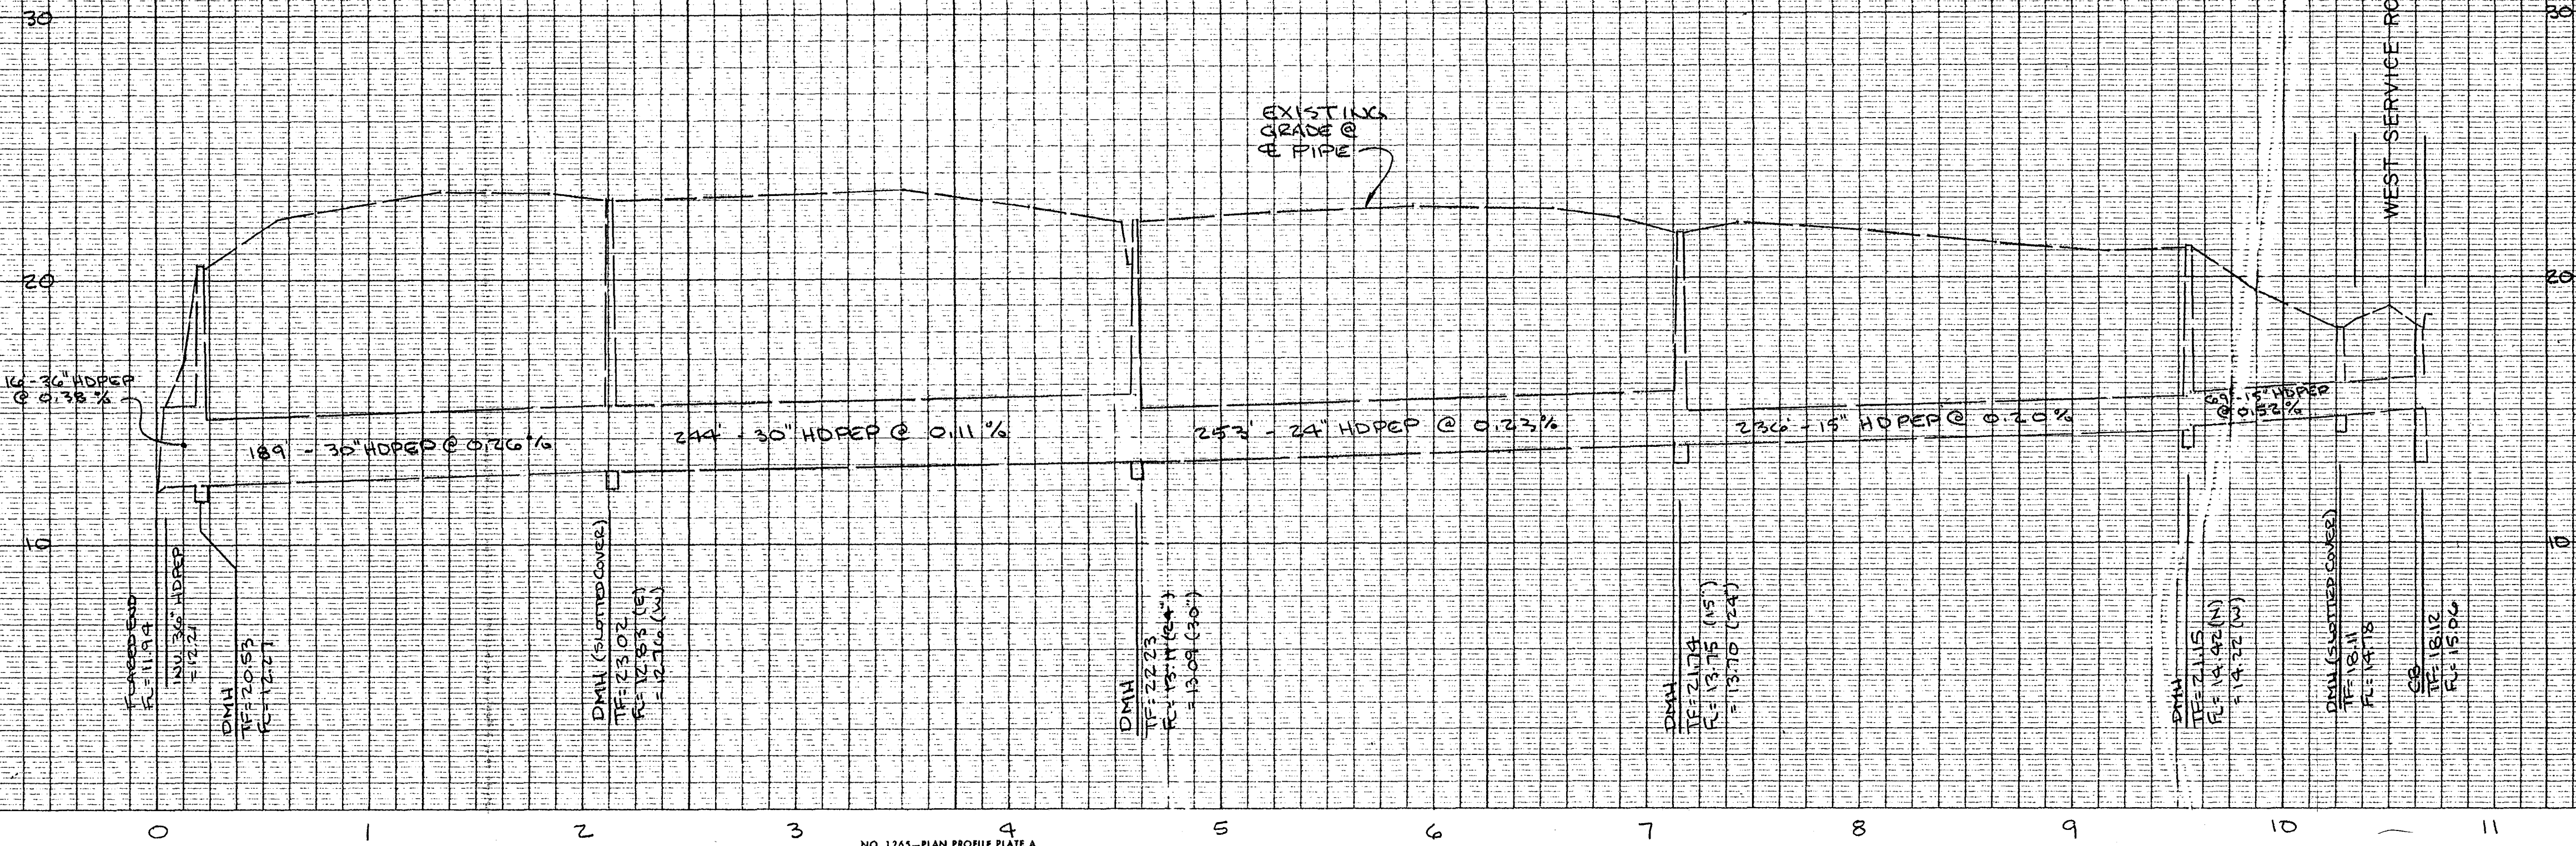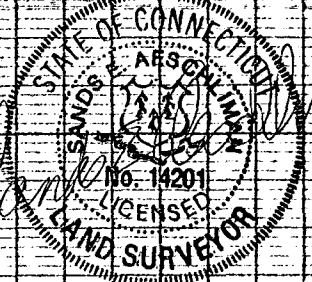

RECORD DRAWING
DRAINAGE PLAN & PROFILE
PREPARED FOR
RUSSO BROS., INC.
HARTFORD, CONN.

AESCHLIMAN LAND SURVEYING
345 BELL STREET
GLASTONBURY, CT 06033
(860) 659-4881
Date 5-19-98 Scale SHOWN Map No. 97057-1