


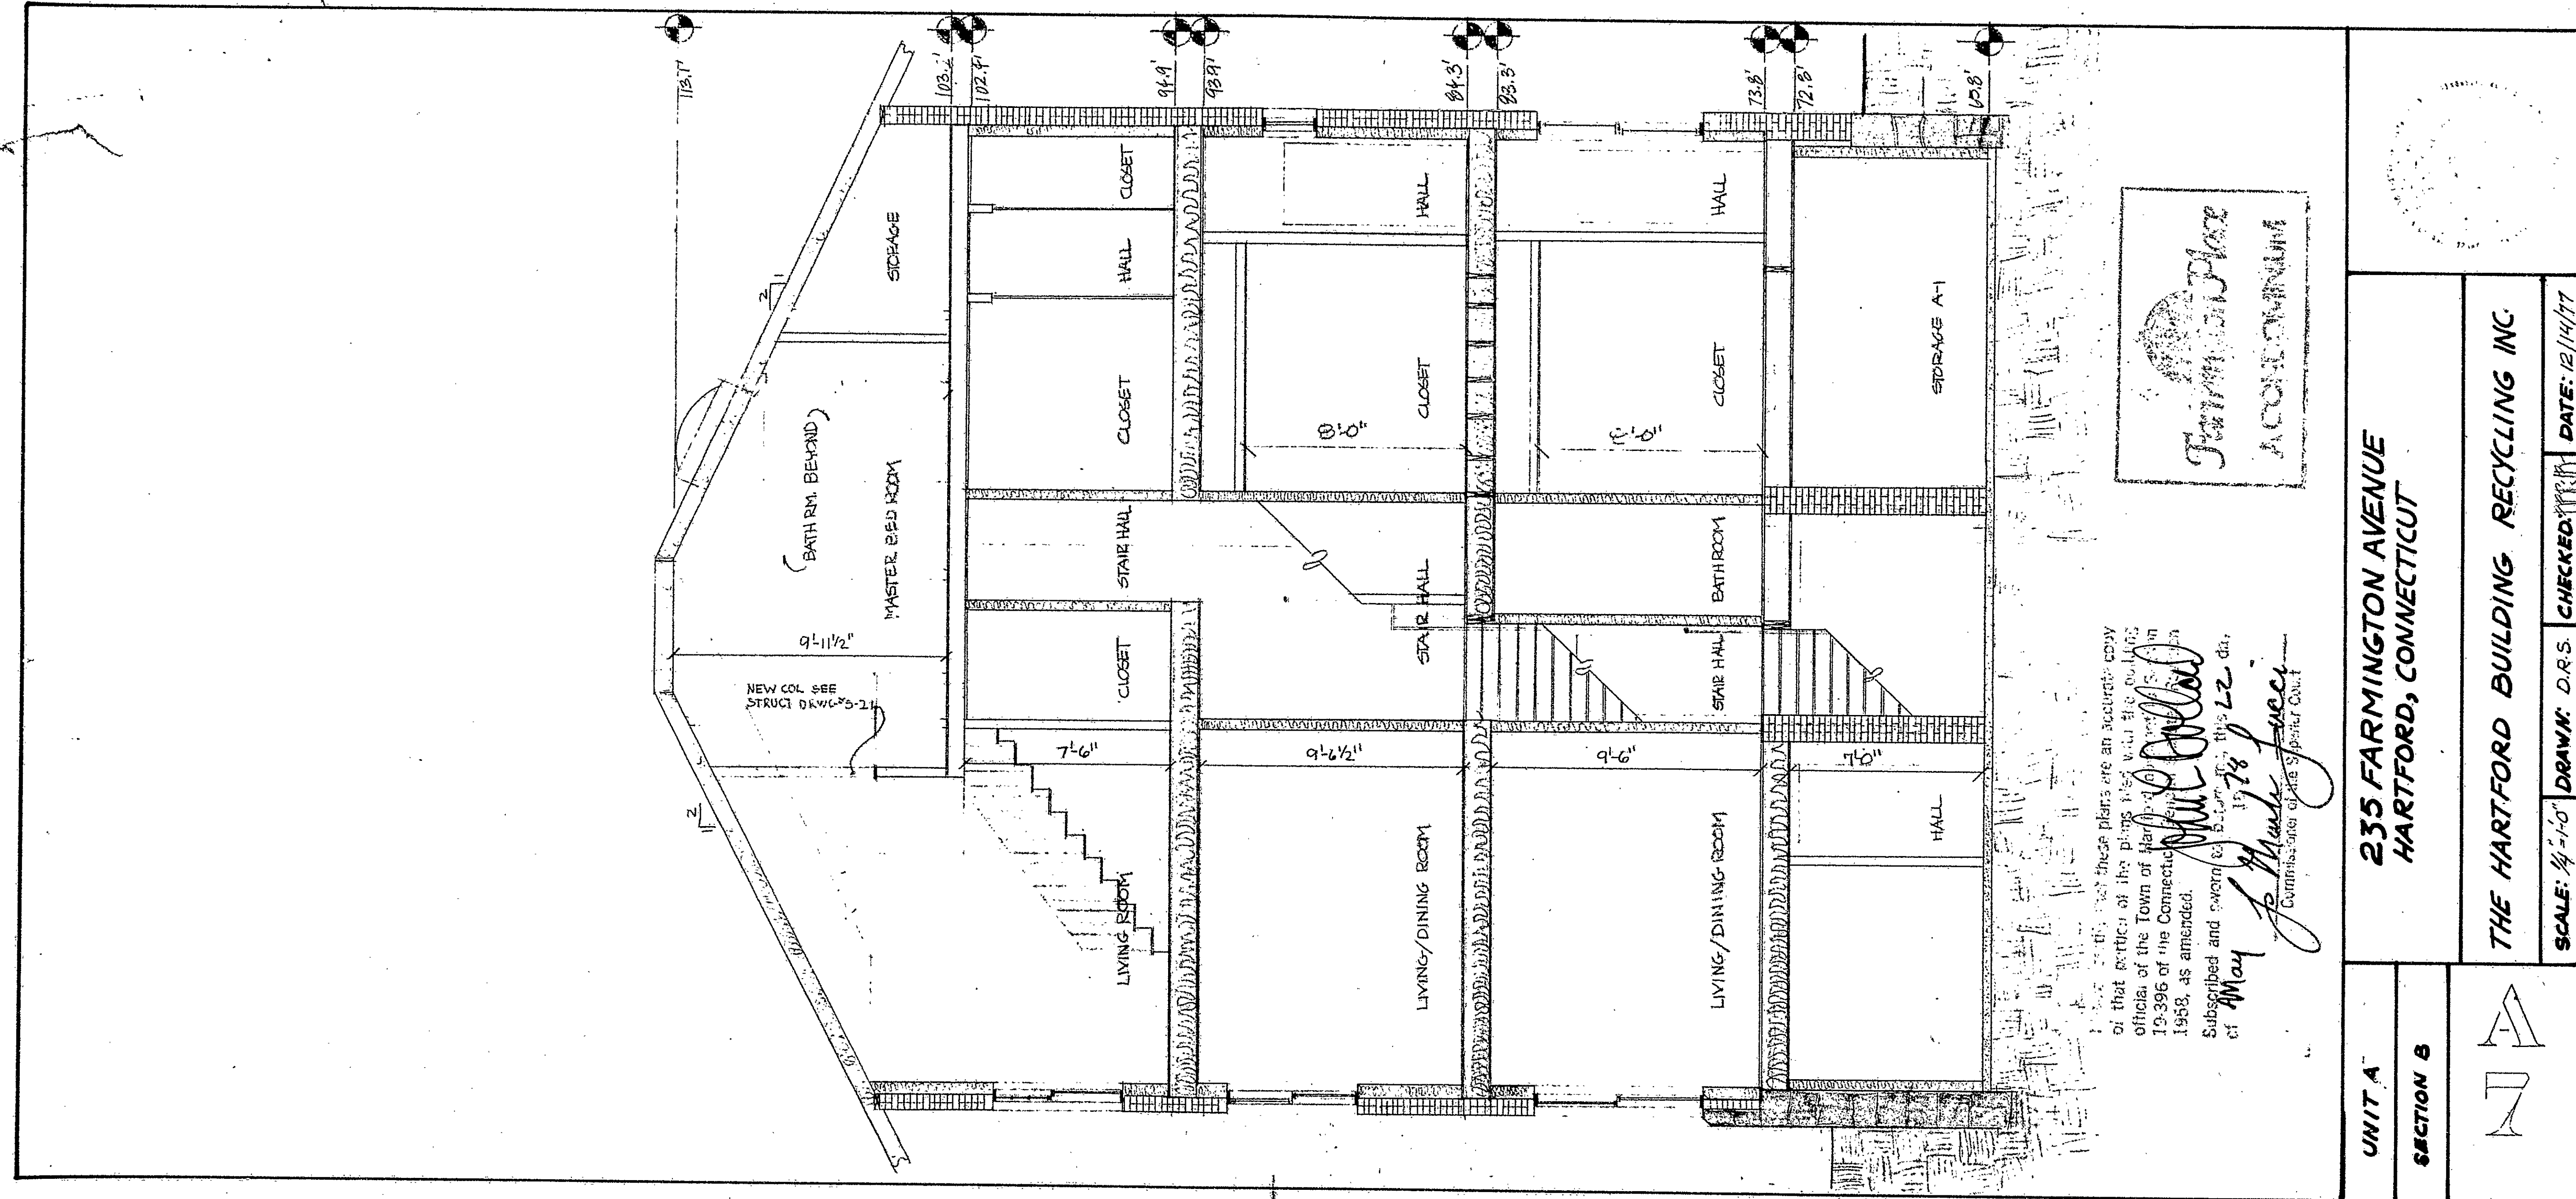

26 12 15 30 BH, JA
RECEIVED BY

