



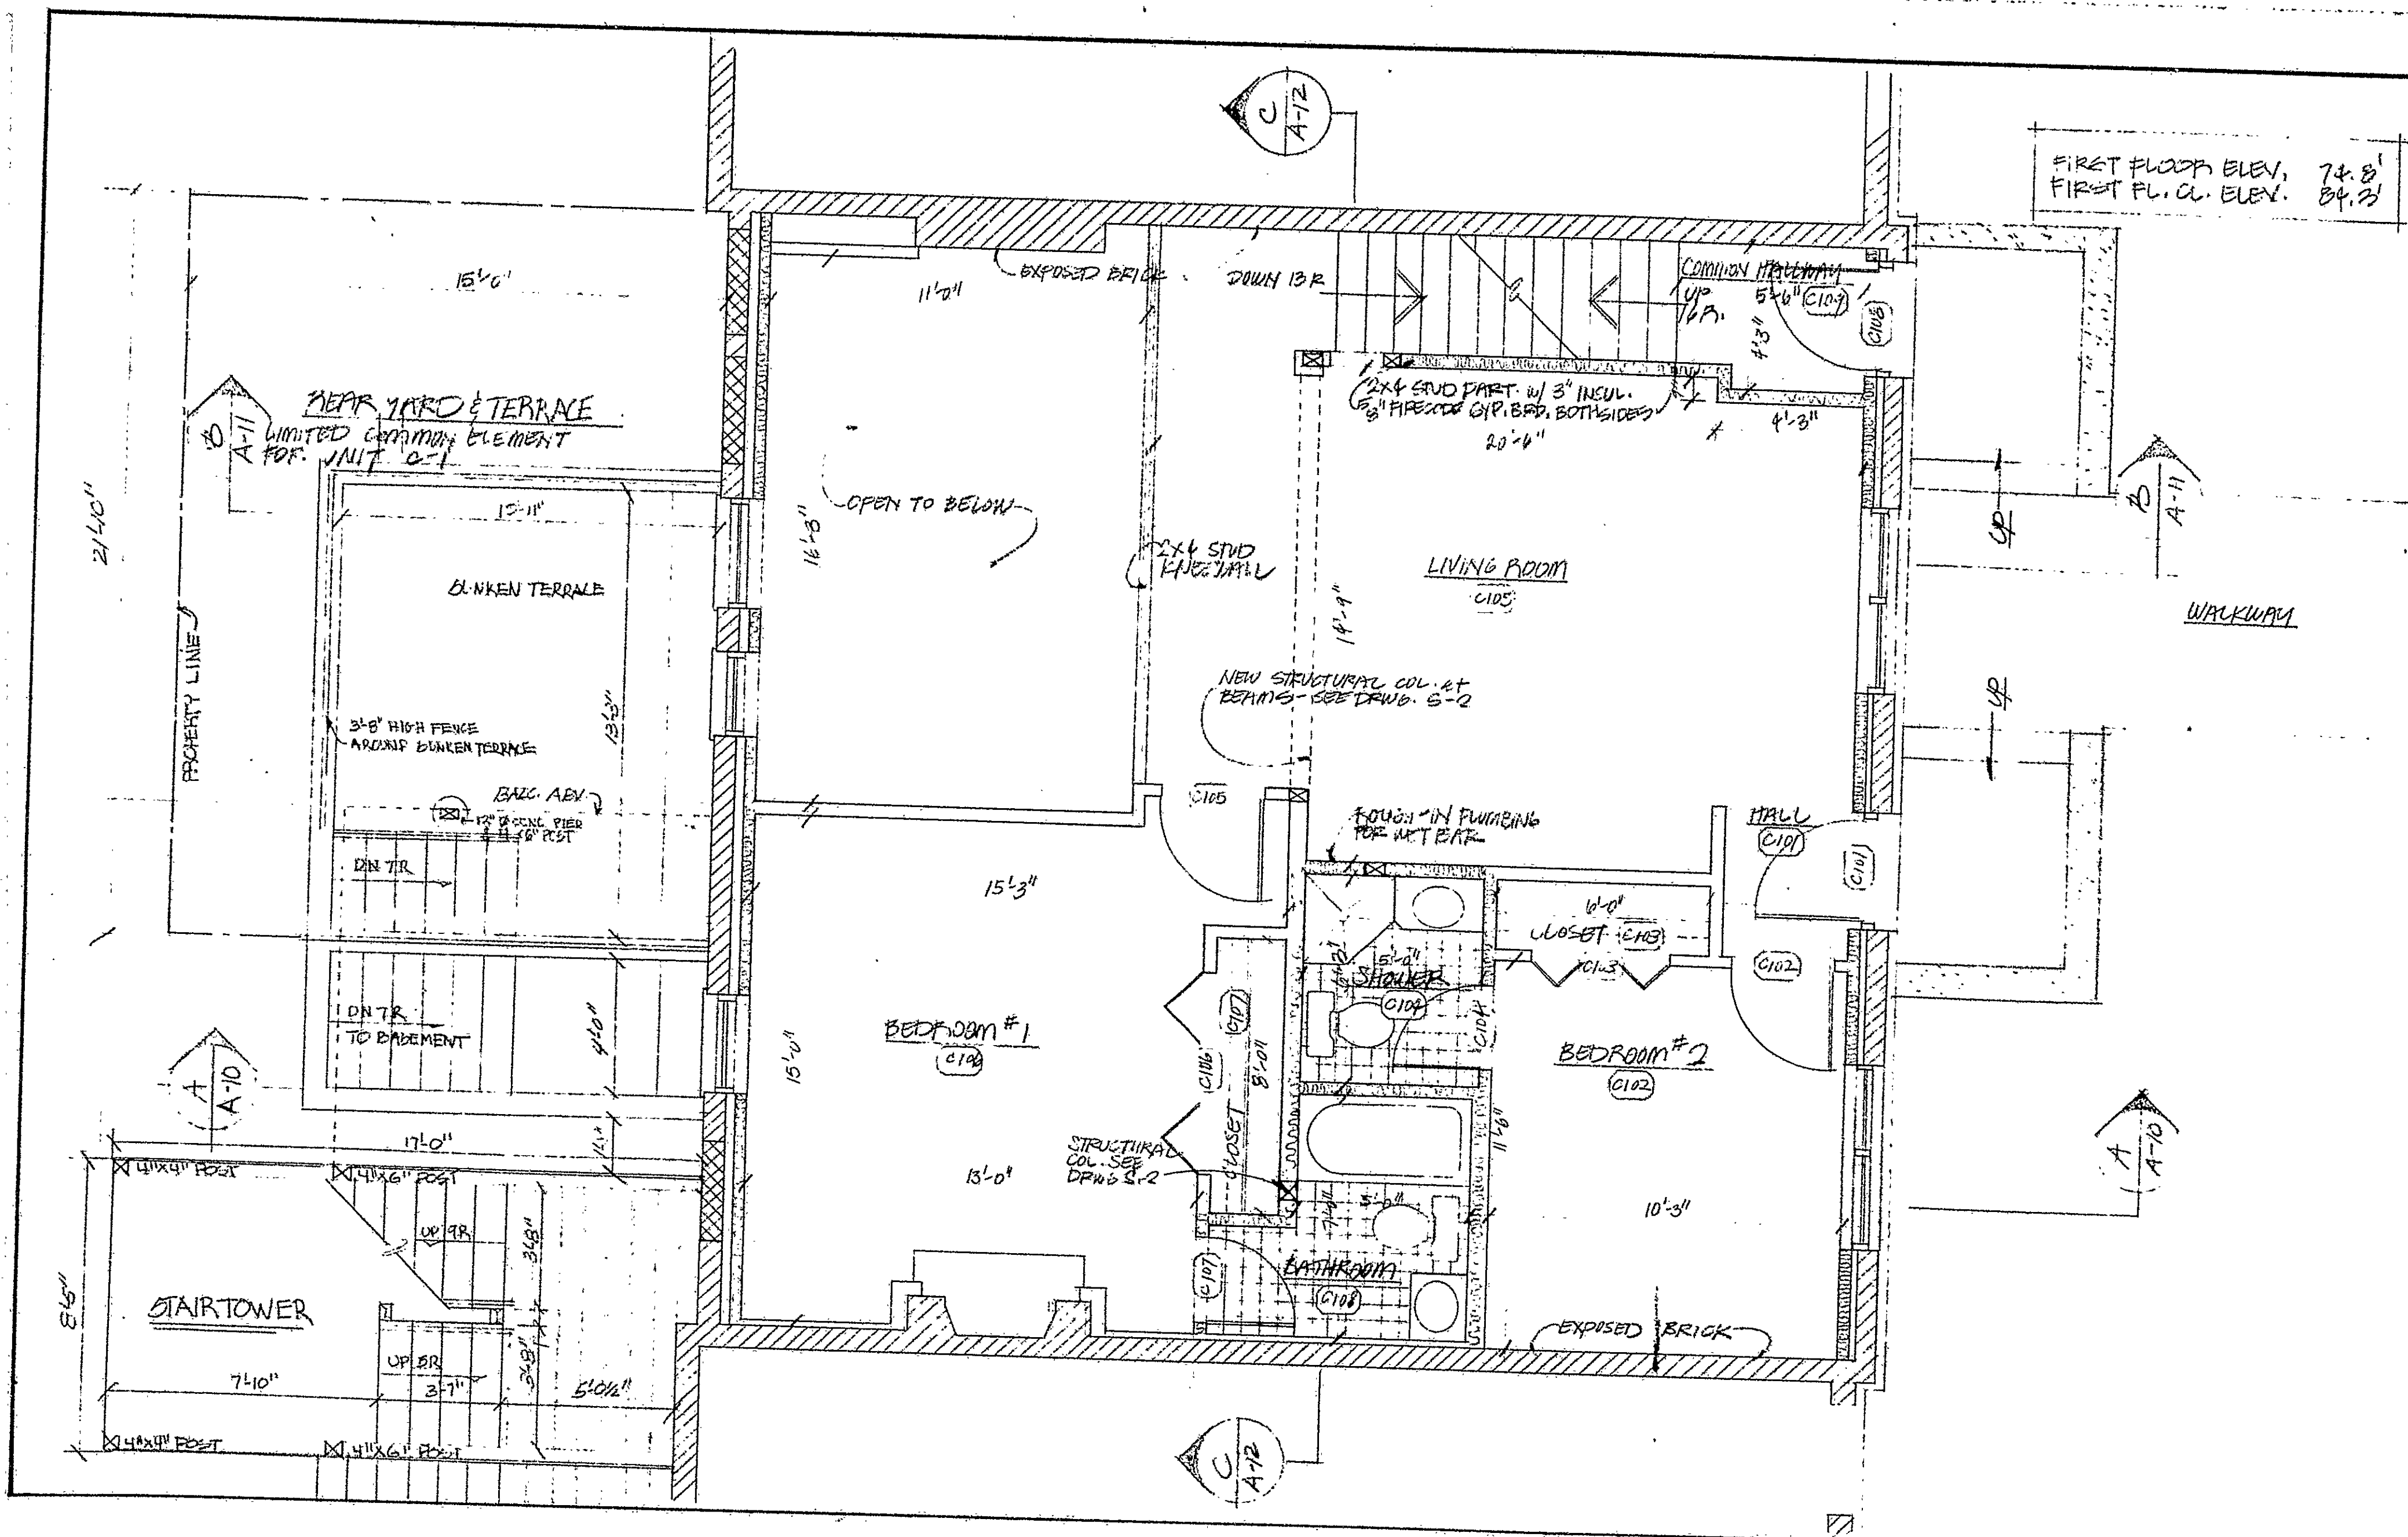


John P. [Signature]

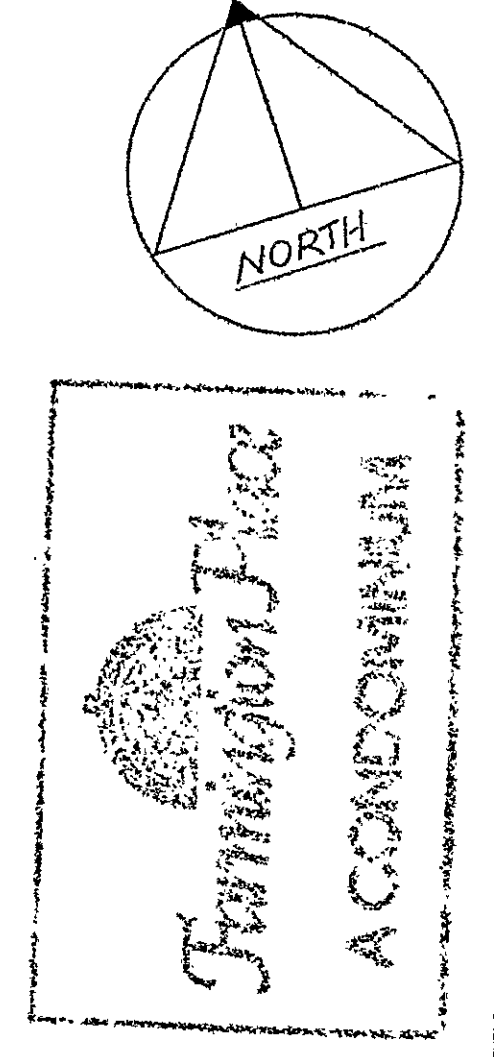

UNIT C-1 1st floor		235 FARMINGTON AVENUE HARTFORD, CONNECTICUT (73 INLAY STREET)		THE HARTFORD BUILDING RECYCLING, INC.	
A 17		SCALE: 1/4" = 1'-0"		DRAWN: DRS. CHECKED: [Signature] DATE: 4/12/78	