



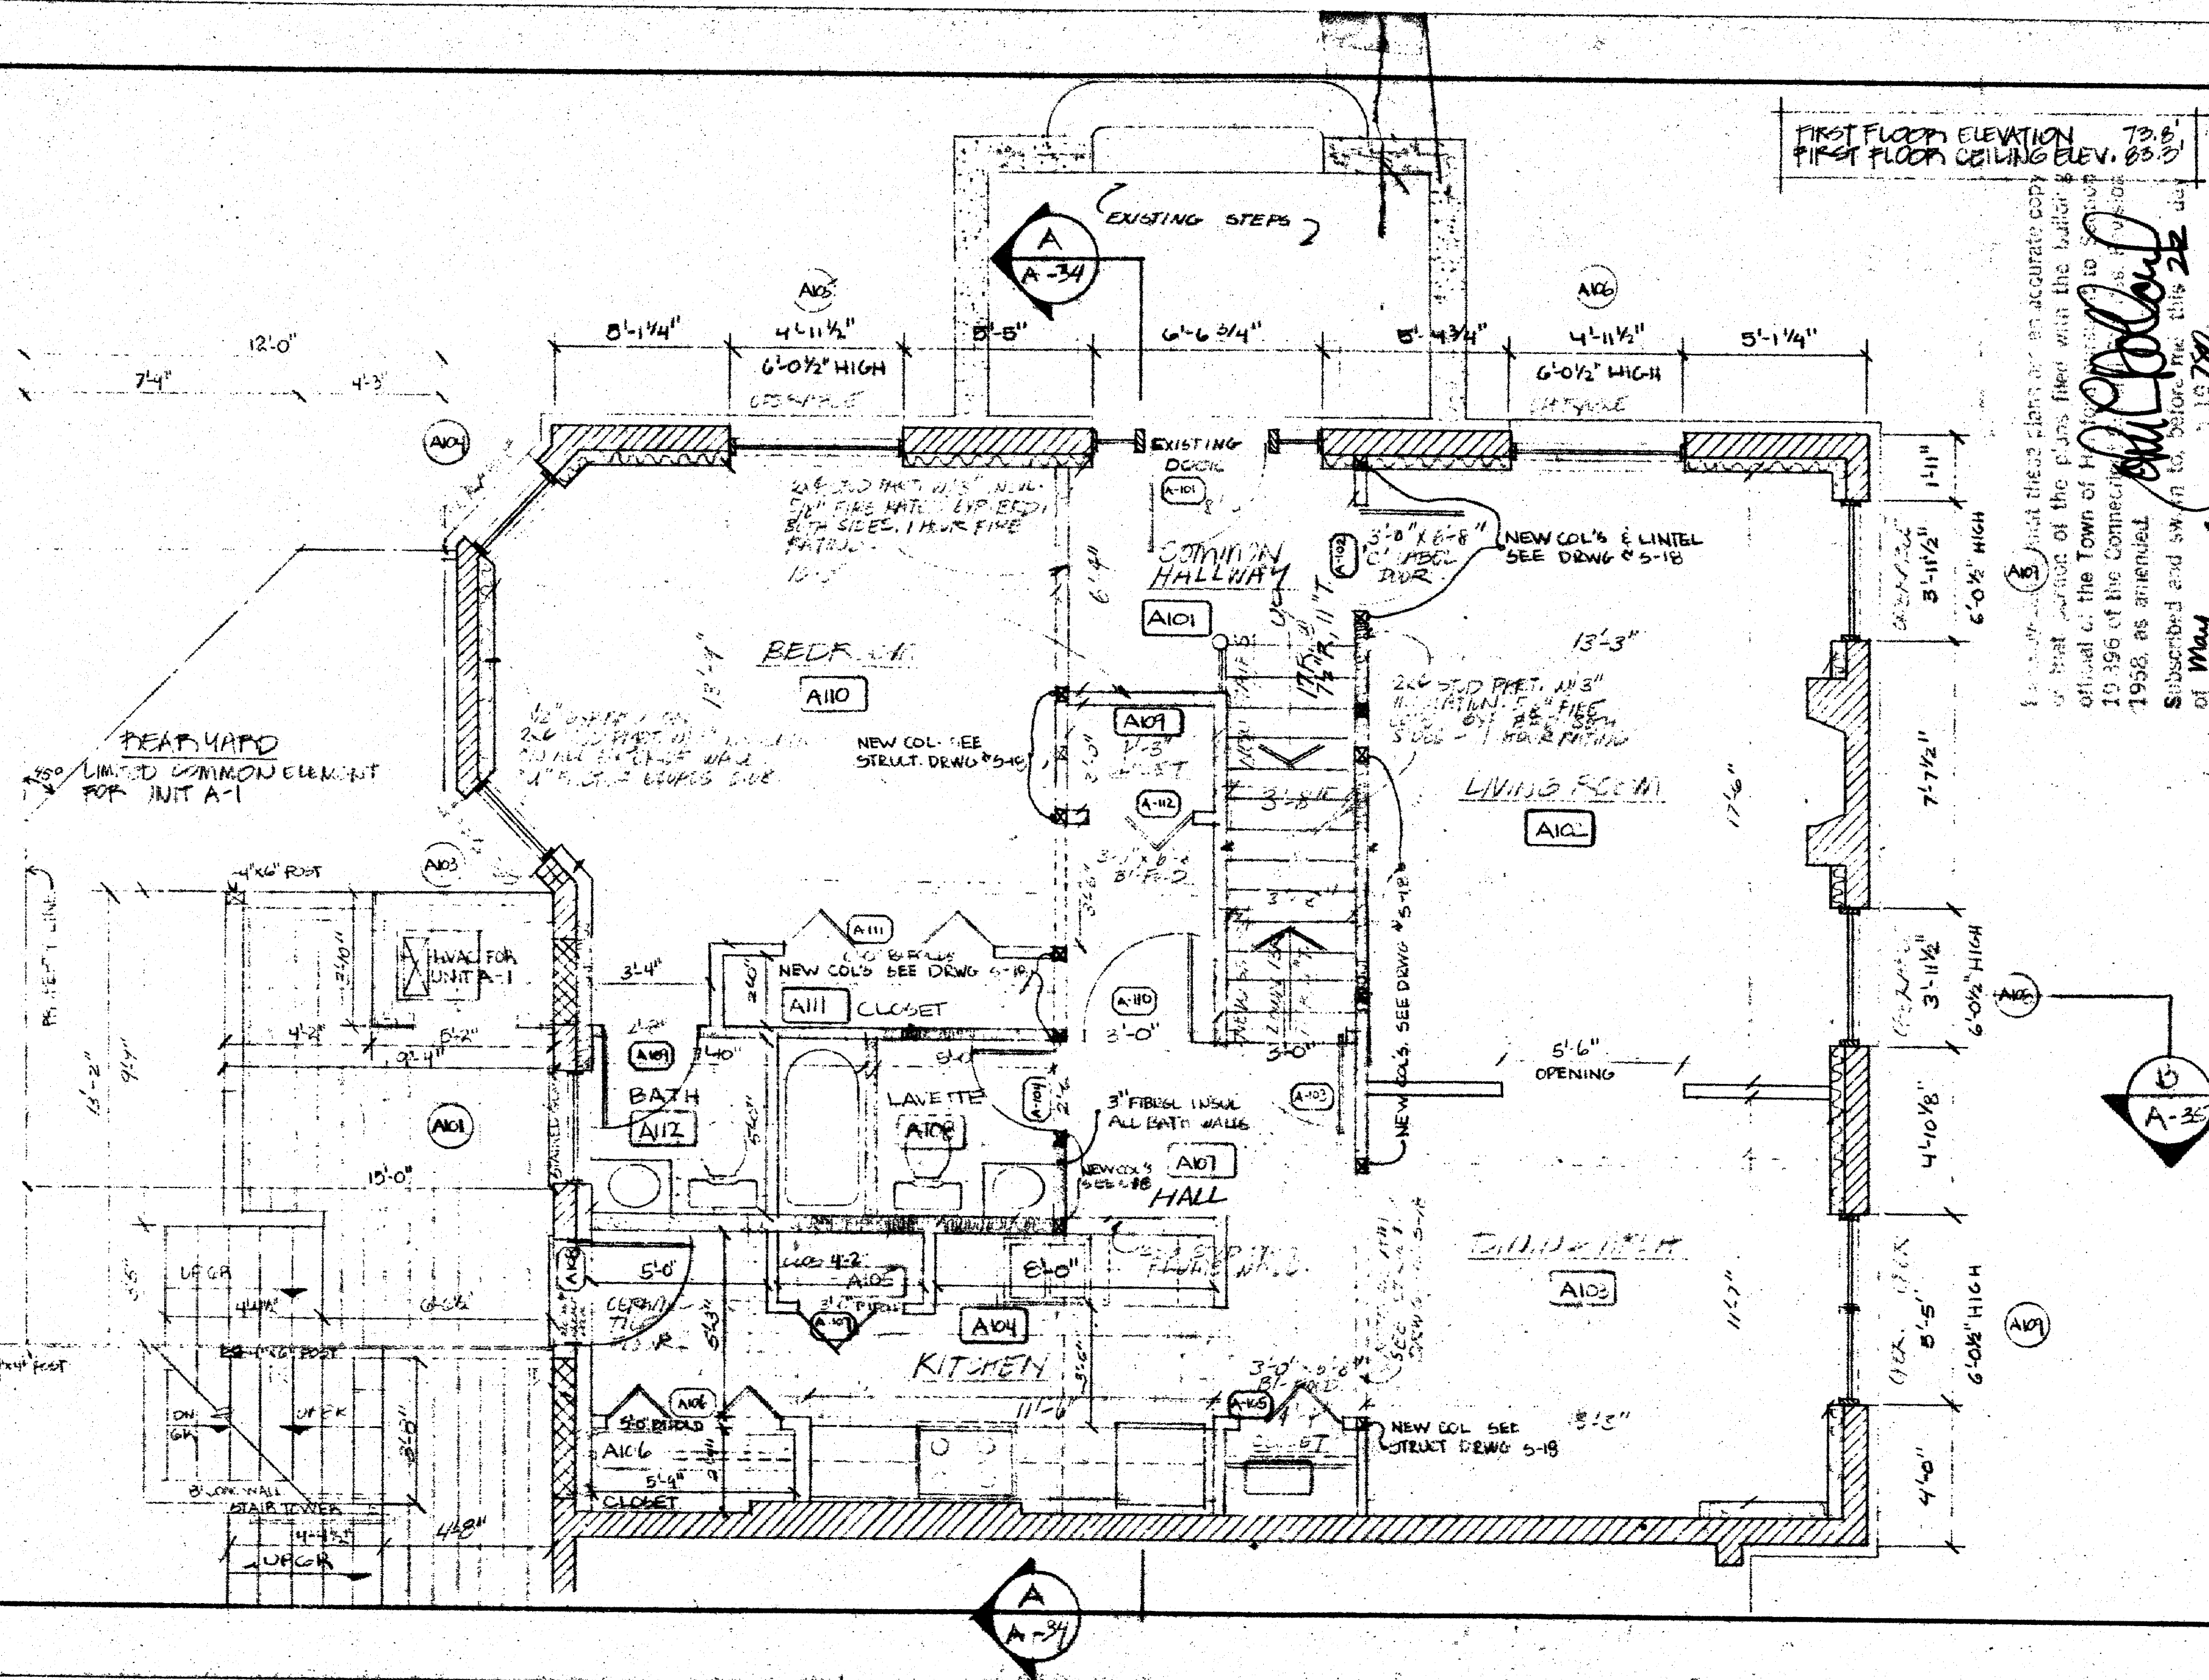

1. The undersigned hereby certify that their plan or an accurate copy
 of that portion of the plans filed with the Auditor &
 10,296 of the Connecticut General Assembly, in Session
 1958, as amended.
 Subscribed and sworn to before me this 22 day
 of May, 1979.
 F. Mark F. Main
 Commissioner of the Superior Court

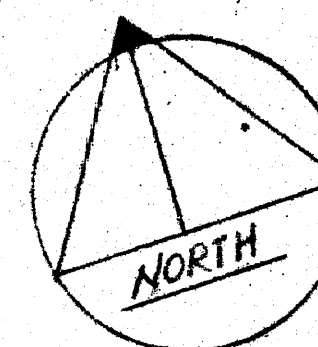

100

235 FARMINGTON AVENUE
HARTFORD, CONNECTICUT

THE HARTFORD BUILDING RECYCLING INC.

SCALE: 1/4"=1'-0"	DRAWN: D.R.S.	CHECKED: 	DATE: 12/13/77
-------------------	---------------	--	----------------

UNIT A-1

A-2

ADG _____ PAGE _____
ICM _____ FEB.
FEB 12 15 30 PM '58
[Signature]
RECEIVED BY

