



RHEIN B/P 100 10-76 88888

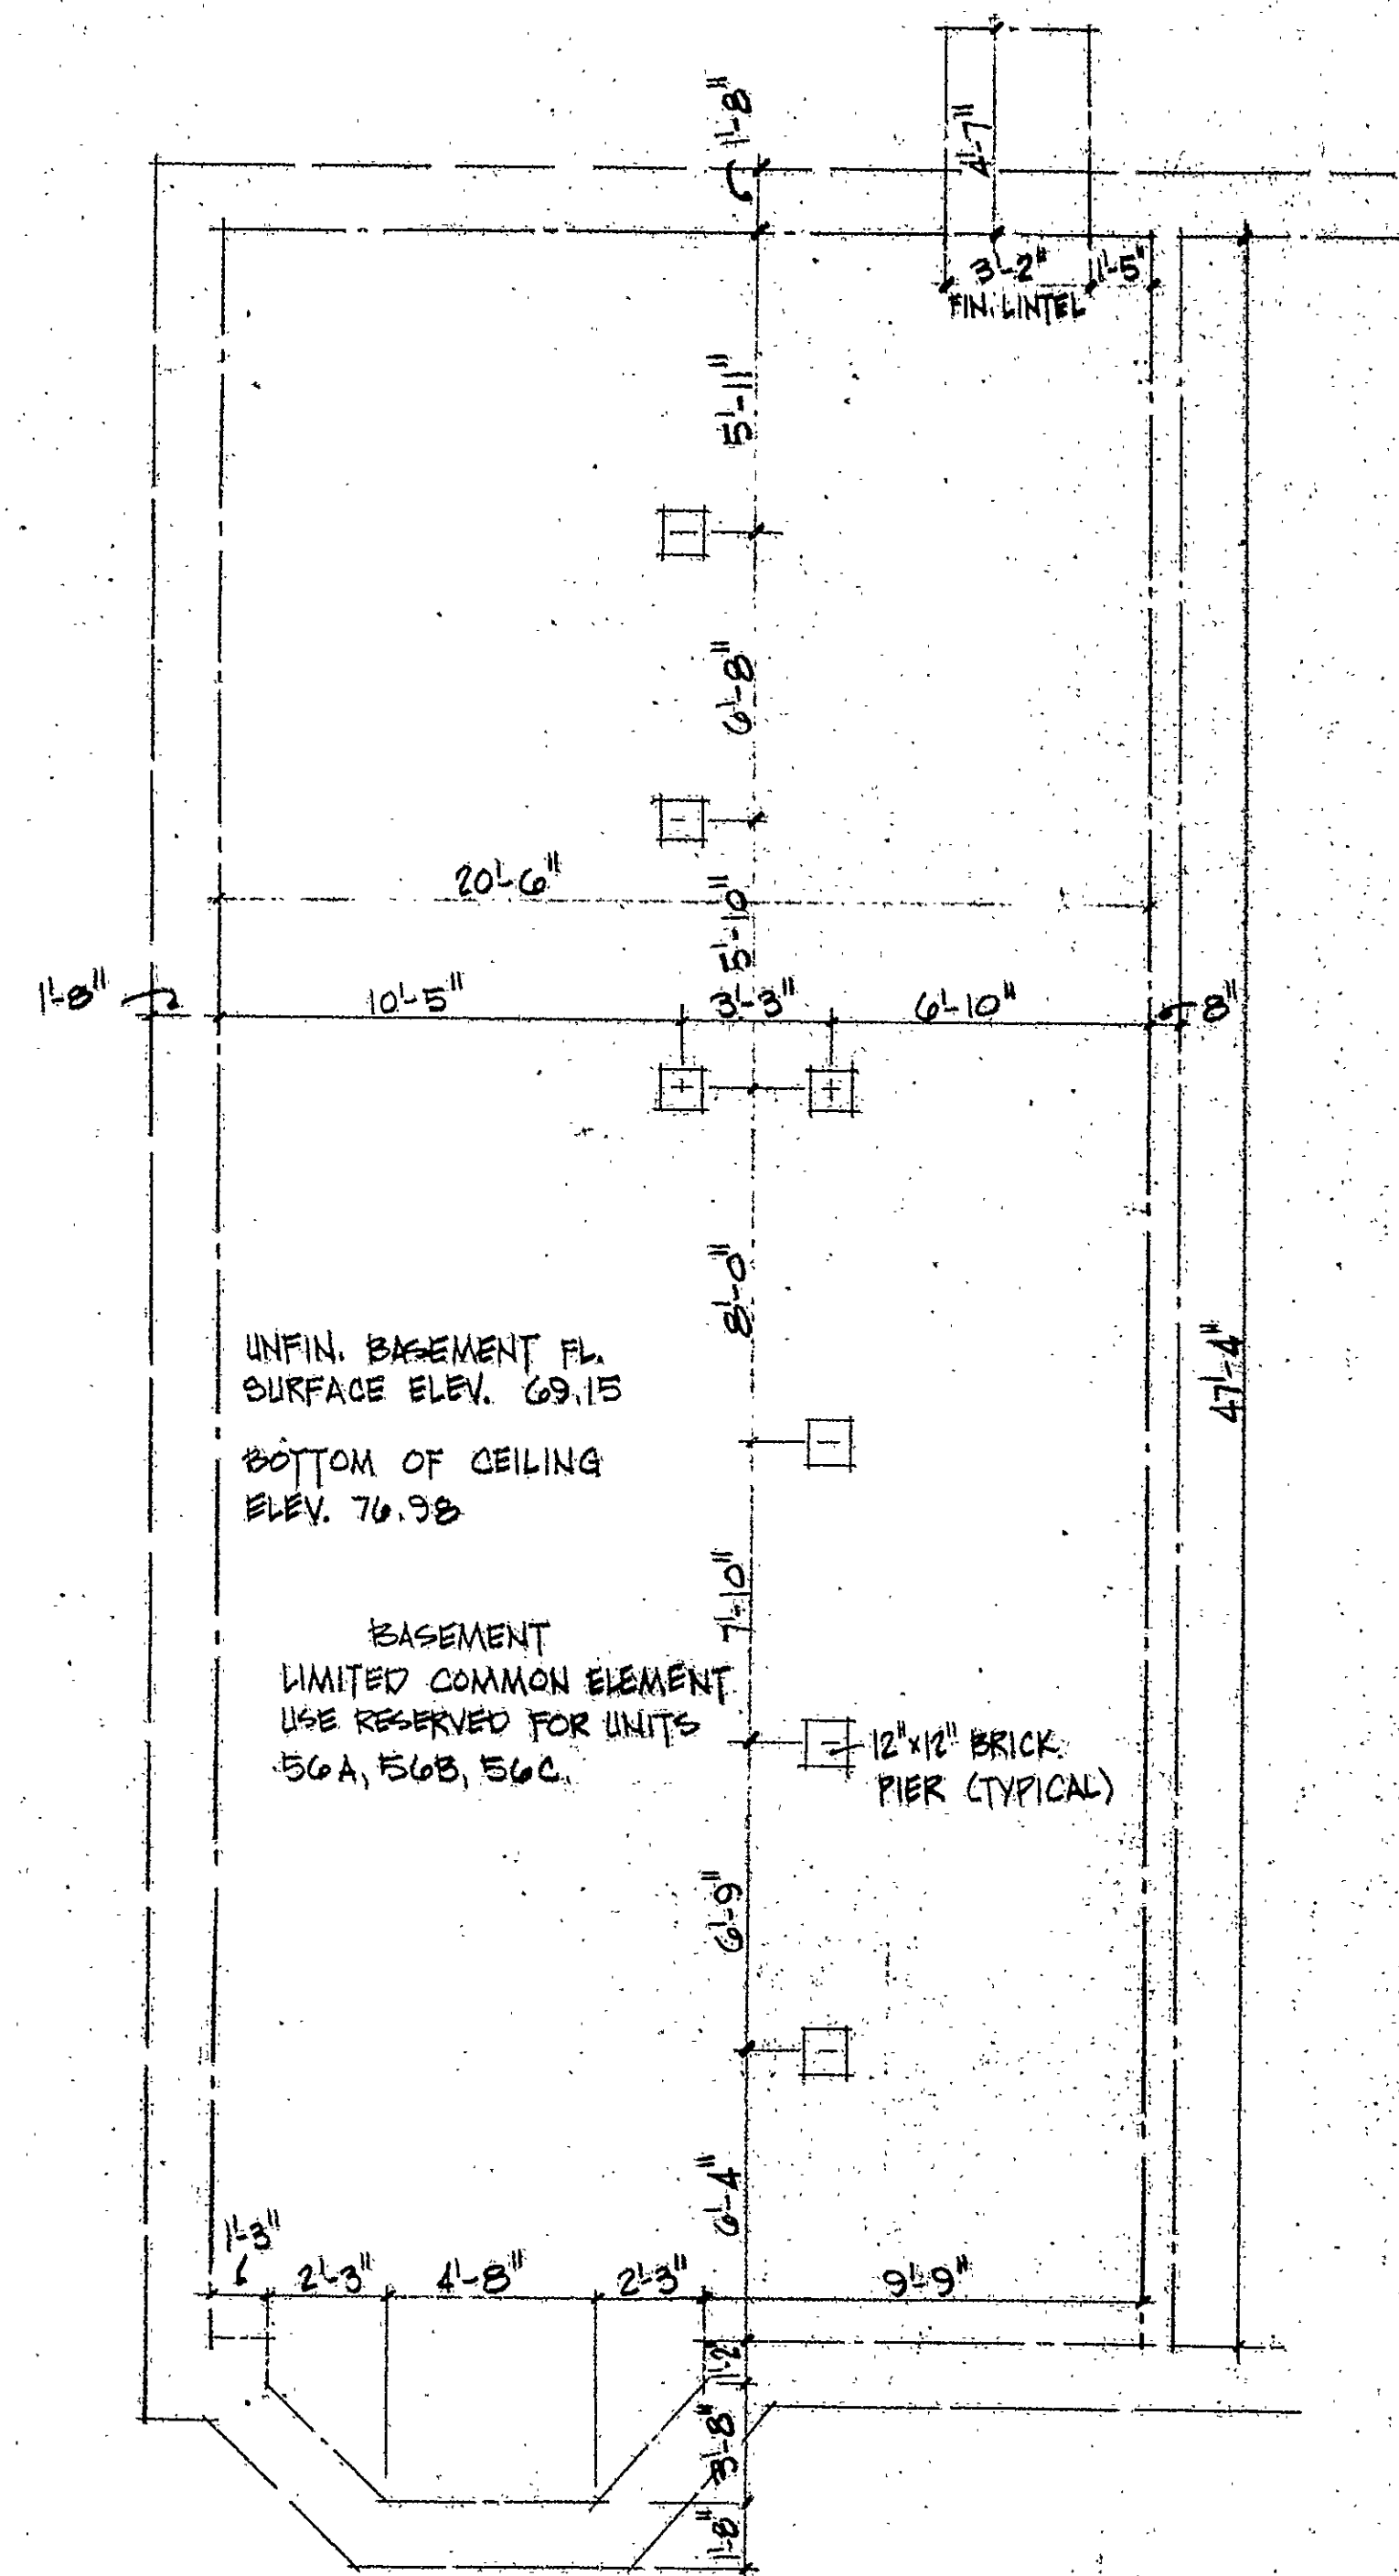

BASEMENT PLAN

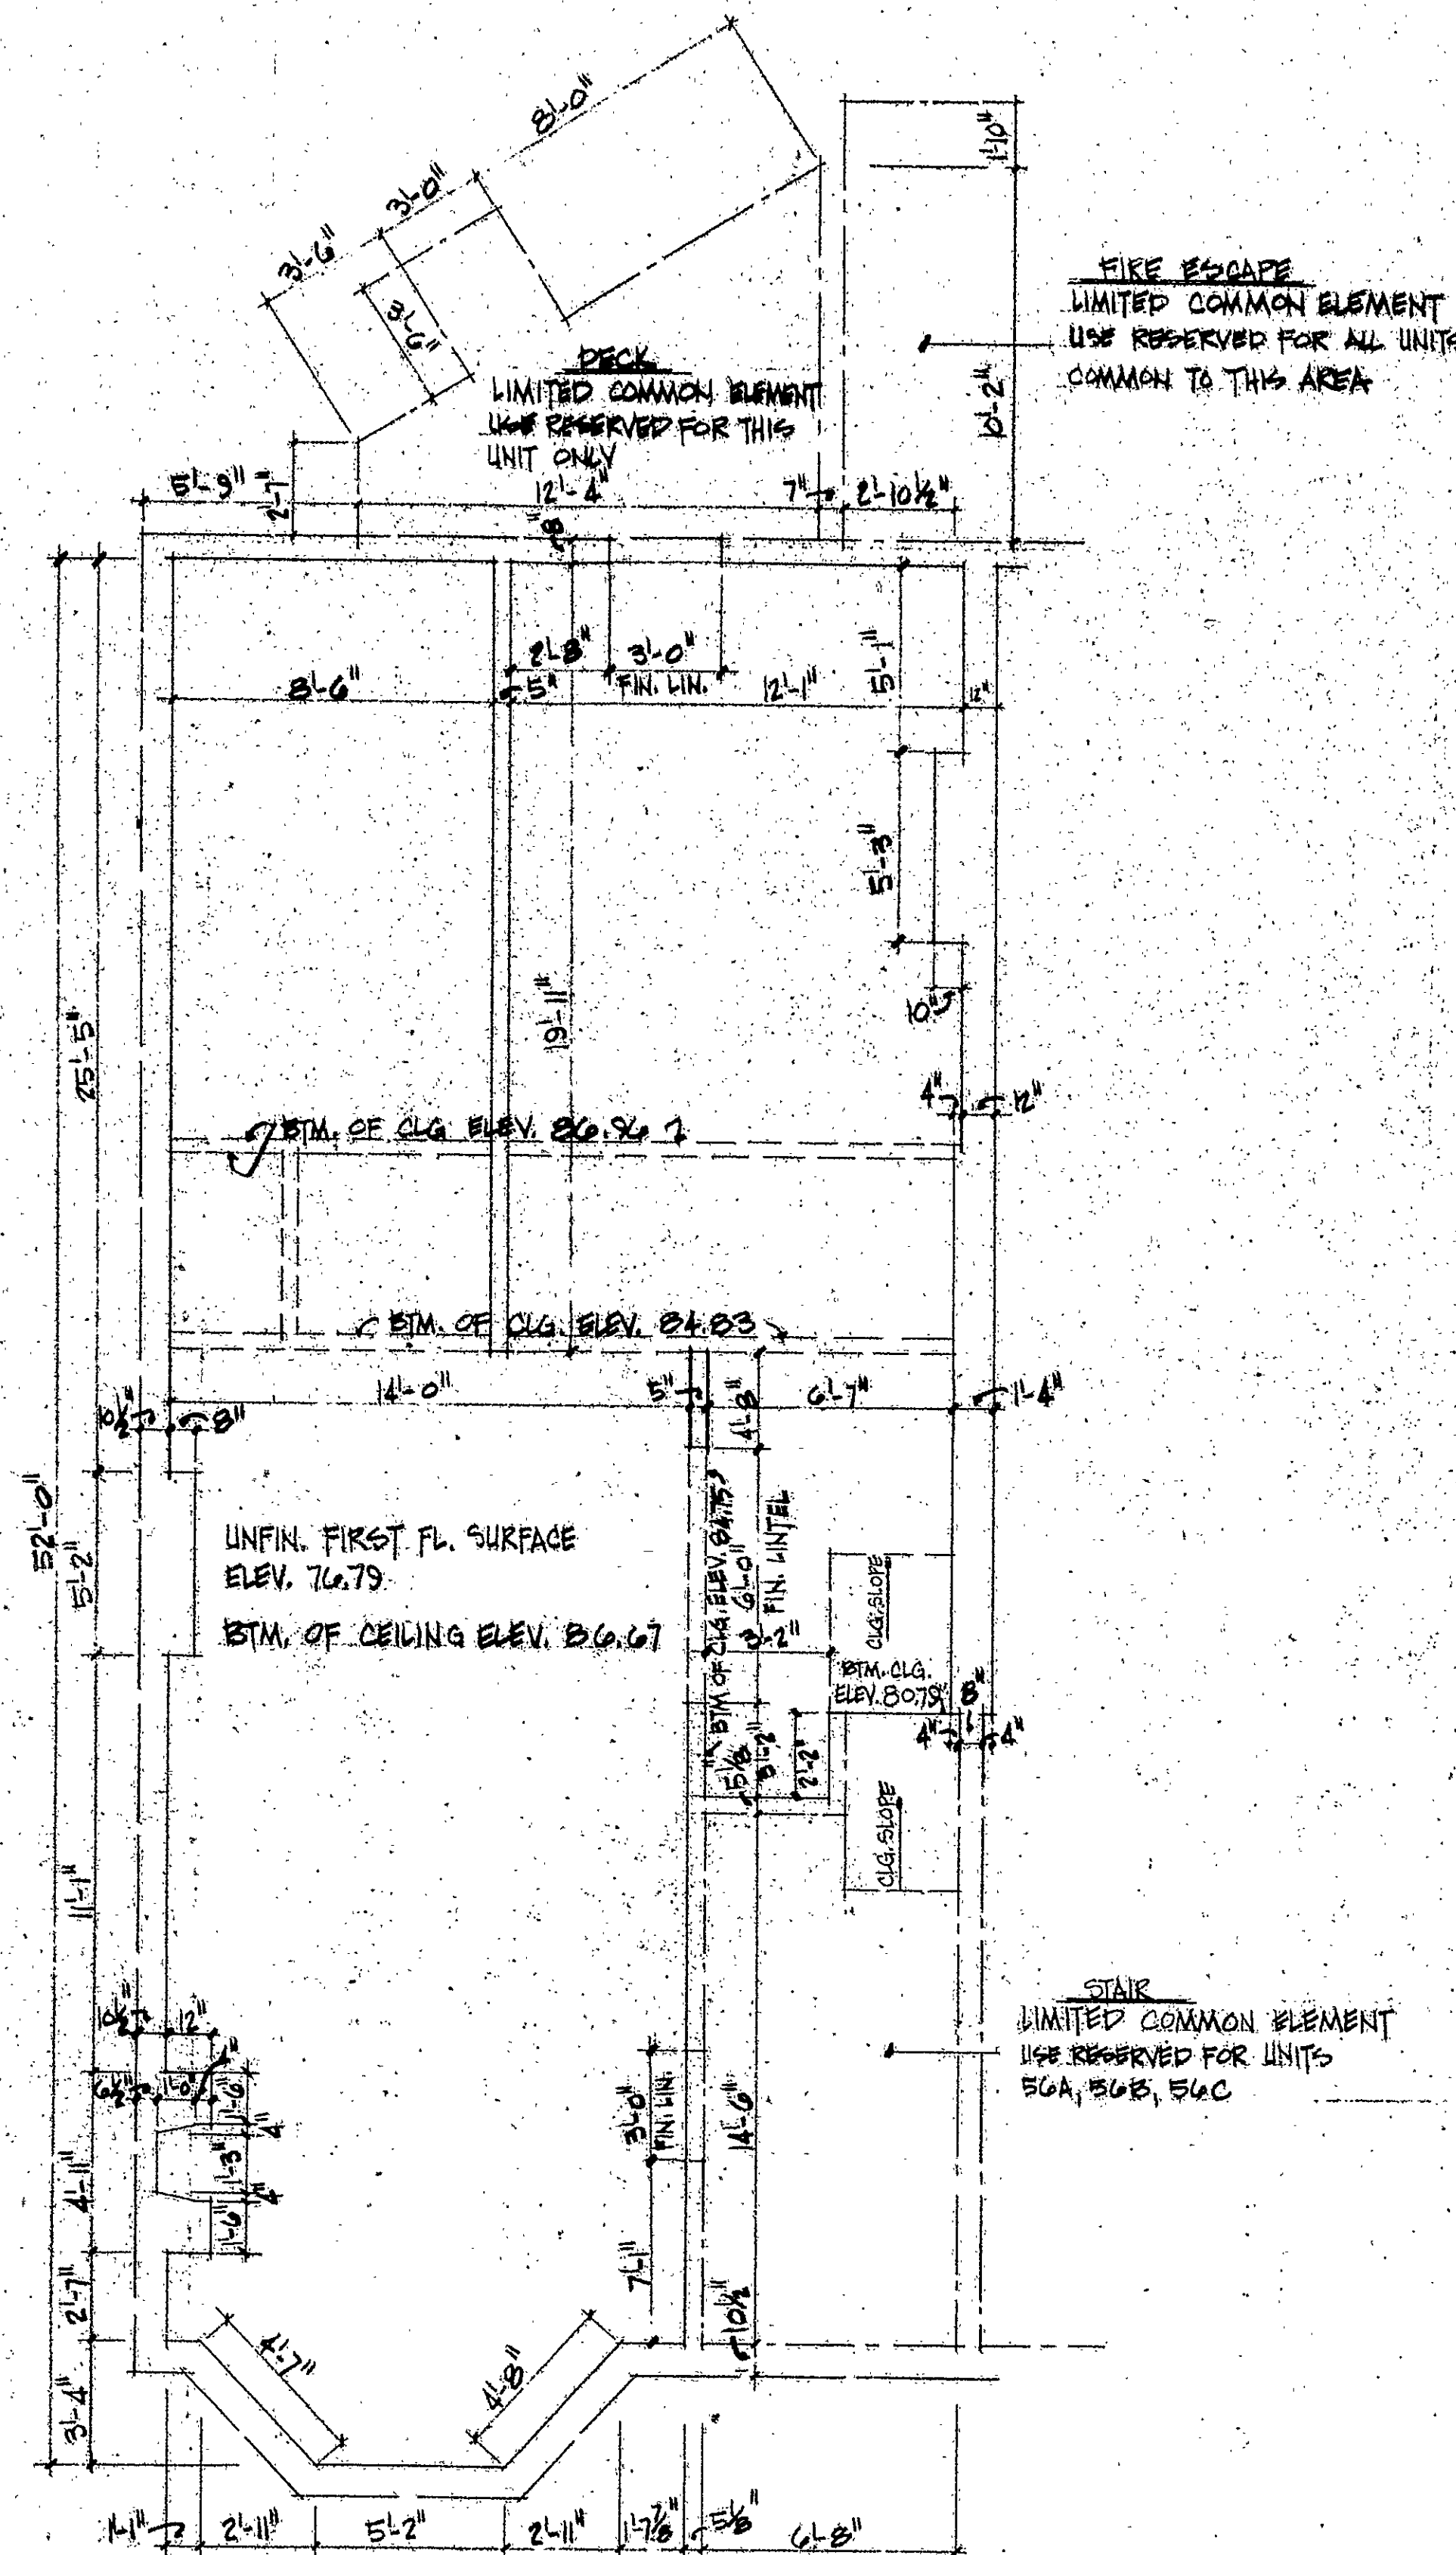

FIRST FLOOR PLAN

UNIT A

RECEIVED BY
TOWN CLERK
MAY 24 2 16 PM '79
VOL. PAGE

VERIFICATION
State of Conn. 4/14/1979
County of Hartford
I, the undersigned, Jack M. Krafjack, signor of the above statement, duly sworn, who made oath of the truth of the statement to which his signature appears.
Commissioner of the Superior Court

Certified to be an accurate copy of portions of the approved plans on file with the City of Hartford, Connecticut Building Department.
Jeffrey C. Linfert 4-4-79
Date

Unit Floor Plans (Schematic)
To the Declaration of Condominium
By Jeffrey C. Linfert
Dated 4-4-79
Recorded Vol. 121 Page 23
Hartford Land Records

Notes
Number of rooms
SUITA 500A+1 BATH
Area
SUIT A 9135 sq. ft.

Scale 1/4" = 1'-0"
1 2 3 4 5 6 7
16 79

LEGEND
--- UNITS
--- LIMITED COMMON AREA
--- COMMON AREA



TOWN HOUSE ON THE HILL
56 Willard St.
Hartford, Ct.
townhouse

design
group
one

3 of 4

Condo Floor Plan #2

