



RECEIVED BY  
May 24 2 16 PM '79  
TOWN CLERK  
VOL. PAGE

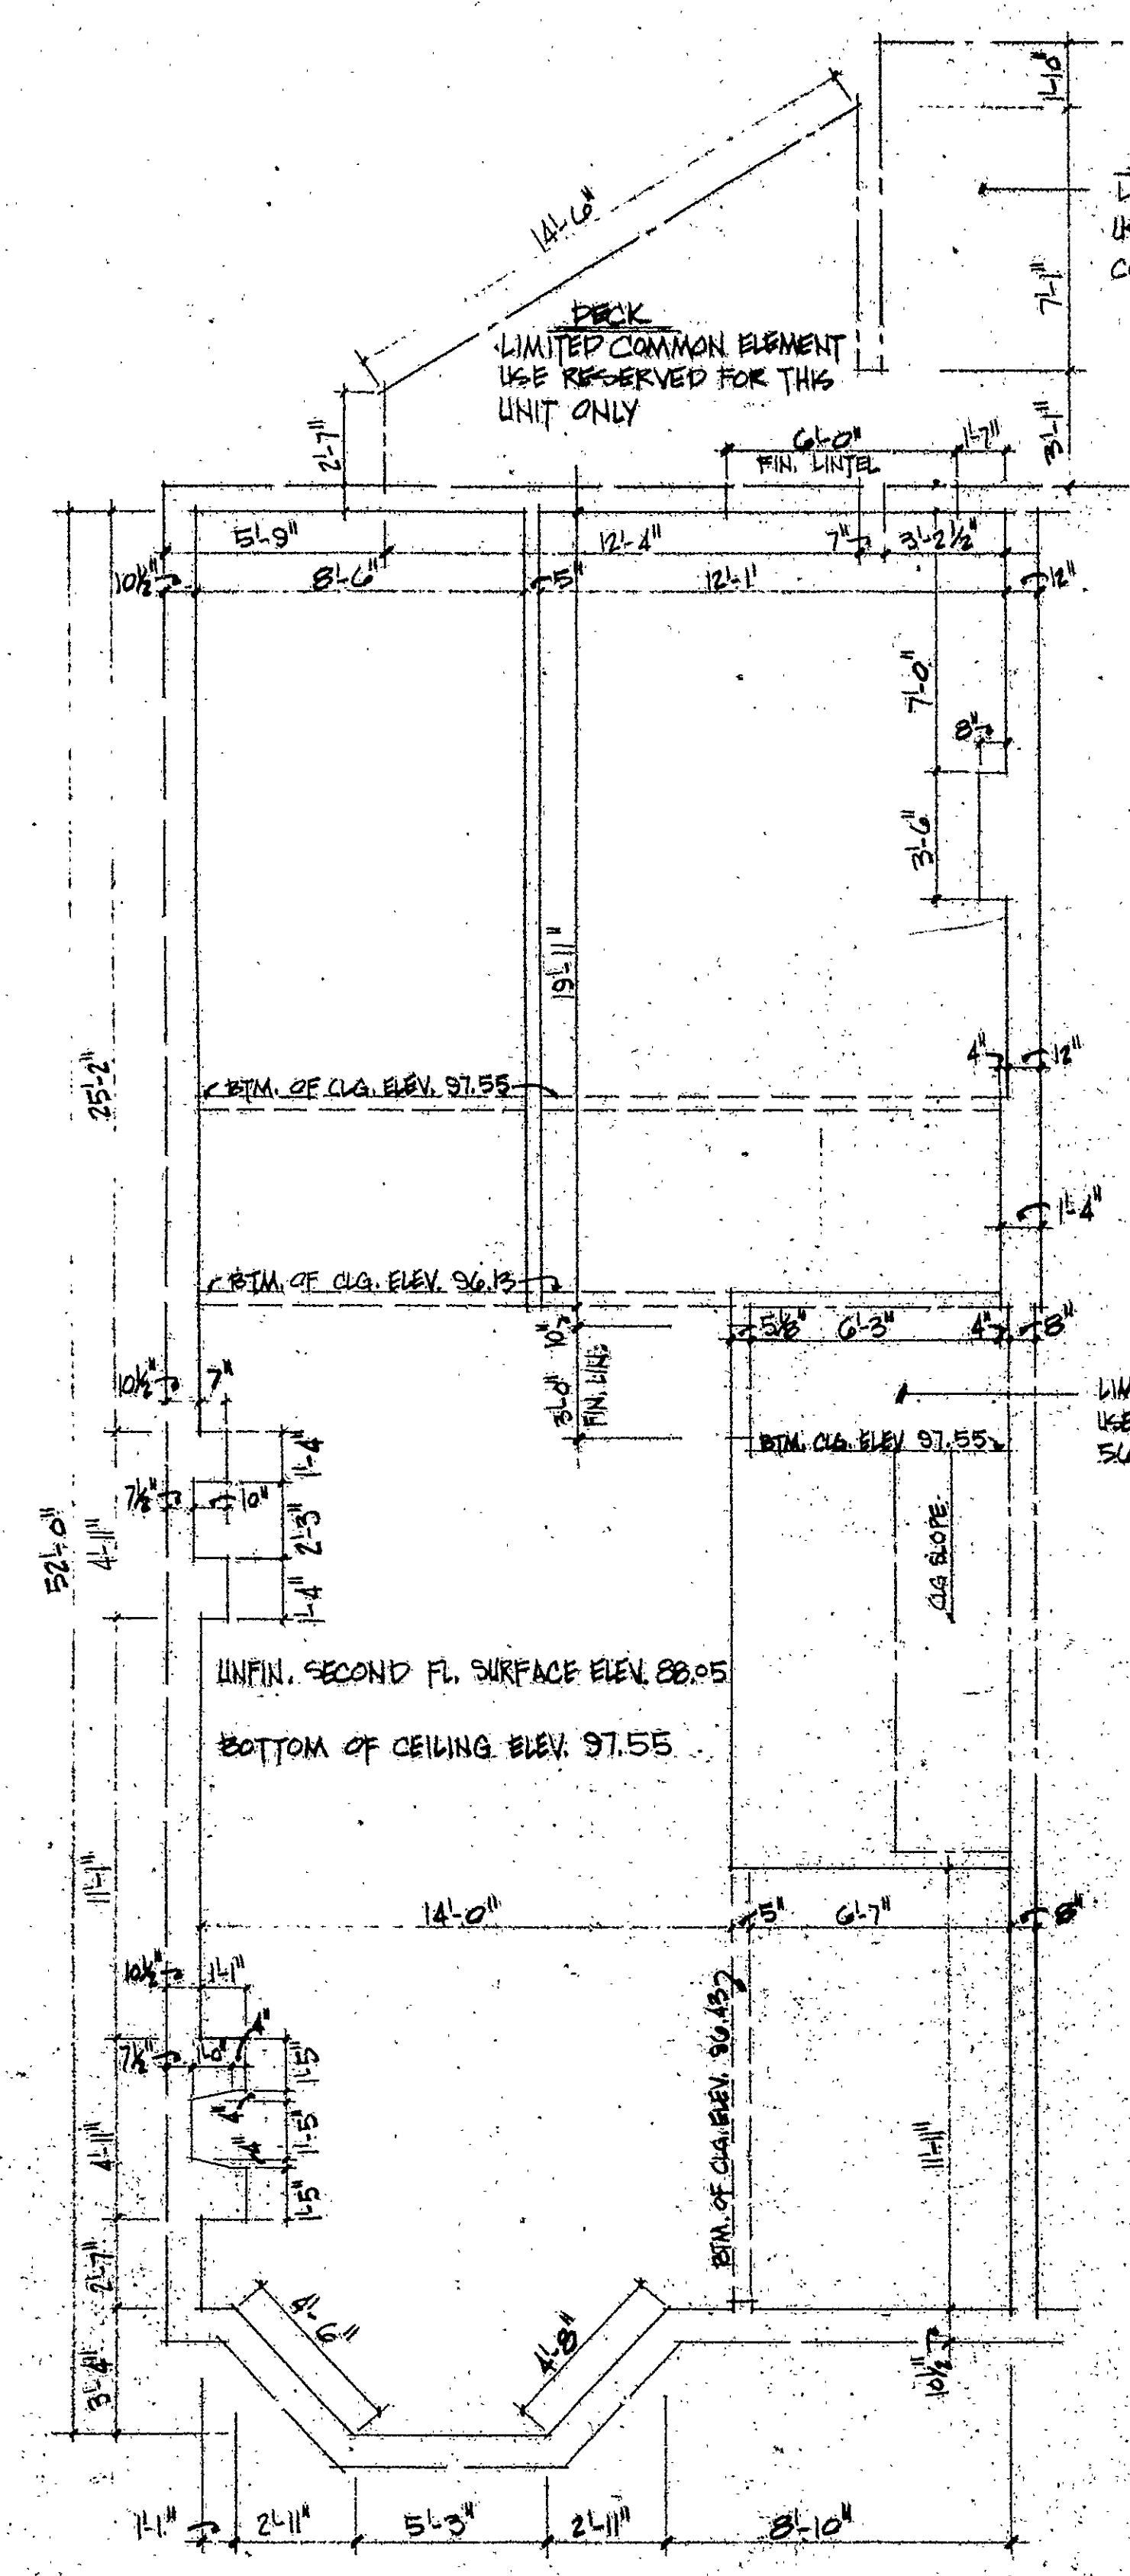

FIRE ESCAPE  
LIMITED COMMON ELEMENT  
USE RESERVED FOR ALL UNITS  
COMMON TO THIS AREA

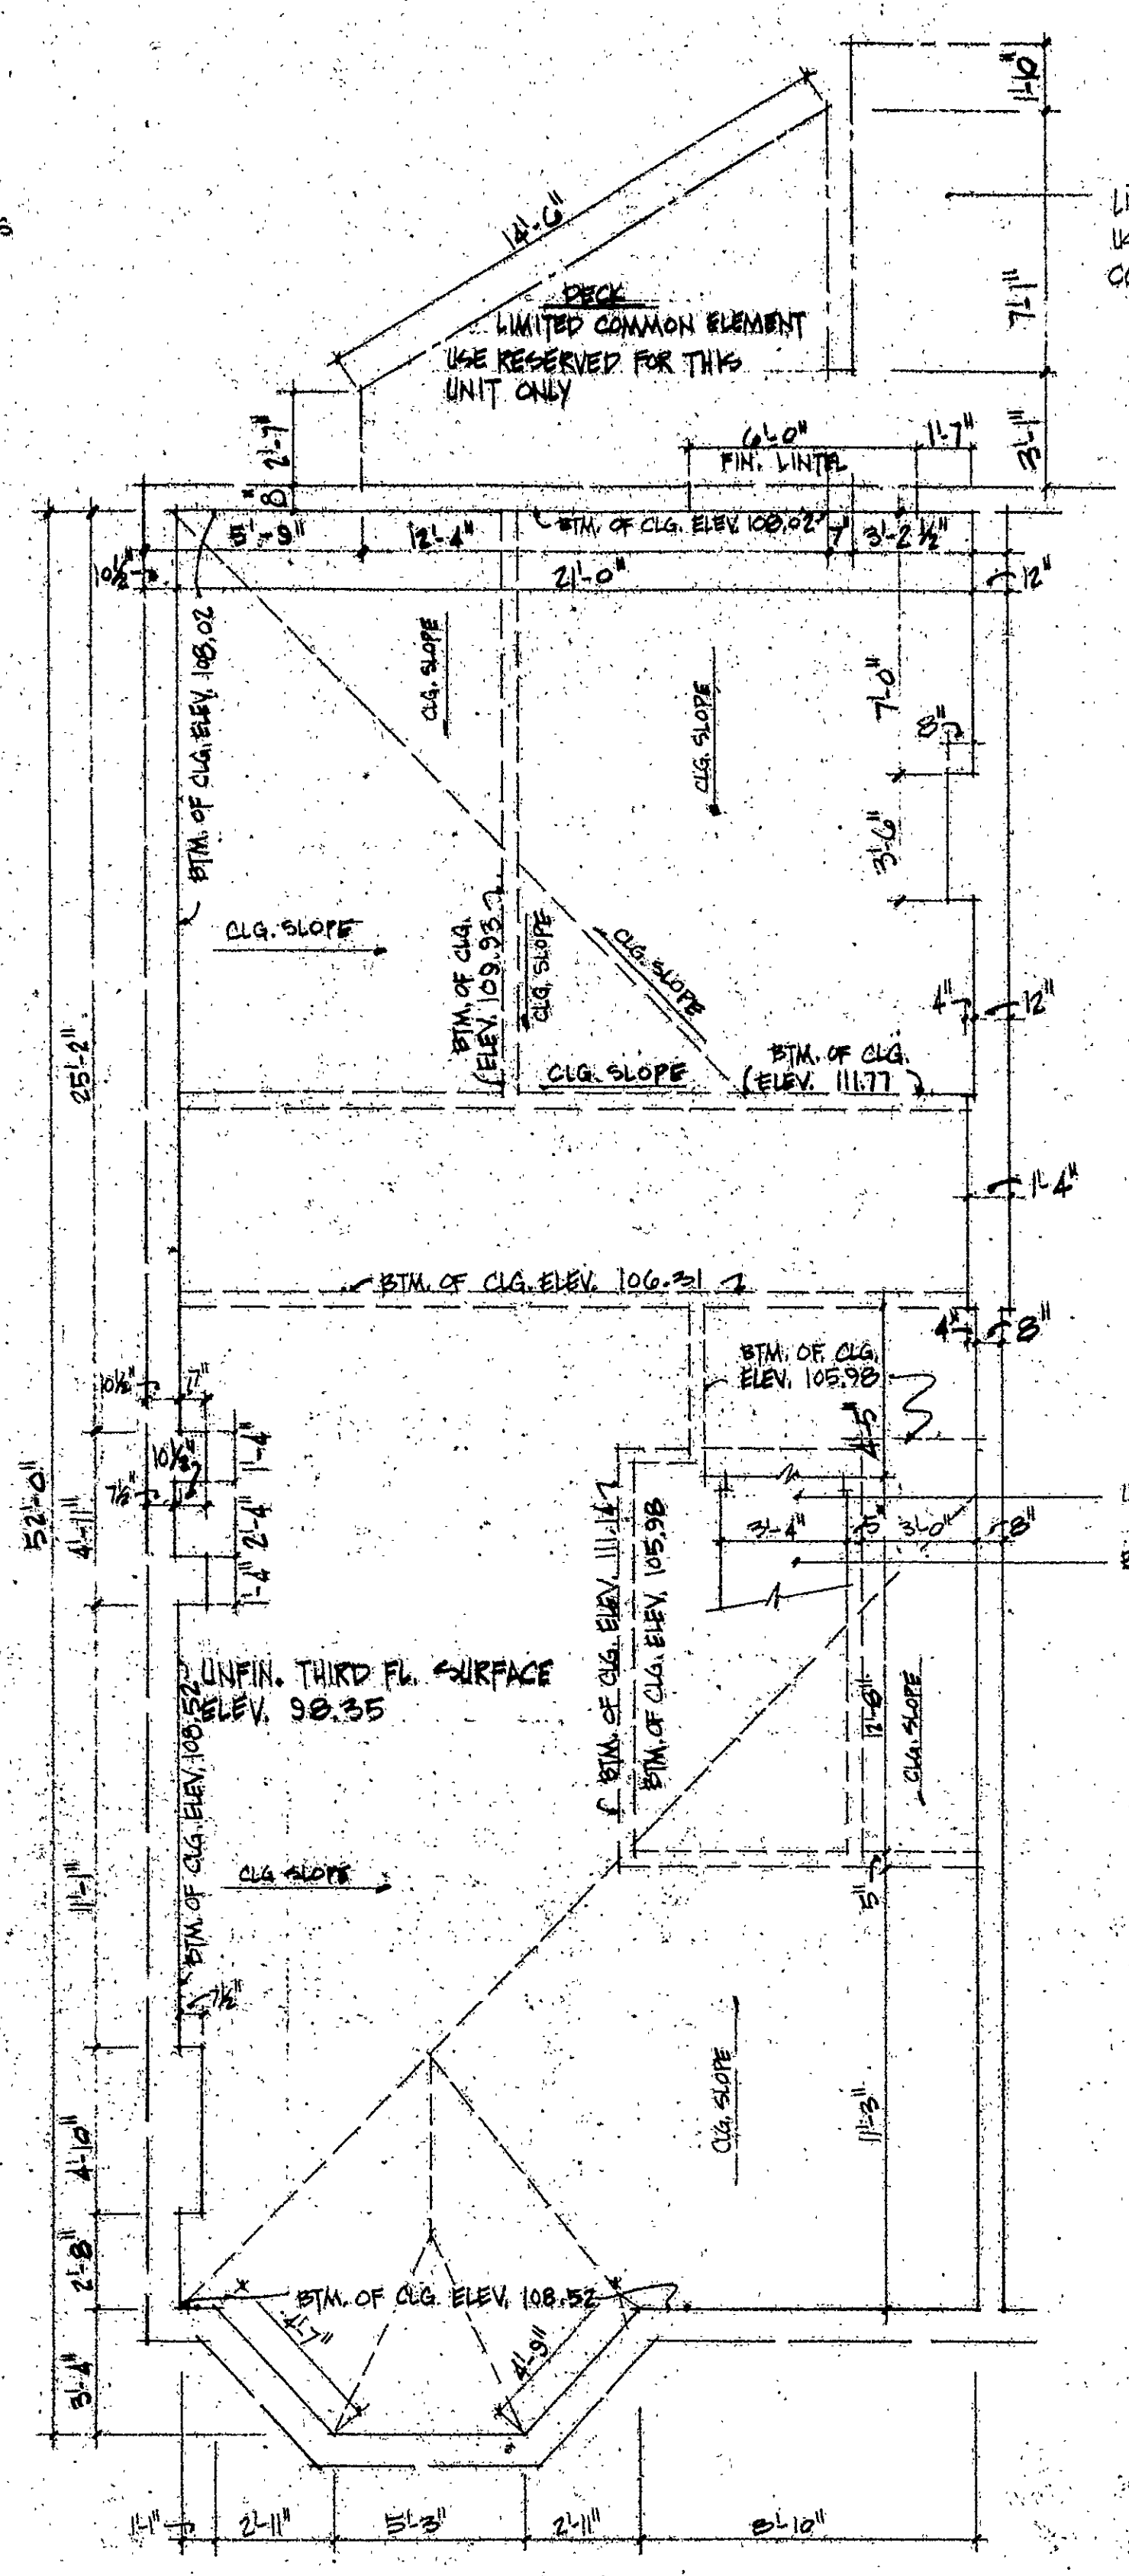

FIRE ESCAPE  
LIMITED COMMON ELEMENT  
USE RESERVED FOR ALL UNITS  
COMMON TO THIS AREA

**TOWN HOUSE ON THE HILL**  
56 Willard St.  
Hartford, Ct.  
townhouse

design  
group  
one

architects - hartford, conn.



4 of 4

C03 do FLOOR Plan #2

