



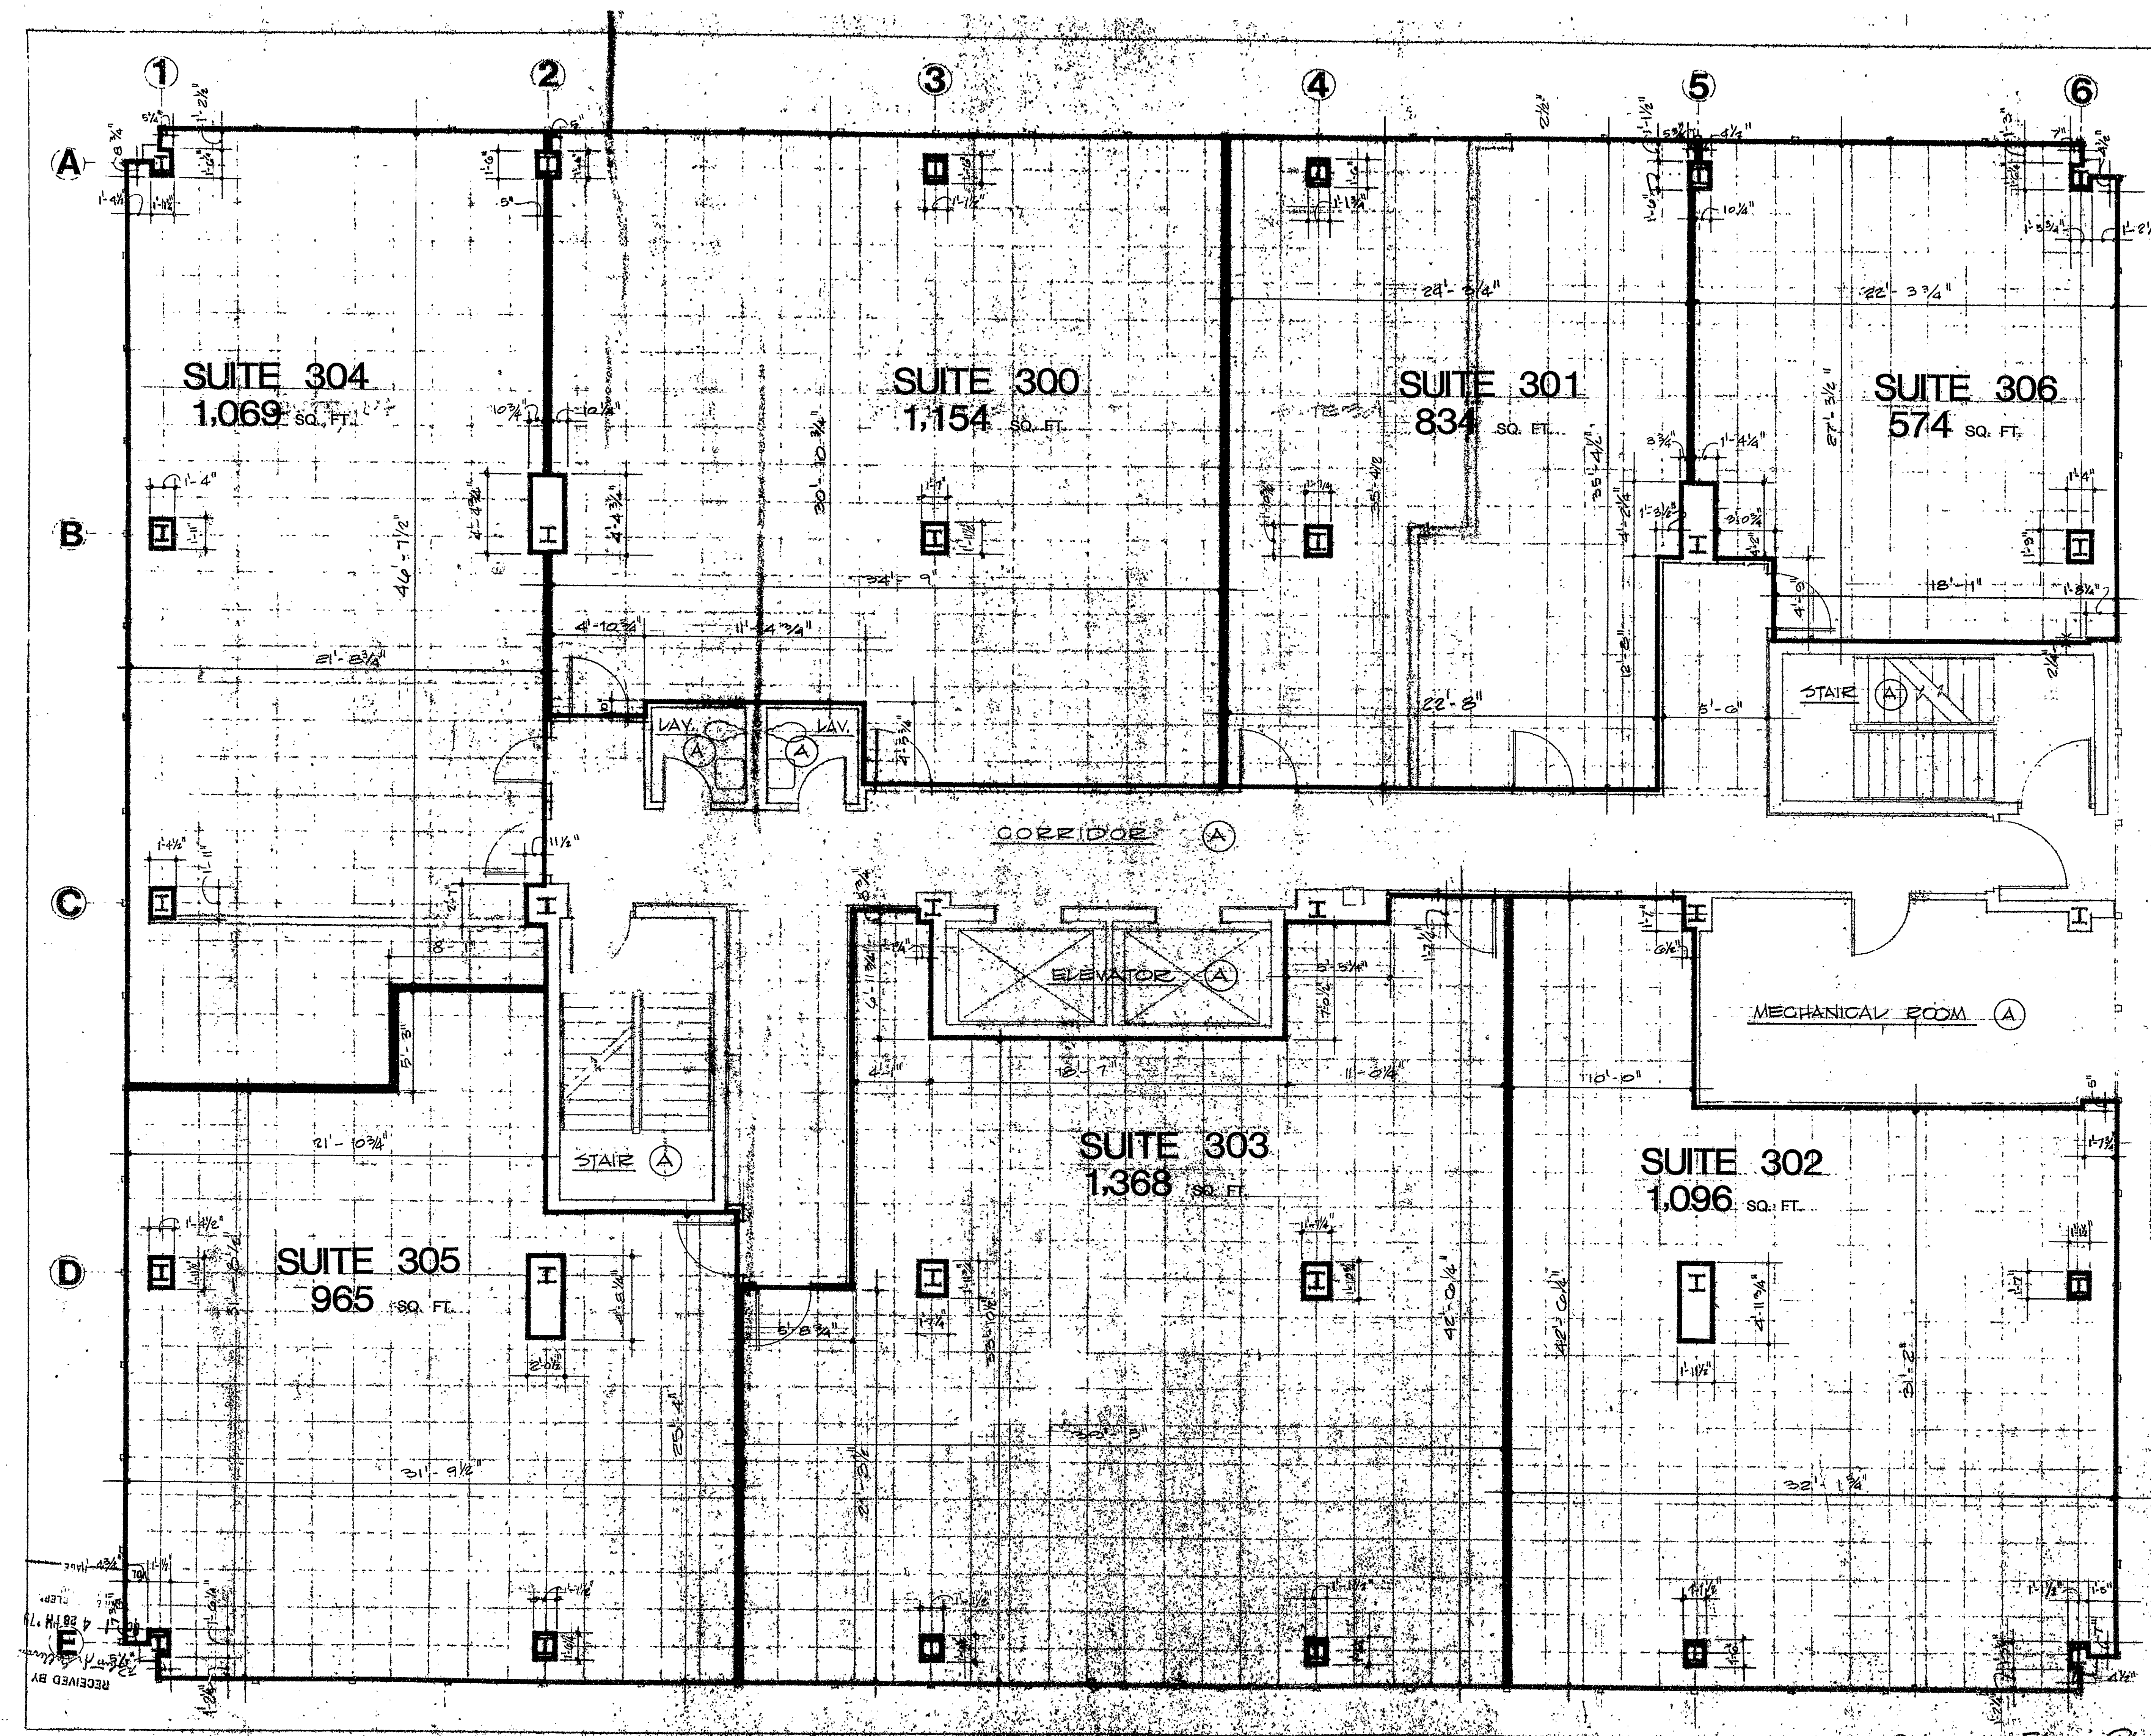

I hereby certify that this plan is substantially correct and represents the conditions and dimensions as they presently exist at 100 Retreat Avenue.

James K. Farrell
James K. Farrell, AIA
Conn. #1566

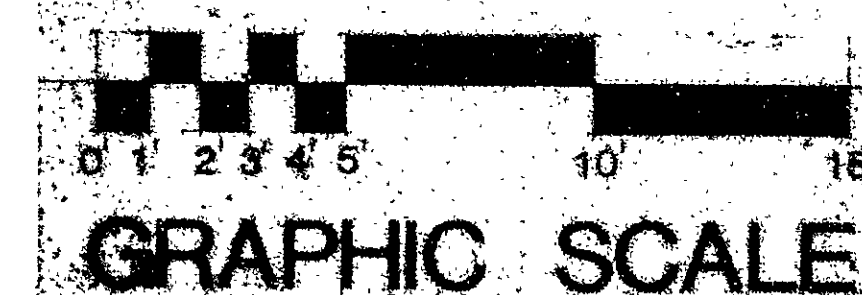

3RD FLOOR

NOTE: ALL DIMENSIONS ARE TAKEN FROM FACE OF GYPSUM BOARD TO FACE OF EXTERIOR WINDOW WALL.

PAGE 4 OF 10
SEE C-70, DRAWING
REVISION: 6.10.79

FLOOR TO CEILING HEIGHT = 8'-0"

REVISION: 6.7.79
REVISION: 6.11.79
REVISION: 6.10.79

100 retreat ave.
dimensions & sq. footages hartford, conn.

THIRD FLOOR PLAN

kanal white

4