



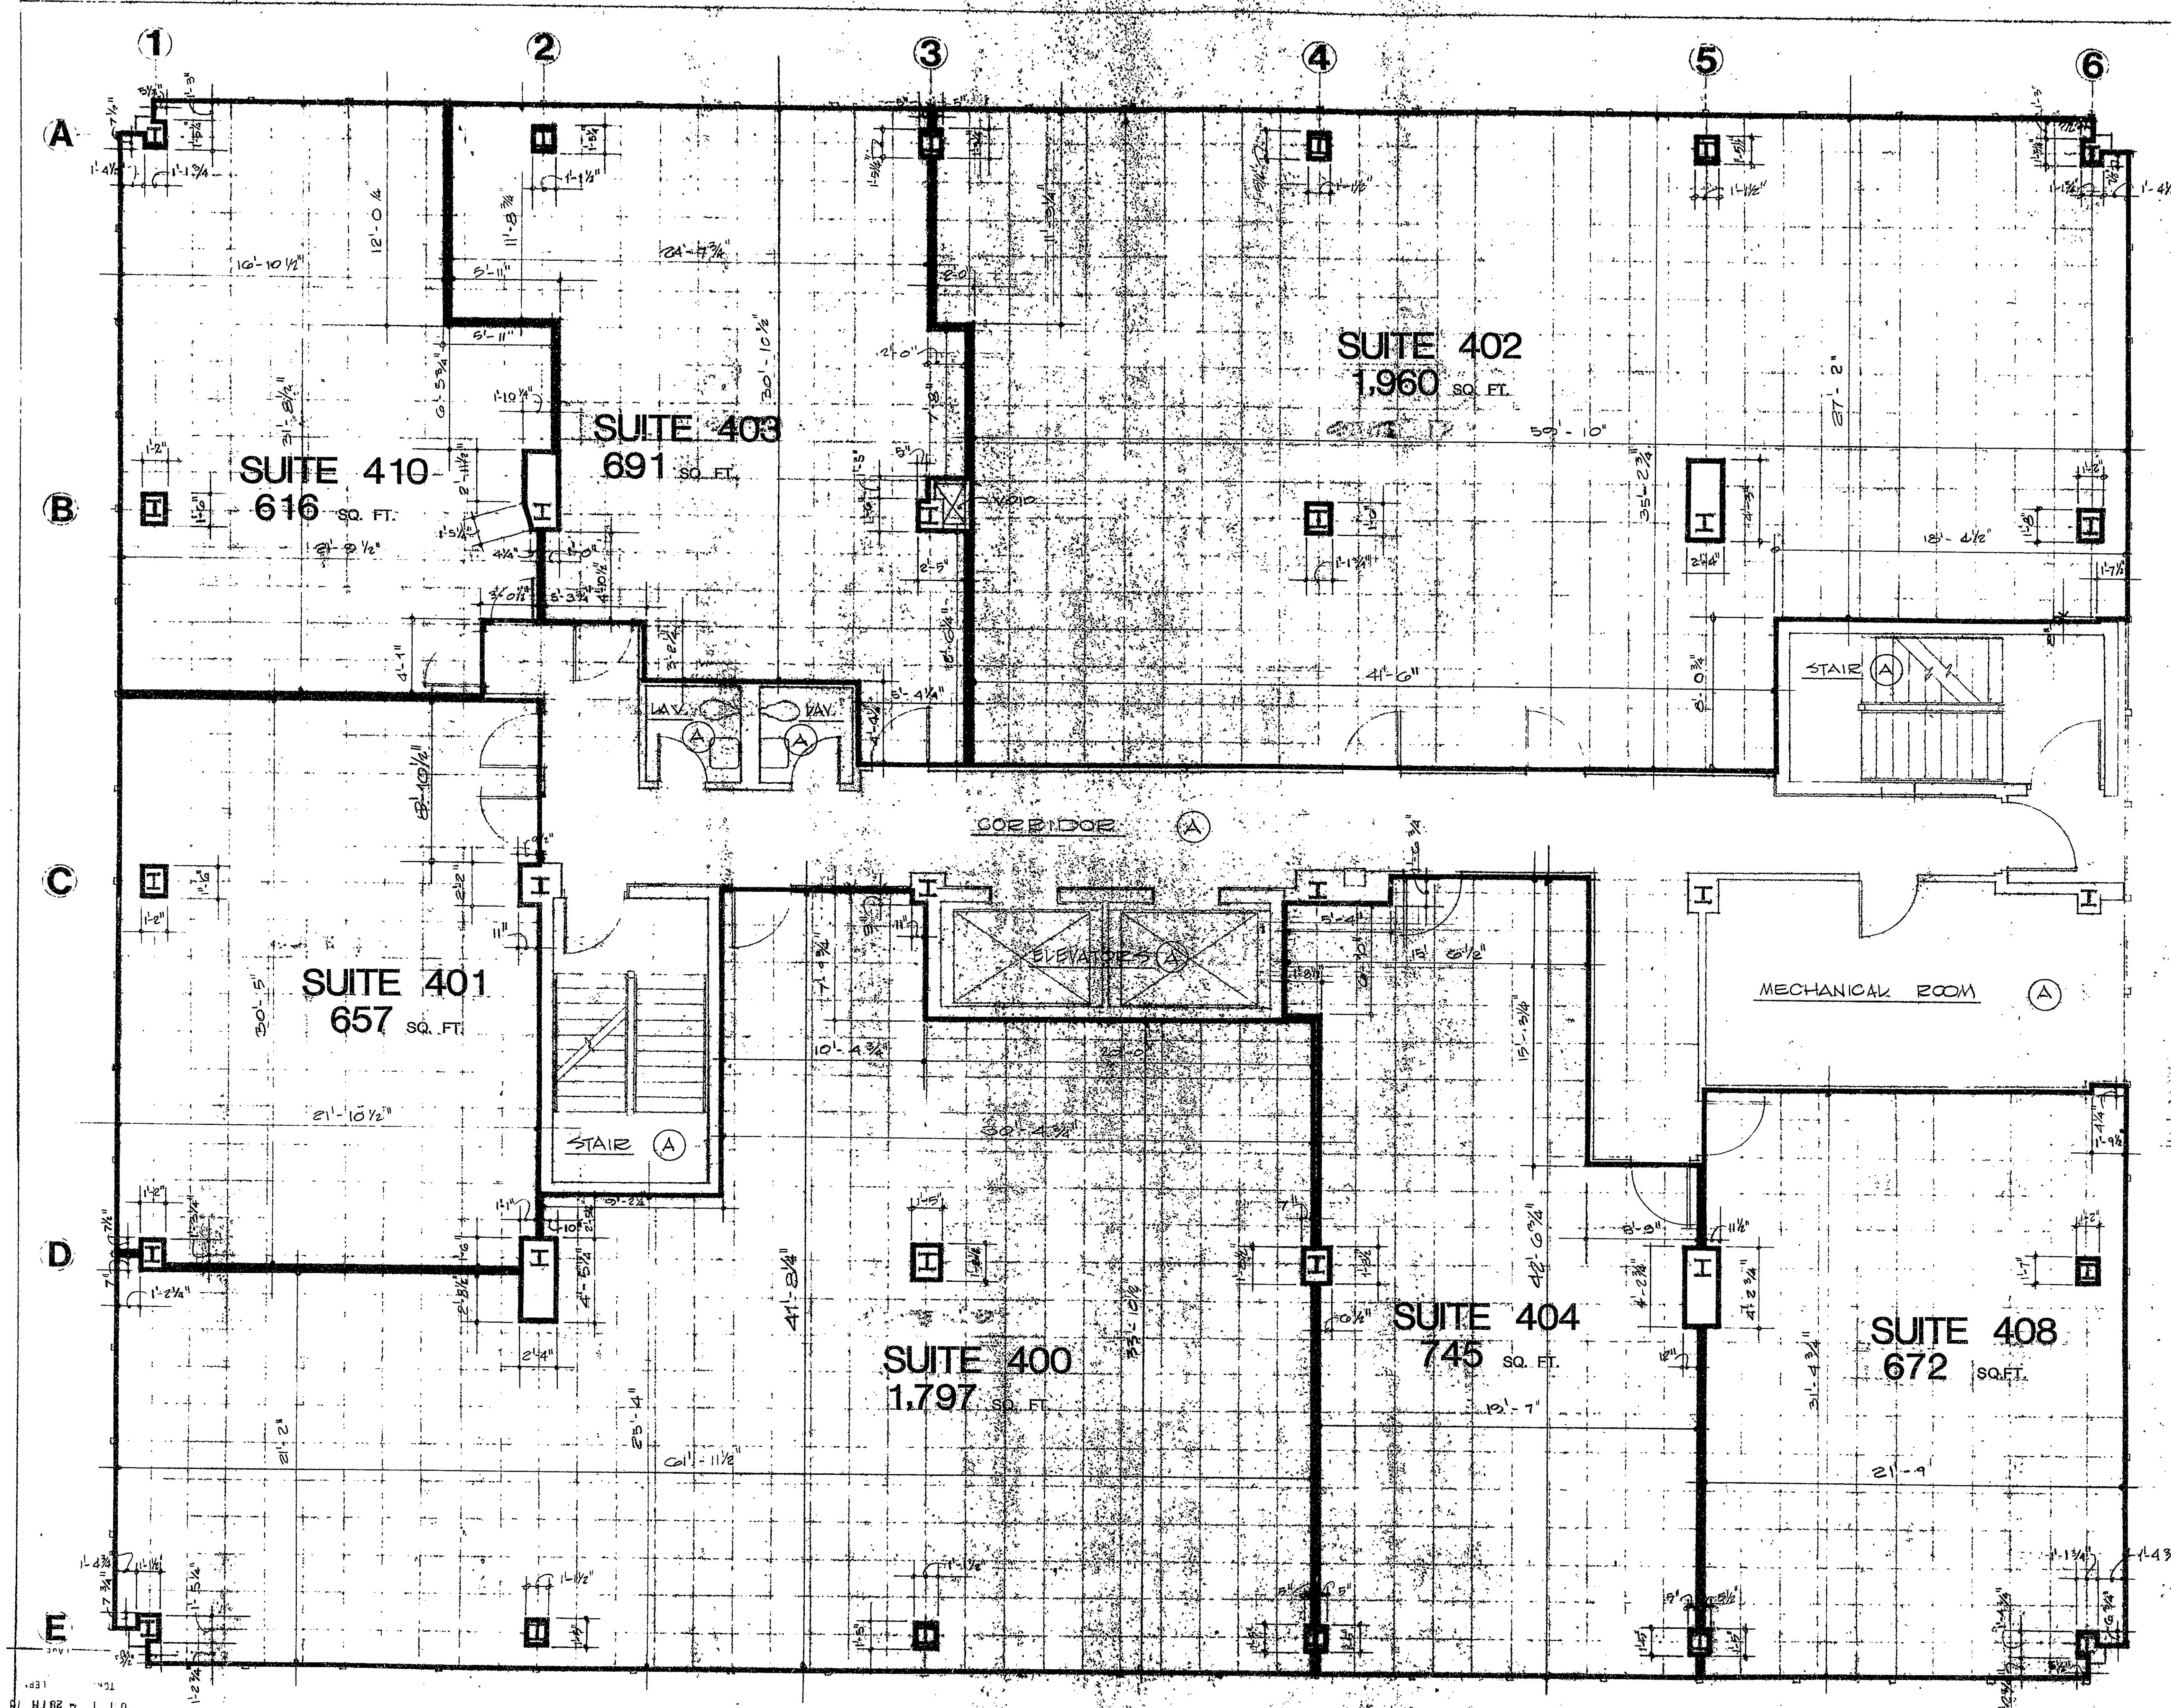

I hereby certify that this plan is substantially correct and represents the conditions and dimensions as they presently exist at 100 Retreat Avenue.

James K. Farrell, AIA
 Code #1566

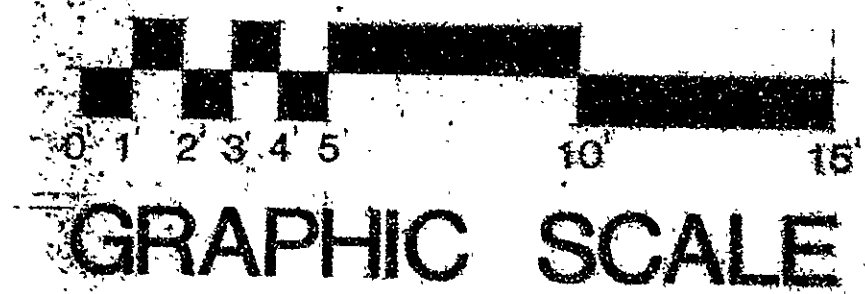

4TH FLOOR

NOTE:
 ALL DIMENSIONS ARE TAKEN FROM FACE OF GYPSUM BOARD TO FACE OF GLASS AT EXTERIOR WINDOW WALL.

FLOOR TO CEILING HEIGHT - 8'-0"

REVISION: 9.25.79
 REVISION: 4.11.77
 REVISION: 4.18.77



100 retreat ave.
 dimensions & sq. footages
 hartford, conn.

FOURTH FLOOR PLAN

architect	planner	AIA
James K. Farrell	James K. Farrell	James K. Farrell
Scale	As Shown	Drawn By
Date	8-25-78	Checked By
Revision	10/1/78	Project No.
1/13/77	08-78	
Verify All Dimensions At Site On Day Scale Drawings		
DRAWING NO.		

5

Cor of Floor Plan 4

