




SIXTH FLOOR PLAN


100 retreat ave.
dimensions & sq. footages hartford, conn.

100 retreat ave.

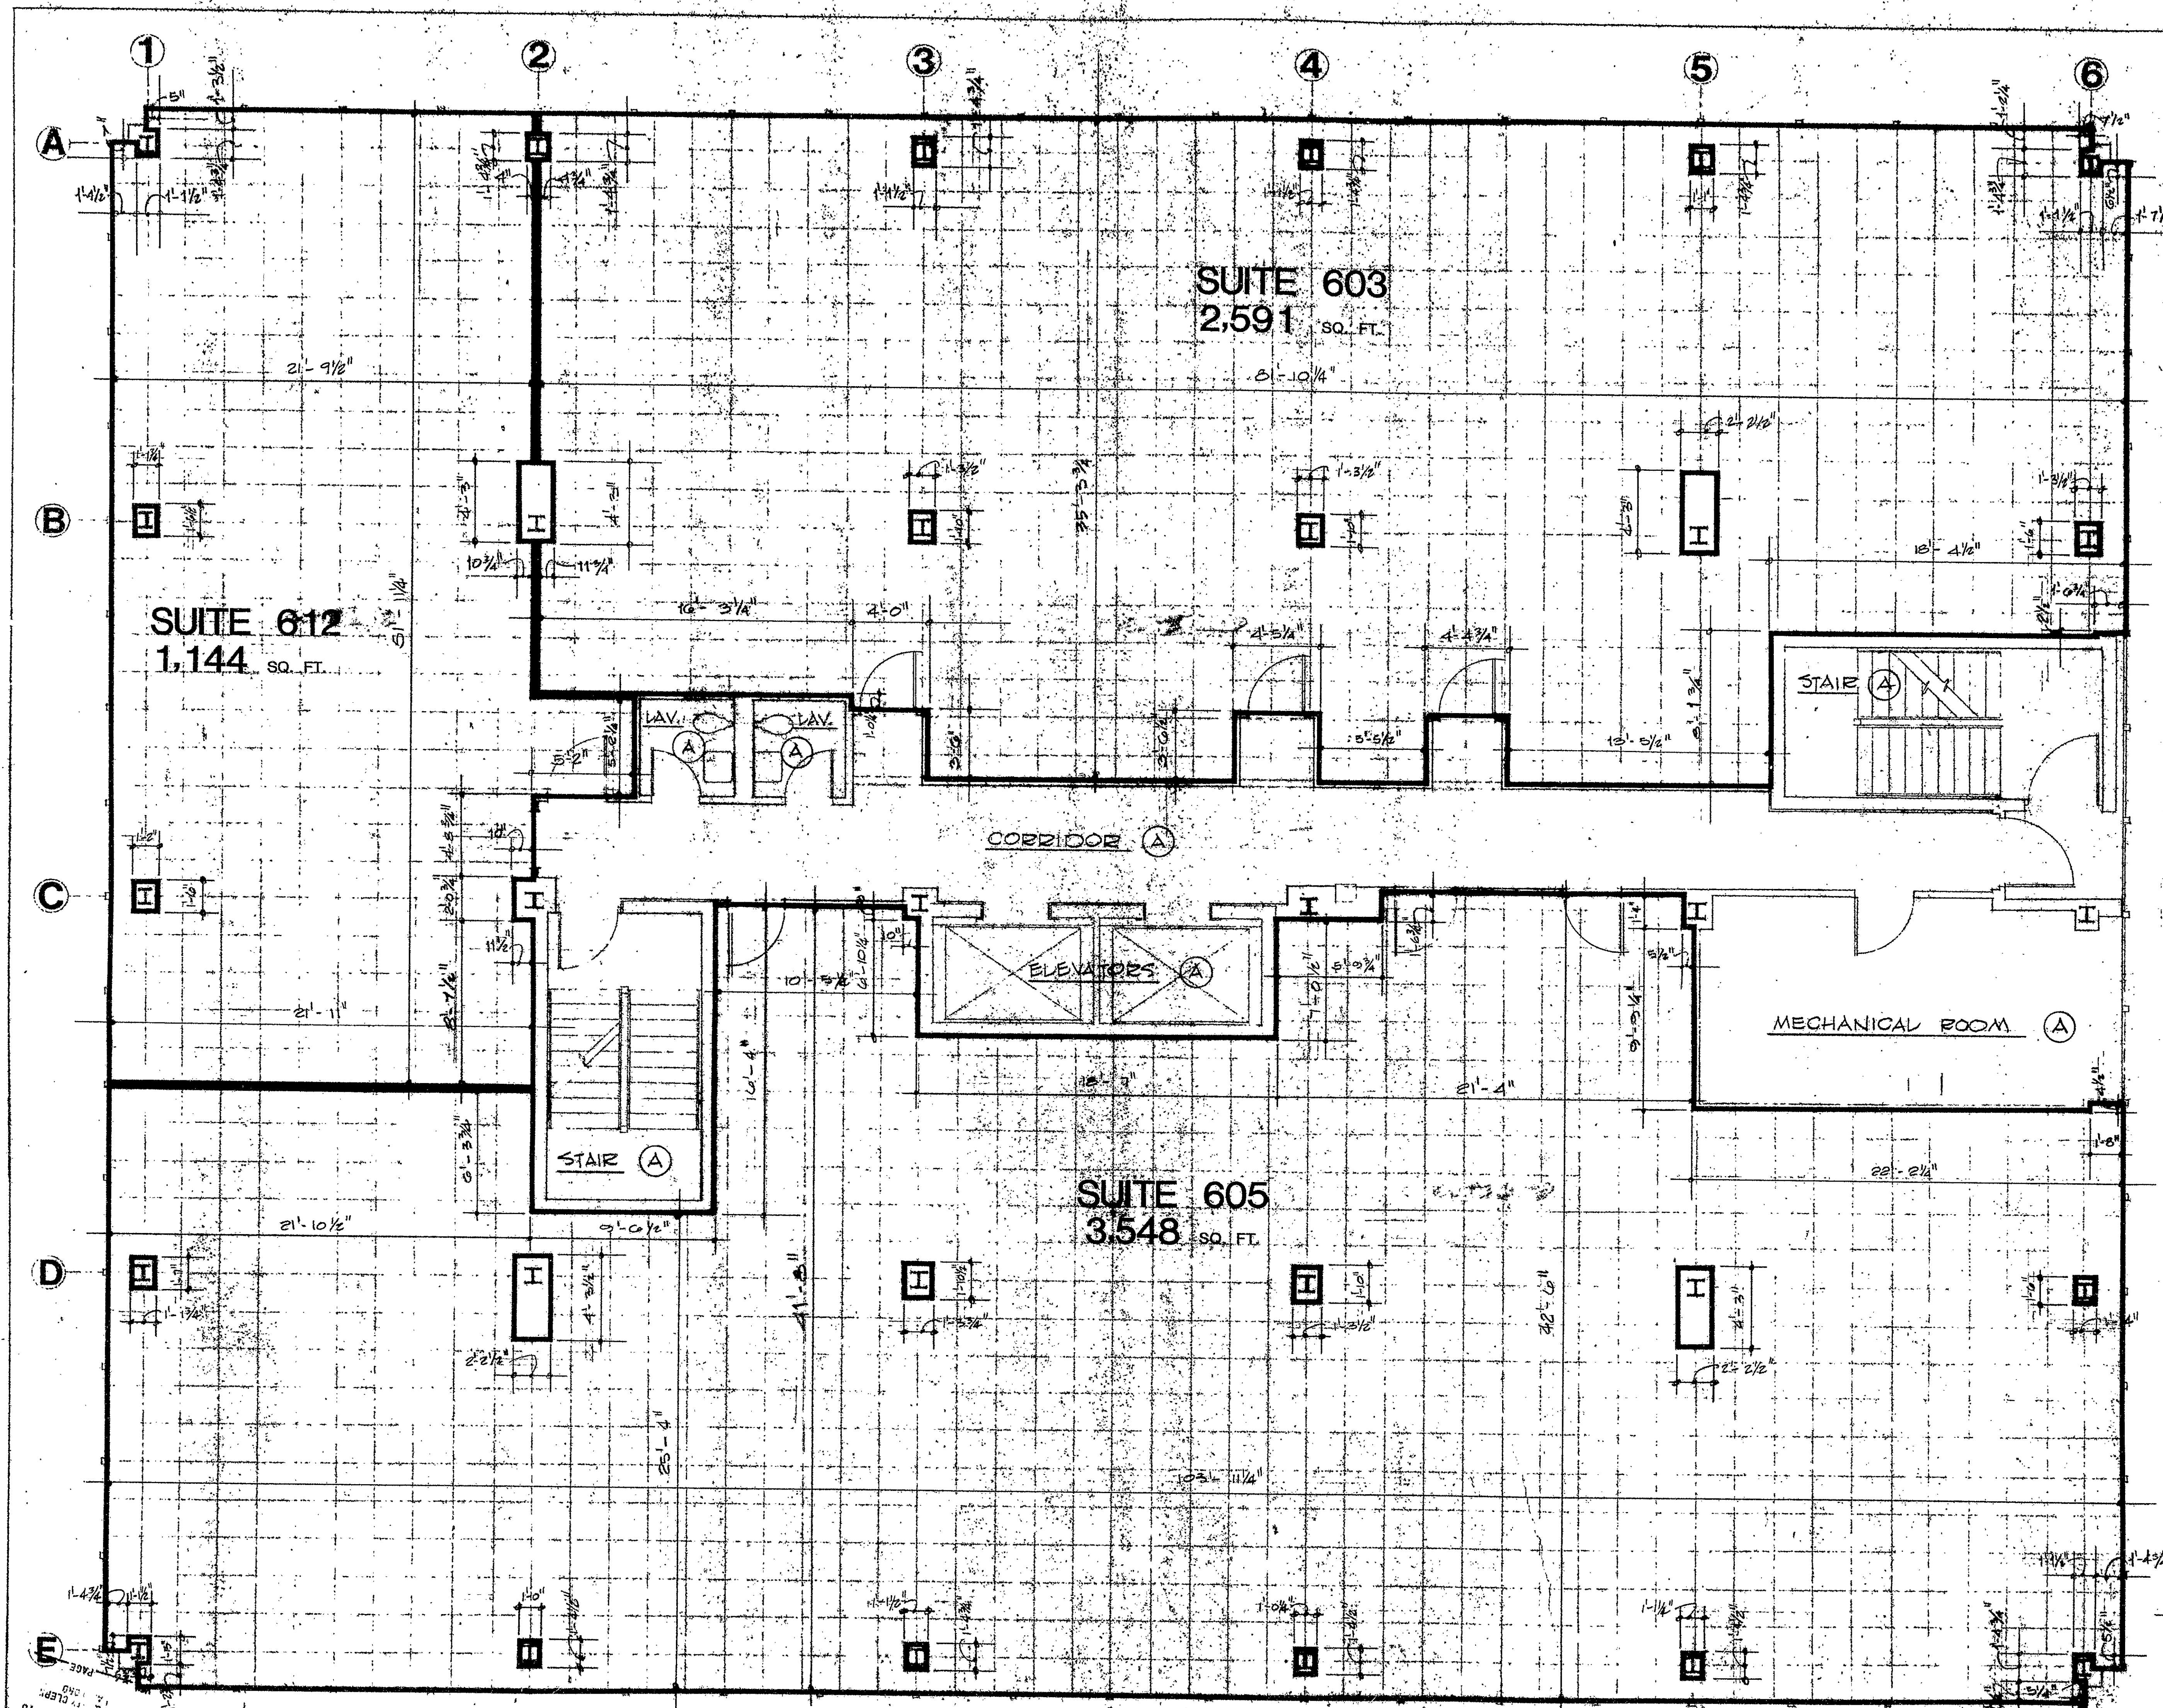

I hereby certify that this plan is substantially correct and represents the conditions and dimensions as they presently exist at 100 Retreat Avenue

James K. Farrell
James K. Farrell, AIA
Conn. #1566

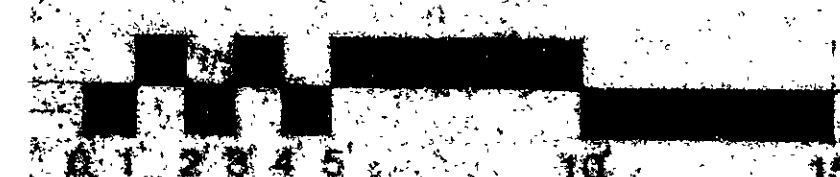

6TH FLOOR

NOTE: ALL DIMENSIONS ARE TAKEN FROM FACE OF GYPSUM BOARD TO FACE OF GLASS AT EXTERIOR WINDOW WALL.

Page 7 of 10
E.C. TO DECLARATION
RETREAT MEDICAL CONCEPT
FLOOR TO CEILING HEIGHT = 8'-0"

9.28.79
REVISION: 6.11.79
REVISION: 6.18.79

REVISION: 6-11-79
REVISION: 6-18-79

Condo Floor Plan #4

architects planners s.d.
828 turington ave. west hartford
connecticut 06105

Scale 1/4" = 1'-0"	Drawn By ✓
Date 8-25-78	Checked By
Revisions 10/31/78 1/18/79	Project No. 08-78
Verify All Dimensions At Site Do Not Scale Drawings	

DRAWING NO. 7