


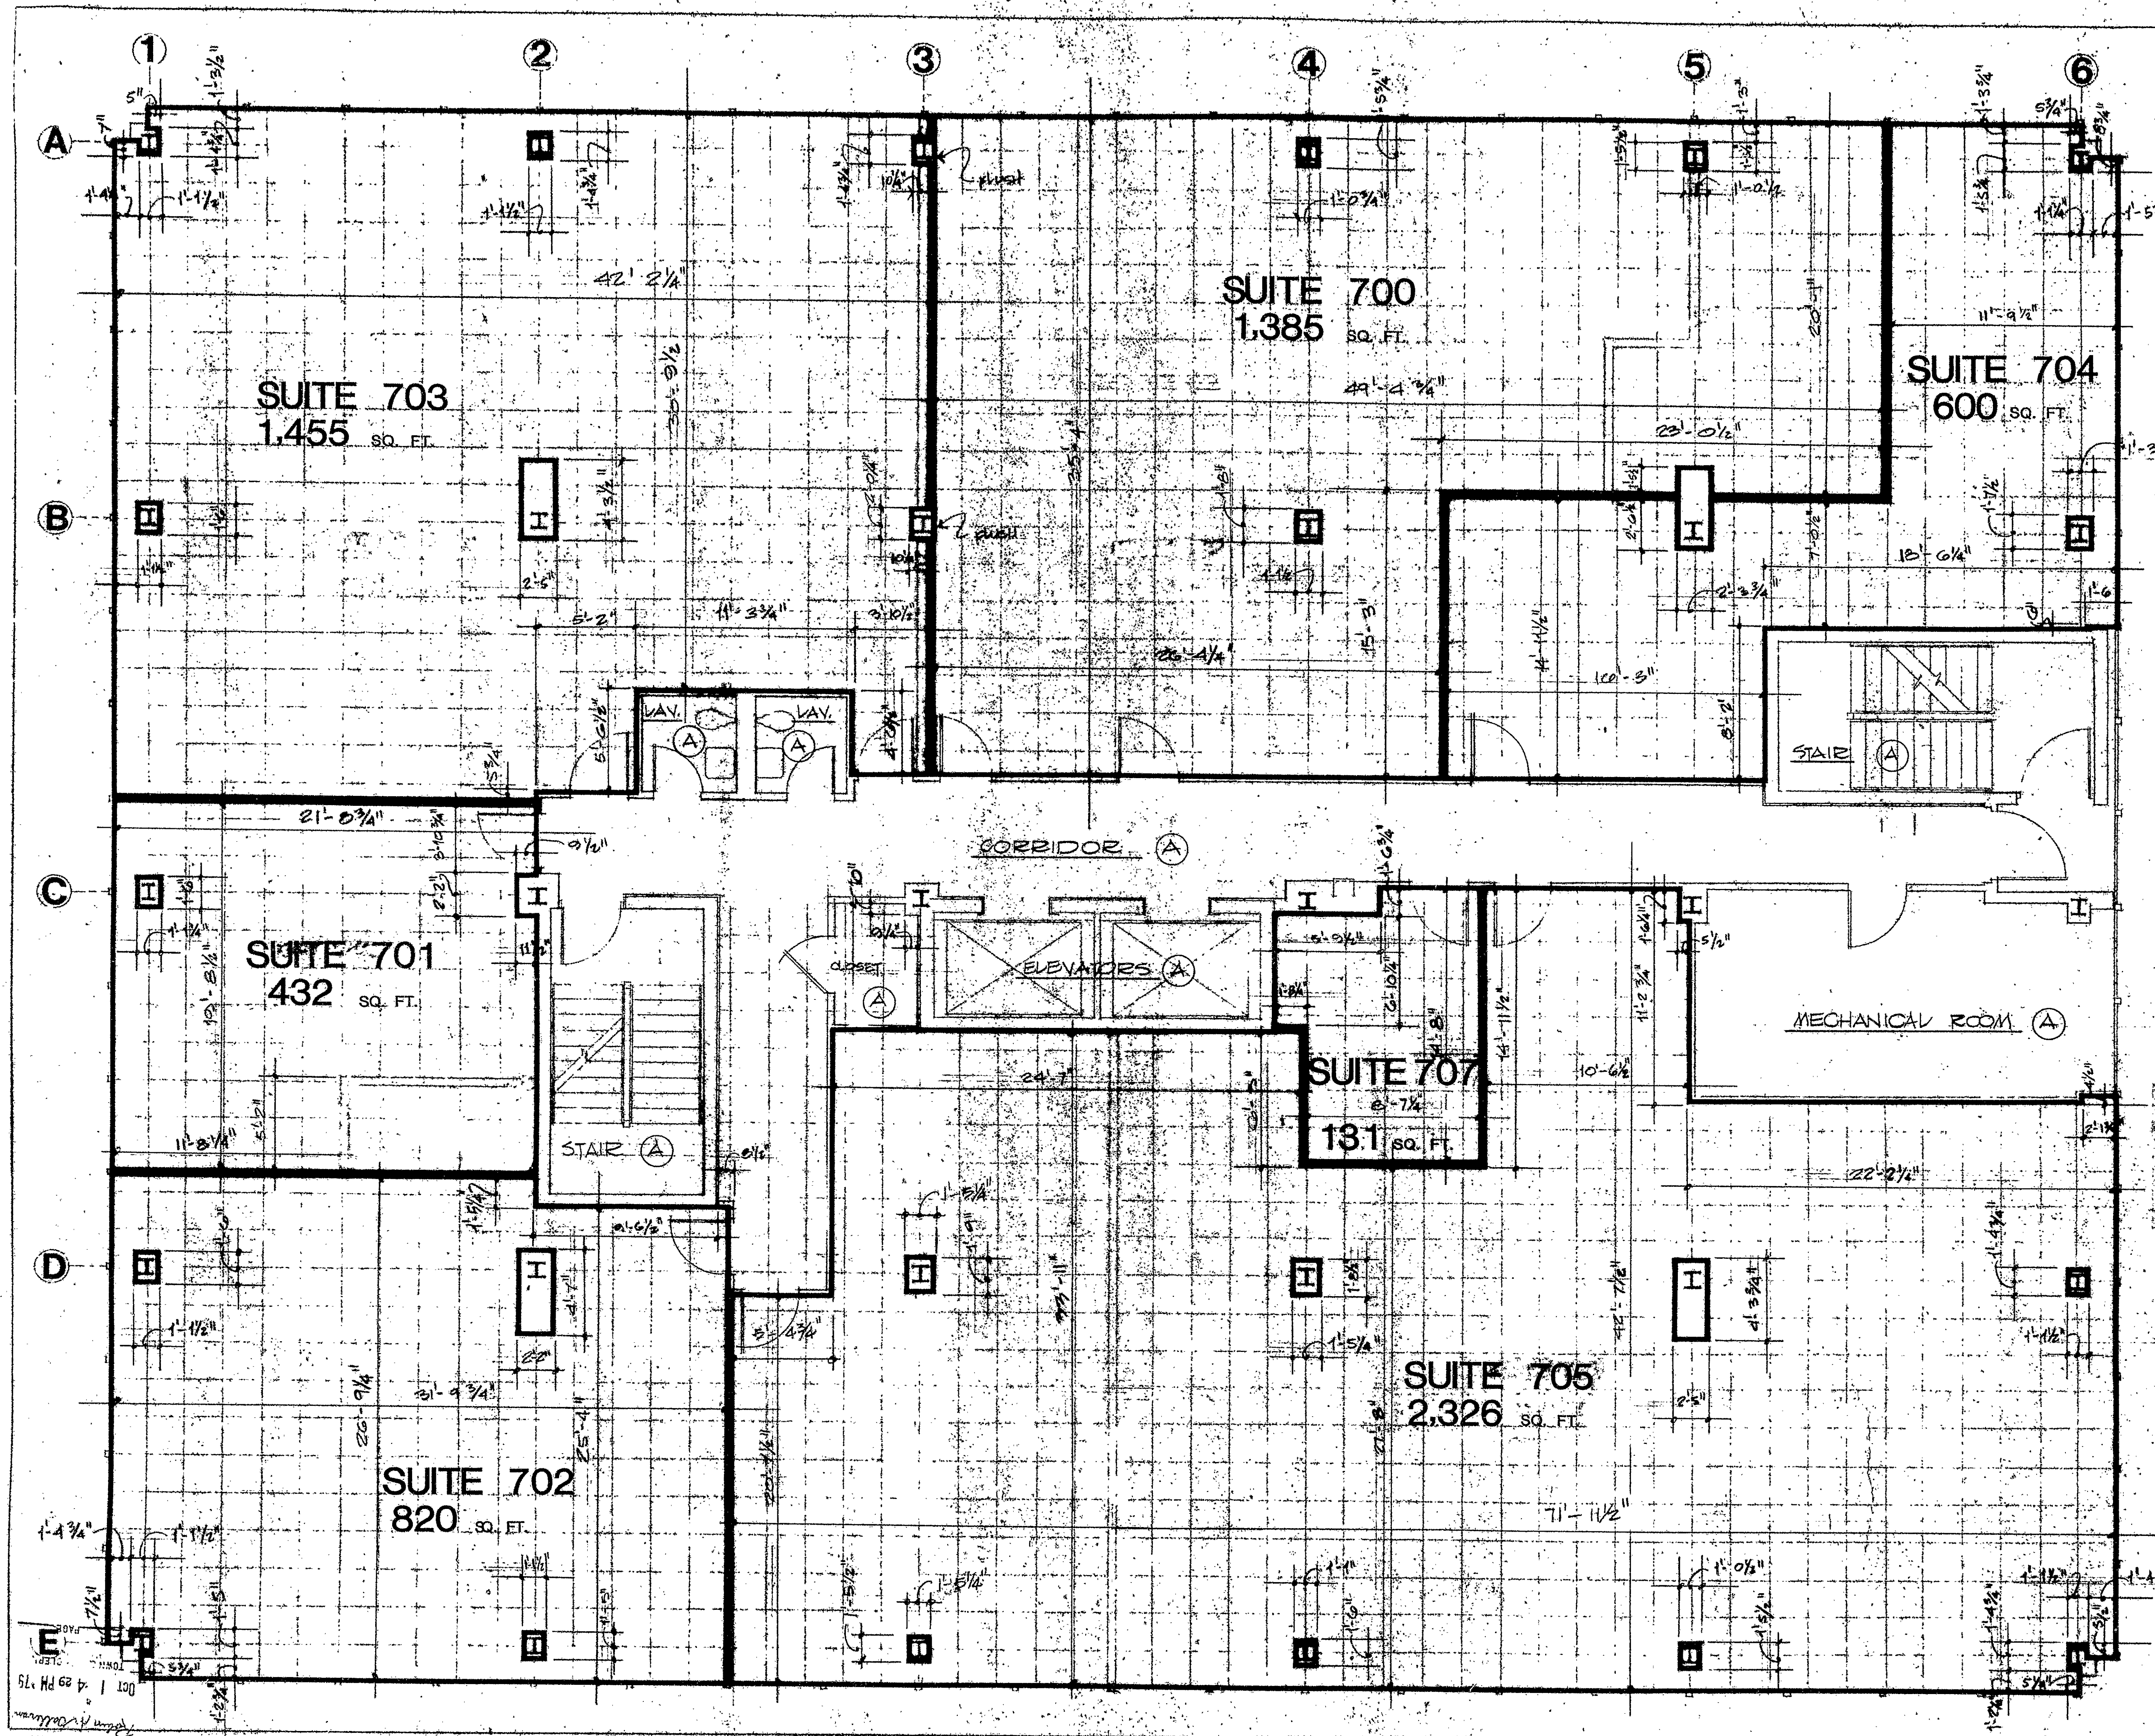

I hereby certify that this plan is substantially correct and represents the conditions and dimensions as they presently exist at 100 Retreat Avenue.

James K. Farrell
James K. Farrell, AIA
Conn. #1566

GRAPHIC SCALE

7TH FLOOR

NOTE:
ALL DIMENSIONS ARE FROM FACE
OF GYPSUM BOARD TO FACE OF
GLASS AT EXTERIOR WINDOW
WALL.

FLOOR TO CEILING HEIGHT = 8'-0"

PAGE 8 OF 10
EX C TO DECLARATION
RETREAT MEDICAL OBSERVATION
3.12.79

REVISION: 6.11.79
REVISION: 4.18.79

Condo Floor Plan to L