



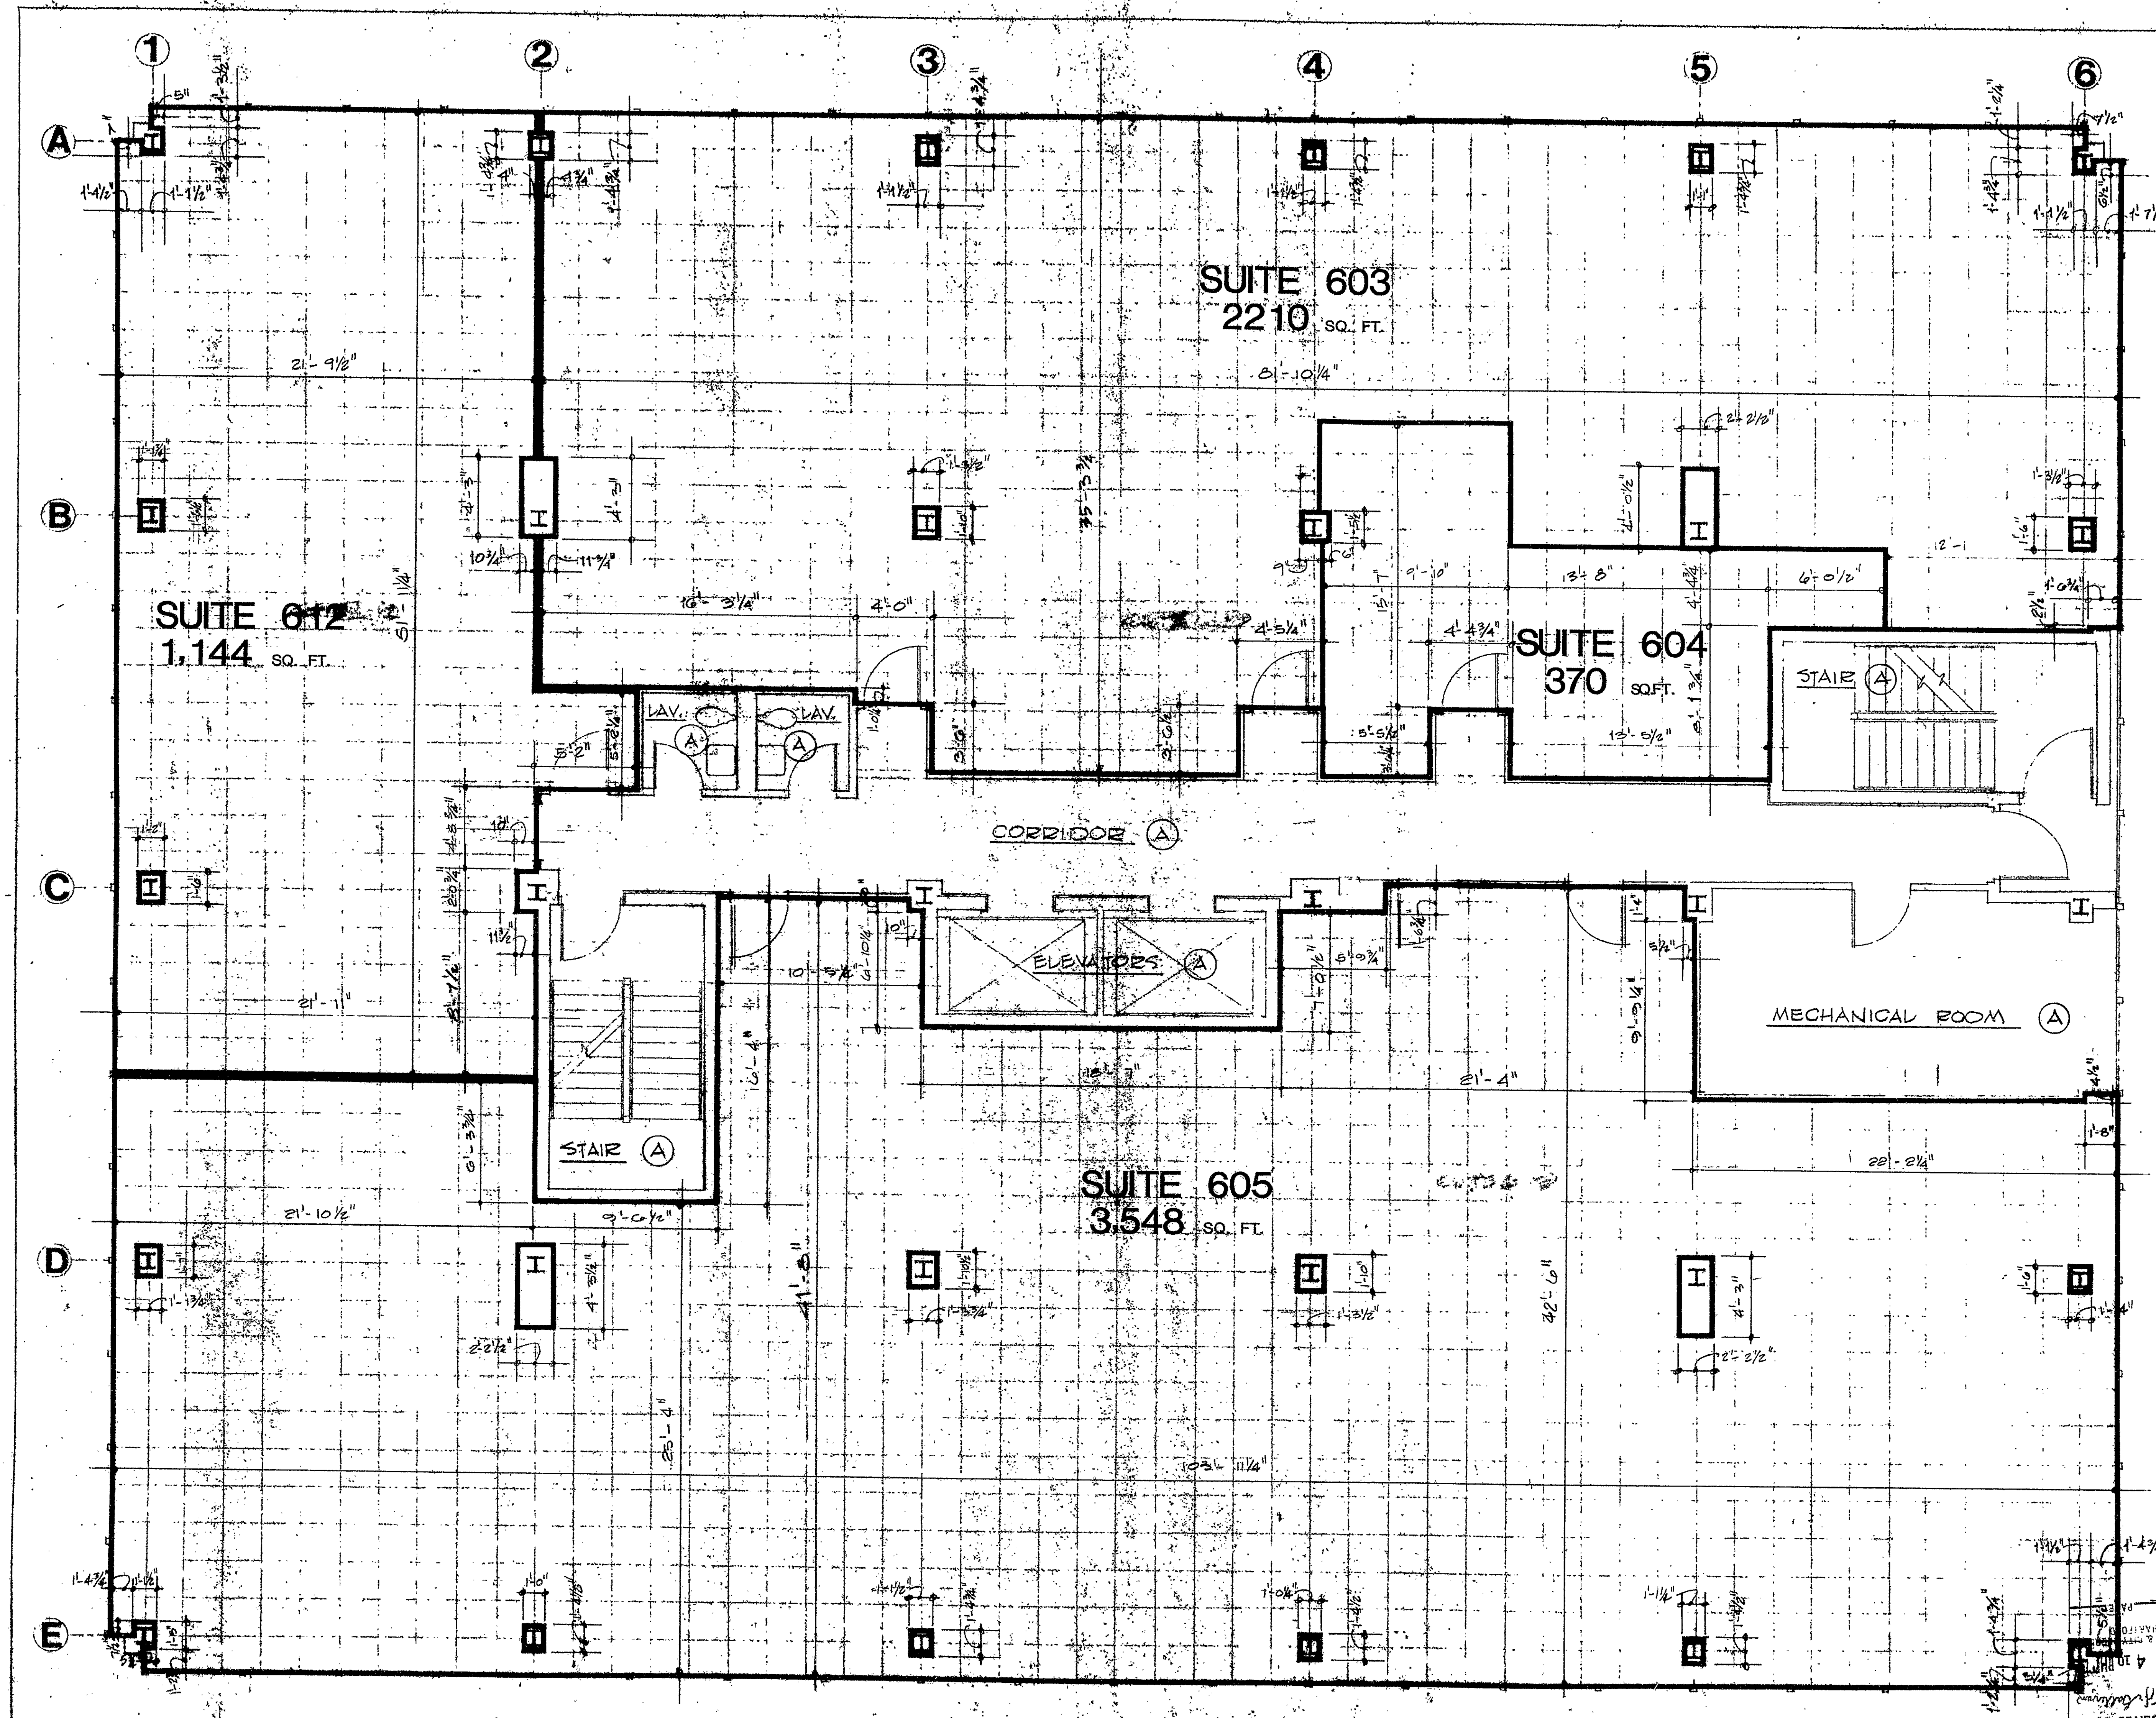

The tracings 1, 7, & 8 are Attachment A to the First Amendment to the Declaration of Retreat Medical Condominium and expandable condominium

Exhibit 'C' to the Declaration of Retreat Medical Condominium - Expandable Condominium

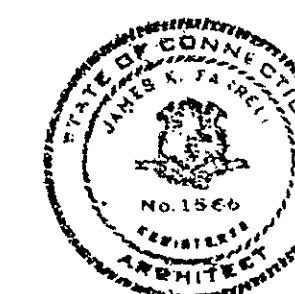

I hereby certify that this plan is substantially correct and represents the conditions and dimensions as they presently exist at 100 Retreat Avenue.

James K. Farrell
James K. Farrell, AIA
Conn. #1566



SIXTH FLOOR

NOTE: ALL DIMENSIONS ARE TAKEN FROM FACE OF CURB/SLAB EDGE TO FACE OF GLASS AT EXTERIOR WINDOW WALL.

FLOOR TO CEILING HEIGHT = 8'-0"

REVISION: 9.18.79
REVISION: 6.11.79
REVISION: 6.13.79
REVISION: 10.13.79
REVISION: 12.10.79

OFFICE UNIT PLANS

SIXTH FLOOR PLAN

100 retreat ave.
dimensions & sq. footages hartford, conn.

Architect: **Kane Farrell White**
Scale: 1/8" = 1'-0"
Date: 8-25-78
Project No.: 08-78
Drawing No.: **7**

Condo Floor Plan # 4

