


LOWER LEVEL PLAN

100 retreat ave.
dimensions & sq. footages
hartford, conn.

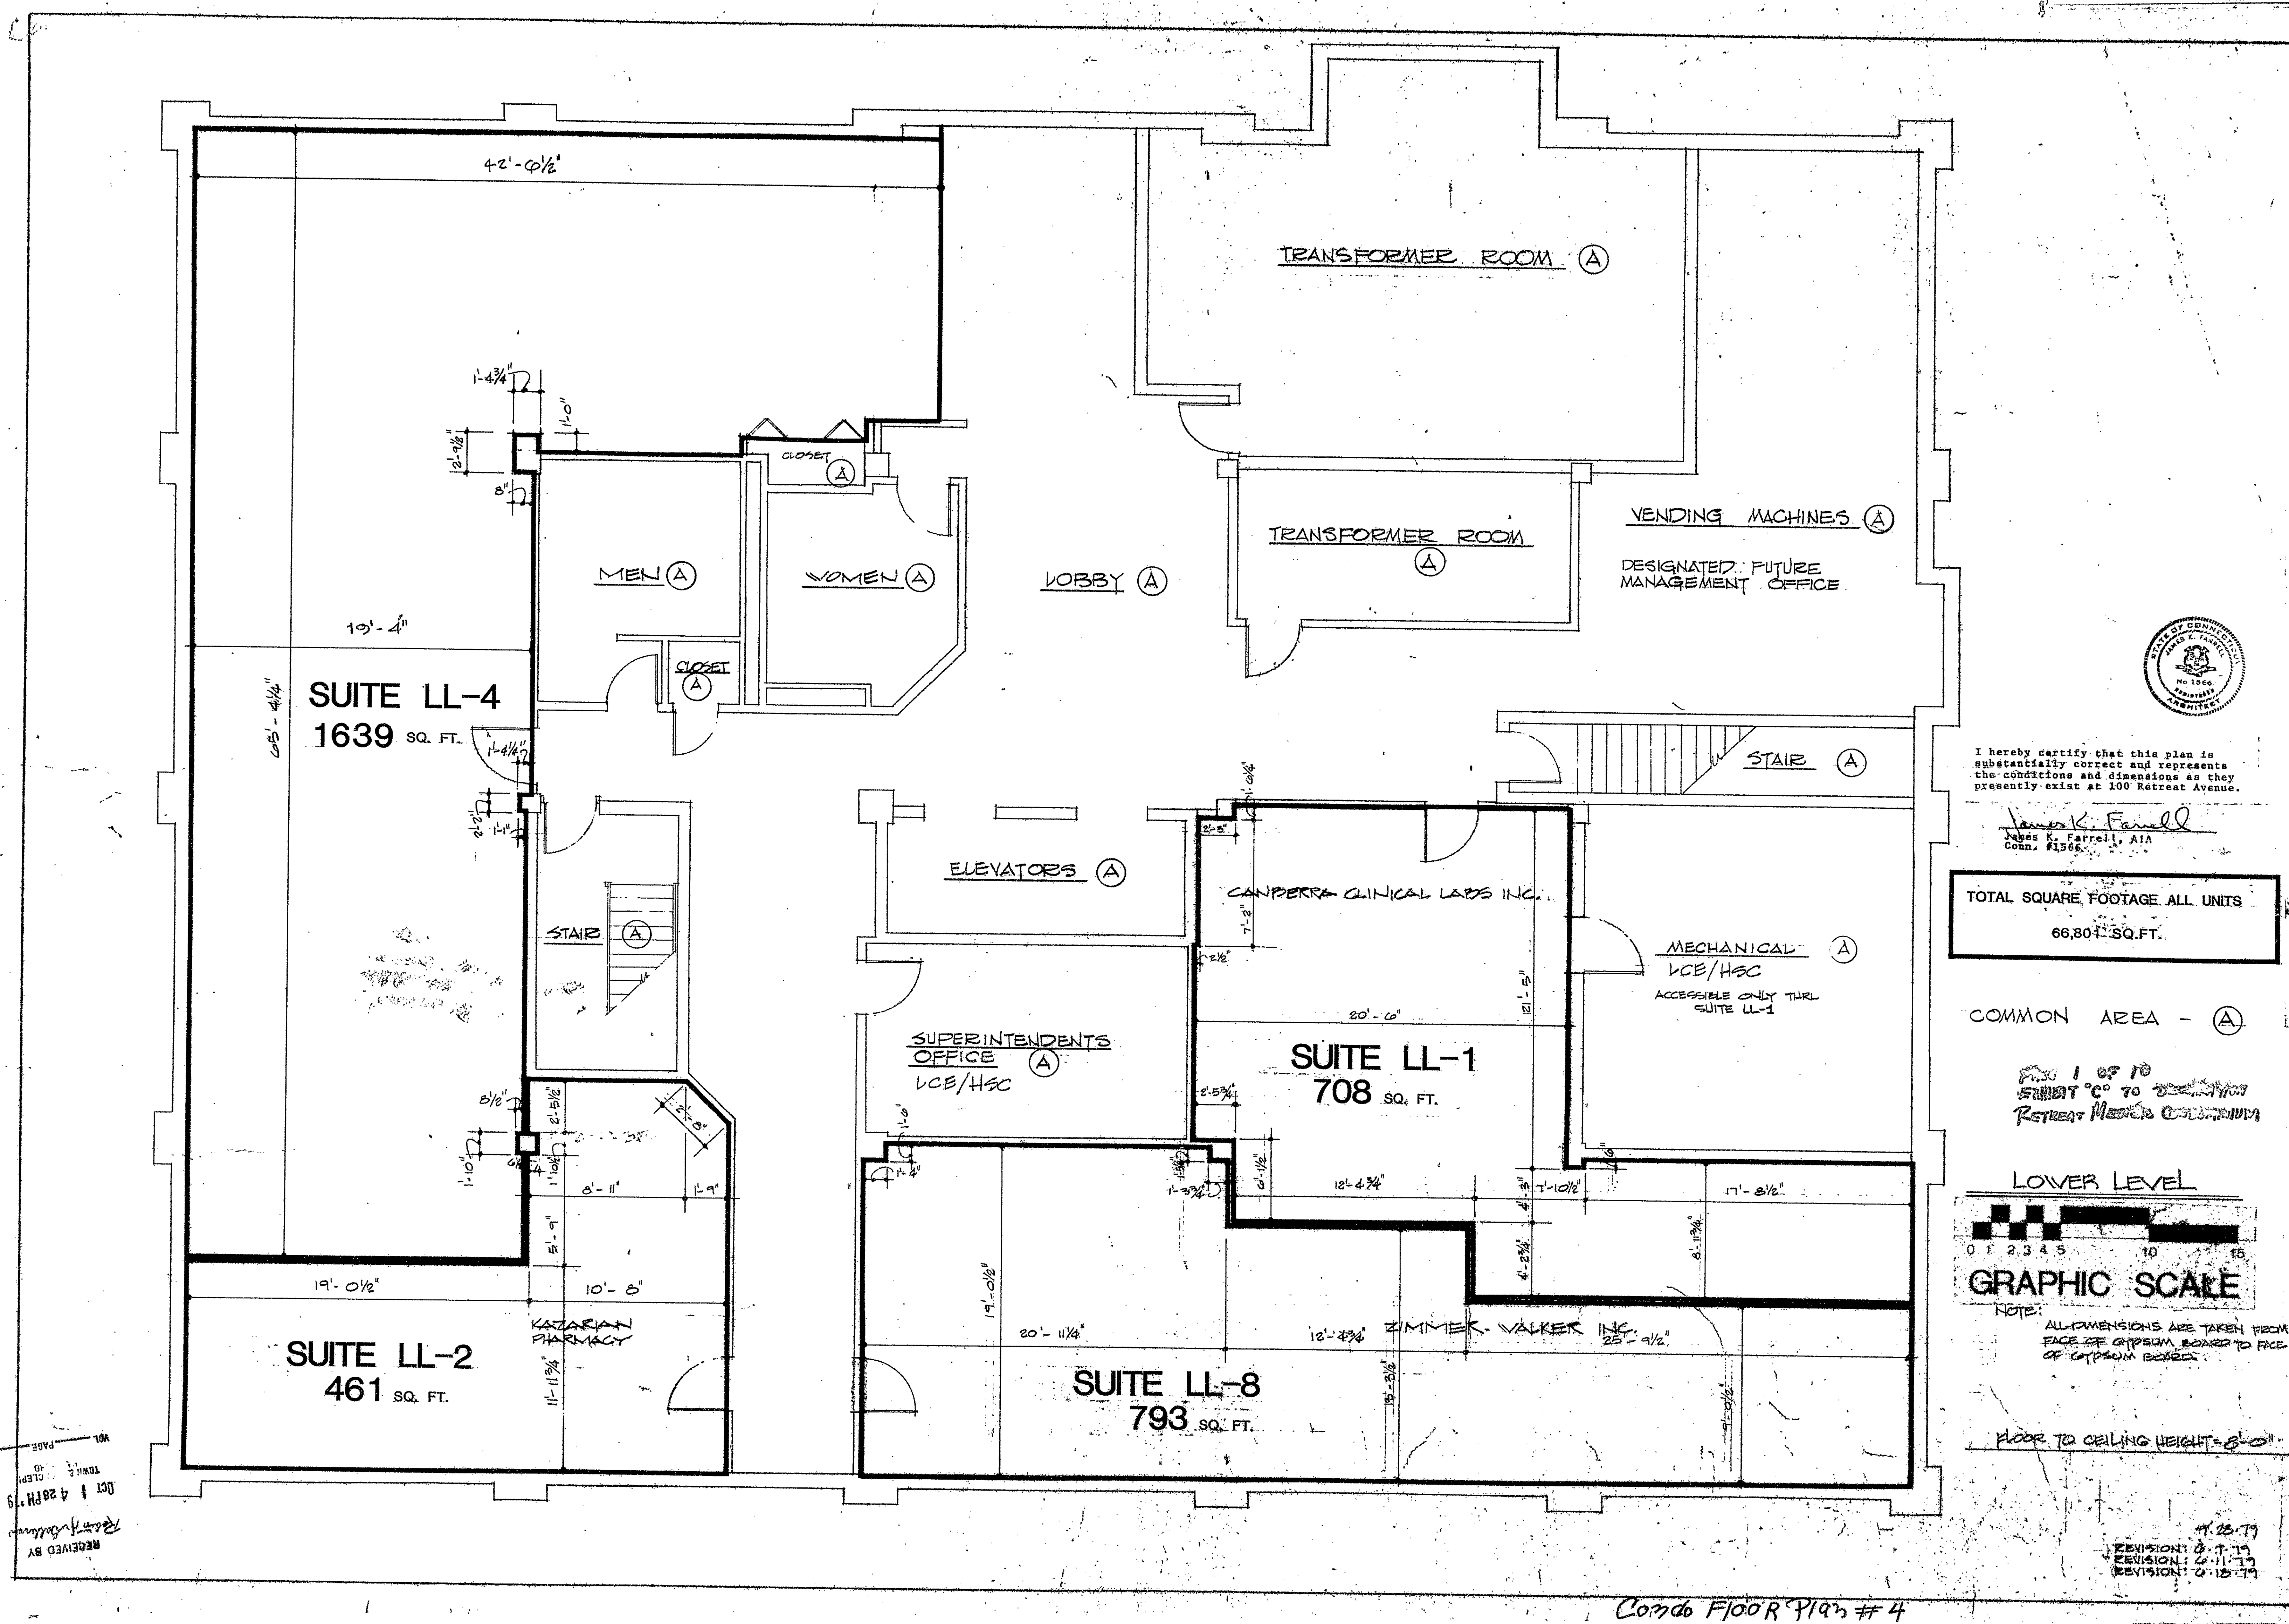


I hereby certify that this plan is substantially correct and represents the conditions and dimensions as they presently exist at 100 Retreat Avenue.

James K. Farrell
James K. Farrell, AIA
Conn. #1366

TOTAL SQUARE FOOTAGE ALL UNITS
66,801 SQ. FT.

COMMON AREA - (A)

Page 1 of 10

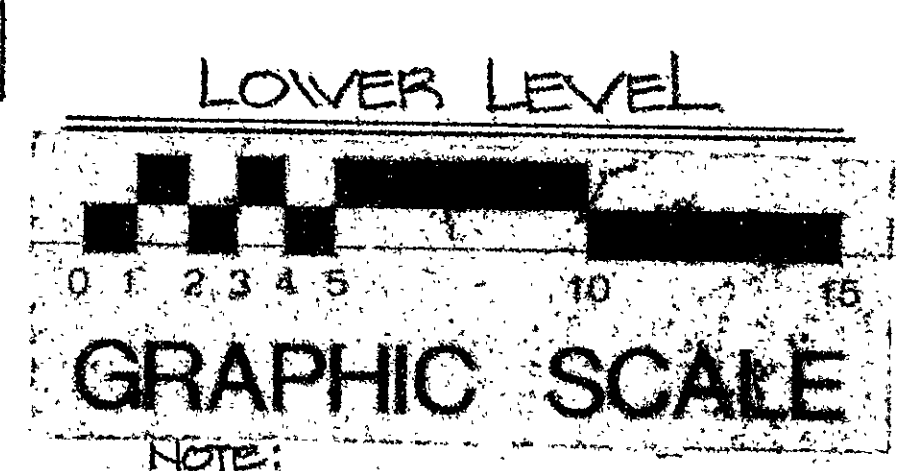


FLOOR TO CEILING HEIGHT - 8'-0"

REVISION: 0.7.79
REVISION: 0.11.79
REVISION: 0.12.79

Condo Floor Plan # 4

RECEIVED BY
DATE
TIME
PAGE 10